#### **EXISTING CONDITION NOTES**

THE CONTRACTOR AND SUB CONTRACTOR SHALL NOT INITIATE ANY WORK UNTIL EXISTING FIELD CONDITIONS ARE PROPERLY VERIFIED. WHEN DEMOLITION IS REQUIRED. THESE VERIFICATIONS SHALL INCLUDE BUT NOT LIMITED TO: DIMENSIONS BOTH HORIZONTAL AND VERTICAL, ELECTRICAL SERVICE/PANELS LOCATION AND VOLTS/PHASE, LOCATION/QTY. OF ROOF MOUNTED HVAC EQUIPMENT, CONFIRM THAT INTERIOR HVAC HUNG UNITS HAVE PROPER SUPPORT CONNECTIONS FOR EXISTING STRUCTURE, FIRE SPRINKLER MAIN RUNS, TOILET ROOM DIMENSIONS, DOOR SWING FOR DOORS TO REMAINED ETC. IF NOT VERIFIED AND DISCOVERED AT A LATER TIME, THE CONTRACTOR SHALL REIMBURSE THE ARCHITECT FOR THE REDESIGN FEE. THIS DOES NOT INCLUDE HIDDEN WORK I.E. PITCH OF SANITARY LINES, ACTUAL CONDITIONS OF EXISTING HVAC EQUIPMENT. STRUCTURAL COLUMNS/BEARING WALLS OR CONDITIONS OF GREASE INTERCEPTORS AND ETC.

#### **GENERAL NOTES**

STOP AND READ

- CONTRACTORS AND SUB-CONTRACTORS SHALL CAREFULLY REVIEW THE CONSTRUCTION DOCUMENTS. INFORMATION REGARDING THE COMPLETE WORK IS DISPERSED THROUGHOUT THE DOCUMENT SET AND CANNOT BE ACCURATELY DETERMINED WITHOUT REFERENCE TO THE COMPLETE DOCUMENT SET.
- CONTRACTOR TO VERIFY THAT ALL EQUIPMENT SHOWN AS EXISTING MATCHES THE DESCRIPTIONS AND SPECIFICATIONS SHOWN ON DRAWINGS AND SCHEDULES. IF DIFFERENT NOTIFY ARCHITECT/ENGINEER BEFORE BIDDING, ORDERING, OR PROCEEDING WITH WORK.
- DRAWINGS/DETAILS ARE TO BE CONSIDERED DIAGRAMMATIC, NOT NECESSARILY SHOWING IN DETAIL OR TO SCALE ALL MINOR ITEMS. UNLESS SPECIFIC DIMENSIONS ARE SHOWN. THE STRUCTURAL, ARCHITECTURAL AND SITE CONDITIONS SHALL GOVERN EXACT LOCATIONS. CONTRACTOR SHALL FOLLOW DRAWINGS IN LAYING OUT WORK, AND CHECK/COORDINATE DRAWINGS OF ALL TRADES.
- COORDINATE WITH THE WORK OF OTHERS SECTIONS, EQUIPMENT FURNISHED BY OTHERS REQUIREMENTS OF THE OWNER, AND WITH THE CONSTRAINTS OF THE EXISTING CONDITIONS OF THE PROJECT SITE. PROVIDE DUCT RISES AND DRIPS AS REQUIRED FOR FIELD INSTALLATION AND TRADE COORDINATION. NOTIFY ARCHITECT OF ANY DISCREPANCIES BEFORE STARTING WORK.
- DRAWINGS FOR HVAC WORK ARE DIAGRAMMATIC, SHOWING THE GENERAL LOCATION, TYPE LAYOUT, AND EQUIPMENT REQUIRED. THE DRAWINGS SHALL NOT BE SCALED FOR EXACT MEASUREMENT. REFER TO MANUFACTURER'S STANDARD INSTALLATION DRAWINGS FOR EQUIPMENT CONNECTIONS AND INSTALLATION REQUIREMENTS. PROVIDE DUCTWORK, CONNECTIONS, ACCESSORIES, OFFSETS, AND MATERIALS NECESSARY FOR A COMPLETE SYSTEM.
- ALL WORK SHALL COMPLY WITH STATE AND LOCAL CODE REQUIREMENTS AS APPROVED AND AMENDED BY THE GOVERNING CITY. PURCHASE ALL PERMITS ASSOCIATED WITH THE WORK. OBTAIN ALL INSPECTIONS REQUIRED BY CODE.
- USE OF COMBUSTIBLE MATERIALS IS NOT ALLOWED IN THE RETURN AIR PLENUM. MATERIALS USED IN THE PLENUM SHALL HAVE FLAME SPREAD RATING NOT TO EXCEED 25, AND SMOKE DEVELOPED RATING NOT TO EXCEED 50 WHEN TESTED IN ACCORDANCE WITH ASTM E 84. ALL EXPOSED WIRING IN THE PLENUM SHALL BE PLENUM RATED.
- G.C.TO VERIFY LOCATION OF PERMISSIBLE NEW STRUCTURAL ROOF PENETRATIONS AND ADAPT THE REQUIRED DUCTS ACCORDINGLY. THE OPENINGS MUST BE LOCATED USING A REBAR LOCATOR, TRYING TO LEAVE A TRANSVERSE BAR WITHIN 4" FROM THE OPENING. LOCATE OPENINGS AT MID-DISTANCE BETWEEN THE STEMS OF THE DOUBLE TEE AND LONGITUDINAL REINFORCEMENT SHALL NEVER BE CUT. CALL THE ARCHITECT'S OFFICE IN CASE OF UNEXPECTED DIFFICULTIES.
- ALL A/C AND FRESH AIR ROUND EXPOSED DUCTS WILL BE SPIRAL GALVANIZED AND READY FOR PAINTING. ALL RECTANGULAR DUCTS OVER CEILINGS MAY BE SHEET METAL WITH EXTERNAL INSULATION. ALL EXPOSED DUCTWORK SHALL BE INTERNALLY INSULATED.
- G.C. SHALL COORDINATE WITH LANDLORD APPROVED ROOFING CONTRACTOR TO FLASH AND SEAL ALL ROOF PENETRATIONS TO MAINTAIN ROOFING WARRANTY.
- CONSTRUCTION "AS BUILT" DRAWINGS AND DOCUMENTS SHALL BE PROVIDED TO THE OWNER WITHIN 90 DAYS AFTER THE DATE OF ACCEPTANCE AND PROVIDE COPY TO LL.
- OPERATION MANUALS AND MAINTENANCE MANUALS SHALL BE PROVIDED TO THE BUILDING OWNER.

#### **MECHANICAL PLAN NOTES**

- REUSE EXISTING ONE 4.0 TON GAS HEAT ROOF TOP UNIT AND PROVIDE ONE NEW 1.0 TON AHU SPLIT AIR CONDITIONING SYSTEM. REUSE EXISTING SUPPLY DUCT WORK AS MUCH AS POSSIBLE PROVIDE NEW DUCTWORK AND NECESSARY ACCESSORIES, RELOCATE AND REUSE EXISTING DIFFUSE AS SHOWN IN PLAN. PROVIDE FLEXIBLE CONNECTORS ON SUPPLY AIR DUCT CONNECTIONS. INSTALL FIRE DAMPERS IN ANY FIRE WALLS AND BETWEEN FLOORS. TRANSITION TO DUCT SIZES SHOWN, PROVIDE DUCTWORK AND AIR DISTRIBUTION DEVICES AS INDICATED ON THE PLAN. REFER TO AC UNIT SCHEDULE FOR ADDITIONAL REQUIREMENTS.
- FOR SYSTEM OVER 2,000 CFM CHECK FOR DUCT MOUNTED AIR SMOKE DETECTORS AND THAT MEET THE REQUIREMENTS OF U.L. 268A, INTERLOCKED TO SHUTDOWN ROOF TOP UNIT UPON DETECTION OF SMOKE. IF NECESSARY PROVIDE SMOKE DETECTOR WITH AN ANNUNCIATOR, ALARM AND POWER L.E.D.'S FOR VISIBLE AND AUDIBLE ALARM SIGNAL, AND VISIBLE TROUBLE SIGNAL. MOUNT ANNUNCIATOR ON ROOM SIDE OF CEILING.
- ALL DUCTS SHALL BE MINIMUM 26 GAUGE SHEET METAL WITH EXTERNAL DUCT WRAP INSULATION FOR CONCEALED DUCTS AND ALL EXPOSED DUCTS WITH INTERNAL INSULATION. ALL DUCTS TO BE MANUFACTURED AND INSTALLED ACCORDING TO ASHRAE AND SMACNA METAL DUCT CONSTRUCTION STANDARD, LATEST EDITION. ALL MATERIALS WILL CONFORM TO NFPA 90A.
- ALL EXPOSED DUCTWORK SHALL BE INTERNALLY INSULATED AND ALL INTERNAL CONCEALED DUCTWORK SHALL BE EXTERNALLY INSULATED.
- THERMOSTATS SHALL BE 7-DAY PROGRAMMABLE TYPE. MOUNT THERMOSTAT 48" A.F.F. IF EXISTING THERMOSTAT AND REMOTE SENSOR ARE NOT REUSABLE THEN PROVIDE NEW THERMOSTAT WITH LOCKABLE COVER. COORDINATE FINAL LOCATION OF THERMOSTAT. PROVIDE REMOTE SENSOR LOCATED 72" ABOVE FINISHED FLOOR NEAR LOCATION INDICATED SEAL WALL OPENING WITH CAULK. COORDINATE LOCATION ON SITE WITH GENERAL CONTRACTOR AND EQUIPMENT.
- ALL INTERIOR AIR DUCTS WITH INSULATION SHALL HAVE A MINIMUM OF THICKNESS OF 1.5", R-6 INSULATION AND EXTERIOR DUCTS SHALL HAVE R-8 INSULATION AS PER 2012 KENTUCKY ENERGY CONSERVATION CODE(2012 IECC)
- ALL SEAMS, JOINTS, ETC WILL BE SEALED TO MAKE AIR DUCT AIRTIGHT. PRESSURE SENSITIVE MATERIALS AND OTHERS APPROVED BY LATEST SMACNA. SEALING MATERIALS WILL BE USED.
- ALL EXISTING RTU'S CONDENSATE DRAINS WILL BE PVC FULL DIAMETER OF OUTLET AND WILL TERMINATE IN THE APPROVED PLACE OF DISPOSAL.
- ALL EQUIPMENT AND MATERIALS WILL BE INSTALLED ACCORDING TO THE MANUFACTURER'S INSTRUCTIONS AND ACCORDING TO THE BEST PRACTICE.
- TESTING AND BALANCING SHALL BE DONE IN ACCORDANCE AS PER 2012 INTERNATIONAL ENERGY CONSERVATION CODE, SECTION C408.2.2. BALANCING PROCEDURES SHALL BE IN ACCORDANCE WITH THE NATIONAL ENVIRONMENTAL BALANCING BUREAU (N.E.B.B.), THE ASSOCIATED AIR BALANCE COUNCIL (A.A.B.C) NATIONAL STANDARDS OR EQUIVALENT PROCEDURES.
- HANGER ATTACHMENTS TO THE STEEL STRUCTURE WILL BE RATED POWDER ACTUATED FASTENERS, "C" CLAMPS, WELDED STUDS, CLAMP HANGERS, JOIST CLAMPS OR OTHER METHODS RECOMMENDED BY SMACNA'S "METAL AND FLEXIBLE STANDARDS", CHAPTER 4, AND WILL HAVE A MINIMUM SAFETY MARGIN OF 4:1. SUSPENDED FROM TOP CHORD OF JOISTS, NOTHING FROM DECK OR CROSS BRACING.

ALL HVAC CONTROLS AND CONTROL WIRING SHALL BE PROVIDED BY THE MECHANICAL CONTRACTOR.

#### **SCOPE OF WORK**

REUSE EXISTING ONE 4.0 TON GAS HEAT ROOF TOP UNIT (CARRIER) AND PROVIDE ONE NEW 1.0 TON AHU SPLIT AIR CONDITIONING SYSTEM WITH SUPPLEMENTARY HEAT. REUSE EXISTING SUPPLY DUCTWORK AS MUCH AS POSSIBLE AND PROVIDE NEW DUCTWORK AND NECESSARY ACCESSORIES, RELOCATE AND REUSE EXISTING DIFFUSER AS SHOWN IN PLAN.

- PROVIDE TWO NEW BATHROOM EXHAUST FANS. PROVIDE ONE NEW KITCHEN EXHAUST FAN & ONE NEW EXHAUST FAN FOR MOP SINK.
- COORDINATE WITH GC ANY ADDITIONAL REFRIGERATION WORK REQUIRED AND PLUMBING CONTRACTOR PROVIDING CONDENSATE LINES FOR MECHANICAL EQUIPMENT.

#### **CITY OF INDEPENDENCE, KY BUILDING DEPARTMENT NOTES**


ALL WORK SHALL COMPLY WITH APPLICABLE SECTIONS OF 2018 KBC/ 2015 IBC AND ALL AMENDMENTS AND RULES AND REGULATIONS OF THE DEPARTMENT OF BUILDINGS TO DATE.

- THE LICENSED PROFESSIONAL ENGINEER, ARCHITECT OR OTHER PERSON HAVING NOT LESS THAN FIVE (5) YEARS EXPERIENCE SUPERVISING THE INSTALLATION OF SUCH MECHANICAL SYSTEMS AND CONDUCTING SUCH TESTS WILL FILE DOCUMENTATION AND REPORTS OF TESTS THAT THE SYSTEM COMPLIES WITH THE CONSTRUCTION DOCUMENTS AND APPLICABLE LAWS.
- TESTS OF MECHANICAL SYSTEMS SHALL BE PERFORMED IN ACCORDANCE WITH THE FOLLOWING SECTIONS OF THE 2015 KMC:
- A. VENTILATION SYSTEM SERVING COMMERCIAL COOKING APPLIANCES 2015 KMC 506

#### THE FOLLOWING WORK ITEMS, COMPONENTS, MATERIALS, CAPACITIES, ETC. SHALL COMPLY WITH THE REFERENCED CODE OR STANDARD:

- A. DUCT CONSTRUCTION AND INSTALLATION 2015 KMC 603 B. STANDARDS OF HEATING - 2015 KMC - 309.1
- C. AIR INTAKES, EXHAUSTS AND RELIEF 2015 KMC 401.5
- D. AIR FILTERS 2015 KMC 605
- E. MANUAL AND AUTOMATIC FIRE AND SMOKE CONTROL FOR AIR DISTRIBUTION SYSTEM 2015 KMC 606 F. GAS FIRED EQUIPMENT - 2015 KENTUCKY FUEL GAS CODE
- . MINIMUM TEMPERATURE TO BE MAINTAINED IN OCCUPIED SPACES DURING HEATING SEASON: 68 DEG. FAHRENHEIT.
- VENTILATION FOR ALL AREA SHALL COMPLY WITH 2015 KMC 403.
- REFER TO ARCHITECTURAL DRAWINGS FOR REQUIRED FIRE-RATED WALL AND SMOKE WALL CONSTRUCTION AND LOCATION.
- THESE PLANS ARE APPROVED ONLY FOR THE WORK INDICATED ON THE APPLICATION SPECIFICATION SHEET. ALL OTHER MATTERS SHOWN ARE NOT TO BE RELIED UPON OR TO BE CONSIDERED AS EITHER BEING APPROVED OR IN ACCORDANCE WITH APPLICABLE CODES.
- 8. ALL HEATING AND COOLING LOADS CALCULATED PER ASHRAE/ACCA 183.
- 9. SMOKE DETECTOR SHALL MEET UL268A.
- 10. STATEMENT SHALL BE FILLED BY THE OWNER OR TENANT IN POSSESSION THAT THE VENTILATION SYSTEM WILL BE KEPT IN CONTINIOUS OPERATION AT ALL TIME DURING THE NORMAL OCCUPANCY OF THE STRUCTURE AS REQUIRED BY THE 2015 KMC - 403.3
- 1. VENTILATION SYSTEMS SHALL BE BALANCED TO MAINTAIN THE MINIMUM VENTILATION AIRFLOW RATE AS SHOWN IN VENTILATION REQUIREMENT TABLE. THIS SYSTEM SHALL BE BALANCED BY APPROVED METHOD -2015 KENTUCKY MECHANICAL CODE SECTION 403.3.1.5. CONTRACTOR TO SUBMIT THE AIR - BALANCE REPORT TO INSPECTOR OF RESPECTIVE BUILDING DEPARTMENT PRIOR TO FINAL INSPECTION.

### **MECHANICAL SYMBOLS**

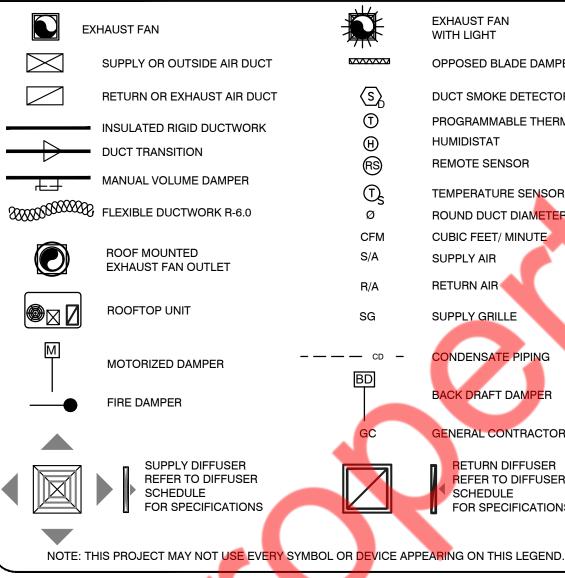

# 

EXHAUST FAN WITH LIGHT

OPPOSED BLADE DAMPER

DUCT SMOKE DETECTOR PROGRAMMABLE THERMOSTAT HUMIDISTAT

REMOTE SENSOR

TEMPERATURE SENSOR ROUND DUCT DIAMETER

CUBIC FEET/ MINUTE SUPPLY AIR

RETURN AIR

SUPPLY GRILLE

ONDENSATE PIPING K DRAFT DAMPE

**GENERAL CONTRACTOR** 

RETURN DIFFUSER REFER TO DIFFUSER SCHEDULE FOR SPECIFICATIONS

00	COUPANCY CALCULATION PEF 2015 KMC TABLE 403.3.1.1	8
DINING AREA	446 SQ. FT. @70 PEOPLE/1000SQ.	T. 32 PEOPLE
	TOTAL	32 PEOPLE
VEN	ITILATION REQUIREMENTS PE 2015 KMC TABLE 403.3.1.1	R
DINING	446 SQ. FT. X 0.18 CFM/SQ. FT. =	81 CFM
Dining	32 PEOPLE. X 7.5 CFM/PEOPLE. =	240 CFM
BACK OF HOUSE / DRY STORAGE	416 SQ. FT. X 0.12 CFM/SQ. FT. =	50 CFM
HALLWAY	169 SQ. FT. X 0.06 CFM/SQ. FT. =	11 CFM
OUTSIDE AIR REQU	JIRED	382 CFM
KITCHEN / SKULLERY	395 SQ. FT. X 0.7 CFM/SQ. FT. =	277 CFM
UNISEX ACC. RR	70 CFM PER FIXTURE	70 CFM
RESTROOM 2	70 CFM PER FIXTURE	70 CFM
MOP SINK	70 CFM	70 CFM
EXHAUST AIR REQ	UIRED	487 CFM
OUTSIDE AIR PRO	/IDED	500 CFM
EXHAUST PROVIDE	D	490 CFM
AIR BALANCE		
O/A PROVIDED RTU	J-1(E)	+400 CFM
O/A PROVIDED AHI	J-1(N)	+100 CFM
BEF-1(N) & BEF-2(N	N) @70 CFM EACH	-140 CFM
EF-1(N) @70 CFM		-70 CFM
EF-2(N) @280 CFM		-280 CFM
BUILDING PRESSU	BF	+10 CFM

	FAN	SCHEDULE		
DESIGNATION	BEF-1(N)	BEF-2(N)	EF-1(N)	EF-2(N)
STATUS	NEW	NEW	NEW	NEW
QUANTITY	1	1	1	1
MANUFACTURER	GREENHECK	GREENHECK	GREENHECK	GREENHECK
MODEL	SP-A110	SP-A110	SP-A110	SP-A510
CFM	70 CFM AT 0.3 W.G. ESP	70 CFM AT 0.3" W.G. ESP	0 CFM AT 0.3" W.G. ESP	280 CFM AT 0.5' W.G. ESP
FLA (AMPS)	0.19	0.19	0.19	3.3
ACCESSORIES	BDD, LITE KIT	BDD, LITE KIT	BDD, LITE KIT	BDD, LITE KIT
WEIGHT (LBS)	17	17	17	31
VOLT/PH/HZ	115/1/60	115/1/60	115/1/60	115/1/60
NOTES	1,2,3	1,2,3	1,2,4	1,2,5
NOTES : 1. PROVIDE DISCONNE				

ROVIDE BAOK DRAFT DAMPER EF-1(N) & BEF-2(N) INTERCONNECT WITH AHU-1(N) E-1/NHHYTERCONNEST WITH ROOM HOAT

5. EF-2(N) INTERCONNECT WITH RTU-1(E).

		DIFFUSE	R SCHEDULE /1	$\overline{\lambda}$		NECK SIZE	ΞT
MANUFACTURER	EXISTING	TITUS	TITUS	TITUS	TITUS	FLEX DUCT DIA	
DESIGNATION	E	А	в	R	R1	Ø6"	
USE	SUPPLY/RETURN	SUPPLY	SUPPLY	RETURN	RETURN	00	
MODEL	EXISTING	300FS	TDC-AA	56FL	56FL	Ø8"	
MOUNTING	CEILING	DUCT	CEILING	SAT CEILING	WALL	Ø10"	
LOCATION	AS SHOWN	AS SHOWN	AS SHOWN	AS SHOWN	AS SHOWN	Ø12"	
FACE SIZE	EXISTING	16" X 6"	12" X 12"	24" X 24"	36" X 12"		
NECK SIZE	-	-	REFER TABLE A	-	-		
FRAME TYPE	LAYIN	FLANGED	LAY IN /FLANGED	LAY IN	FLANGED		
FINISH	WHITE	WHITE	WHITE	) WHITE	WHITE		
NOISE CRITERIA	<30	<30	<30	<30	<30		
ACCESSORIES	VOLUME DAMPER	VOLUME DAMPER	VOLUME DAMPER	VOLUME DAMPER	VOLUME DAMPER		

1. MOUNTING FRAME TYPE SHALL BE COORDINATED WITH CEILING/ WALL CONSTRUCTION.

2. COORDINATE FINAL FINISH/COLOR WITH ARCHITECT/OWNER.

3. CONTRACTOR TO FIELD VERIFY AND CONFIRM, EXISTING DIFFUSER ARE PROVIDED WITH VD, IF NOT PROVIDE AND INSTALL VD TO THE EXISTING DIFFUSER.

#### HVAC PIPING INSULATION NOTES

ALL INSULATION MATERIALS, INCLUDING JACKETS, FACING, ADHESIVE, COATINGS, AND ACCESSORIES ARE TO BE FIRE HAZARD RATED AND LISTED BY UNDERWRITERS LABORATORIES, INC. USING STEINER TUNNEL TEST METHOD FOR FIRE HAZARD CLASSIFICATION OF BUILDING MATERIALS, STANDARD UL 723 (ASTM E-84), (ASA A2.5-1963). FLAMESPREAD: MAXIMUM 25. FUEL CONTRIBUTED AND SMOKE DEVELOPED: MAXIMUM 50. FLAMEPROOFING TREATMENTS SUBJECT TO DETERIORATION FROM MOISTURE OR HUMIDITY ARE NOT ACCEPTABLE.

EXPOSED: INDOOR DUCTS, PIPING OR EQUIPMENT LOCATED IN MECHANICAL EQUIPMENT ROOMS AND IN AREAS WHICH WILL BE VISIBLE WITHOUT REMOVING CEILINGS OR OPENING ACCESS PANELS.


CONCEALED: INDOOR DUCTS, PIPING OR EQUIPMENT WHICH IS NOT EXPOSED.

OUTDOOR: DUCTS, PIPING OR EQUIPMENT WHICH IS EXPOSED TO THE WEATHER.

MINIMUM REFRIGERANT PIPE INSULATION THICKNESS (IN.)												
FLUID OPERATING	INSULATION CON	IDUCTIVITY	NOMINAL PIPE OR TUBE SIZE (IN.)									
TEMP. RANGE & USAGE (°F)	CONDUCTIVITY BTU.IN./(H.FT <sup>2</sup> .°F)	MEAN RATING TEMP., °F	<1	1 TO<1-1/2	1-1/2 TO <4	4 TO <8	≥8					
40 — 60	0.21 — 0.27	75	0.5	0.5	1.0	1.0	1.0					
< 40	0.20 — 0.26	75	0.5	1.0	1.0	1.0	1.5					

		T SCHEDULE			
		RTU-1(E)	-	UNIT TAG	AHU-1(N)
			-		MULTI-POSITION
MANUFACTURER MODEL			-		SEE PLAN
STATUS		2A5A0B0A0 & V.I.F.		SUPPLY AIR (CFM) OUTSIDE AIR (CFM)	
	E	ROOF	_	STATIC PRESS. (E.S.P.)	0.5
		.0 TONS		VOLTS/PH/HZ	208-230/1/60
		S.A.E	₹	TOT. COOLING CAP. (MBH)	12.0
TOTAL SENSIBLE COOLING		S.A.E	DA	COOLING SENS. CAP (MBH)	9.24
EER/SEER		S.A.E	AIR HANDLER DATA	MANUFACTURER	MITSUBISHI OR EQUIVALENT
TEATING MBH (INPUT)	11	5.0 & V.I.F	- IAN	MODEL NO.	PVA-A12AA7 OR EQUIVALENT
IEATING MBH (OUT.)		0.5 & V.I.F	AIR T	WEIGHT, LBS	113
AFUE (%)		S.A.E		ELECTRICAL HEATING KW	3.0
SUPPLY AIR (CFM)		1600	1	HEATER MODEL NO.	EH03-MPA-SB
OUTDOOR AIR (CFM)		400 1	-	MAX. UNIT AMPS	16.5/18.6
VOLTAGE/PHASE/HZ	208-23	80/3/60 & V.I.F		MAX. CKT. BRKR. AMPS	20/25
MCA (A)	24	1.0 & V.I.F	]	UNIT TAG	ACCU-1 (N)
MOCP (A)	30	).0 & V.I.F		AIR HANDLER SERVED	AHU-1 (N)
ESP (IN. OF W.G.)		S.A.E		CAPACITY	1.0 TR
WEIGHT (lbs)		S.A.E		REFRIGERANT	R410-A
NOTES:			ATA	COMPRESSOR RLA/LRA	7.0/12.0
1. EXISTING RTU-1(E) WI SAME AND TO BE REU		RIES TO REMAIN	UNIT DATA	OUTDOOR FAN FLA	0.50
2. S.A.E- SAME AS EXISTI	NG & V.I.F- VERIFY			V/Ph/Hz	208-230/1/60
3. CONTRACTOR TO FIEL WORKING AT THEIR		( )	SING	M.C.A. / M.C.B. AMPS	11.0/28.0
INFORM TO DESIGN E ARE FOUND IN	NGINEER IF ANY		CONDENSING	MANUFACTURER	MITSUBISHI OR EQUIVALENT
CONSTRUCTION.			NOC	MODEL# (CONDENSER)	PUY-A12NKA7 OR EQUIVALENT
4. CONTRACTOR TO FIEL CONFIGURATION OF U		LOCATION AND		TOT. COOLING CAP. (MBH)	12.0
5. IF REQUIRED, PROV	VIDE NEW THE			COOLING SENS. CAP (MBH)	9.24
TEMPERATURE SENS RTU-1(E). CO-ORDINAT				EER/SEER	13.4/21.4 92
WITH ARCHITECT/OWN 6. CONTRACTOR TO BAL		B & BETHBN AIB		WEIGHT, LBS	32
DAMPERS ON EXISTIN MENTIONED IN ABOVE	NG RTU-1(E) TO		SPLIT S		
7. REPLACE FILTERS, IF F			WI           2.         SL           3.         RE           4.         PR           5.         AL           6.         CO           7.         PR           8.         VE           9.         PR           CO         CO           10.         CO           11.         CO	TH ARCHITECT/OWNER. JPPLY AIR BASED ON HIGH SPEI FRIGERANT R410A SHALL BE PI OVIDE LOW AMBIENT CONTROL I REFRIGERANT PIPING TO BE COMMENDATION. ONTRACTOR TO PROVIDE A LON PING IN THE EVENT THAT T CEEDS THE MANUFACTURER' NGTH. OVIDE DRAIN PAN WITH WATEF FRIFY ALL DATA WITH MANUFA QUIPMENT. OVIDE CONDENSATE DRAIN ONDENSATE DRAIN FROM A UMBING DRAIN POINT NO ORDINATE WITH PLUMBING CO ONTRACTOR TO PROVIDE NE ONTROLS FOR THE PROPEF CATING KIT.	ROVIDED. L. E SIZED PER MANUFACTURERS NG LINE SET FOR REFRIGERANT TOTAL REFRIGERANT LENGTH S STANDARD RECOMMENDED R LEAK DETECTOR. CTURER PRIOR TO ORDERING PUMP IF REQUIRED. ROUTE AHU-1(N) TO THE NEAREST WITH APPROVED MANNER.
	NECK SIZE LEX DUCT DIA Ø6"	TABLE - A CFM RANGE 0-100	NS, WIRE	E SIZES, BREAKERS, DISCONNE	ECT ETC. PRIOR TO ORDERING
56FL	Ø8" Ø10"	201-400			

	TOP UNIT SCHEDULE	:	SPLIT SYSTEM	
NUOF		-	1	
	RTU-1(E)	_		AHU-1(N)
	GAS HEAT	_		MULTI-POSITION
	CARRIER		AREA SERVED	SEE PLAN
	48TCEA05A2A5A0B0A0 & V.I.I	₽.	SUPPLY AIR (CFM)	400
	EXISTING		OUTSIDE AIR (CFM)	
	ROOF		STATIC PRESS. (E.S.P.)	0.5
	4.0 TONS	⊿	VOLTS/PH/HZ	208-230/1/60
	S.A.E	AIR HANDLER DATA	TOT. COOLING CAP. (MBH)	12.0
NG MBH	S.A.E		COOLING SENS. CAP (MBH)	9.24
	S.A.E			MITSUBISHI OR EQUIVALENT
	115.0 & V.I.F	HA	MODEL NO.	PVA-A12AA7 OR EQUIVALENT
	90.5 & V.I.F	<b>A</b>	WEIGHT, LBS	113
	S.A.E		ELECTRICAL HEATING KW	3.0
	1600		HEATER MODEL NO.	EH03-MPA-SB
	400 1		MAX. UNIT AMPS	16.5/18.6
	208-230/3/60 & V.I.F		MAX. CKT. BRKR. AMPS	20/25
	24.0 & V.I.F	_		ACCU-1 (N)
	30.0 & V.I.F	_	AIR HANDLER SERVED	AHU-1 (N)
	S.A.E	_	CAPACITY	1.0 TR
	S.A.E		REFRIGERANT	R410-A
		ATA	COMPRESSOR RLA/LRA	7.0/12.0
WITH ALL EUSED.	L ACCESSORIES TO REMAIN	UNIT DATA	OUTDOOR FAN FLA	0.50
STING &	V.I.F- VERIFY IN FIELD.		V/Ph/Hz	208-230/1/60
	RIFY IF EXISTING RTU-1(E) IS RATED CAPACITIES/LOADS.	CONDENSING	M.C.A. / M.C.B. AMPS	11.0/28.0
n Engine	EER IF ANY DISCREPANCIES	DEN	MANUFACTURER	MITSUBISHI OR EQUIVALENT
N PER	FORMANCE PRIOR TO	ONE	MODEL# (CONDENSER)	PUY-A12NKA7 OR EQUIVALENT
FIELD VE	RIFY EXACT LOCATION AND	0	TOT. COOLING CAP. (MBH)	12.0
	NEW THERMOSTAT AND		COOLING SENS. CAP (MBH)	9.24
	OMPATIBLE WITH EXISTING AL LOCATION OF T-SENSOR		EER/SEER	13.4/21.4
WNER.			WEIGHT, LBS	92
	OUTSIDE AIR & RETURN AIR IU-1(E) TO MATCH VALUES		SYSTEM NOTES	
IF REQUI	RED.	2. SU 3. RE 4. PF 5. AL 6. CO PII EX 7. PF 8. VE 9. PF 8. VE 0. CO 10. CO CO HE 11. CO	CEEDS THE MANUFACTURER NGTH. NOVIDE DRAIN PAN WITH WATER RIFY ALL DATA WITH MANUFA QUIPMENT. NOVIDE CONDENSATE DRAIN ONDENSATE DRAIN FROM A UMBING DRAIN POINT W OORDINATE WITH PLUMBING CO ONTRACTOR TO PROVIDE NEI ONTROLS FOR THE PROPER EATING KIT.	ED. ROVIDED.  SIZED PER MANUFACTURERS IG LINE SET FOR REFRIGERANT 'OTAL REFRIGERANT LENGTH S STANDARD RECOMMENDED I LEAK DETECTOR. CTURER PRIOR TO ORDERING PUMP IF REQUIRED. ROUTE AHU-1(N) TO THE NEAREST WITH APPROVED MANNER. DNTRACTOR. CESSARY ACCESSORIES AND
	ACT ELECTRICAL CONNECTION ECK SIZE TABLE - A		E SIZES, BREAKERS, DISCONNE	ECT ETC. PRIOR TO ORDERING
FLEX D	06" 0-100 08" 101-200			
FLEX D Ø				

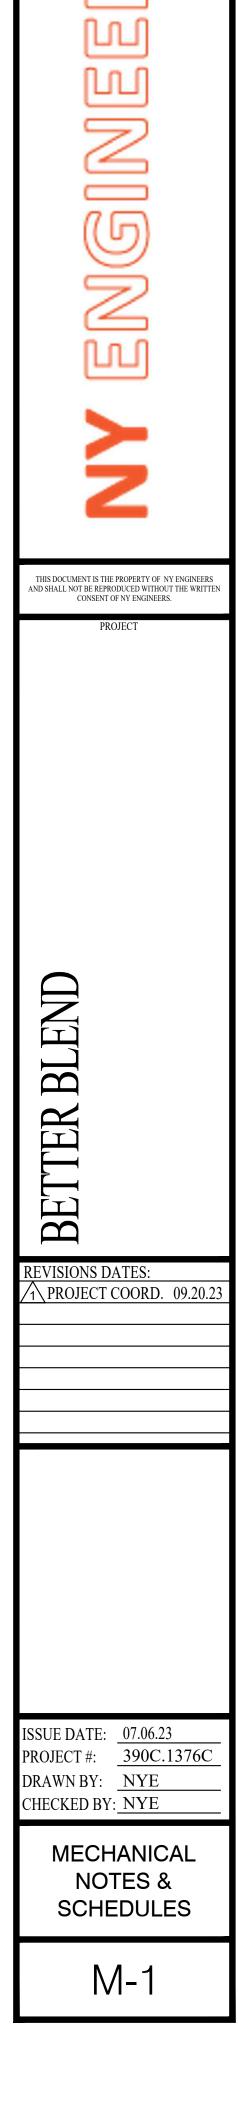

#### THERMOSTATIC CONTROL

#### C403.2.4.1 THERMOSTATIC CONTROLS

THE SUPPLY OF HEATING AND COOLING ENERGY TO EACH ZONE SHALL BE CONTROLLED BY INDIVIDUAL THERMOSTATIC CONTROLS CAPABLE OF RESPONDING TO TEMPERATURE WITHIN THE ZONE. WHERE HUMIDIFICATION OR DEHUMIDIFICATION OR BOTH IS PROVIDED, AT LEAST ONE HUMIDITY CONTROL DEVICE SHALL BE PROVIDED FOR EACH HUMIDITY CONTROL SYSTEM.

EXCEPTION: INDEPENDENT PERIMETER SYSTEMS THAT ARE DESIGNED TO OFFSET ONLY BUILDING ENVELOPE HEAT LOSSES OR GAINS OR BOTH SERVING ONE OR MORE PERIMETER ZONES ALSO SERVED BY AN INTERIOR SYSTEM PROVIDED:

- 1. THE PERIMETER SYSTEM INCLUDES AT LEAST ONE THERMOSTATIC CONTROL ZONE FOR EACH BUILDING EXPOSURE HAVING EXTERIOR WALLS FACING ONLY ONE ORIENTATION (WITHIN +/-45 DEGREES) (0.8 RAD) FOR MORE THAN 50 CONTIGUOUS FEET (15 240 MM); AND
- 2. THE PERIMETER SYSTEM HEATING AND COOLING SUPPLY IS CONTROLLED BY A THERMOSTATS LOCATED WITHIN THE ZONES SERVED BY THE SYSTEM.

#### C403.2.4.2 SET POINT OVERLAP RESTRICTION

WHERE USED TO CONTROL BOTH HEATING AND COOLING, ZONE THERMOSTATIC CONTROLS SHALL PROVIDE A TEMPERATURE RANGE OR DEADBAND OF AT LEAST 5°F (2.8°C) WITHIN WHICH THE SUPPLY OF HEATING AND COOLING ENERGY TO THE ZONE IS CAPABLE OF BEING SHUT OFF OR REDUCED TO A MINIMUM.

EXCEPTION: THERMOSTATS REQUIRING MANUAL CHANGEOVER BETWEEN HEATING AND COOLING MODES.

#### C403.2.4.3 OFF-HOUR CONTROLS

EACH ZONE SHALL BE PROVIDED WITH THERMOSTATIC SETBACK CONTROLS THAT ARE CONTROLLED BY EITHER AN AUTOMATIC TIME CLOCK OR PROGRAMMABLE CONTROL SYSTEM. EXCEPTIONS:

#### 1. ZONES THAT WILL BE OPERATED CONTINUOUSLY.

2. ZONES WITH A FULL HVAC LOAD DEMAND NOT EXCEEDING 6,800 BTU/H (2 KW) AND HAVING A READILY ACCESSIBLE MANUAL SHUTOFF SWITCH.


#### C403.2.4.3.1 THERMOSTATIC SETBACK CAPABILITIES


THERMOSTATIC SETBACK CONTROLS SHALL HAVE THE CAPABILITY TO SETBACKORTEMPORARILYOPERATETHESYSTEMTOMAINTAINZONETEMPERATURESDOWN TO 55°F (13°C)ORUP TO 85°F (29°C).

C403.2.4.3.2 AUTOMATIC SETBACK AND SHUTDOWN CAPABILITIES AUTOMATIC TIME CLOCK OR PROGRAMMABLE CONTROLS SHALL BE CAPABLE OF STARTING AND STOPPING THE SYSTEM FOR SEVEN DIFFERENT DAILY SCHEDULES PER WEEK AND RETAINING THEIR PROGRAMMING AND TIME SETTING DURING A LOSS OF POWER FOR AT LEAST 10 HOURS. ADDITIONALLY, THE CONTROLS SHALL HAVE A MANUAL OVERRIDE THAT ALLOWS TEMPORARY OPERATION OF THE SYSTEM FOR UP TO 2 HOURS; A MANUALLY OPERATED TIMER CAPABLE OF BEING ADJUSTED TO OPERATE THE SYSTEM FOR UP TO 2 HOURS; OR AN OCCUPANCY SENSOR.

#### C403.2.4.3.3 AUTOMATIC START CAPABILITIES

AUTOMATIC START CONTROLS SHALL BE PROVIDED FOR EACH HVAC SYSTEM. THE CONTROLS SHALL BE CAPABLE OF AUTOMATICALLY ADJUSTING THE DAILY START TIME OF THE HVAC SYSTEM IN ORDER TO BRING EACH SPACE TO THE DESIRED OCCUPIED TEMPERATURE IMMEDIATELY PRIOR TO SCHEDULED OCCUPANCY.

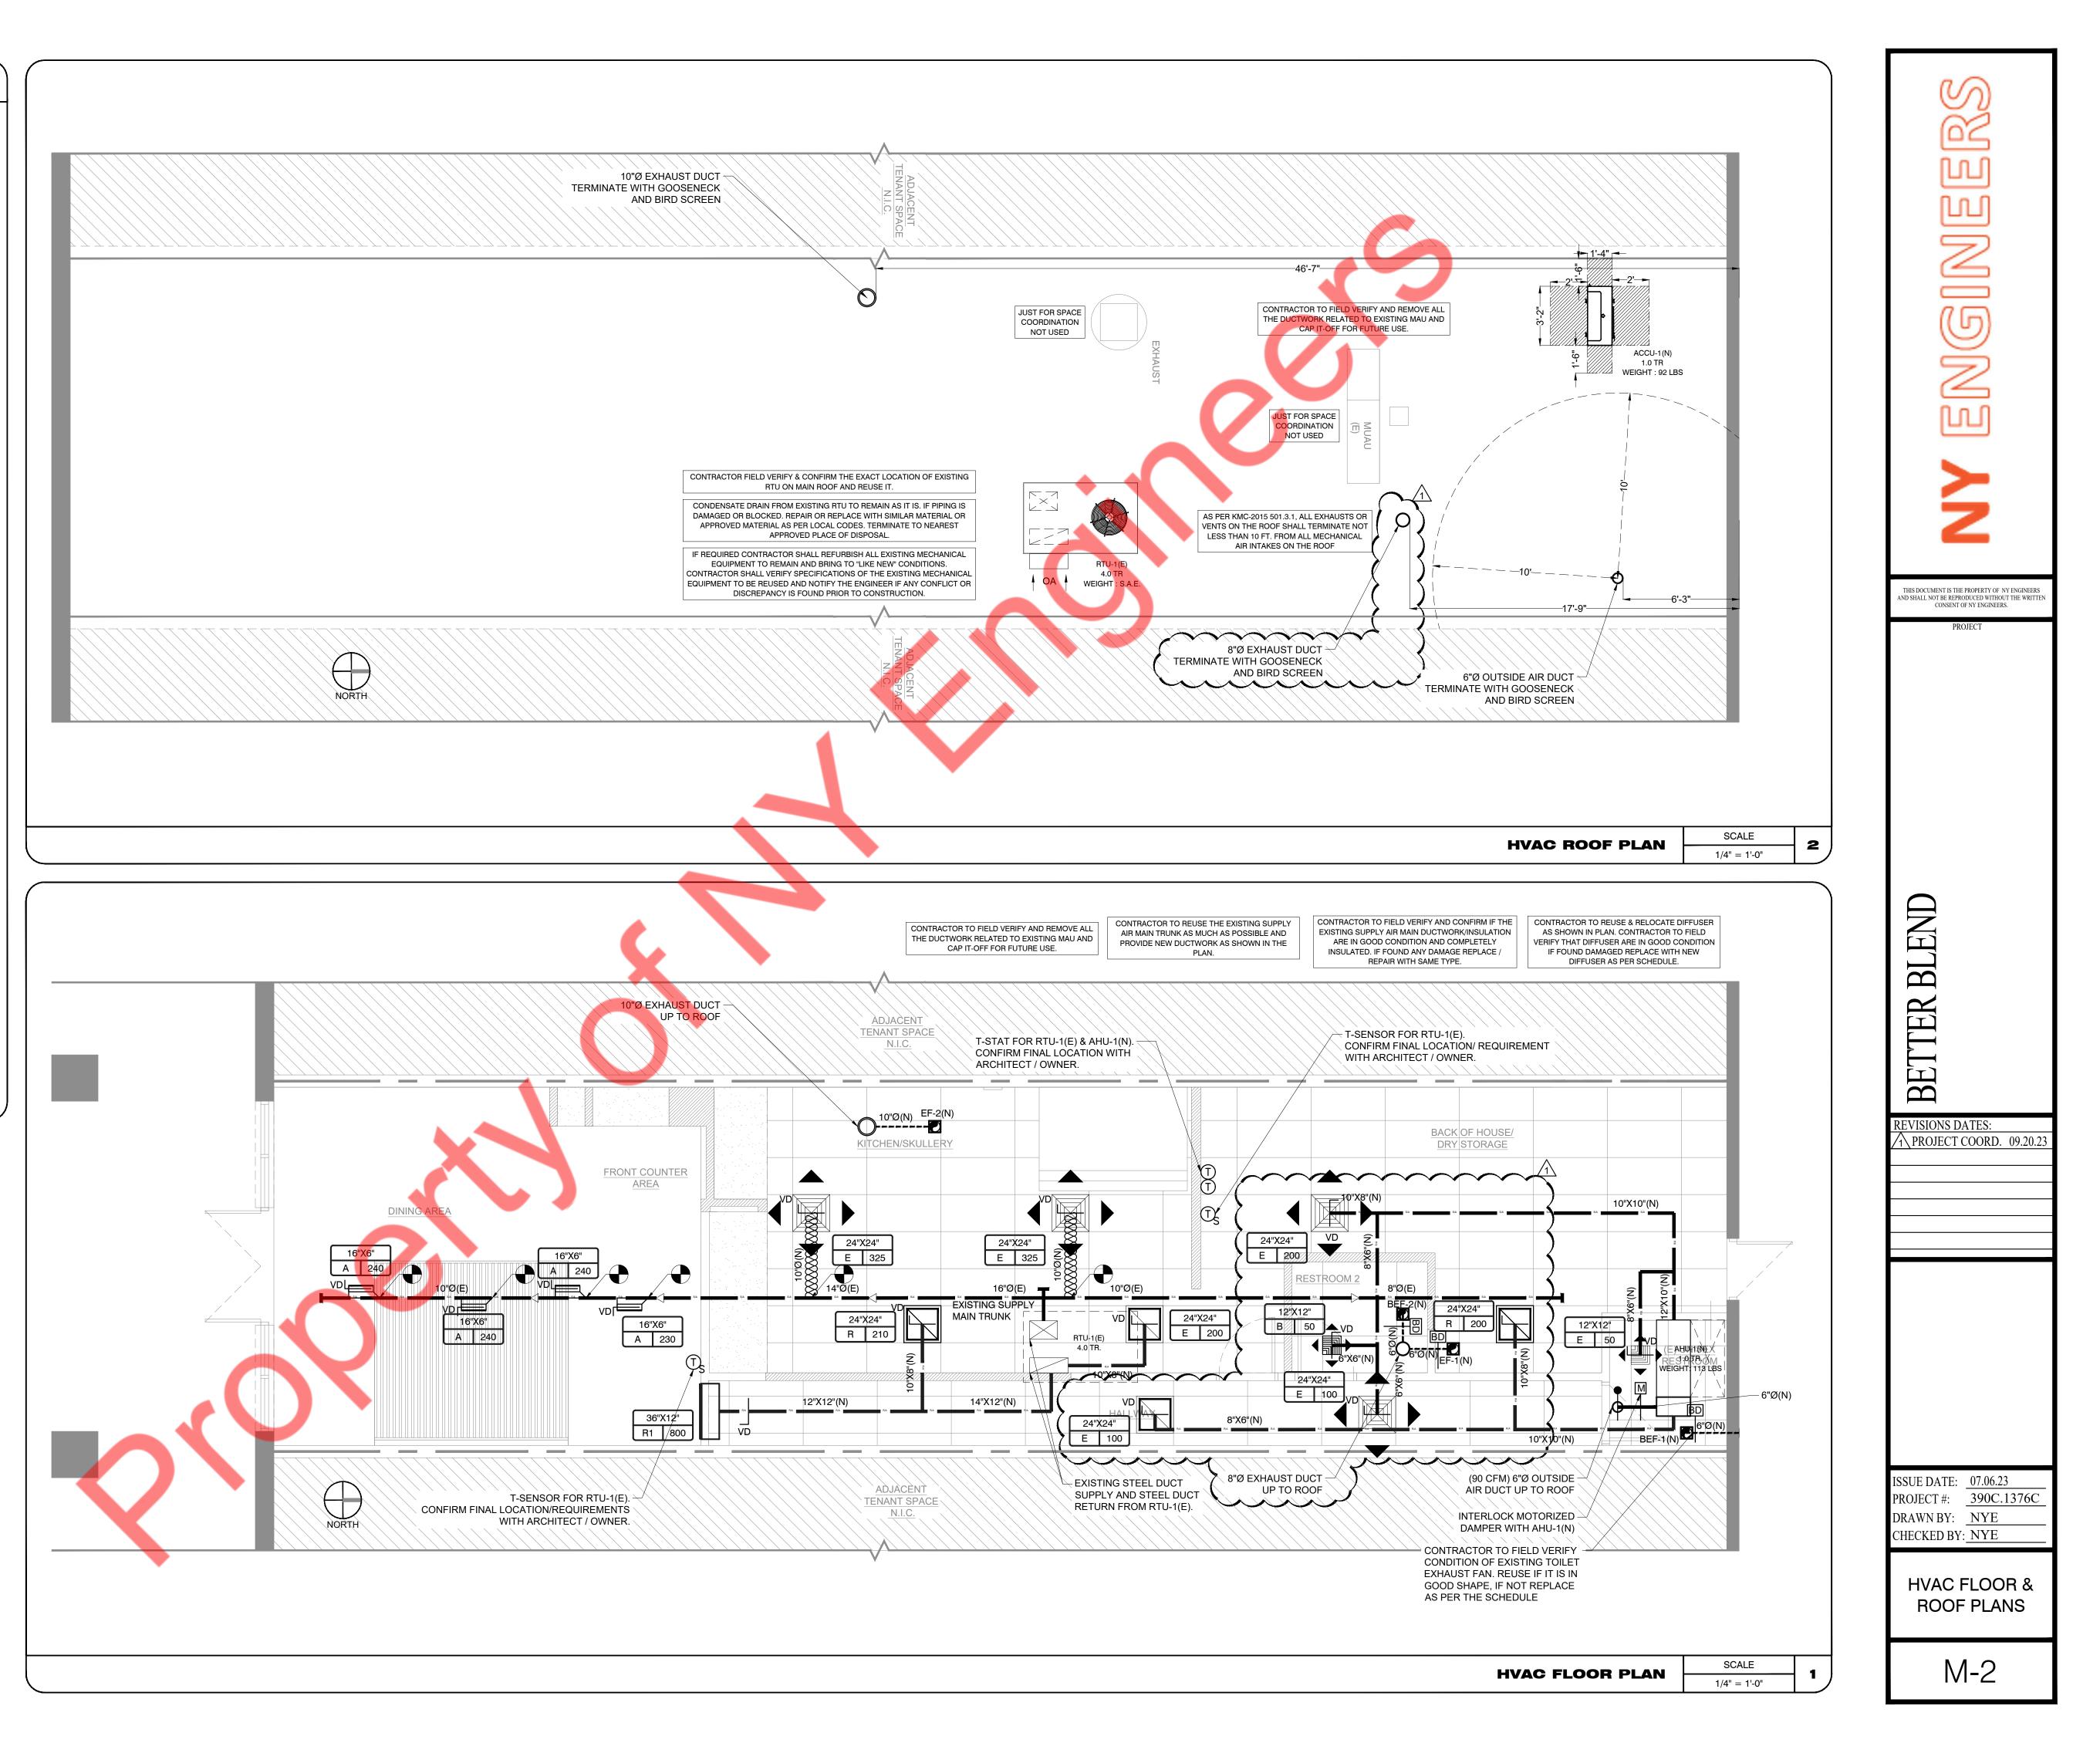

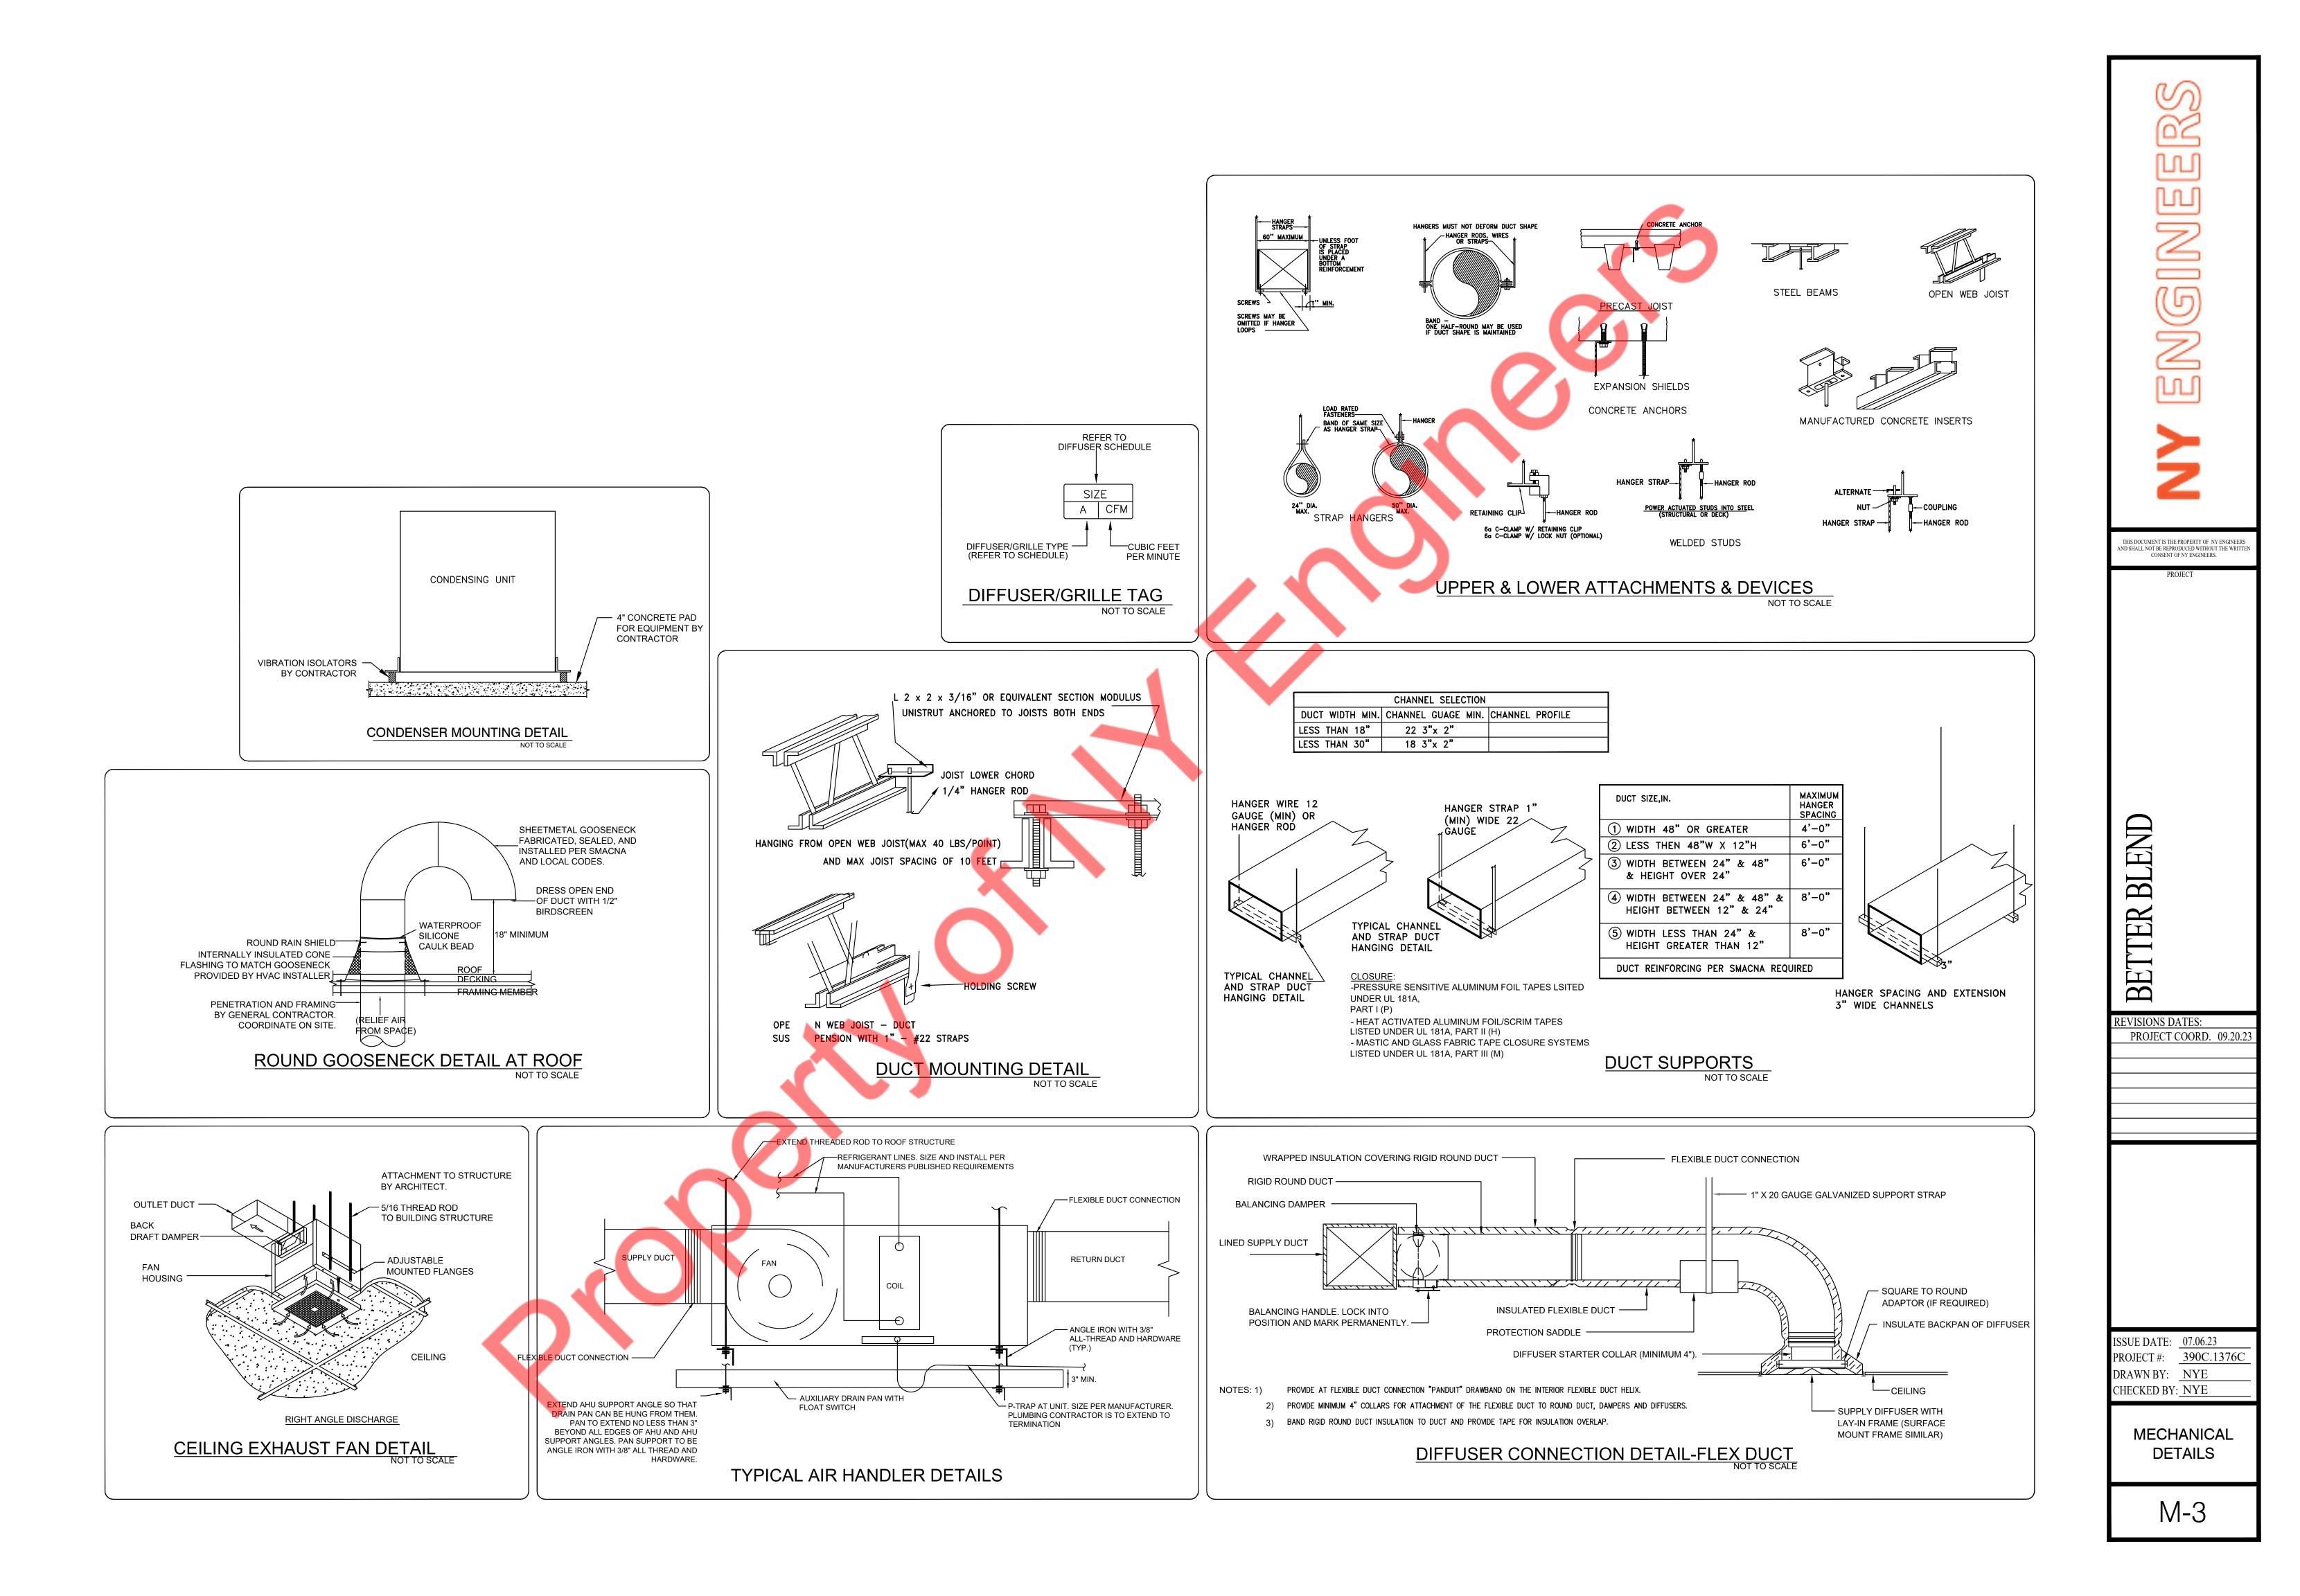

#### **ELECTRICAL PLAN NOTES**

	ELECTRICAL PLAN NOTES			GEN	
1.	ELECTRICAL CONTRACTOR SHALL REVIEW ALL DRAWINGS OF THIS SET.	32.	PROVIDE AND INSTALL CONDUIT, CONDUCTORS, PULL WIRES, BOXES, COVER PLATES, DEVICES, ETC. FOR ALL OUTLETS AS INDICATED.	A. UPP	ER CASE LETTER NEXT
2.	CONTRACTOR TO VERIFY THAT ALL EQUIPMENT SHOWN AS EXISTING MATCHES THE DESCRIPTIONS AND SPECIFICATIONS SHOWN ON DRAWINGS AND SCHEDULES. IF DIFFERENT, NOTIFY ARCHITECT/ENGINEER BEFORE BIDDING, ORDERING, OR PROCEEDING WITH WORK.	33.	MATERIALS, PRODUCTS, AND EQUIPMENT, INCLUDING ALL COMPONENTS THEREOF, SHALL BE NEW AND SUCH AS APPEAR ON THE UL LIST OF APPROVED ITEMS AND SHALL MEET OR EXCEED THE REQUIREMENTS OF		EMERGENCY FIXTURES
3.	ELECTRICAL CONTRACTOR SHALL SUPPLY AND INSTALL ALL NEW ELECTRICAL WORK INDICATED. CONSTRUCTION SHALL BE IN ACCORDANCE WITH DRAWINGS AND APPLICABLE SPECIFICATIONS. IF A PROBLEM IS	34.	N.E.C. NEMA, AND IECE. CONTRACTOR SHALL SUBMIT SHOP DRAWINGS OR CUT SHEETS OF LIGHTING FIXTURES, SWITCHES, AND OTHER ELECTRICAL ITEMS FOR APPROVAL BY		
	ENCOUNTERED IN COMPLYING WITH THIS REQUIREMENT, CONTRACTOR SHALL NOTIFY THE OWNER OR HIS REPRESENTATIVE AS SOON AS POSSIBLE AFTER DISCOVERY OF THE PROBLEM AND SHALL NOT PROCEED WITH THAT	35.	ENGINEER/ARCHITECT. ELECTRICAL CONTRACTOR SHALL BE RESPONSIBLE FOR ALL CUTTING,	ELE	CTRICAL LEG
	PORTION OF THE WORK UNTIL OWNER HAS DIRECTED CORRECTIVE ACTION TO BE TAKEN.	36	PATCHING AND FIRED CAULKING REQUIRED OF HIS WORK.	SYMBOL	DESCRIPTION
4.	ELECTRICAL CONTRACTOR SHALL VISIT JOB SITE AND FAMILIARIZE HIMSELF WITH ALL CONDITIONS AFFECTING ELECTRICAL AND COMMUNICATIONS		DIRECTORIES.		EXHAUST FAN
	INSTALLATION AND MAKE PROVISIONS AS TO THE COST THEREOF. EXISTING CONDITIONS OF ELECTRICAL EQUIPMENT, LIGHT FIXTURES, ETC. THAT ARE	37.	ALL ELECTRICAL OUTLETS SHALL BE AT 18" A.F.F. EXCEPT IN THE REHEARSAL AND MULTI-PURPOSE ROOM SHALL BE AT 24" UNLESS OTHERWISE NOTED.		JUNCTION BOX BATTERY BACK
	PART OF THE FINAL SYSTEM SHALL BE VERIFIED BY THE CONTRACTOR PRIOR TO SUBMITTING HIS BID.	38.	ALL LIGHT SWITCHES TO BE AT 42" A.F.F.		BATTERY BACK
5.	ALL WORK SHALL BE PERFORMED IN ACCORDANCE WITH THE 2017 EDITION OF THE NATIONAL ELECTRIC CODE AND ALL CODES AND ORDINANCES OF THE AUTHORITY HAVING JURISDICTION.	39.	ALL ELECTRICAL WIRING SHALL BE THE RESPONSIBILITY OF THE ELECTRICAL CONTRACTOR. ALL ELECTRICAL WIRING FOR HVAC SYSTEM INCLUDING CONTROLS, THERMOSTATS, POWER, ETC. SHALL BE THE RESPONSIBILITY OF THE ELECTRICAL CONTRACTOR.	\$ \$ \$	WALL SWITCH (S WALL SWITCH ( WALL SWITCH (
6.	DO NOT SCALE THE ELECTRICAL DRAWINGS. REFER TO ARCHITECTURAL PLANS AND ELEVATIONS FOR EXACT LOCATION FOR ALL EQUIPMENT. CONFIRM WITH OWNER'S REPRESENTATIVE.	40.	BREAKER AND PANELS ALL CURRENT CARRYING BUSSES SHALL BE COPPER. ALL GROUND BUS BARS SHALL BE COPPER. PANEL BOARD ENCLOSURES SHALL BE FURNISHED WITHOUT PRE-PUNCHED CONCENTRIC		DIMMER WALL S OCCUPANCY SE
7.	ALL ELECTRICAL NOT BEING REUSED MUST BE REMOVED IN ITS ENTIRETY.		HOLES. A.I.C. RATINGS SHALL BE AS INDICATED ON PANEL BOARD SCHEDULES.	Φ <sub>A</sub>	SIMPLEX RECER
8.	ALL CONDUIT IN OR UNDERGROUND OR IN CONCRETE MUST BE RIGID GALVANIZED STEEL.	41.	DISCONNECT SWITCHES SHALL BE H.P. RATED, GENERAL DUTY, QUICK-MAKE,		A - NEMA 5-15R B - NEMA 6-15R
9.	CIRCUIT BREAKERS AND PANELS TO BE BOLT ON TYPE	12	QUICK-BREAK ENCLOSURES AS REQUIRED BY EXPOSURE.		C - NEMA 14-30F D - NEMA 14-50F
10	ALL EQUIPMENT SHALL BE APPROVED BY UL OR OTHER NATIONALLY RECOGNIZED TESTING COMPANY.		RELAYS IN EACH HOT LEG.		E - NEMA L6-30R DUPLEX RECEPT
11	ALL RECEPTACLES SHALL BE GROUNDED AS REQUIRED BY NEC 250.146	43.	THE TERM "PROVIDE" USED IN THE CONSTRUCTION DOCUMENTS AND SPECIFICATIONS INDICATES THE CONTRACT SHALL FURNISH AND INSTALL.	<b>+</b>	DUPLEX RECEPT
12	SUBMIT SERVICE ENTRANCE EQUIPMENT FOR SEPARATE APPROVAL.	44.	CONTRACTOR SHALL CONFIRM WITH ANY AND ALL REQUIREMENTS SUCH AS: LUG SIZE RESTRICTIONS, CONDUIT ENTRY, TRANSFORMER SIZE, SCHEDULED		HALF SWITCHED
13	ALL LOW VOLTAGE MUST BE IN CONDUIT TO ABOVE THE DROP CEILING. BRIDAL RINGS OR "J" HOOKS REQUIRED.		DOWN TIME FOR OWNERS CONFIRMATION, ETC. ANY CONFLICTS SHALL BE BROUGHT TO ATTENTION OF THE ENGINEER BEFORE PROCEEDING WITH		QUADRUPLEX R
14	SEPARATE PERMITS ARE REQUIRED FOR ALL LOW VOLTAGE SUCH AS		ANY WORK.		FLOOR MOUNTE
15	TELEPHONE, DATA, THERMOSTAT, MUSIC, ALARMS ETC.	45.	VOLTAGE DROP FOR ALL BRANCH CONDUCTORS SHALL NOT EXCEED 3%. WHERE VOLTAGE DROP EXCEEDS 3%, CONTRACTOR SHALL INCREASE SIZE OF CONDUCTORS.		FLOOR MOUNTE
	PRIOR TO ANY CONSTRUCTION WORK BEGINNING AN ON-SITE MEETING WITH	46.			USB CHARGER F
	GENERAL CONTRACTORS IS REQUIRED.		CIRCUITS OR GFI PROTECTION FOR THE WHOLE CIRCUIT.		ELECTRICAL PAI
	ELECTRICIAN MUST BE ON SITE FOR ALL INSPECTIONS. MINIMUM WIRE SIZE SHALL BE #12 A.W.G. EXCLUDING CONTROL WIRING. ALL		GAS PIPING SHALL BE BONDED. ELECTRICAL CONTRACTOR SHALL COORDINATE SERVICE ENTRY WITH		DISCONNECT SV
10	CONDUCTORS SHALL BE COPPER AND UNLESS OTHERWISE NOTED THHN INSULATION.	40.	SERVICE PROVIDER PRIOR TO DETERMINING EXACT LOCATION OF THE METER BOX IN ORDER TO AVOID DISCREPANCIES BETWEEN DRAWINGS AND		TELEVISION OUT
19	OUTLET BOXES SHALL BE PRESSED STEEL IN DRY LOCATIONS, PLASTIC AND		JOB CONDITIONS.		TELEPHONE/DA
	CAST ALLOY WITH THREADED HUBS IN WET OR DAMP LOCATIONS, AND SPECIAL ENCLOSURES FOR OTHER CLASSIFIED AREAS.		ALL OUTDOOR EQUIPMENT SHALL BE WEATHERPROOF.		DATA OUTLET FLOOR MTD. FLU
20	. IT IS NOT THE INTENT OF THESE PLANS TO SHOW EVERY MINOR DETAIL OF CONSTRUCTION. THE CONTRACTOR IS EXPECTED TO FURNISH AND INSTALL	50.	PROVIDED TO THE OWNER WITHIN 30 DAYS AFTER THE DATE OF ACCEPTANCE. PROVIDE A COPY TO LL.		QUAD. DATA OU
	ALL ITEMS FOR A COMPLETE ELECTRICAL SYSTEM AND PROVIDE ALL REQUIREMENTS NECESSARY FOR EQUIPMENT TO BE PLACED IN PROPER	51.	OPERATION MANUALS AND MAINTENANCE MANUALS SHALL BE PROVIDED TO		CEILING MTD. D
21	WORKING ORDER.	52.	THE BUILDING OWNER. ABSOLUTELY NO FLEXIBLE CONDUIT IS PERMITTED IN DEMISING WALLS.		NON FUSED DIS AS NOTED
	REQUIRED BY THE N.E.C. OR LOCAL CODES.		FLEXIBLE CONDUIT IS PERMITTED FOR SHORT FINAL CONNECTIONS ONLY (6'-0" OR LESS).	SM	MOTOR SWITCH
22	ALL MATERIALS SHALL BE NEW AND BEAR UNDERWRITERS' LABELS WHERE APPLICABLE.	53.	EXPOSED CONDUIT SHALL BE INSTALLED IN STRAIGHT LINES, PARALLEL OR IN RIGHT ANGLES TO THE BUIDING STRUCTURE. DO NOT LOOP EXCESS		
23	ALL WORK SHALL BE PERFORMED BY A LICENSED ELECTRICAL CONTRACTOR IN A FIRST CLASS WORKMANLIKE MANNER. THE COMPLETED SYSTEM SHALL BE FULLY OPERATIVE AND ACCEPTED BY ENGINEER/ARCHITECT.		FLEXIBLE CONDUIT IN CEILING SPACE OR WALL CAVITY. NO CONDUIT TO BE SUPPORTED FROM THE ROOF DECK. CABLE TYPES AC AND NM CABLES ARE NOT ACCEPTABLE. TYPE MC CABLE.	AB	<u>EVIATIONS</u> : DVE FINISH FLOOR= A.F.F. UNTER TOP LEVEL= C
	ALL WORK SHALL BE COORDINATED WITH OTHER TRADES TO AVOID INTERFERENCE WITH THE PROGRESS OF CONSTRUCTION.		ELECTRIC METALLIC TUBING (EMT) AND RIGID GALVANIZED CONDUIT ARE PERMITTED.	GR VE	OUND FAULT INTERRUPTER: RIFY PRIOR TO INSTALL= VH ATHER PROOF= WP
25	ELECTRICAL CONTRACTOR SHALL GUARANTEE ALL MATERIALS AND WORKMANSHIP FREE FROM DEFECTS FOR A PERIOD OF NOT LESS THAN ONE YEAR FROM DATE THAT CERTIFICATE OF OCCUPANCY IS ISSUED. WARRANTY SHALL BE PROVIDED IN WRITING. PROVIDE COPY TO LL.		ALL EQUIPMENT, DEVICES AND FIXTURES SHALL BE GROUNDED IN COMPLIANCE WITH NEC AND UL REQUIREMENTS. ALL PANELS TO BE UL LABELED WITH BOLT-ON TYPE CIRCUIT BREAKERS.	ELE	CIRCULATION PUMP= RCP ECTRICAL CONTRACTOR= EC OF TOP UNIT= RTU
26	CORRECTION OF ANY DEFECTS SHALL BE COMPLETED WITHOUT ADDITIONAL CHARGE AND SHALL INCLUDE REPLACEMENT OR REPAIR OF ANY OTHER PHASE OF THE INSTALLATION WHICH MAY HAVE BEEN DAMAGED THEREBY.	57.	LIGHTS, SHOW WINDOW LIGHTS, SHOW WINDOW RECEPTACLES AND STOREFRONT SIGNAGE. ILLUMINATED STOREFRONT SIGNS MUST REMAIN	AIF	COOLED CONDENSING UNI
27	ALL REQUIRED INSURANCE SHALL BE PROVIDED FOR PROTECTION AGAINST PUBLIC LIABILITY AND PROPERTY DAMAGE FOR THE DURATION OF THE WORK.	58.	LIT DURING ALL MALL BUSINESS HOURS. TENANT IS REQUIRED TO MAKE A FIELD SURVEY OF THE EXISTING ELECTRICAL SERVICE TO ENSURE THAT THE TOTAL CONNECTED LOAD DOES NOT EXCEED THE ELECTRIC SERVICE. ANY/ALL MODIFICATIONS OR		
28	CONTRACTOR SHALL PAY FOR ALL PERMITS, FEES, INSPECTIONS AND TESTING. CONTRACTOR TO OBTAIN PERMIT AND APPROVED SUBMITTALS PRIOR TO BEGINNING WORK OR ORDERING EQUIPMENT.		UPGRADES NEEDED ARE SUBJECT TO LANDLORD'S PRIOR APPROVAL AND WILL BE COMPLETED BY TENANT/TENANT'S GC AT TENANT'S SOLE EXPENSE.		
29	THE ELECTRICAL INSTALLATION SHALL MEET ALL STANDARD REQUIREMENTS OF POWER AND TELEPHONE COMPANIES.		ALL ELECTRICAL PANELS TO BE MOUNTED ON PLYWOOD BACKER BOARD. PANEL PHASE LOADS TO BE BALANCED WITHIN 10%.		
30	OF POWER AND TELEPHONE COMPANIES. CONTRACTOR SHALL COORDINATE WITH MECHANICAL DRAWINGS AND PROVIDE ALL NECESSARY CONTROL WIRING.		ALL THE ELECTRICAL BOXES SHALL BE SEALED.		
31	ALL CIRCUIT BREAKERS FEEDING MECHANICAL EQUIPMENT SHALL BE HACR TYPE CIRCUIT BREAKERS.			J	
$\overline{\ }$				/	

#### **SCOPE OF WORK**

1. REUSE THE EXISTING 200A, 120/208V, 3-PHASE, 4-WIRE ELECTRICAL SERVICE. 2. REUSE EXISTING 200A, 120/208V, 3-PHASE, 4-WIRE ELECTRICAL METER & BREAKER SWITCH IN THE EXISTING ELECTRICAL METER BANK FOR THE PROPOSED TENANT SPACE.

- 3. REUSE EXISTING (1) 200A(M.L.O), 120/208V, 3-PHASE, 4-WIRE ELECTRICAL PANEL "L".
- 4. PROVIDE NEW ADDITIONAL 60A(M.L.O), 120/208V, 1-PHASE, 3-WIRE ELECTRICAL PANEL "M". 5. ALL NECESSARY EQUIPMENT, WIRING AND LIGHTING FOR THE PROJECT SPACE INCLUDING WIRING FOR VENTILATION EQUIPMENT. COORDINATE WITH G.C FOR LOW VOLTAGE WIRING.

#### **GENERAL LIGHTING NOTES**

ITER NEXT TO LIGHT FIXTURE DENOTES FIXTURE TYPE FIXTURES SHALL BE CONNECTED TO AN UNSWITCHED HOT

Y FIXTURES SHALL BE CONNECTED TO AN UNSWITCHED HOT
AL LEGEND
CRIPTION
AUST FAN
CTION BOX
FERY BACK UP EXIT LIGHT
IERY BACK UP EMERGENCY LIGHT L SWITCH (SINGLE, DOUBLE, )
L SWITCH (SINGLE, DOUBLE, ) L SWITCH (3 WAY, 4 WAY)
L SWITCH (TIMER)
AER WALL SWITCH
UPANCY SENSOR WALL SWITCH
PLEX RECEPTACLE, +18" AFF OR AS NOTED.
FIX DENOTES FOLLOWING:
IEMA 5-15R
EMA 6-15R
IEMA 14-30R IEMA 14-50R
EMA L6-30R
LEX RECEPTACLE
LEX RECEPTACLE, 46" TO AFF AT KITCHEN, BATHS AND TOPS
SWITCHED DUPLEX RECEPTACLE
/OLT RECEPTACLE
DRUPLEX RECEPTACLE
DR MOUNTED. FLUSH DUPLEX RECEPTACLE
DR MOUNTED. FLUSH QUAD. RECEPTACLE
DR MOUNTED. FLUSH 230 VOLT RECEPTACLE
CHARGER RECEPTACLE
ING MOUNTED DUPLEX RECEPTACLE
CTRICAL PANEL
CONNECT SWITCH
VISION OUTLET
EPHONE OUTLET
A OUTLET
OR MTD. FLUSH TELEPHONE/DATA OUTLET
D. DATA OUTLET RJ45
ING MTD. DATA OUTLET
FUSED DISCONNECT SWITCH AMPERAGE AND NUMBER OF POLES

FUSED DISCONNECT SWITCH AMPERAGE AND NUMBER OF POLES

OR SWITCH

OOR= A.F.F.	BELOW COUNTER= BC
EVEL= C	PUSH BUTTON= PB
NTERRUPTER= GFCI	UNDER CABINET= UC
) INSTALL= VH	NIGHT LAMP= NL
F= WP	WATER HEATER EXISTING = WH-E
PUMP= RCP	EXHAUST FAN= EF
ITRACTOR= EC	AUTHORITY HAVING JURISDICTION= AHJ
RTU	AIR HANDLING UNIT = AHU
IDENSING UNIT= ACCU	BATHROOM EXHAUST FAN= BEF

	TYPE	DESCRIPTION	MANUFACTURER	CATALOG NUMBER
	В	2x2 RECESSED LAY-IN FLUORESCENT	ORACLE	22-FPL-BL-LED-2000L/3000L/4000L-DIM10-MVOLT-35
$\odot$	С	INCANDESCENT PENDANT LIGHT	OIUSQBH	O-0815
O	D	RECESSED COMPACT FLUORESCENT	JUNO	JPDZ4 DC ALO10 SWW5WD 90CRIXXX MVOLT ZT
	G	SUSPENDED LINEAR LED	TBD	TBD
<b>*</b>	хс	EXIT SIGN/EMERGENCY LIGHT COMBO	LITHONIA	ECR-LED
<u>~~</u> >	EU	WALL-MOUNTED EMERGENCY LIGHTS	LITHONIA	ELM-2
\$т	т	TIMER WALL SWITCH	LEVITON	6124
\$os		OCCUPANCY WALL SWITCH	LEVITON	ODS10
(os		CEILING OCCUPANCY SENSOR	LEVITON	O2C10-UDW
DS		DAYLIGHT SENSOR	-	
	(E)	EXISTING FIXTURE SHALL REMAIN	-	
	(R)	EXISTING FIXTURE REUSED AND RELOCATED	-	

ON RECORD FOR ANY DISCREPANCIES. BASE BID ACCORDINGLY.

ELECTRICAL RISER KEYED NOTES:

 $\underline{\land}$ 

|(M)|

EXISTING 200A, 120/208V, 3-PHASE, 4-WIRE ELECTRICAL METER AND BREAKER SWITCH IN THE EXISTING METER BANK FOR THE PROJECT SPACE SHALL REMAIN. E.C. SHALL COORDINATE WITH BASE BUILDING FOR THE EXACT LOCATION OF THE EXISTING METER BANK AND EXACT POWER DISTRIBUTION IN THE FILED. E.C SHALL VERIFY THE OPERABLE CONDITION OF EXISTING METER & BREAKER SWITCH, REPLACE IF INOPERABLE. BASE BID ACCORDINGLY.

INCOMER


SECTION


(E)

- TO THE ELECTRICAL PANEL 'L' FOR THE PROJECT SPACE FROM THE EXISTING ELECTRICAL METER BANK. E.C. SHALL GET INFORMATION ABOUT THE EXISTING POWER DISTRIBUTION PRIOR TO COMMENCING ANY WORK AND INFORM ENGINEER ON RECORD FOR ANY DISCREPANCIES. BASE BID ACCORDINGLY.
- C EXISTING 200A(M.L.O), 120/208V, 3-PHASE, 4-WIRE ELECTRICAL PANEL "L" TO REMAIN. E.C. TO FIELD VERIFY THE EXACT SIZE, LOCATION & OPERABLE CONDITION OF THE PANEL, REPLACE IF FOUND INOPERABLE. BASE BID ACCORDINGLY.
- D EXISTING INCOMING FEEDER TO REMAIN. E.C. TO VERIFY OPERABLE CONDITION OF FEEDER IN FIELD AND PROVIDE NEW IF FOUND INOPERABLE. BASE BID ACCORDINGLY.
- NEW 60A(M.L.O), 120/208V, 1-PHASE, 3-WIRE ELECTRICAL PANEL "M". E.C. SHALL COORDINATE EXACT LOCATION WITH ARCHITECT/OWNER. SHALL COORDINATE EXACT LOCATION WITH ARCHITECT/OWNER.

ELECTRICAL GENERAL NOTES:

- 1. ABOVE RISER DIAGRAM IS FOR REFERENCE PURPOSES ONLY. E.C. SHALL VERIFY EXACT POWER DISTRIBUTION IN FIELD AND INFORM ENGINEER ON RECORD FOR ANY DISCREPANCY.
- 2. E.C. SHALL VERIFY INCOMING SERVICE AMPERAGE, WIRE SIZING AND DISTRIBUTION.
- 3. ELECTRICAL CONTRACTOR TO COORDINATE FAULT CURRENT (Isc) RATING WITH UTILITY COMPANY AND AHJ PRIOR TO COMMENCING ANY WORK.
- 4. E.C. TO VERIFY OPERABLE CONDITIONS OF EXISTING DEVICES IN FIELD. REPLACE/RECTIFY IF FOUND IN OPERABLE. BASE BID ACCORDINGLY.
- 5. EXISTING ELECTRICAL DISTRIBUTION TO BE MAINTAINED AND UTILIZED TO SERVE PROJECT SPACE.

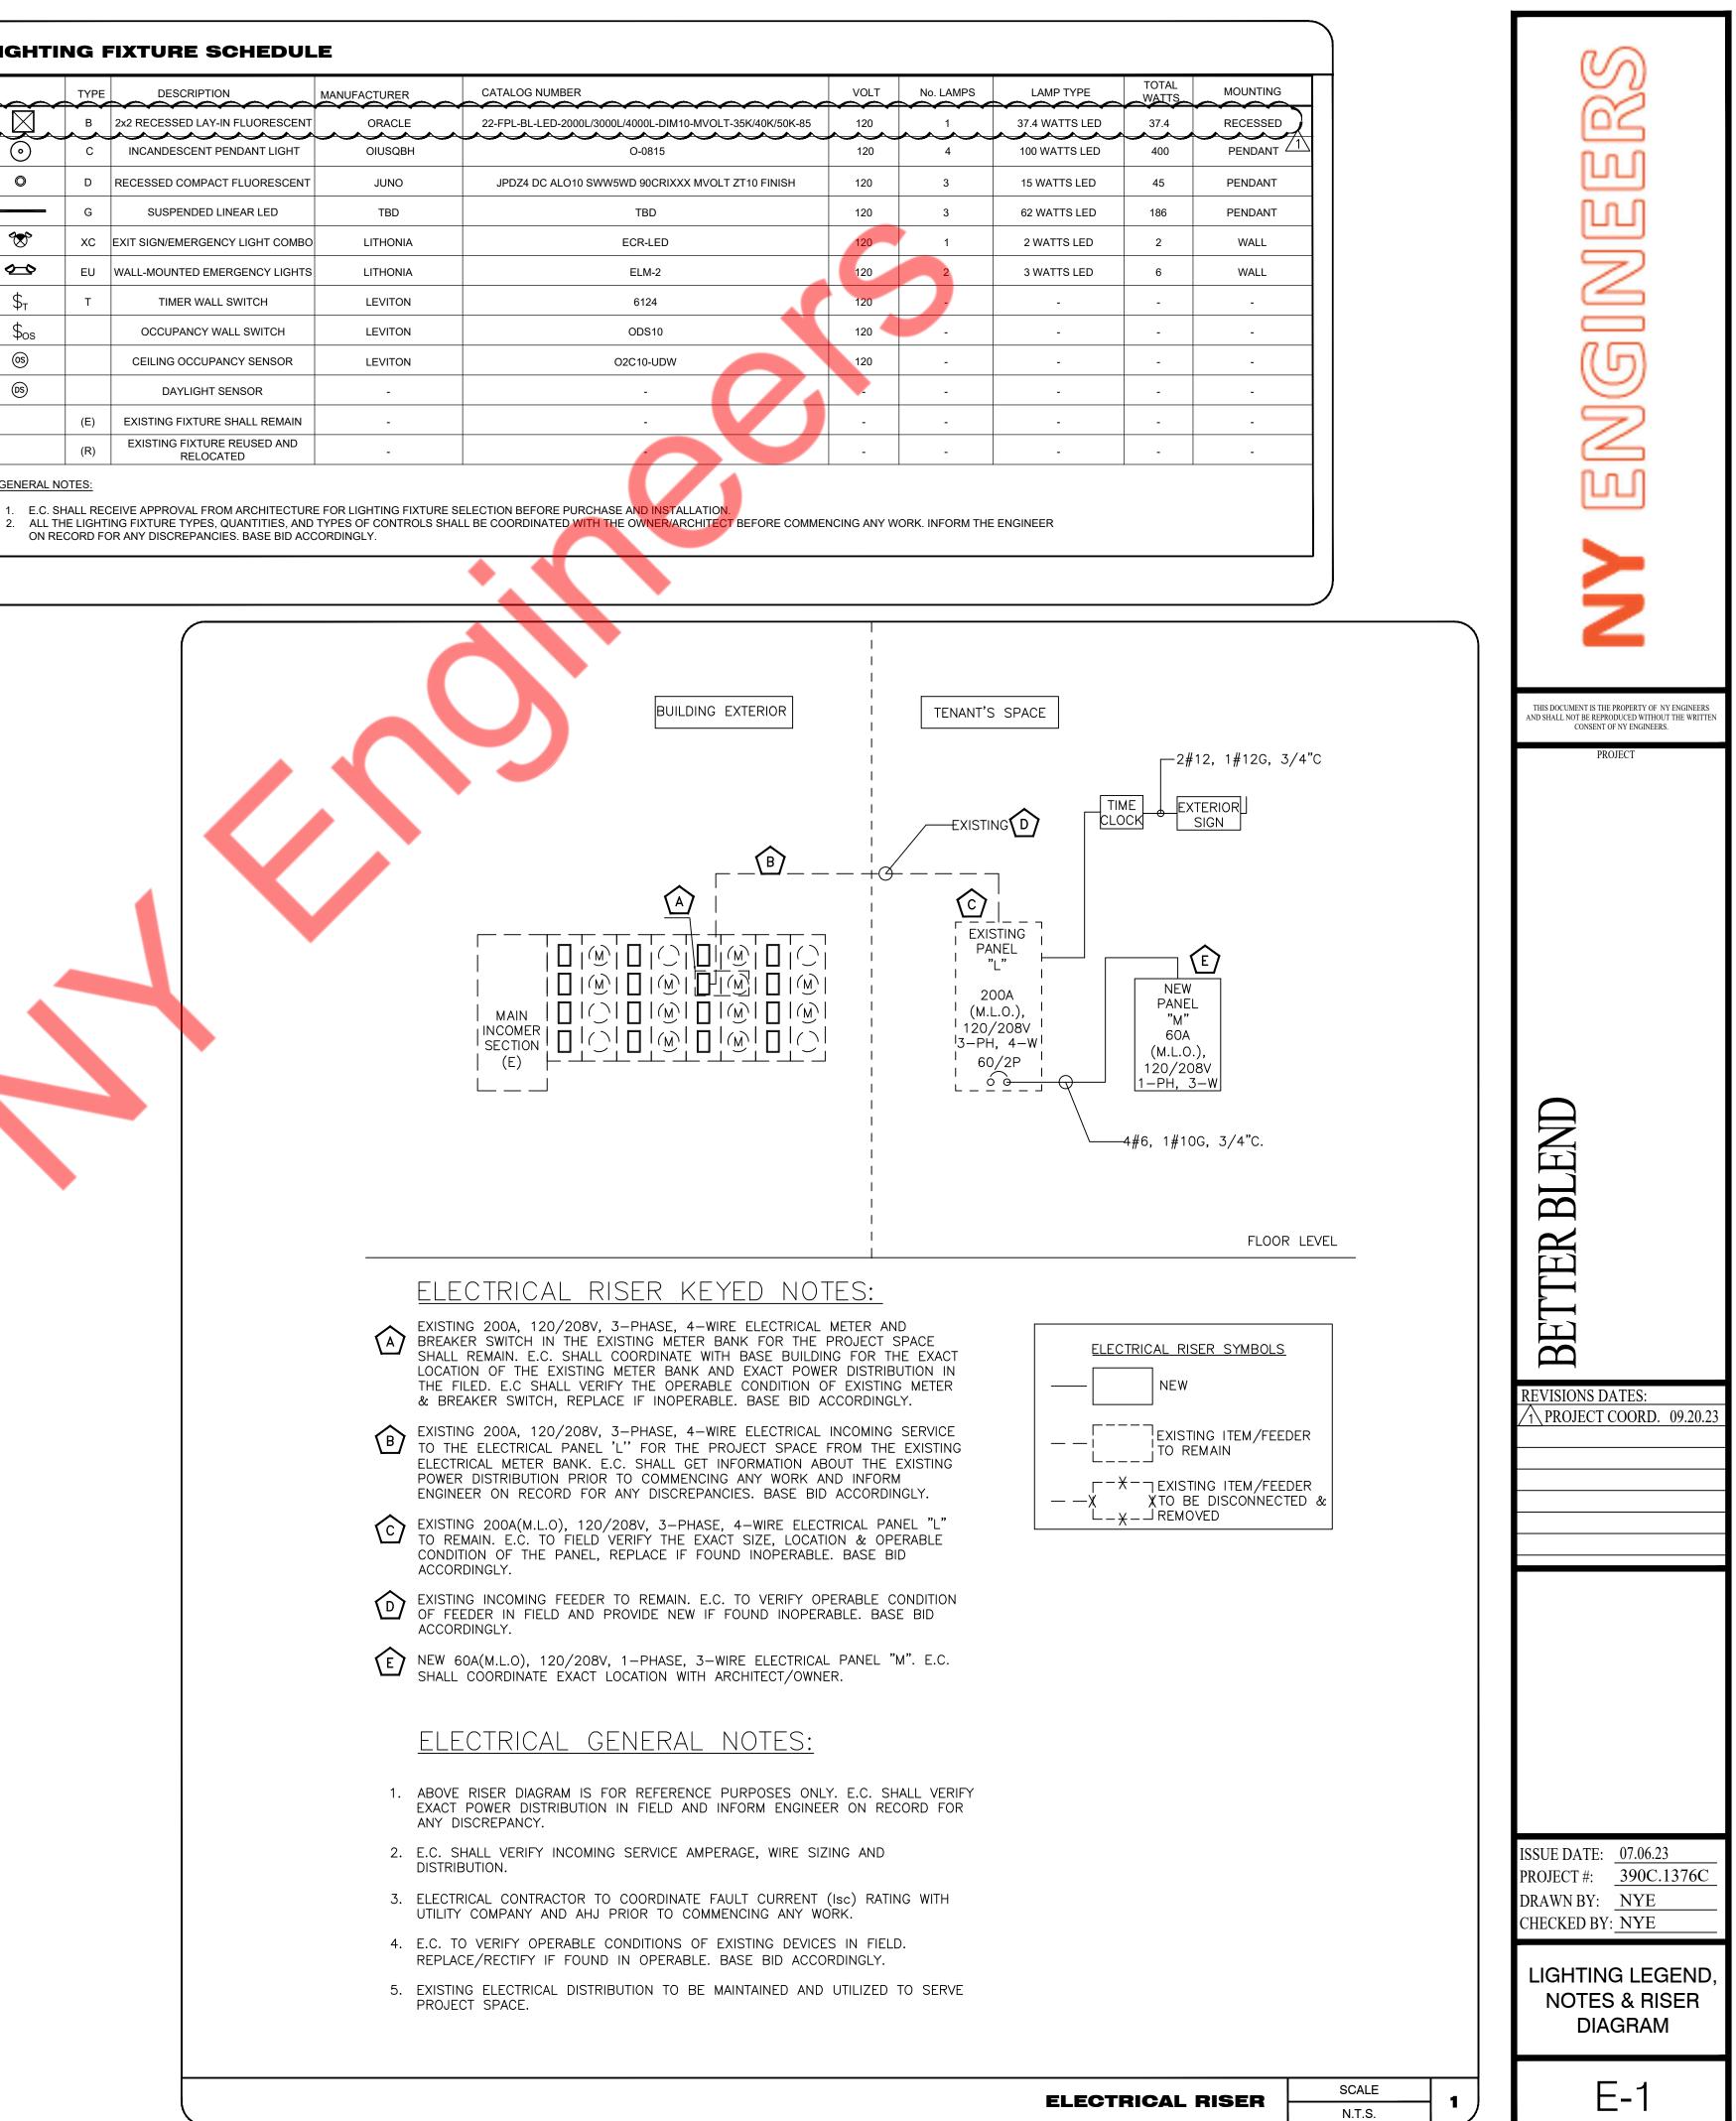

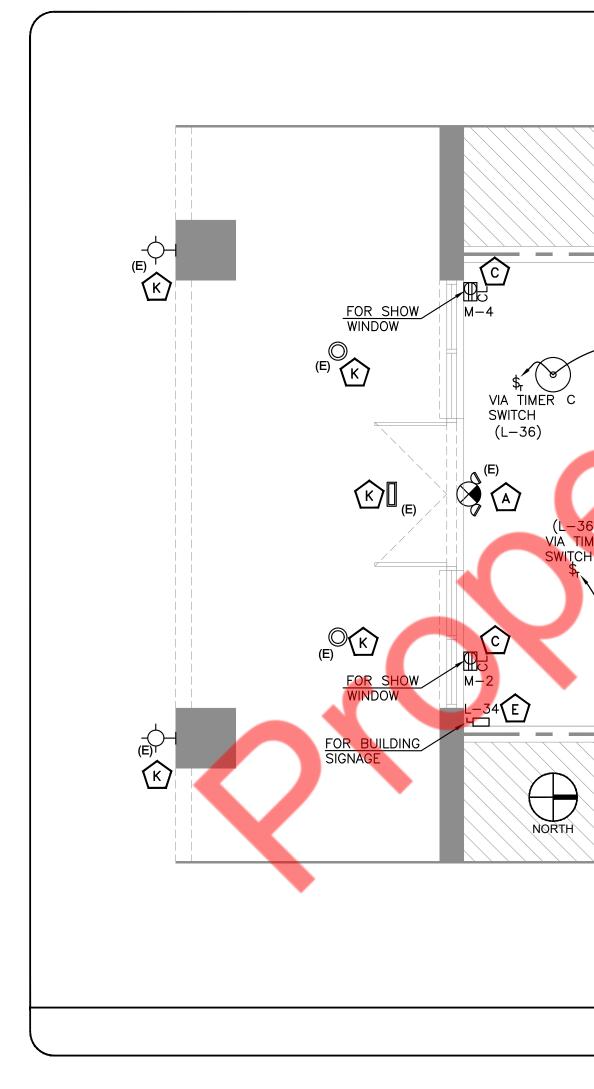

ELECTRICAL LIGHTING PLAN GENERAL NOTES: 1. COORDINATE FINAL FIXTURE MAKE & MODEL WITH ARCHITECT 2. ALL LIGHT FIXTURES CONSIDERED TO BE AS 120 VOLT FIXT SHALL INFORM ENGINEER ON RECORD OTHERWISE. 3. ALL EMERGENCY FIXTURES SHALL BE CONNECTED TO AN UNS HOT CONDUCTOR. 4. ALL THE LIGHTING FIXTURE TYPES, QUANTITIES, AND TYPES CONTROLS SHALL BE COORDINATED WITH THE OWNER/ARCHIT COMMENCING ANY WORK. INFORM THE ENGINEER ON RECORD DISCREPANCIES. BASE BID ACCORDINGLY. 5. E.C. TO PROVIDE MANUAL OVERRIDE SWITCH AS PER IECC TO COORDINATE THE LOCATION WITH ARCHITECT/OWNER. 6. CONNECT EXISTING LIGHTING FIXTURE TO EXISTING LIGHTING SAME AREA VIA EXISTING LIGHTING CONTROLS. E.C. TO VERIF OPERABLE CONDITION OF EXISTING ELECTRICAL CIRCUIT & E LIGHTING CONTROL IN FIELD. E.C. TO ENSURE THAT EXISTING CONTROL IS COMPLYING WITH IECC-2012 REQUIREMENTS. UPDATE/PROVIDE NEW CONTROLS AS REQUIRED. BASE BID A ADJACENT TENANT SPACE <u>N.I.C.</u> (L) (J) M-16 

KITCHEN/SKULLERY

逊

ADJACENT TENANT SPACE <u>N.I.C.</u> (L-6) VIA TIMER SWITCH

EU

ً

FRONT COUNTER AREA

C

SWITCH (L-36)


Ø

XC

M−17

VIA TIMER SWITCH (L-6)

		S
T/OWNER.	ELECTRICAL LIGHTING PLAN KEYED NOTES:	<u>وک</u> ۱۳۷
TURE. E.C.	A NEAREST LIGHTING BRANCH CIRCUIT AHEAD OF ALL SWITCHING AND CONTROLS AS PER STATE AND LOCAL CODES.	
NSWITCHED	B EXISTING LIGHT FIXTURE DENOTED BY (E) SHALL REMAIN AND THE EXISTING FIXTURE DENOTED BY (R) SHALL BE RELOCATED AS SHOWN. ELECTRICAL SHALL VERIFY THE EXACT EXISTING LIGHTING CONTROLS PROVIDED, THEIR OPERATING CONDITIONS IN FIELD. THE EXISTING LIGHTING	
NTECT BEFORE RD FOR ANY	CONTROLS SHALL BE IN COMPLIANCE WITH IECC CODES. PROVIDE NEW CONTROLS AS SHOWN ON THE PLANS IF REQUIRED. INFORM ENGINEER ON RECORD FOR ANY DISCREPANCIES/ISSUES BEFORE COMMENCING ANY WORK. BASE BID ACCORDINGLY.	
2012. E.C.	PROVIDE SHOW WINDOW RECEPTACLE AS PER NEC 210.62. VERIFY EXACT LOCATION WITH ARCHITECT/OWNER.	G
IFY THE EXISTING IG LIGHTING	D COORDINATE EXACT LOCATION OF TIMER SWITCH BANK WITH OWNER/	$\leq$
ACCORDINGLY.	E.C. TO COORDINATE THE BUILDING SIGNAGE CONNECTION REQUIREMENTS WITH SIGN VENDOR. BASE BID ACCORDINGLY.	ഹ
	$\stackrel{\frown}{\text{F}}$ LIGHTING CONTROL IN THIS AREA SHALL NOT BE WITH AUTOMATIC MEANS AS PER NEC 110.26(D).	
	PROVIDE (1) DUPLEX RECEPTACLE AND (1) CAT6 DATA CABLE AND CONNECTION TO EACH MENU BOARD. E.C TO COORDINATE WITH ARCHITECT/OWNER FOR LOCATION, MOUNTING HEIGHT AND ADDITIONAL POWER AND DATA REQUIREMENTS FOR MENU BOARD PRIOR COMMENCING WORK. BASE BID ACCORDINGLY.	Z
$\langle$	H INTERCONNECT EXHAUST FANS BEF-1(N) & BEF-2(N) WITH AHU-1(N). E.C TO COORDINATE WITH MECHANICAL DRAWINGS.	THIS DOCUMENT IS THE PROPERTY OF NY ENGINEERS
	$\begin{array}{c} \hline \\ \hline \\ \hline \\ \hline \\ \hline \\ \\ \hline \\ \\ \hline \\ \\ \hline \\$	AND SHALL NOT BE REPRODUCED WITHOUT THE WRITTEN CONSENT OF NY ENGINEERS. PROJECT
	$\cancel{1}$ INTERCONNECT EXHAUST FANS EF-2(N) WITH RTU-1(E). E.C TO COORDINATE WITH MECHANICAL DRAWINGS.	
	EXISTING LIGHT FIXTURE IN THIS AREA DENOTED BY (E) SHALL REMAIN CONNECTED TO THE RESPECTED EXISTING ELECTRICAL HOUSE PANEL ALONG WITH THEIR CONTROLS. E.C. TO COORDINATE WITH OWNER/ARCHITECT. ALSO VERIFY THEIR OPERABLE CONDITION IN FIELD AND REPLACE IF FOUND INOPERABLE. BASE BID ACCORDINGLY.	
	EXISTING HOOD LIGHTS AND CONTROL PANEL SHALL REMAIN CONNECTED TO THE RESPECTED EXISTING ELECTRICAL PANEL ALONG WITH THEIR CONTROLS. E.C. TO COORDINATE WITH OWNER/VENDOR FOR ANY	
	REQUIREMENT. ALSO VERIFY THEIR OPERABLE CONDITION IN FIELD AND REPLACE IF FOUND INOPERABLE. IF REQUIRED PROVIDE 120V DEDICATED CIRCUIT FOR EXISTING HOOD LIGHTING & CONTROL PANEL FROM THE NEW PANEL "M" AS SHOWN IN THE DRAWING. INFORM ENGINEER ON RECORD	
	FOR ANY DISCREPANCIES/ISSUES BEFORE COMMENCING ANY WORK. BASE BID ACCORDINGLY.	
		LEN
		KB KB
		BEI
اسر	6 BACK OF HOUSE/ DRY STORAGE	REVISIONS DATES:
/		
	(E)	
	B BEF-2(N)	
	Sos CEF-1(N)	
E) B		
		ISSUE DATE:07.06.23PROJECT #:390C.1376CDRAWN BY:NYECHECKED BY:NYE
		LIGHTING PLAN
	LIGHTING PLAN         SCALE         1           1/4" = 1'-0"         1	E-2

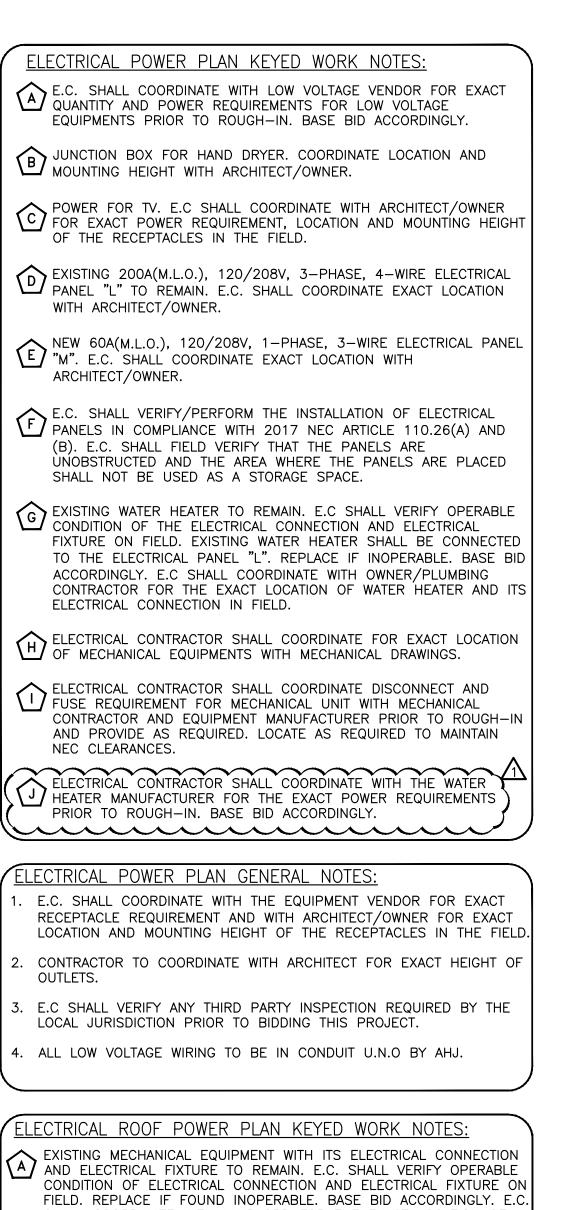


FIELD. REPLACE IF FOUND INOPERABLE. BASE BID ACCORDINGLY. E.C. SHALL COORDINATE WITH LANDLORD FOR THE EXACT LOCATION OF RTU AND ITS ELECTRICAL CONNECTIONS ON FIELD.

B EXISTING ROOF OUTLETS SHALL REMAIN WITH ITS BRANCH CIRCUITS. E.C. SHALL COORDINATE IN FIELD THE EXACT LOCATION AND OPERABLE CONDITIONS OF THE SAME AND PROVIDE NEW IF FOUND INOPERABLE AS SHOWN ON THE DRAWINGS. BASE BID ACCORDINGLY.

C ELECTRICAL CONTRACTOR SHALL COORDINATE FOR EXACT LOCATION OF MECHANICAL EQUIPMENTS WITH MECHANICAL DRAWINGS.

DE ELECTRICAL CONTRACTOR SHALL COORDINATE DISCONNECT AND FUSE REQUIREMENT FOR MECHANICAL UNIT WITH MECHANICAL CONTRACTOR AND EQUIPMENT MANUFACTURER PRIOR TO ROUGH-IN AND PROVIDE AS REQUIRED. LOCATE AS REQUIRED TO MAINTAIN NEC CLEARANCES.

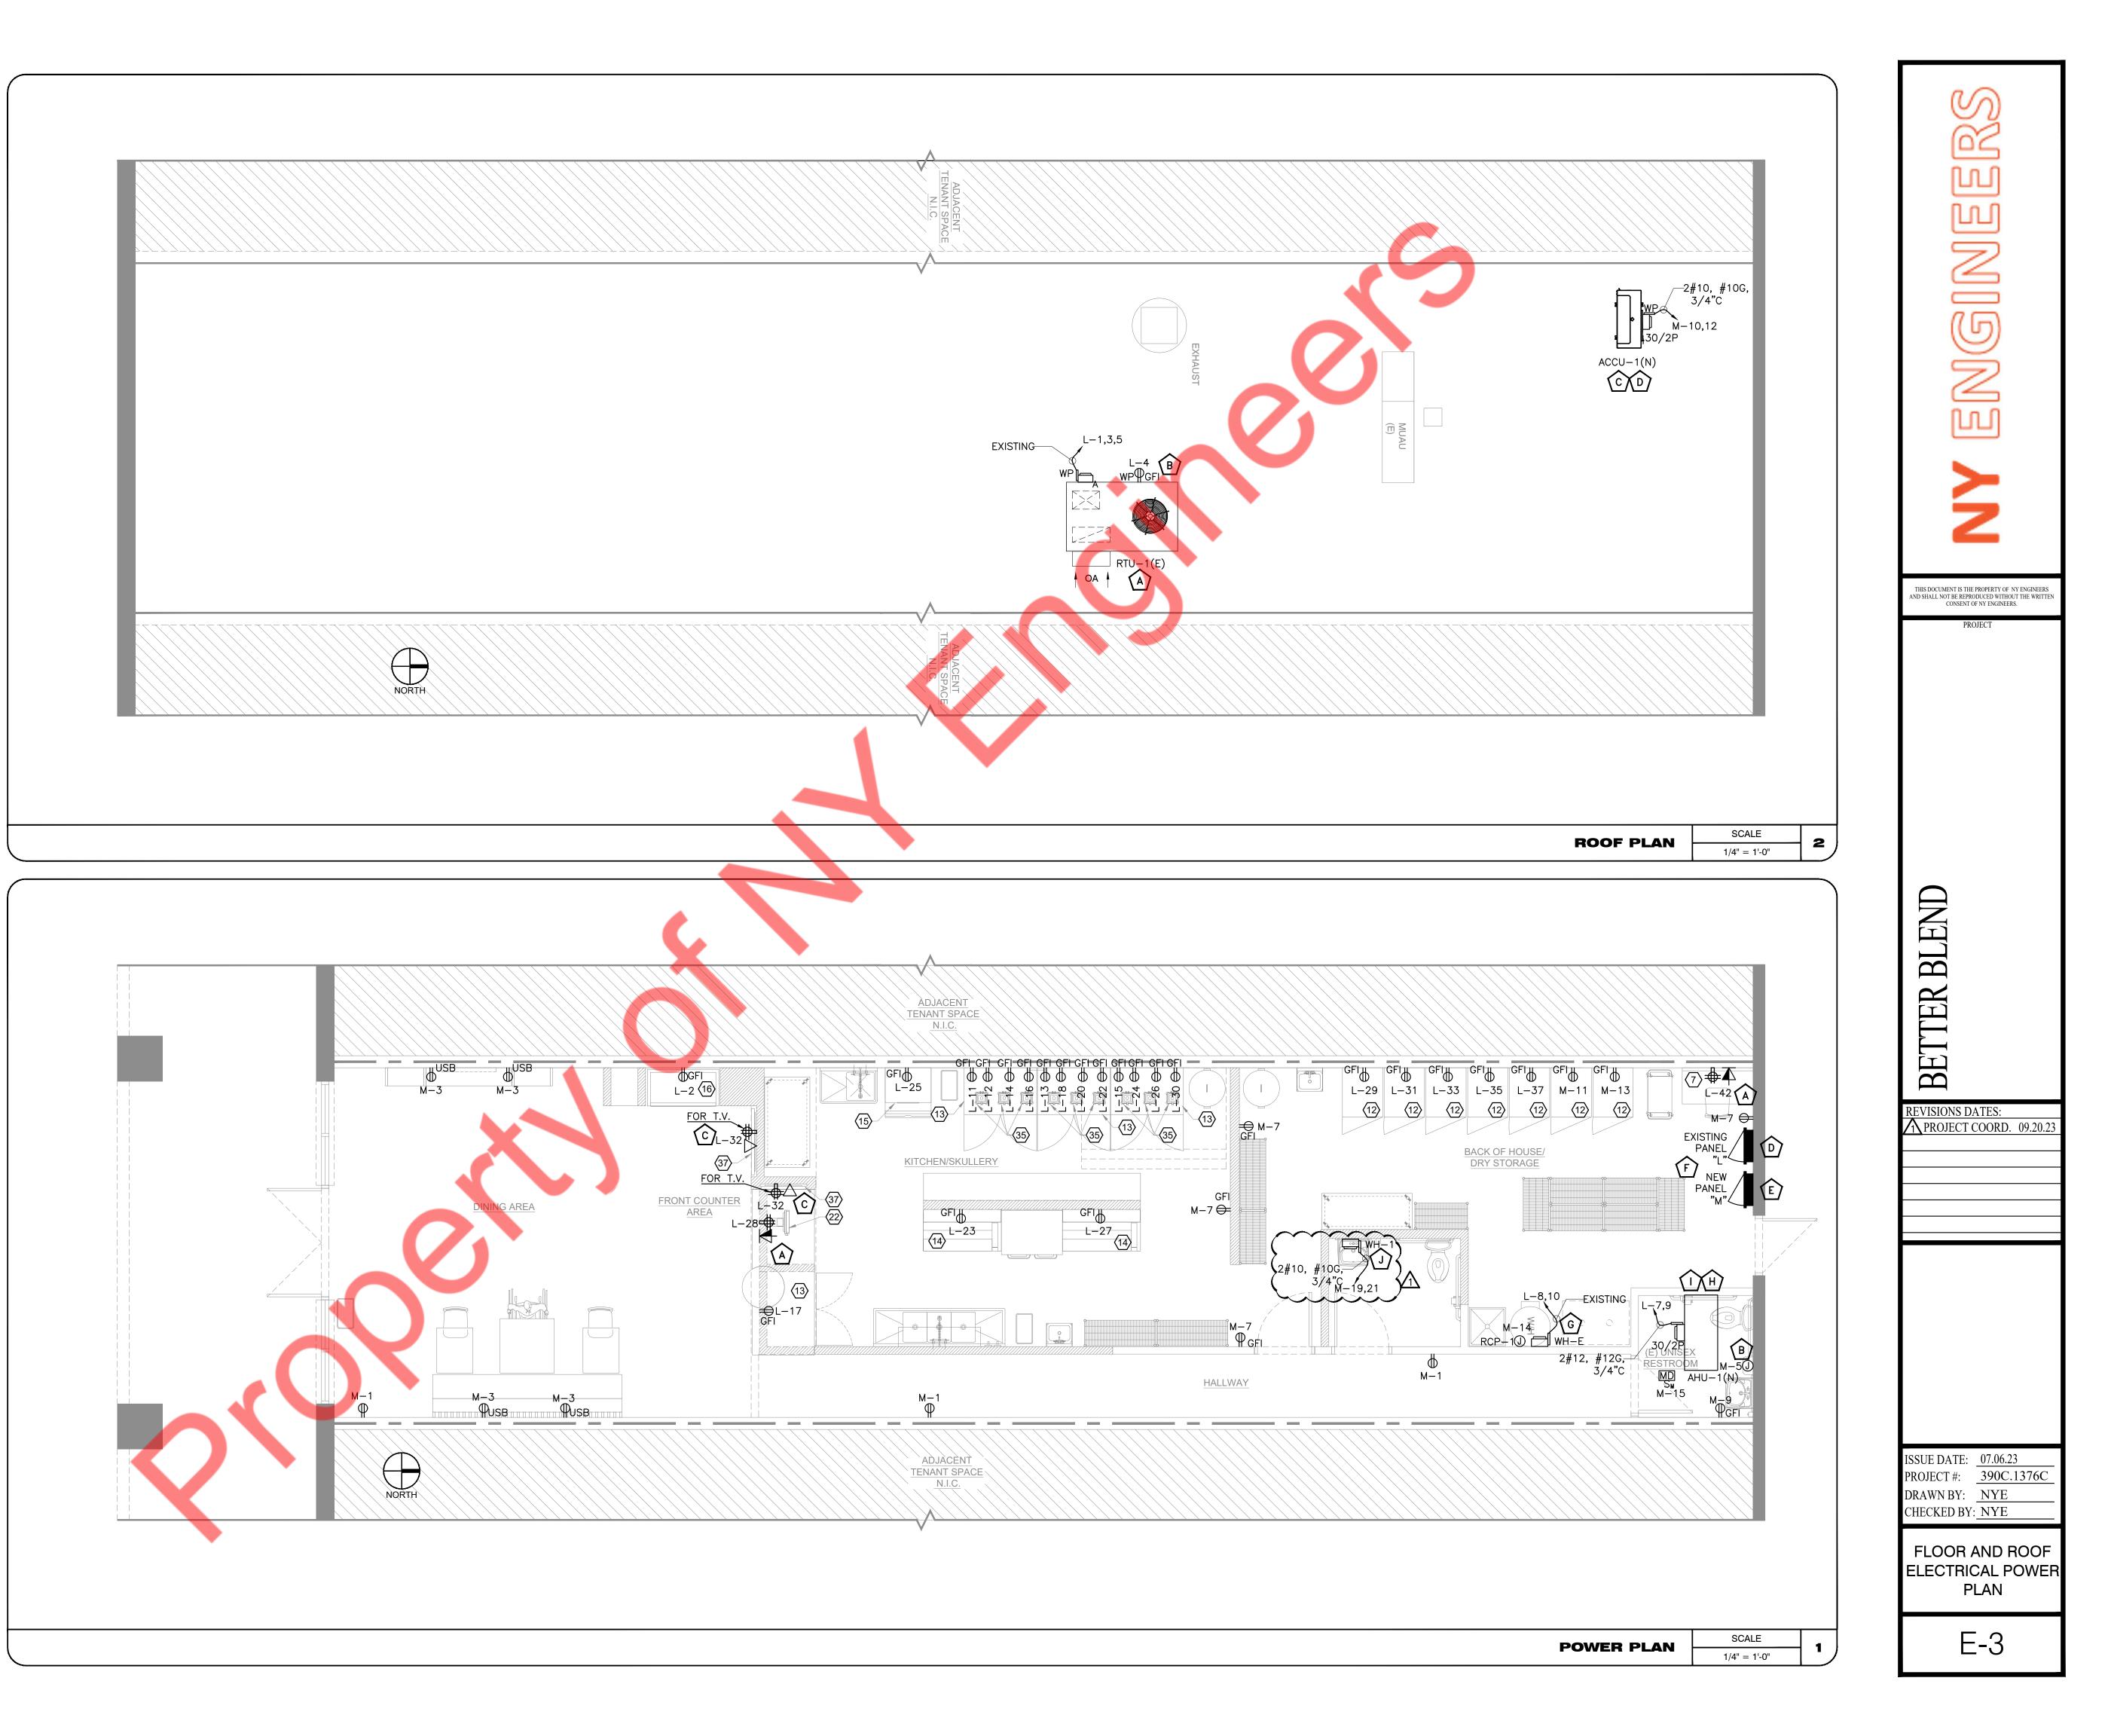

#### PANEL SCHEDULE:

PANEL:	L(E)												MOUNTING:	RECESSED		
2002/120	VOLTS,		PHASE,											DOLL		
208Y/120	VULIS,	3	PHASE,			4	WIRE						PANEL LOCATION:	BOH		
MAIN CB	NA	MLO:	200A		BUS:	EXISTING	MIN,						FED FROM:	EXISTING METER/D	ISCONNECT	
NOTE: L : LIC	GHTING, H	HVAC LOAD, M : MOTOR LOA	D, R : RECEPT	ACLES, O : C	THER/MIS	C. (TYPICAL)										
CKT NO.	TRIP AMPS	DESCRIPTION OF LC	)AD	LOAD TYPE	LOAD (KVA)	MINIMUM BRANCH CIRCUIT	PE	R PHASE (K\ B	/A) C	MINIMUM BRANCH CIRCUIT	LOAD (KVA)	LOAD TYPE	DESCRIPTION	OF LOAD	TRIP AMPS	скт
1				н	2.88		4.32			2#12, #12G, 3/4"C	1.44	E	OPEN DISPLAY MERCHAN	DISER_(#16)	20	2
3	30/3P	EXISTING (RTU)		н	2.88	EXISTING		3.06		EXISTING	0.18	R	EXISTING (ROOFTOP GFI)		20	4
5	1			н	2.88				3.38	2#12, #12G, 3/4"C	0.50	E	EXISTING (LIGHTING)		20	(
7	20/20			н	1.72		3.97			EVICTING	2.25	0			20/20	:
9	20/2P	AHU-1(N)		Н	1.72	2#10, #10G, 3/4"C		3.97		EXISTING	2.25	0	WH-E (EXISTING WATER H	IEATER)	30/2P	1
11	20	UNDERCOUNTER REF_(#13)		E	0.26	2#12, #12G, 3/4"C			1.76	2#12, #12G, 3/4"C	1.50	E	COMMERCIAL BLENDERS	_(#35)	20	1
13	20	UNDERCOUNTER REF_(#13)		E	0.26	2#12, #12G, 3/4"C	1.76			2#12, #12G, 3/4"C	1.50	E	COMMERCIAL BLENDERS	_(#35)	20	1
15	20	UNDERCOUNTER REF_(#13)		E	0.26	2#12, #12G, 3/4"C		1.76		2#12, #12G, 3/4"C	1.50	E	COMMERCIAL BLENDERS	(#35)	20	1
17	20	UNDERCOUNTER REF_(#13)		E	0.26	2#12, #12G, 3/4"C			1.76	2#12, #12G, 3/4"C	1.50	E	COMMERCIAL BLENDERS	_(#35)	20	1
19	20/2P	SPARE					1.50			2#12, #12G, 3/4"C	1.50	E	COMMERCIAL BLENDERS	_(#35)	20	2
21	20/2P	SPARE						1.50		2#12, #12G, 3/4"C	1.50	E	COMMERCIAL BLENDERS	_(#35)	20	2
23	20	DIPPING CABINET_(#14)		E	0.23	2#12, #12G, 3/4"C			1.73	2#12, #12G, 3/4"C	1.50	E	COMMERCIAL BLENDERS	_(#35)	20	2
25	20	ICE MAKER, CUBE-STYLE_(#15	5)	E	1.64	2#12, #12G, 3/4"C	3.14			2#12, #12G, 3/4"C	1.50	E	COMMERCIAL BLENDERS_	_(#35)	20	2
27	20	DIPPING CABINET_(#14)		E	0.23	2#12, #12G, 3/4"C		0.59		2#12, #12G, 3/4"C	0.36	R	FRONT COUNTER : POS_(#	ŧ22)	20	2
29	20	REACH-IN FREEZER_(#12)		E	0.24	2#12, #12G, 3/4"C			1.74	2#12, #12G, 3/4"C	1.50	E	COMMERCIAL BLENDERS	(#35)	20	3
31	20	REACH-IN FREEZER_(#12)		E	0.24	2#12, #12G, 3/4"C	0.96			2#12, #12G, 3/4"C	0.72	R	WALL MOUNTED TV RECE	PTACLE_(#37)	20	3
33	20	REACH-IN FREEZER_(#12)		E	0.24	2#12, #12G, 3/4"C		1.44		2#12, #12G, 3/4"C	1.20	L	EXTERIOR SIGNAGE/TIME	CLOCK	20	3
35	20	REACH-IN FREEZER_(#12)		E	0.24	2#12, #12G, 3/4"C			0.74	2#12, #12G, 3/4"C	0.50	L	LIGHTING - FRONT DINING	G AREA	20	3
37	20	REACH-IN FREEZER_(#12)		E	0.24	2#12, #12G, 3/4"C	0.24						EXISTING		15	3
39	60/2P	PANEL "M"		0	4.33	4#6, #10G, 3/4"C		4.33					EXISTING		35	4
41	00/28			0	4.33	4#0, #100, 5/4 C			4.69	2#12, #12G, 3/4"C	0.36	R	COMPUTER DESK_(#7)		20	4
		TOTAL CONI	NECTED LOAD	(KVA)			15.89	16.65	15.79							

PANEL:	M(N)												
208Y/120	VOLTS, 1 - PHASE		3			WIRE							
MAIN CB	NA	<b>MLO:</b> 60A		BUS: 100A			MIN,						
NOTE: L : LI	GHTING, H	HVAC LOAD, M	: MOTOR LO	AD, R : RECEPT	TACLES, O :	OTHER/MIS	C. (TYPICAL)	L					_
CKT NO.	TRIP AMPS	DESCE	RIPTION OF LOAD		LOAD	LOAD (KVA)	MINIMUM BRANCH CIRCUIT	PER PHASE (KVA)		MINIMUM BRANCH	LOAD	LOAD	
		DESCR						Α	В	CIRCUIT	(KVA)	TYPE	
1	20	RECEPTACLE-GE	NERAL		R	0.54	2#12, #12G, 3/4"C	1.74		2#12, #12G, 3/4"C	1.20	R	RE
3	20	RECEPTACLE-US	В		R	0.72	2#12, #12G, 3/4"C		1.92	2#12, #12G, 3/4"C	1.20	R	RE
5	20	HAND DRYER		0	1.00	2#12, #12G, 3/4"C	1.02		2#12, #12G, 3/4"C	0.02	0	BE	
7	20	RECEPTACLE-GENERAL		R	0.72	2#12, #12G, 3/4"C		1.10	2#12, #12G, 3/4"C	0.38	0	EF	
9	20	RECEPTACLE-RESTROOM		R	0.18	2#12, #12G, 3/4"C	1.32		2#10 #100 2/4%	1.14	н	H AC	
11	20	REACH-IN FREEZER_(#12)		E	0.24	2#12, #12G, 3/4"C		1.39	2#10, #10G, 3/4"C	1.14	н		
13	20	REACH-IN FREEZ	ZER_(#12)		E	0.24	2#12, #12G, 3/4"C	0.33		2#12, #12G, 3/4"C	0.09	R	RC
15	20	MOTORIZED DA	MPER		0	0.02	2#12, #12G, 3/4"C		0.52	2#12, #12G, 3/4"C	0.50		НС
17	20	MENU DISPLAY		~~~	R	0.36	2#12, #12G, 3/4"C	0.38	~~	2#12, #12G, 3/4"C	0.02	0	BE
19	20/20		TER HEATER (WH-1)(NEW		0	2.05	2#10 #100 2/4"0	2.05					SP.
21	- 30/2P				0	2.05	2#10, #10G, 3/4"C	2.05					SP
23	20	SPARE							0.00				SP
			TOTAL CON	NECTED LOAI	D (KVA)			6.85	6.98				

PANEL SCHEDULE KEYED WORK NOTES:	PANEL SCHEDULE KEYED WORK NO
A. ALL CIRCUITING SHOWN IN PANEL "L" FOR REFERENCE PURPOSE ONLY. E.C. SHALL VERIFY CIRCUITING OF THE EXISTING DEVICES IN FIELD AND INFORM ENGINEER FOR DISCREPANCIES.	E.C. TO PROVIDE (1) 60/ BASE BID ACCORDINGLY.
B. ELECTRICAL CONTRACTOR TO VERIFY THE EXACT PANEL SIZES AND INCOMING FEEDER SIZE.	
C. E.C. SHALL PROVIDE NEW CIRCUIT BREAKERS IN PLACE OF EXISTING CIRCUIT BREAKERS WHEREVER NECESSARY TO BE IN LINE WITH THE PANEL SCHEDULE.	
D. ELECTRICAL CONTRACTOR SHALL VERIFY EXACT CIRCUIT NUMBER & BREAKER SIZE OF EXISTING DEVICES IN FIELD.	
E. E.C. SHALL VERIFY THE EXISTING EQUIPMENT LOAD & RATINGS IN FIELD AND ACCORDINGLY CONSIDER THE ELECTRICAL LOAD IN PANEL BOARD SCHEDULE.	


### EQUPIMENT SCHEDULE:

ITEM NO.	DESCRIPTION	VOLTAGE	PHAS
12	REACH-IN FREEZER	115	1
13	UNDERCOUNTER REFIGERATOR	115	1
14	DISPLAY DIPPING CASE	115	1
15	ICE MAKER, CUBE STYLE	115	1
16	OPEN DISPLAY MERCHANDISER	120	1
22	P.O.S.	115	1
35	COMMERCIAL BLENDER	115	1
37	WALL MOUNTED TV	115	1

#### MOUNTING: SURFACE PANEL LOCATION: BOH FED FROM: PANEL L(E.) TRIP AMPS DESCRIPTION OF LOAD CKT NO. 20 RECEPTACLE-SHOW WINDOW 2 20 20 20 RECEPTACLE-SHOW WINDOW 4 BEF-1(N) 6 EF-2N) 8 ACCU-1(N) 30/2P RCP-1 20 HOOD LIGHTS BEF-2(N) SPARE 20 20 20 20 20 20 SPARE 22 SPARE 20 24

ORK NOTES:

) 60/2P BREAKER IN PLACE OF EXISTING (2) 20/1P BREAKERS. GLY.

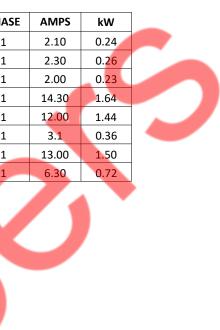

SABANGINE RSS
THIS DOCUMENT IS THE PROPERTY OF NY ENGINEERS AND SHALL NOT BE REPRODUCED WITHOUT THE WRITTEN CONSENT OF NY ENGINEERS. PROJECT
REVISIONS DATES:
REVISIONS DATES:
ISSUE DATE:       07.06.23         PROJECT #:       390C.1376C         DRAWN BY:       NYE         CHECKED BY:       NYE
PANEL SCHEDULES
E-4

#### **SCOPE OF WORK**

## PROVIDE ALL PLUMBING FOR NEW SMOOTHIE SHOP WITHIN AN EXISTING BUILDING, INCLUDING ALL WATER, GREASE, AND SANITARY & VENT LINES AND CONNECT TO EXISTING UTILITIES. EXISTING ELECTRIC STORAGE WATER NEAVER AND GREASE INTERCEPTOR TO BE REMAIN. EXISTING GAS NETWORK TO REMAIN. PROVIDE NEW POINT OF USE WATER HEATER.) COORDINATE WITH G.C. AND MECHANICAL CONTRACTOR FOR ANY REQUIRED CONDENSING WATER LINES.

#### **PLUMBING NOTES**

- ALL WORKMANSHIP AND MATERIALS SHALL BE IN STRICT ACCORDANCE WITH APPLICABLE LOCAL CODES, RULES AND ORDINANCES.
- PLUMBING CONTRACTOR SHALL REVIEW ALL DRAWINGS OF THIS SET. CONTRACTOR TO VERIFY THAT ALL EQUIPMENT SHOWN AS EXISTING MATCHES THE DESCRIPTIONS AND SPECIFICATIONS SHOWN ON DRAWINGS AND SCHEDULES. IF DIFFERENT NOTIFY ARCHITECT/ENGINEER BEFORE BIDDING, ORDERING OR PRECEDING WITH WORK.
- ALL EQUIPMENT WHICH IS TO REMAIN MUST BE REFURBISHED TO A LIKE NEW CONDITION.
- PLUMBING CONTRACTOR SHALL VISIT THE JOB SITE AND THOROUGHLY FAMILIARIZE HIMSELF WITH ALL EXISTING CONDITIONS. . ALL MATERIALS SHALL BE NEW.
- ALL WORK SHALL BE PERFORMED BY A LICENSED PLUMBING CONTRACTOR IN A FIRST CLASS WORKMANLIKE MANNER. THE COMPLETED SYSTEM SHALL BE FULLY OPERATIVE. ALL EXCAVATION AND BACKFILL AS REQUIRED FOR THIS PHASE OF CONSTRUCTION SHALL BE A PART OF THIS CONTRACT.
- REQUIRED INSURANCE SHALL BE PROVIDED BY THE PLUMBING CONTRACTOR FOR PROTECTION AGAINST PUBLIC LIABILITY AND PROPERTY DAMAGE FOR THE DURATION OF THE WORK.
- PLUMBING CONTRACTOR SHALL SECURE AND PAY FOR ALL PERMITS, FEES, INSPECTION AND TESTS. PLUMBING CONTRACTOR TO OBTAIN PERMIT AND APPROVED SUBMITTALS PRIOR TO BEGINNING WORK OR ORDERING EQUIPMENT. PLUMBING CONTRACTOR MUST BE PRESENT FOR ALL INSPECTIONS OF HIS WORK BY REGULATORY AUTHORITIES.
- DRAWINGS ARE DIAGRAMMATIC. DO NOT SCALE FOR THE EXACT LOCATION OF FIXTURES, PIPING, EQUIPMENT, ETC. 0. ALL WORK SHALL BE COORDINATED WITH OTHER TRADES TO AVOID INTERFERENCE WITH THE PROGRESS OF
- CONSTRUCTION. REPORT ANY DISCREPANCY TO ENGINEER/ARCHITECT PRIOR TO BEGINNING CONSTRUCTION.
- 1. VERIFY LOCATION, SIZE, DIRECTION OF FLOW AND INVERTS OF ALL EXISTING UTILITIES PRIOR TO BEGINNING OF CONSTRUCTION. ADVISE ENGINEER OF ANY DISCREPANCIES.
- 2. EXPOSED WATER PIPING SHALL BE TYPE "L" COPPER FOR 2" AND UNDER. WATER PIPING IN WALLS AND UNDERGROUND MAY BE "PEX" TYPE PIPING THAT MEETS ANSI/NSF STANDARD 61.
- 13. SOIL, WASTE AND VENT PIPING SHALL BE PVC BUT MAY NOT RUN THRU RATED ASSEMBLIES OR IN PLENUMS.
- 14. ALL FIXTURES MUST BE PROVIDED WITH READILY ACCESSIBLE STOPS AND APPROPRIATELY MARKED ACCESS PANELS. COORDINATE LOCATIONS WITH GENERAL CONTRACTOR PRIOR TO INSTALLATION.
- 5. FURNISH AND INSTALL APPROVED AIR CHAMBERS AT EACH PLUMBING FIXTURE GROUP AS PER CODE AND WITH GOOD ENGINEERING PRACTICE.
- 6. DIELECTRIC COUPLINGS ARE REQUIRED BETWEEN ALL DISSIMILAR METAL IN PIPING AND EQUIPMENT CONNECTIONS; EXCEPT AT WATER HEATER AS PER CODE. 7. ISOLATE COPPER PIPE FROM HANGER OR SUPPORTS WITH ISOLATOR PAD.
- 18. ALL FIRE RATED FLOOR AND WALL PENETRATIONS SHALL BE PROPERLY PROTECTED FROM FIRE, SMOKE AND WATER PENETRATION BY FILLING VOIDS BETWEEN PIPE AND WALL/FLOOR SLEEVES WITH FIRE RATED FOAM, TO ACHIEVE THE SAME RATING AS WALLS OR FLOORS AS PART OF THE PLUMBER'S WORK.
- 9. PLUMBING CONTRACTOR SHALL GUARANTEE ALL MATERIALS AND WORKMANSHIP FREE FROM DEFECTS FOR A PERIOD OF NOT LESS THAN ONE (1) YEAR FROM DATE OF CERTIFICATE OF OCCUPANCY. CORRECTION OF ANY DEFECTS SHALL BE COMPLETED WITHOUT ADDITIONAL CHARGE WITHIN 72 HOURS OF NOTIFICATION AND SHALL INCLUDE REPLACEMENT OR REPAIR OF ANY OTHER PHASE OF THE INSTALLATION WHICH MAY HAVE BEEN DAMAGED. PROVIDE COPY TO LL
- 20. STUDOR MINI/MAXI AIR ADMITTANCE VALVES MAY NOT BE USED AS AN ALTERNATE TO VENT PIPING THRU ROOF.
- 21. PROVIDE CHROME PLATED COMBINATION COVER PLATE AND CLEAN OUT PLUG OR ACCESS PANEL FOR ALL CLEANOUTS. 22. NO COMBUSTIBLE MATERIAL TO BE USED IN MECHANICAL ROOMS OR IN CEILING SPACES WHERE USED AS RETURN AIR
- PLENUMS 23. NO WATER, SANITARY OR DRAINAGE PIPING PERMITTED IN ELECTRICAL OR ELEVATOR EQUIPMENT ROOMS.
- 24. WATER PIPING INSULATION SHALL BE 1" THICK ARMAFLEX INSTALLED IN ACCORDANCE WITH MANUFACTURER'S INSTRUCTIONS FOR ALL HOT WATER PIPING. WHERE DOMESTIC WATER TEMPERATURES CAN CAUSE SWEATING, ALL COLD WATER PIPING SHALL BE INSULATED WITH 1/2" THICK ARMAFLEX INSULATION.
- 25. CONDENSATE DRAIN LINES TO BE RUN UNDER SLAB IN PVC SCH 40 PIPE AND STUBBED OUT OF WALL TO UNIT. TIE-IN OF A/C TO BE BY OTHERS. PVC PIPING WITH 1/2" THICK ARMAFLEX INSULATION MAY BE USED IN LOCATIONS WHERE ALLOWED BY LOCAL CODES. SEE PLUMBING DRAWINGS FOR SIZE AND LOCATION OF PIPING. PVC WILL BE MIN. SCHEDULE 40 FOR SIZE AND LOCATION OF PIPING. PVC WILL BE MIN. SCHEDULE 40.
- 26. PROVIDE ANGLE STOPS ON ALL WATER SERVICE LINES TO FIXTURES FOR INDIVIDUAL SHUT-OFF.
- 27. NO JOINTS UNDERGROUND FOR COPPER.
- 28. PLUMBING FIXTURES SHALL COMPLY WITH 2020 KENTUCKY STATE PLUMBING CODE.
- 29. WATER HAMMER ARRESTORS AS PER 2020 KENTUCKY STATE PLUMBING CODE.
- 30. PLUMBING CONTRACTOR SHALL REVIEW ALL BID DOCUMENTATION.
- 31. PLUMBING CONTRACTOR SHALL REVIEW WALL FINISHES @ LOCATION REQUIRING BARRIER-FREE COMPLIANCE (EXAMPLE: CENTER LINE TO TOILET).
- 32. CONSTRUCTION "AS BUILT" DRAWINGS AND DOCUMENTS SHALL BE PROVIDED TO THE OWNER WITHIN 30 DAYS AFTER THE DATE OF ACCEPTANCE. PROVIDE A COPY TO LL
- 33. OPERATION MANUALS AND MAINTENANCE MANUALS SHALL BE PROVIDED TO THE BUILDING OWNER. PROVIDE A COPY

<b>KITC</b>	HE	N E	QUIPMENT SCHE	DULE		V	ATER	N	WASTE		
Item N	lo.	Qty.	v. Description Manufacturer		rer	Model	Hot	c Co	ld Dire	ct Indi	rect
26		1	3 COMPARTMENT SINK*	JOHN BOOS		E3S8-18-14T24X				1-1	/2"
25		1	FAUCET FOR 3 COMP SINK	T&S BRASS		В-0133-В	3/4"	+ 3/4	t		
29		1	1 COMPARTMENT SINK*	JOHN BOOS		1B16204-1D18L-X	1/2"+	-+ 1/2	2"	1-1	/2"
15		1	ICE MACHINE	SCOTSMAN		C0330MA-1		1/2	2"	3/	4"
30		2	HAND SINK	JOHN BOOS		PBHS-W-0909-P-SSLR-X	1/2"+	-+ 1/2	2" 1-1/2	2"	
32		1	MOP SINK			EXISTING TO REMAIN			E		
31		1	FAUCET FOR MOP SINK			EXISTING TO REMAIN	E	E			
FS	FS 3 FLOOR SINK ZURN		Z1900-23-31 (ZS1900 IF IN EXPOSED AR	REAS)		3"					
FD 1 FLOOR DRAIN ZURN			ZS415 W/ TYPE BS STRAINER			4"					
TM	/	3	THERMAL MIXING VALVE	WATTS		LFMMV	1/2	' 1/2	2"		
НОТ	WATE	R 140	°F, ++ PROVIDE TMV AS PEF	R SCHEDULE, *LEVER WAS	TE VAL	VE REQUIRED,					
	$\sim$		FIXTURE SCHEDU		$\sim$	~~~~~~~~~~~~~~~~~~~~~~~~~~~~~~~~~~~~~~~	WA	TER	WASTE		$\sim$
n No.	Qty.		Description	Manufacturer		Model	Hot	Cold	Waste	Usage	Spec
A .	1	WATE	ER CLOSET		EXIST			E	E		
.1	1		ER CLOSET			3.010		3/4"	4"		
3			TORY					5, 1	E		
31	1		TORY			ERNE 0355.012			2"		
)	1	LAVA	TORY FAUCET	EXIST		TING TO REMAIN	E	Е			
	1 LAVATORY FAUCET KOHLER K-2		14.00	101 M	1/2"	1/2"		0.5	GPM		

# **PLUMBING LEGEND**

∽ — san — →	SANITARY SEWER I (UNDERGROUND)				
∽ — gsan — →	GREASE SANITARY (UNDERGROUND)				
Şvv v −s	VENT PIPING				
<u>ډ</u>	DOMESTIC COLD W				
<u>۶                                    </u>	HOT WATER PIPING				
<i>∽</i> −−−− <i>∽</i>	HOT WATER RETUR				
ςEx.cwς	EXISTING COLD WA				
ςEx.HWς	EXISTING HOT WAT				
<i>∽</i> −−− <i>∽</i>	PIPE RISE				
∽	PIPE DROP				
[	CAPPED END OF PI				
FCOO	FLOOR CLEAN OUT				
	P-TRAP				
S.O.V.	SHUT - OFF VALVE				
CW	DOMESTIC COLD W				
HW	DOMESTIC HOT WA				
HWR	DOMESTIC HOT WA				
WCO	WALL CLEAN OUT				
EX. FD	EXISTING FLOOR DF				
$\bowtie$	GATE VALVE				
	FLOOR DRAIN				
Ø	BALANCING VALVE				
$\bullet$	POINT OF CONNECT				
I.W.	INDIRECT WASTE				
	FLOOR SINK				
	THERMOSTATIC MIX				

