

	THE CONTRACTOR SHALL GIVE NECESSARY NOTICE, FILE DRAWINGS AND SPECIFICATIONS WITH ALL DEPARTMENTS HAVING JURISDICTION, WORK AND PAY ALL FEES THEREFORE. THE CONTRACTOR SHALL ARRANGE FOR INSPECTION AND TESTS OF ANY OR ALL PARTS OF THE WORK IF SO REQUIRED BY AUTHORITIES AND PAY ALL CHARGES FOR SAME. THE CONTRACTOR SHALL PAY ALL COSTS FOR, AND FURNISH TO THE OWNER BEFORE FINAL BILLING, ALL CERTIFICATES NECESSARY AS EVIDENCE THAT THE WORK INSTALLED CONFORMS WITH ALL REGULATIONS WHERE THEY APPLY TO THIS WORK.	SHALL BE DEAD FRONT, NEMA TYPE 1, EXCEPT AS NOTED. FRAMES, IC AND INTERCHANGEABLE TRIPS SHALL BE AS FOLLOWS, UNLESS OTHERWISE NOTED: 1) 120 VOLTS, 100-AMP FRAME: 10,000 AMPS, 1 POLE. 2) 120/240 VOLTS, 225-AMP FRAME: 22,000 AMPS MINIMUM DISTRIBUTION PANELBOARDS, CIRCUIT BREAKER TYPE: A. THREE PHASE, 4 OR 5 WIRE, COPPER BUS BARS, WITH 2, 3, OR 4 WIRE BRANCHES, AS NOTED. CAPACITY OF PANEL AND CIRCUITS, AS NOTED BELOW. PANELBOARD TO HAVE GROUND BUS SAME SIZE AS PHASE BUSES. B. CABINETS: CODE GAUGE GALVANIZED SHEET STEEL PRIMED AND PAINTED WITH TRIM AND DOOR, TYPE AS NOTED, LAP AND RIVET CORNERS OR FORM AS APPROVED. C. TRIM: ONE PIECE FULL FINISH PRIMED AND PAINTED SHEET STEEL. TRIM SHALL BE MOUNTED WITH A CONTINUOUS PIANO HINGE CONFIGURED IN SUCH A MANNER THAT IT SHALL BE POSSIBLE TO GAIN FULL ACCESS TO CIRCUIT BREAKERS AND WIRING GUTTERS WITHOUT REMOVING THE TRIM. PROVIDE A MULTI-PIN CYLINDER LOCK (YALE, CORBIN OR EQUAL) TO LATCH THE TRIM. KEYS SHALL BE MILLED. D. HARDWARE: MULTI-PIN, CYLINDER LOCKS WITH MILLED KEYS. ALL PANELS SHALL BE KEYED ALIKE. DOOR OVER 48" HIGH SHALL BE EQUIPPED WITH A CHROME PLATED VAULT HANDLE, BUILT-IN LOCK AND 3-POINT CATCH FASTENING DOOR AT TOP, BOTTOM AND CENTER. E. HINGES: CONCEALED, CONTINUOUS PIANO HINGE AS DESCRIBED ABOVE. F. DIRECTORY HOLDER: MEAL FRAME WITH NONBREAKABLE TRANSPARENT COVER AND DIRECTORY CARD. ENTRIES TO BE TYPEWRITTEN BY ELECTRICAL CONTRACTOR. PROVIDE AN ENGRAVED LAMINATED NAMEPLATE ADJACENT TO EACH BRANCH BREAKER. MOUNT WITH SELF TAPPING MACHINE SCREWS. G. FURNISH MULTI-CABLE LUGS WHERE REQUIRED. DOUBLE LUGGING NOT PERMITTED. SECURE LUGS TO BUS BY STUD BOLTS. H. PANELBOARD CONSTRUCTION FOR BOLTED TYPE BREAKERS. MINIMUM SHORT CIRCUIT RATING 25,000 AMPERES, RMS SYMMETRICAL FOR ALL 120/208V APPLICATIONS. INDIVIDUAL CIRCUIT BREAKERS SHALL HAVE MINIMUM 100A FRAME, TRIPS SIZED AS SHOW ON THE PLANS. I. MINIMUM GUTTER SPACES: PANELS WITH 225 AMPERE MAINS, 5-¾" MINIMUM, 400 AMPERES AND OVER, MINIMUM GUTTERS 8". FOR PANELS WITH THROUGH FEEDERS, INCREASE GUTTER WIDTH BY 2" MINIMUM AND PROVIDE A SHEET STEEL BARRIER BETWEEN THE PANEL GUTTER AND THE THROUGH FEEDER PORTION OF THE BACK BOX. BRANCH CIRCUIT BREAKERS SHALL BE MECHANICALLY INTERLOCKED WHEN SHOWN ON DRAWINGS. J. DISTRIBUTION AND SUB-DISTRIBUTION PANELBOARDS SHALL BE A MINIMUM OF 30" WIDE AND 10" DEEP. K. PANELBOARD SHALL HAVE MAIN CIRCUIT BREAKER OR MAIN LUGS AS INDICATED ON THE DRAWINGS. QUANTITY, POLES AND TRIP RATINGS OF BRANCH CIRCUIT BREAKERS TO BE AS INDICATED ON DRAWINGS. L. PANELBOARD SHALL HAVE ENGRAVED WHITE CORE, BLACK LAMACOID NAMEPLATE SCREWED ONTO PANE TRIM WITH DESIGNATION LISTED (PANELBOARD NAME, VOLTAGE, RATING OR MAINS IN AMPS).	c. FLEXIBLE METALLIC CONDUIT: ANGLE WEDGE TYPE WITH INSULATED THROAT. d. BUSHINGS: METALLIC INSULATED TYPE.	Q. PANEL, JUNCTION AND PULL BOXES SHALL BE LOCATED CLEAR OF OTHER TRADES. CONCEAL JUNCTION AND PULL BOXES IN FINISHED SPACES. WHERE NECESSARY, REROUTE RACEWAYS OR MAKE OTHER ARRANGEMENTS FOR CONCEALMENT. BOXES SHALL BE ACCESSIBLE. SUPPORT BOXES FROM BUILDING STRUCTURE, INDEPENDENT OF CONDUIT. PROVIDE FLOOR-TO-CEILING CHANNELS FOR MOUNTING ON DRYWALL AND LIGHTWEIGHT CONSTRUCTION. OUTLET BOXES FOR FIXTURES RECESSED IN HUNG CEILINGS SHALL BE ACCESSIBLE THROUGH OPENING CREATED BY REMOVAL OF FIXTURE. SECURE TO BLACK IRON SUPPORT. MOTOR TERMINAL BOXES: COORDINATE WITH MOTOR BRANCH CIRCUIT CONDUIT AND WIRING; ADD BOX VOLUME WHERE REQUIRED. R. FIRE SEALANTS: PROVIDE FOR RACEWAYS AND WIRE PASSING THROUGH FLOOR SLOTS, SLEEVES OR OPENINGS IN FIRE-PARTITIONS ROOMS. S. PERFORM CONTINUITY TESTS OF RESISTANCE OF FEEDER CONDUITS FROM SERVICE TO POINT OF FINAL DISTRIBUTION USING 1 CONDUCTOR RETURN. MAXIMUM RESISTANCE SHALL BE 25 OHMS.	D. INSERTION RECEPTACLES SHALL BE HOSPITAL GRADE DUPLEX CONVENIENCE 125 VOLTS, 2 POLE, 3 WIRE, U GROUND SLOT. GROUNDED, EXCEPT AS NOTED. 1) HEALTH CARE FACILITIES: a) DUPLEX, 20 AMP, 125 VOLTS, 2 POLE, 3 WIRE, U GROUND SLOT: SIMILAR TO HUBBELL NO. 8300 HOSPITAL GRADE. b) SINGLE, 20 AMP, 125 VOLT, 2 POLE, 3 WIRE, U GROUND SLOT: SIMILAR TO HUBBELL NO. 8310 HOSPITAL GRADE. 2) GROUND FAULT INTERRUPTER RECEPTACLES: a. 20 AMP DUPLEX FEED-THROUGH TYPE. SIMILAR TO NO. GF8300.
E.	CONTRACTOR SHALL PERFORM ALL CONTROLLED INSPECTIONS IN ACCORDANCE WITH THE NYC BUILDING CODE. SECURE ALL REQUIRED PERMITS AND APPROVALS AND TRANSMIT SAME TO OWNER. CONTRACTOR SHALL BE RESPONSIBLE FOR ALL FEES.				E. DEVICE PLATES: SEE ARCHITECT FOR TYPE. FOR RECEPTACLES WITH OTHER THAN 120 VOLT, INSCRIBED VOLTAGE AVAILABLE.
F.	AREAS WITH NO ELECTRICAL WORK SHALL REMAIN AS IS. CONTRACTOR SHALL MAINTAIN CONTINUITY OF ALL ELECTRICAL SYSTEMS TO ALL AREAS NOT COVERED BY THIS RENOVATION AND SHALL PROVIDE 48 HOUR NOTICE TO LANDLORD OF ANY PLANNED POWER INTERRUPTIONS OR SIGNAL SYSTEM OUTAGES.				F. COLORS: COORDINATE COLORS WITH ARCHITECT.
4.	SHOP DRAWINGS A. PRIOR TO THE INSTALLATION OF ANY WORK AND PROCUREMENT OF EQUIPMENT, CONTRACTOR SHALL PROVIDE COMPLETE SETS OF COORDINATED SHOP DRAWINGS OF ALL NEW AND EXISTING EQUIPMENT, INDICATING CAPACITY, DIMENSIONS AND SEQUENCE OF OPERATION FOR WRITTEN APPROVAL BY THE ARCHITECT AND ENGINEER. B. INDICATE ON EACH SHOP DRAWINGS SUBMITTED: 1) PROJECT NAME AND LOCATION 2) NAME OF ARCHITECT AND ENGINEER 3) ITEM IDENTIFICATION 4) APPROVAL STAMP OF PRIME CONTRACTOR C. SUBMISSIONS: 1) SUBMISSIONS 11 IN. X 17 IN. OR SMALLER: IF THE SUBMISSION IS A CATALOG CUT, THEN THE CONTRACTOR SHALL SUBMIT ONE ORIGINAL AND TWO COPIES. OTHERWISE, HE SHALL SUBMIT THREE COPIES. THE ARCHITECT WILL FORWARD THE ORIGINAL AND ONE COPY (TWO COPIES WHEN NO ORIGINAL IS RECEIVED) TO THE ENGINEER. ALL CATALOG CUTS SHALL BE COMPLETE. 2) SUBMISSIONS LARGER THAN 11 IN. X 17 IN.: SUBMIT TWO PRINTS AND ONE PAPER SEPIA TO THE ARCHITECT. THE ARCHITECT WILL FORWARD ONE PRINT AND THE PAPER SEPIA TO THE ENGINEER. D. SUBMIT SHOP DRAWINGS FOR THE FOLLOWING: 1) SAFETY/DISCONNECT SWITCHES 2) FUSES 3) CIRCUIT BREAKERS 4) PANELBOARDS/LOADCENTER (INCLUDING DIMENSIONS, SCHEDULES, AND CATALOG CUTS). 5) RACEWAYS 6) WIRE AND CABLE 7) WALL SWITCHES 8) INSERTION RECEPTACLES 9) MOMENTARY CONTACT SWITCHES 10) TIME SWITCHES 11) LIGHTING FIXTURES. E. ASSIST AND PROVIDE ALL NECESSARY INFORMATION, DIAGRAMS, SKETCHES, ETC. TO THE HVAC CONTRACTOR, FOR THE PREPARATION OF COORDINATED SHOP DRAWINGS INDICATING ROUTING OF FEEDERS, PIPING AND DUCTWORK WHERE APPLICABLE, CERTIFIED BY ALL TRADES THAT COORDINATION HAS BEEN ESTABLISHED. SUBMIT FOUR(4) BOOKBOUND OPERATING AND SERVICE MANUALS WHICH SHALL INCLUDE COPIES OF ALL SHOP DRAWING. PROVIDE SHOP DRAWINGS FOR PANELS, FIXTURES, WIRING DEVICES, CONDUIT, CABLE, DISCONNECT SWITCH, RELAYS, CONTRACTORS, AND OTHER SYSTEMS AS DIRECTED BY THE ENGINEER.			10.	WIRE AND CABLE: A. PROVIDE WIRE AND CABLE COMPLETE WITH ACCESSORIES. SIZE REFERENCE SHALL BE AWG EXCEPT AS NOTED. B. CONDUCTORS SHALL BE COPPER, ASTM STANDARD SOLID (NO. 10 AND SMALLER) OR STRANDED (NO. 8 AND LARGER). GENERAL USE CABLEING SHALL BE NO. 12 MINIMUM. AT 120 VOLTS AND OVER 100 FT CIRCUIT LENGTH PROVIDE NO. 10 MINIMUM. AT 265 VOLTS AND OVER 200 FT CIRCUIT LENGTH PROVIDE NO. 10 MINIMUM. C. CONTROL AND ALARM CABLEING, EXCEPT AS NOTED, SHALL BE NO. 14 MINIMUM. AT 120 VOLTS AND OVER 200 FT CIRCUIT LENGTH PROVIDE NO. 12 MINIMUM. OTHER VOLTAGES AND PHASES: ADJUST CABLE SIZING AS REQUIRED TO MAINTAIN VOLTAGE DROP, INCREASE RACEWAY SIZES FOR LARGER WIRE AS REQUIRED. D. INSULATION SHALL BE RUBBER AND THERMOPLASTIC MEETING ASTM AND IPCEA STANDARDS. TYPE THW OR THWN SHALL BE UTILIZED FOR FEEDERS AND BRANCH CIRCUITS EXCEPT AS NOTED. TYPE SEF-2 SHALL BE UTILIZED FOR BRANCH CIRCUITS LOCATED IN WIRING CHANNELS OF CONTINUOUS FLUORESCENT FIXTURES AND IN AMBIENT TEMPERATURES OVER 90 DEG C. FOR UNGROUNDED ISOLATED BRANCH CIRCUITS PROVIDE CROSS-LINKED POLYETHYLENE INSULATION (TYPE XHHW). E. ARMORED CABLE (BX) SHALL BE UTILIZED FOR BRANCH CIRCUITS IN DRY HOLLOW LOCATIONS, HUNG CEILINGS, AND BLOCK WALLS. WHEN USED IN LIEU OF WIRING IN CONDUIT, STATE IN PROPOSAL THAT PRICE IS BASED UPON THE USE OF HOSPITAL GRADE 'BX'. F. COLOR CODING SHALL BE AS FOLLOWS: 120/208 VOLT SYSTEM: BLACK FOR A PHASE RED FOR B PHASE BLUE FOR C PHASE 1) NEUTRAL WIRE SHALL UTILIZE WHITE OUTER COVERING THROUGHOUT. EQUIPMENT GROUND WIRE SHALL UTILIZE GREEN OUTER COVERING THROUGHOUT. WHERE COLOR-CODED CABLE IS NOT AVAILABLE, CERTIFY IN WRITING AND REQUEST PERMISSION TO OVERLAP CONDUCTORS WITH 6 IN. OF COLOR TAPING IN ACCESSIBLE LOCATIONS. G. PROVIDE FLAMEPROOF LINEN OR FIBER TAGS IN ACCESSIBLE LOCATIONS. FOR FEEDERS INDICATE FEEDER NUMBER, SIZE, PHASE AND POINTS OF ORIGIN AND TERMINATIONS. FOR CONTROL AND ALARM WIRING INDICATE TYPE (CONTROL OR ALARM), SIZE OF WIRE, AND POINTS OF ORIGIN AND TERMINATIONS. H. TERMINATIONS, SPLICES AND TAPS UNDER 600 VOLTS: COPPER CONDUCTORS NO. 10 AND SMALLER SHALL UTILIZE COMPRESSION-TYPE OF TWIST-ON SPRING-LOADED CONNECTORS AND CLEAR NYLON-INSULATED COVERING. COPPER CONDUCTORS NO. 8 AND LARGER SHALL UTILIZE MECHANICAL BOLTED PRESSURE OR HYDRAULIC COMPRESSION TYPE USING MANUFACTURER'S RECOMMENDED TOOLING. CABLE LUGS AND CONNECTORS SHALL UTILIZE COMPRESSION TYPE OF SAME METAL AS CONDUCTOR. PROVIDE TO MATCH CABLE, WITH MARKING INDICATING SIZE AND TYPE. COPPER LUG CONNECTIONS TO BUS BARS: USE ANTISEIZE COMPOUND ON TANG. I. NOT MORE THAN 3 LIGHTING OR CONVENIENCE OUTLET CIRCUITS SHALL BE INSTALLED IN ONE CONDUIT UNLESS OTHERWISE INDICATED. PULL NO THERMOPLASTIC WIRES AT TEMPERATURES LOWER THAN 32 DEG F. PROVIDE SEPARATE RACEWAYS FOR CONDUCTORS OF 120/208 AND 265/460 VOLT SYSTEMS, EXCEPT 460 VOLT MOTOR BRANCH CIRCUIT WIRING AND RELATED 120 VOLT CONTROL WIRING. THERMOPLASTIC WIRES SHALL NOT BE INSTALLED IN COMPUTER AREA RAISED FLOORS. J. LEAVE WIRES WITH SUFFICIENT SLACK TO PERMIT MAKING FINAL CONNECTIONS. K. PERFORM CONTINUITY AND INSULATION TESTS. MEGGER TEST 100 PERCENT OF FEEDERS, 10 PERCENT OF BRANCH CIRCUITS AND ALL MOTOR BRANCH CIRCUITS OVER 25 HP. PERFORM TESTS PRIOR TO CONNECTING EQUIPMENT AND IN PRESENCE OF AUTHORIZED REPRESENTATIVES. SUBMIT WRITTEN REPORT OF RESULTS. CORRECT OR REPLACE CABLE TESTING BELOW MANUFACTURER'S STANDARDS.
5.	AS-BUILT DRAWINGS AND EQUIPMENT OPERATIONAL INSTRUCTIONS A. UPON COMPLETION AND ACCEPTANCE OF WORK, CONTRACTOR SHALL FURNISH WRITTEN INSTRUCTIONS AND EQUIPMENT MANUALS AND DEMONSTRATE TO THE OWNER THE PROPER OPERATION AND MAINTENANCE OF ALL EQUIPMENT AND APPARATUS FURNISHED UNDER THIS CONTRACT. B. THESE INSTRUCTIONS SHALL BE TYPED ON 8-1/2 IN. X 11 IN. PAPER AND BOUND IN THREE RING BINDERS WITH CLEAR ACETATE COVERS. CONTRACTOR SHALL GIVE THREE COPIES OF THE INSTRUCTIONS TO THE OWNER AND ONE COPY TO THE ENGINEER. C. THE INSTRUCTION BOOKLET SHALL BEAR THE NAME, ADDRESS AND TELEPHONE NUMBER OF THE PROJECT, ARCHITECT AND ENGINEER. D. REPRODUCIBLE "AS-BUILT" DRAWINGS SHALL BE PROVIDED INDICATING THE AS INSTALLED CONDITIONS OF THE WORK. "AS-BUILT" DRAWINGS SHALL BE PROVIDED TO THE ARCHITECT AFTER COMPLETION OF THE INSTALLATION.				
6.	FUSES A. CIRCUITS 0 TO 600 AMPERES SHALL BE PROTECTED BY FUSES SIMILAR TO CURRENT LIMITING BUSSMAN LOW-PEAK DUAL-ELEMENT TIME-DELAY LPN-RK (AMP)SP (250V) /LPS-RK (AMP)SP (600V) OR LPJ (AMP)SP (600V) (UL CLASS RK1 OR CLASS J), AND BE LISTED BY UL WITH AN INTERRUPTING RATING OF 300,000 AMPERES RMS SYMMETRICAL. B. MOTOR CIRCUITS - ALL INDIVIDUAL MOTOR CIRCUITS WITH FULL LOAD AMPERE RATINGS (FLA) OF 480 AMPERES OR LESS SHALL BE PROTECTED BY FUSES SIMILAR TO CURRENT LIMITING BUSSMANN LOW-PEAK DUAL-ELEMENT TIME-DELAY LPN-RK (AMP)SP (250V) /LPS-RK (AMP)SP (600V) OR LPJ (AMP)SP (600V) (UL CLASS RK1 OR CLASS J), AND BE LISTED BY UL WITH AN INTERRUPTING RATING OF 300,000 AMPERES RMS SYMMETRICAL. C. ALL FUSES SHALL BE PROVIDED BY SAME MANUFACTURER. D. PROVIDE 1 SPACE MATCHING FUSE FOR EACH SET OF 3. E. CIRCUIT BREAKERS: MOLDED CASE BREAKERS SHALL BE THERMAL-MAGNETIC, QUICK-MAKE-QUICK-BREAK, BOLT-ON TYPE, MANUALLY OPERATED WITH INSULATED TRIP-FREE HANDLE. MULTI-POLE TYPE BREAKERS SHALL CONTAIN INTERNAL TRIP BAR. TERMINALS SHALL BE SUITABLE FOR COPPER OR ALUMINUM CABLE. FURNISH AUXILIARY DEVICES WHERE REQUIRED FOR SHUNT-TRIPPING, OPEN AND CLOSE MOTOR OPERATOR AND ALARM INDICATION. ENCLOSURES				
7.	DISTRIBUTION PANELBOARDS, CIRCUIT BREAKER TYPE: A. THREE PHASE, 4 OR 5 WIRE, COPPER BUS BARS, WITH 2, 3, OR 4 WIRE BRANCHES, AS NOTED. CAPACITY OF PANEL AND CIRCUITS, AS NOTED BELOW. PANELBOARD TO HAVE GROUND BUS SAME SIZE AS PHASE BUSES. B. CABINETS: CODE GAUGE GALVANIZED SHEET STEEL PRIMED AND PAINTED WITH TRIM AND DOOR, TYPE AS NOTED, LAP AND RIVET CORNERS OR FORM AS APPROVED. C. TRIM: ONE PIECE FULL FINISH PRIMED AND PAINTED SHEET STEEL. TRIM SHALL BE MOUNTED WITH A CONTINUOUS PIANO HINGE CONFIGURED IN SUCH A MANNER THAT IT SHALL BE POSSIBLE TO GAIN FULL ACCESS TO CIRCUIT BREAKERS AND WIRING GUTTERS WITHOUT REMOVING THE TRIM. PROVIDE A MULTI-PIN CYLINDER LOCK (YALE, CORBIN OR EQUAL) TO LATCH THE TRIM. KEYS SHALL BE MILLED. D. HARDWARE: MULTI-PIN, CYLINDER LOCKS WITH MILLED KEYS. ALL PANELS SHALL BE KEYED ALIKE. DOOR OVER 48" HIGH SHALL BE EQUIPPED WITH A CHROME PLATED VAULT HANDLE, BUILT-IN LOCK AND 3-POINT CATCH FASTENING DOOR AT TOP, BOTTOM AND CENTER. E. HINGES: CONCEALED, CONTINUOUS PIANO HINGE AS DESCRIBED ABOVE. F. DIRECTORY HOLDER: MEAL FRAME WITH NONBREAKABLE TRANSPARENT COVER AND DIRECTORY CARD. ENTRIES TO BE TYPEWRITTEN BY ELECTRICAL CONTRACTOR. PROVIDE AN ENGRAVED LAMINATED NAMEPLATE ADJACENT TO EACH BRANCH BREAKER. MOUNT WITH SELF TAPPING MACHINE SCREWS. G. FURNISH MULTI-CABLE LUGS WHERE REQUIRED. DOUBLE LUGGING NOT PERMITTED. SECURE LUGS TO BUS BY STUD BOLTS. H. PANELBOARD CONSTRUCTION FOR BOLTED TYPE BREAKERS. MINIMUM SHORT CIRCUIT RATING 25,000 AMPERES, RMS SYMMETRICAL FOR ALL 120/208V APPLICATIONS. INDIVIDUAL CIRCUIT BREAKERS SHALL HAVE MINIMUM 100A FRAME, TRIPS SIZED AS SHOW ON THE PLANS. I. MINIMUM GUTTER SPACES: PANELS WITH 225 AMPERE MAINS, 5-¾" MINIMUM, 400 AMPERES AND OVER, MINIMUM GUTTERS 8". FOR PANELS WITH THROUGH FEEDERS, INCREASE GUTTER WIDTH BY 2" MINIMUM AND PROVIDE A SHEET STEEL BARRIER BETWEEN THE PANEL GUTTER AND THE THROUGH FEEDER PORTION OF THE BACK BOX. BRANCH CIRCUIT BREAKERS SHALL BE MECHANICALLY INTERLOCKED WHEN SHOWN ON DRAWINGS. J. DISTRIBUTION AND SUB-DISTRIBUTION PANELBOARDS SHALL BE A MINIMUM OF 30" WIDE AND 10" DEEP. K. PANELBOARD SHALL HAVE MAIN CIRCUIT BREAKER OR MAIN LUGS AS INDICATED ON THE DRAWINGS. QUANTITY, POLES AND TRIP RATINGS OF BRANCH CIRCUIT BREAKERS TO BE AS INDICATED ON DRAWINGS. L. PANELBOARD SHALL HAVE ENGRAVED WHITE CORE, BLACK LAMACOID NAMEPLATE SCREWED ONTO PANE TRIM WITH DESIGNATION LISTED (PANELBOARD NAME, VOLTAGE, RATING OR MAINS IN AMPS).				
8.	CIRCUIT BREAKERS: MOLDED CASE BREAKERS SHALL BE THERMAL-MAGNETIC, QUICK-MAKE-QUICK-BREAK, BOLT-ON TYPE, MANUALLY OPERATED WITH INSULATED TRIP-FREE HANDLE. MULTI-POLE TYPE BREAKERS SHALL CONTAIN INTERNAL TRIP BAR. TERMINALS SHALL BE SUITABLE FOR COPPER OR ALUMINUM CABLE. FURNISH AUXILIARY DEVICES WHERE REQUIRED FOR SHUNT-TRIPPING, OPEN AND CLOSE MOTOR OPERATOR AND ALARM INDICATION. ENCLOSURES				

LIGHTING KEYED NOTES: (#)

- EXISTING LIGHTING FIXTURES ALONG WITH THEIR CIRCUITS AND CONTROLS SHALL REMAIN. E.C. TO VERIFY OPERABLE CONDITIONS IN THE FIELD. REPLACE IF FOUND INOPERABLE.BASE BID ACCORDINGLY.
- LOOP ALL EMERGENCY LIGHT FIXTURES AND EXIT SIGNS AND WIRE THEM BACK TO THE EMERGENCY LIGHTING CIRCUIT IN THE PANEL. THE CIRCUIT SHALL HAVE A LOCKOUT BREAKER.
- COORDINATE EXACT LOCATION OF TIME CLOCK WITH ARCHITECT/OWNER. ALL LIGHTING CIRCUIT SHALL PASS THROUGH T.C.
- CEILING MOUNTED DAY-LIGHT SENSOR (LS). ALL LIGHTS ARE IN PRIMARY DAYLIGHT ZONE IN THIS LIGHTING PLAN AND AUTOMATIC DAYLIGHT CONTROL WILL BE VIA LIGHT SENSOR.
- TOGGLE DISCONNECT SWITCH FOR CONNECTION TO EXTERIOR SIGNAGE. E.C. TO VERIFY THE LOCATION OF EXISTING EXTERIOR SIGNAGE IN THE FIELD AND PROVIDE NEW IF EXISTING IS NOT OPERABLE.
- E.C. TO VERIFY EXISTING CEILING MOUNTED RECEPTACLES FOR SHOW WINDOW. PROVIDE NEW IF EXISTING IS INOPERABLE.
- EC TO PROVIDE A NEW SWITCH BANK AS / IF REQUIRED. EC SHALL COORDINATE EXACT & FINAL LOCATION OF SWITCH BANK IN FIELD.

LIGHT FIXTURE SCHEDULE GENERAL NOTES:

- VERIFY ALL LUMINAIRE COLORS, TRIMS, LENGTHS, ETC. WITH THE ARCHITECT PRIOR TO PLACING FINAL PURCHASE ORDERS. SUBMISSION PF SHOP DRAWINGS WILL BE INTERPRETED AS HAVING BEEN COORDINATED WITH THE ARCHITECTURAL DRAWINGS .
- PROVIDE ALL LENGTHS, FEEDS, ACCESSORIES, CONNECTORS, WIRING, POWER SUPPLIES, DRIVERS ETC. FOR A COMPLETE INSTALLATION. THE E.C. SHALL VERIFY THE COMPLETE BILL OF MATERIAL WITH MANUFACTURER'S REPRESENTATIVE AND ENSURE ALL EQUIPMENT ARE INCLUDED IN BID PRICE. COORDINATE INSTALLATION WITH ARCHITECTURAL DETAILS.
- VERIFY FINAL LUMINAIRE LOCATIONS WITH OTHER CEILING MOUNTED EQUIPMENTS SUCH AS DIFFUSER WITH ARCHITECTURAL REFLECTED CEILING PLANS.
- ANY PROPOSED ALTERNATE LUMINAIRES SHALL BE APPROVED BY THE ARCHITECT PRIOR TO FINAL BID PRICING.
- SHOULD THE CONTRACTOR PROPOSE TO FURNISH MATERIALS, EQUIPMENT AND DEVICES OTHER THAN THOSE SPECIFIED AND LISTED, THE CONTRACTOR SHALL SUBMIT A WRITTEN REQUEST FOR SUBSTITUTIONS, TO THE ENGINEERS AT LEAST TEN (10) BUSINESS DAYS PRIOR TO BID OPENING. THE REQUEST SHALL BE AN ALTERNATE TO THE ORIGINAL BID AND SHALL INCLUDE A COMPLETE SPECIFICATIONS CUTSHEET SUBMITTAL AS OUTLINED IN THE SPECIFICATIONS, COMPLETE WITH DESCRIPTIVE (MANUFACTURER, BRAND NAME, CATALOG NUMBER, ETC.) AND TECHNICAL DATA FOR ALL ITEMS. INDICATE ANY ADDITIONS OR DEDUCTIONS TO THE CONTRACT PRICE WITH THE SUBSTITUTION SUBMITTAL AND ON THE BID FORM.
- ALL EMERGENCY LIGHTING FIXTURES AND EXIT SIGNS SHALL HAVE A MINIMUM OF 90 MINUTES OF BATTERY BACKUP OR AS REQUIRED BY AHJ.
- ALL THE LIGHTING FIXTURES SHALL BE LED TYPE, OPERABLE AT 120V UNLESS OTHERWISE NOTED.
- FIXTURE LOCATED ABOVE COOKING EQUIPMENT SHALL BE VAPOR-PROOF TYPE.

LIGHTING PLAN GENERAL NOTES:

- CONTRACTOR IS ADVISED THAT ADJUSTMENTS TO EMERGENCY AND EXIT LIGHT FIXTURE LOCATIONS/QUANTITIES MAY BE REQUIRED BY AHJ UPON FINAL INSPECTION.
- ALL EMERGENCY AND EXIT LIGHT FIXTURES SHALL BE CONNECTED AHEAD OF SWITCHED LIGHTING CIRCUIT.
- UNLESS OTHERWISE NOTED, LIGHT SWITCHES SHALL BE GANGED TOGETHER UNDER A COMMON FACEPLATE.
- ALL WIRING AND CABLES SHOULD BE PLENUM RATED. ALL WIRING LINES INCLUDING LOW VOLTAGE IN THE CEILING PLENUM SHALL BE IN CONDUIT.
- EMERGENCY LIGHT SHALL TURN ON DURING POWER FAILURE WHEREAS ALL EXIT SIGNS SHALL BE PERMANENTLY ON. WIRE THE FIXTURES ACCORDINGLY.
- THE NEUTRAL AND GROUNDING ARE NOT SHOWN ON THE DRAWING. E.C. TO PROVIDE AS REQUIRED.
- NEW EMERGENCY LIGHT FIXTURES MAKE AND MODEL SHOULD THE BE SAME AS EXISTING.

LIGHTING FIXTURE SCHEDULE


SYMBOL	FIXTURE TAG	DESCRIPTION/NAME	SUPPLIER/MANUFACTURE	COLLECTION/ MODEL #	WATTAGE
	L1	FOH PENDANT	SCHNEID STUDIO	THE JUNIT LAMP; DROP	6 WATT
	L2	RECESS DOWNLIGHT	WAC LIGHTING	HR-LED212E	4 WATT
	L3	RECESSED LIGHTING	VISUAL COMFORT	MODEL: ENCL3RFA-930W-W UC-42-15-930-SV-D (53506111)	8 WATT
	L4	UNDER CABINET LIGHT	ETI		22 WATT

ABBREVIATIONS :

N = NEW LIGHT FIXTURE
E = EXISTING LIGHT FIXTURE

MULTILEVEL LIGHTING CONTROL:

THE LOWER CASE LETTERS "a" "b" & "c" MARKED NEAR THE LIGHTING FIXTURES INDICATES THE SWITCH CONTROL. THE SWITCHES AND SENSORS (OCCUPANCY SENSOR & DAY LIGHT SENSOR SHOWN ON THE LIGHTING PLAN) SHALL BE CONNECTED SUCH THAT THE DIFFERENT LEVEL OF ILLUMINATION CAN BE ACHIEVED COMPLYING THE REQUIREMENT OF MULTILEVEL SWITCHING REQUIRED UNDER 130.1 (b) OF TITLE 24. THE SENSORS SHALL MEET THE CONTROL FUNCTION REQUIREMENTS.

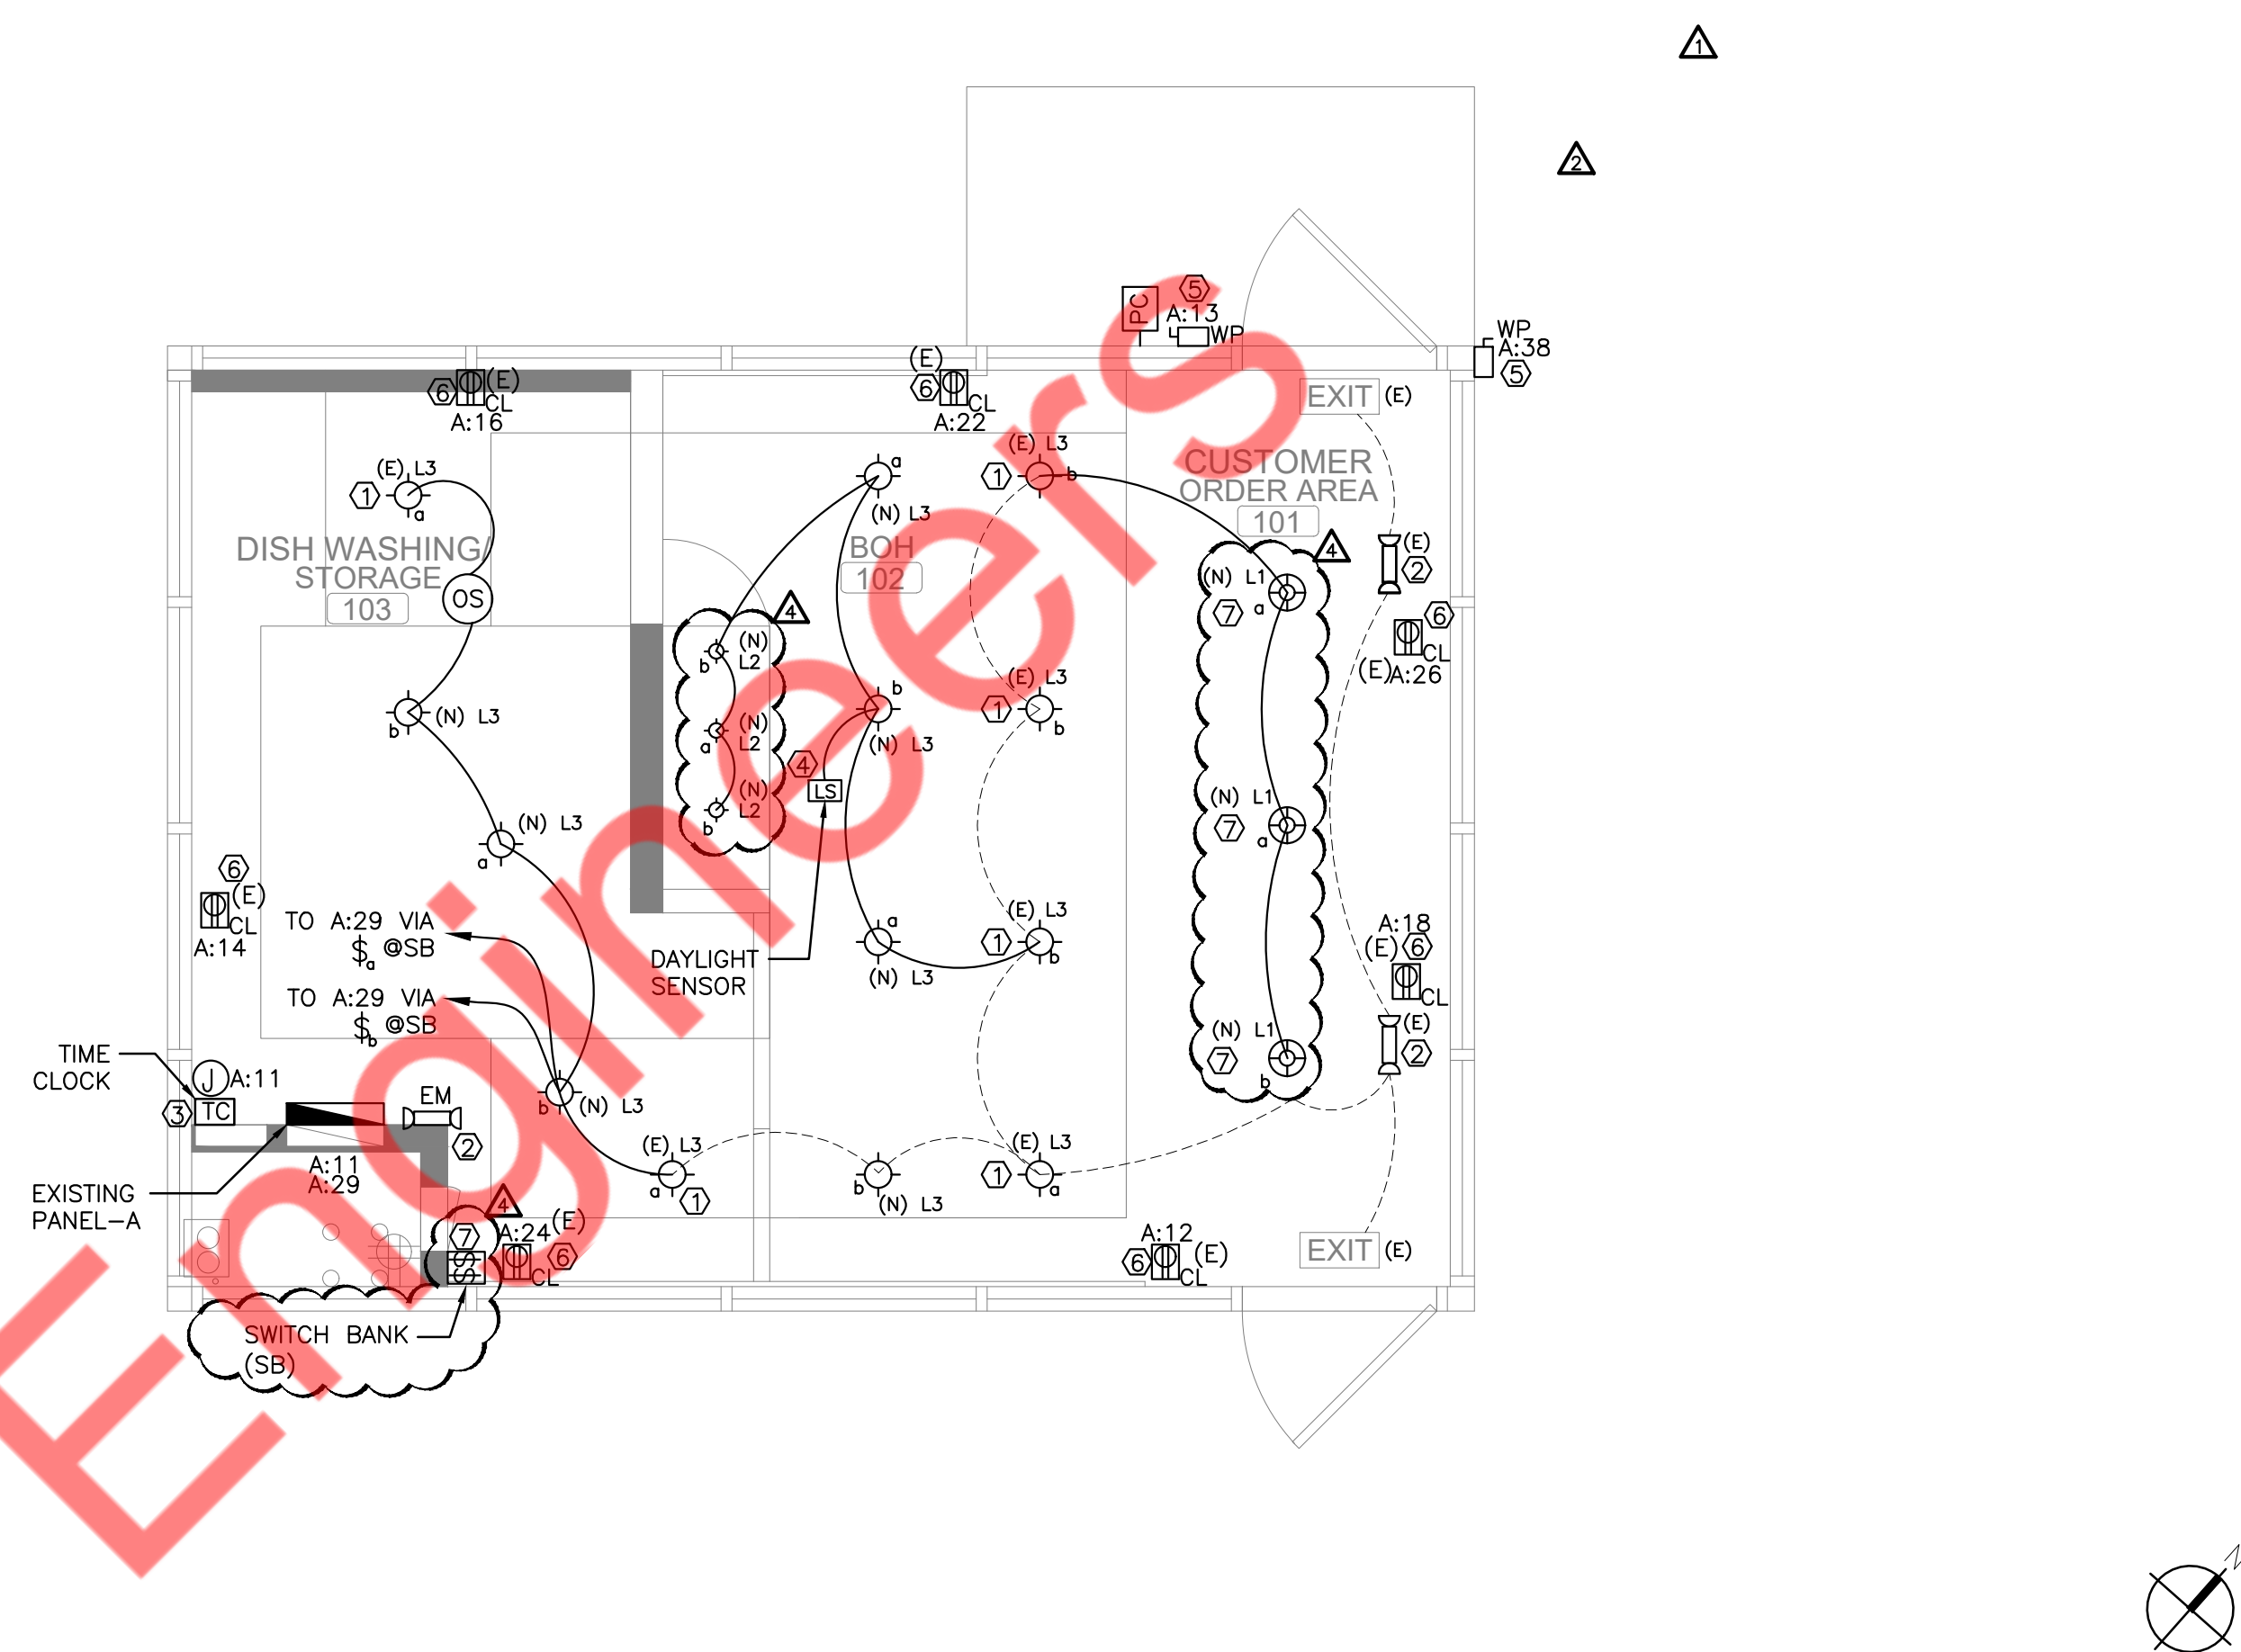

ELECTRICAL LIGHTING PLAN

SCALE
3/8"=1'-0"

1

ID	NAME	MFG.	MODEL /SIZE	VOLTAGE	PHASE	WATT	AMPS	NEMA	NOTES
E01	LINEA PB W SCALE BUILT IN	LA MARZOCCO	PB 2 GROUP	208	1	4600	30	-	1,2,5,6
E02	GRINDER (FILTER)	MAHKONIG	EK43	208	1	1300	13	-	1,2,5,6
E03	MAZZER ROBUR	ESPRESSO PARTS	ROBUR 5	120	1	800	6.6	-	1,2,5,6
E07	SINGLE COFFEE BREWER	CURTIS	CRS-2251 NG	208	1	6000	25.5	-	1,2,5,6
E10	ICE MACHINE	MANITOWOC	IT1200	208	1	2950	14.2	-	1,2,5,7
E12	BLENDER	BLEND TEC	CONNOISSEUR 825 BLENDER	120	1	1800	15	NEMA 5-15P	1,2,5,6
E13	POS	SQUARE	POS KIT	115	1			NEMA 5-15P	1,2,4,7
E14	UNDER COUNTER REFRIGERATOR	BEVERAGE AIR	UCR20HC	115	1	300	2.5	NEMA 5-15P	1,2,6
E15	RECAH IN UNIT	FEDRA	UCBSA3573S	120	1	1480	12.3	NEMA 5-20P	1,2,6
E18	REACH IN UNIT	TURBO AIR	TOM-36UC-W-N 36" White Drop-In Refrigerated Open Display Case Merchandiser	115	1	600	7.5	NEMA 5-15P	1,2,6
E19	SQUARE PRINTER	SQUARE	NOTE: INCLUDED IN SQUARE POS KIT	115				NEMA 5-15P	1,2,4,6
E20	PUOPRESS	PUQ Q1	5.6" X 7.7" X 11.3"	115	1	76		NEMA 5-15P	1,2,5,6
E23	AIR CURTAIN	SCHWANKAIR	AC-1036-12-6K-36"	120	1	380	3.2	NEMA 5-15P	1,2,5,6
E27	UNDER COUNTER SINGLE DOOR FREEZER	BEVERAGE AIR	UCF20HC	115	1	300	2.5	NEMA 5-15P	1,2,5,6
P03	WATER HEATER	DEL-50	48 GAL						1,2,5,6
P04	WATER FILTRATION SYSTEM	3M	TFS450, 30GAL						

NOTES:

- REFER TO THE PANEL SCHEDULE FOR CIRCUIT NUMBER INFORMATION.
- CONTRACTOR TO COORDINATE WITH MANUFACTURER INSTALLATION MANUAL FOR ALL POWER AND COMMUNICATION CONNECTION REQUIREMENTS.
- ALL EQUIPMENT UNDER THE HOOD SHALL HAVE SHUNT TRIP BREAKER.
- COORDINATE EXACT MAKE/MODEL NUMBER WITH THE OWNER/ARCHITECT.
- COORDINATE THE EXACT CONNECTION TYPE WITH THE VENDOR BEFORE BID.
- COORDINATE MOUNTING HEIGHT OF THE RECEPTACLE OR DISCONNECTION WITH THE ARCHITECT/OWNER.


ELECTRICAL POWER PLAN GENERAL NOTES:

- ALL THE BRANCH WIRING SHALL BE COPPER. THE INSULATION SHALL BE RATED FOR THE AREA OF THE USE.
 - POWER AND LOCATION OF ALL THE MECHANICAL AND PLUMBING UNITS SHALL BE COORDINATED WITH THE RESPECTIVE CONTACTORS BEFORE BID.
 - ELECTRICAL OUTLETS PLACED ON BOTH SIDES OF THE WALL PARTITION TO BE LOCATED OFFSET OF EACH OTHER.
 - ELECTRICAL OUTLETS AND DEVICES LOCATED IN DEMISING WALLS TO HAVE FIRE
 - PUTTY AROUND THE BOX TO MAINTAIN PARTITION FIRE RATING.
- THE DISCONNECT SWITCHES FOR THE BRANCH CIRCUIT SHOWN ON THE PLAN SHALL BE RATED EQUAL TO OR HIGHER THAN THE BREAKER RATING. REFER BREAKER RATING IN THE PANEL SCHEDULE AND PROVIDE DISCONNECT AS NEEDED.
- GFI MARKED ON THE PLAN INDICATES THAT THE CIRCUIT SHALL BE GFI PROTECTED. E.C. SHALL PROVIDE A GFI RECEPTACLE IN THE READILY ACCESSIBLE LOCATION. PROVIDE GFI BREAKER IN THE PANEL IF EITHER THE RECEPTACLE IS NOT AVAILABLE OR NOT ACCESSIBLE WHEN INSTALLED IN THE DESIRED LOCATION.

- ALL EQUIPMENT AND RECEPTACLES SHOWN ON THE PLAN ARE NEW. UNLESS NOTED OTHERWISE.
- E.C. SHALL VERIFY THE EXACT LOCATION AND OPERABLE CONDITION OF THE EXISTING MECHANICAL UNITS IN THE FIELD. PROVIDE NEW CIRCUIT, DISCONNECT/SWITCH IF EXISTING IS INOPERABLE.

ELECTRICAL POWER PLAN KEYED WORK NOTES:

- QUAD & DATA OUTLET FOR DESK. E.C. TO VERIFY EXACT LOCATION AND MOUNTING HEIGHT OF OUTLETS WITH ARCHITECT/OWNER PRIOR TO BID.
- E.C. SHALL VERIFY WITH THE ARCHITECT/OWNER FOR THE EXACT LOCATION OF THE EXISTING PANEL ALSO, ENSURE CLEAR WORKING AND DEDICATED SPACE HAVE BEEN PROVIDED PER CODE.
- COORDINATE EXACT LOCATION AND MOUNTING HEIGHT WITH OWNER/ARCHITECT.
- E.C. SHALL COORDINATE WITH THE MECHANICAL CONTRACTOR FOR THE EXACT LOCATION AND ELECTRICAL CONNECTION REQUIREMENT OF THE UNIT IN THE FIELD. PROVIDE CIRCUIT AND CONTROL AS REQUIRED.
- PROVIDES QUAD AND DATA/TEL COMBINATION FOR THE IT RACK. COORDINATE WITH THE ARCHITECT/OWNER/SERVICE PROVIDER FOR OTHER REQUIREMENTS. PROVIDE CONDUIT AND CONNECTION AS REQUIRED.

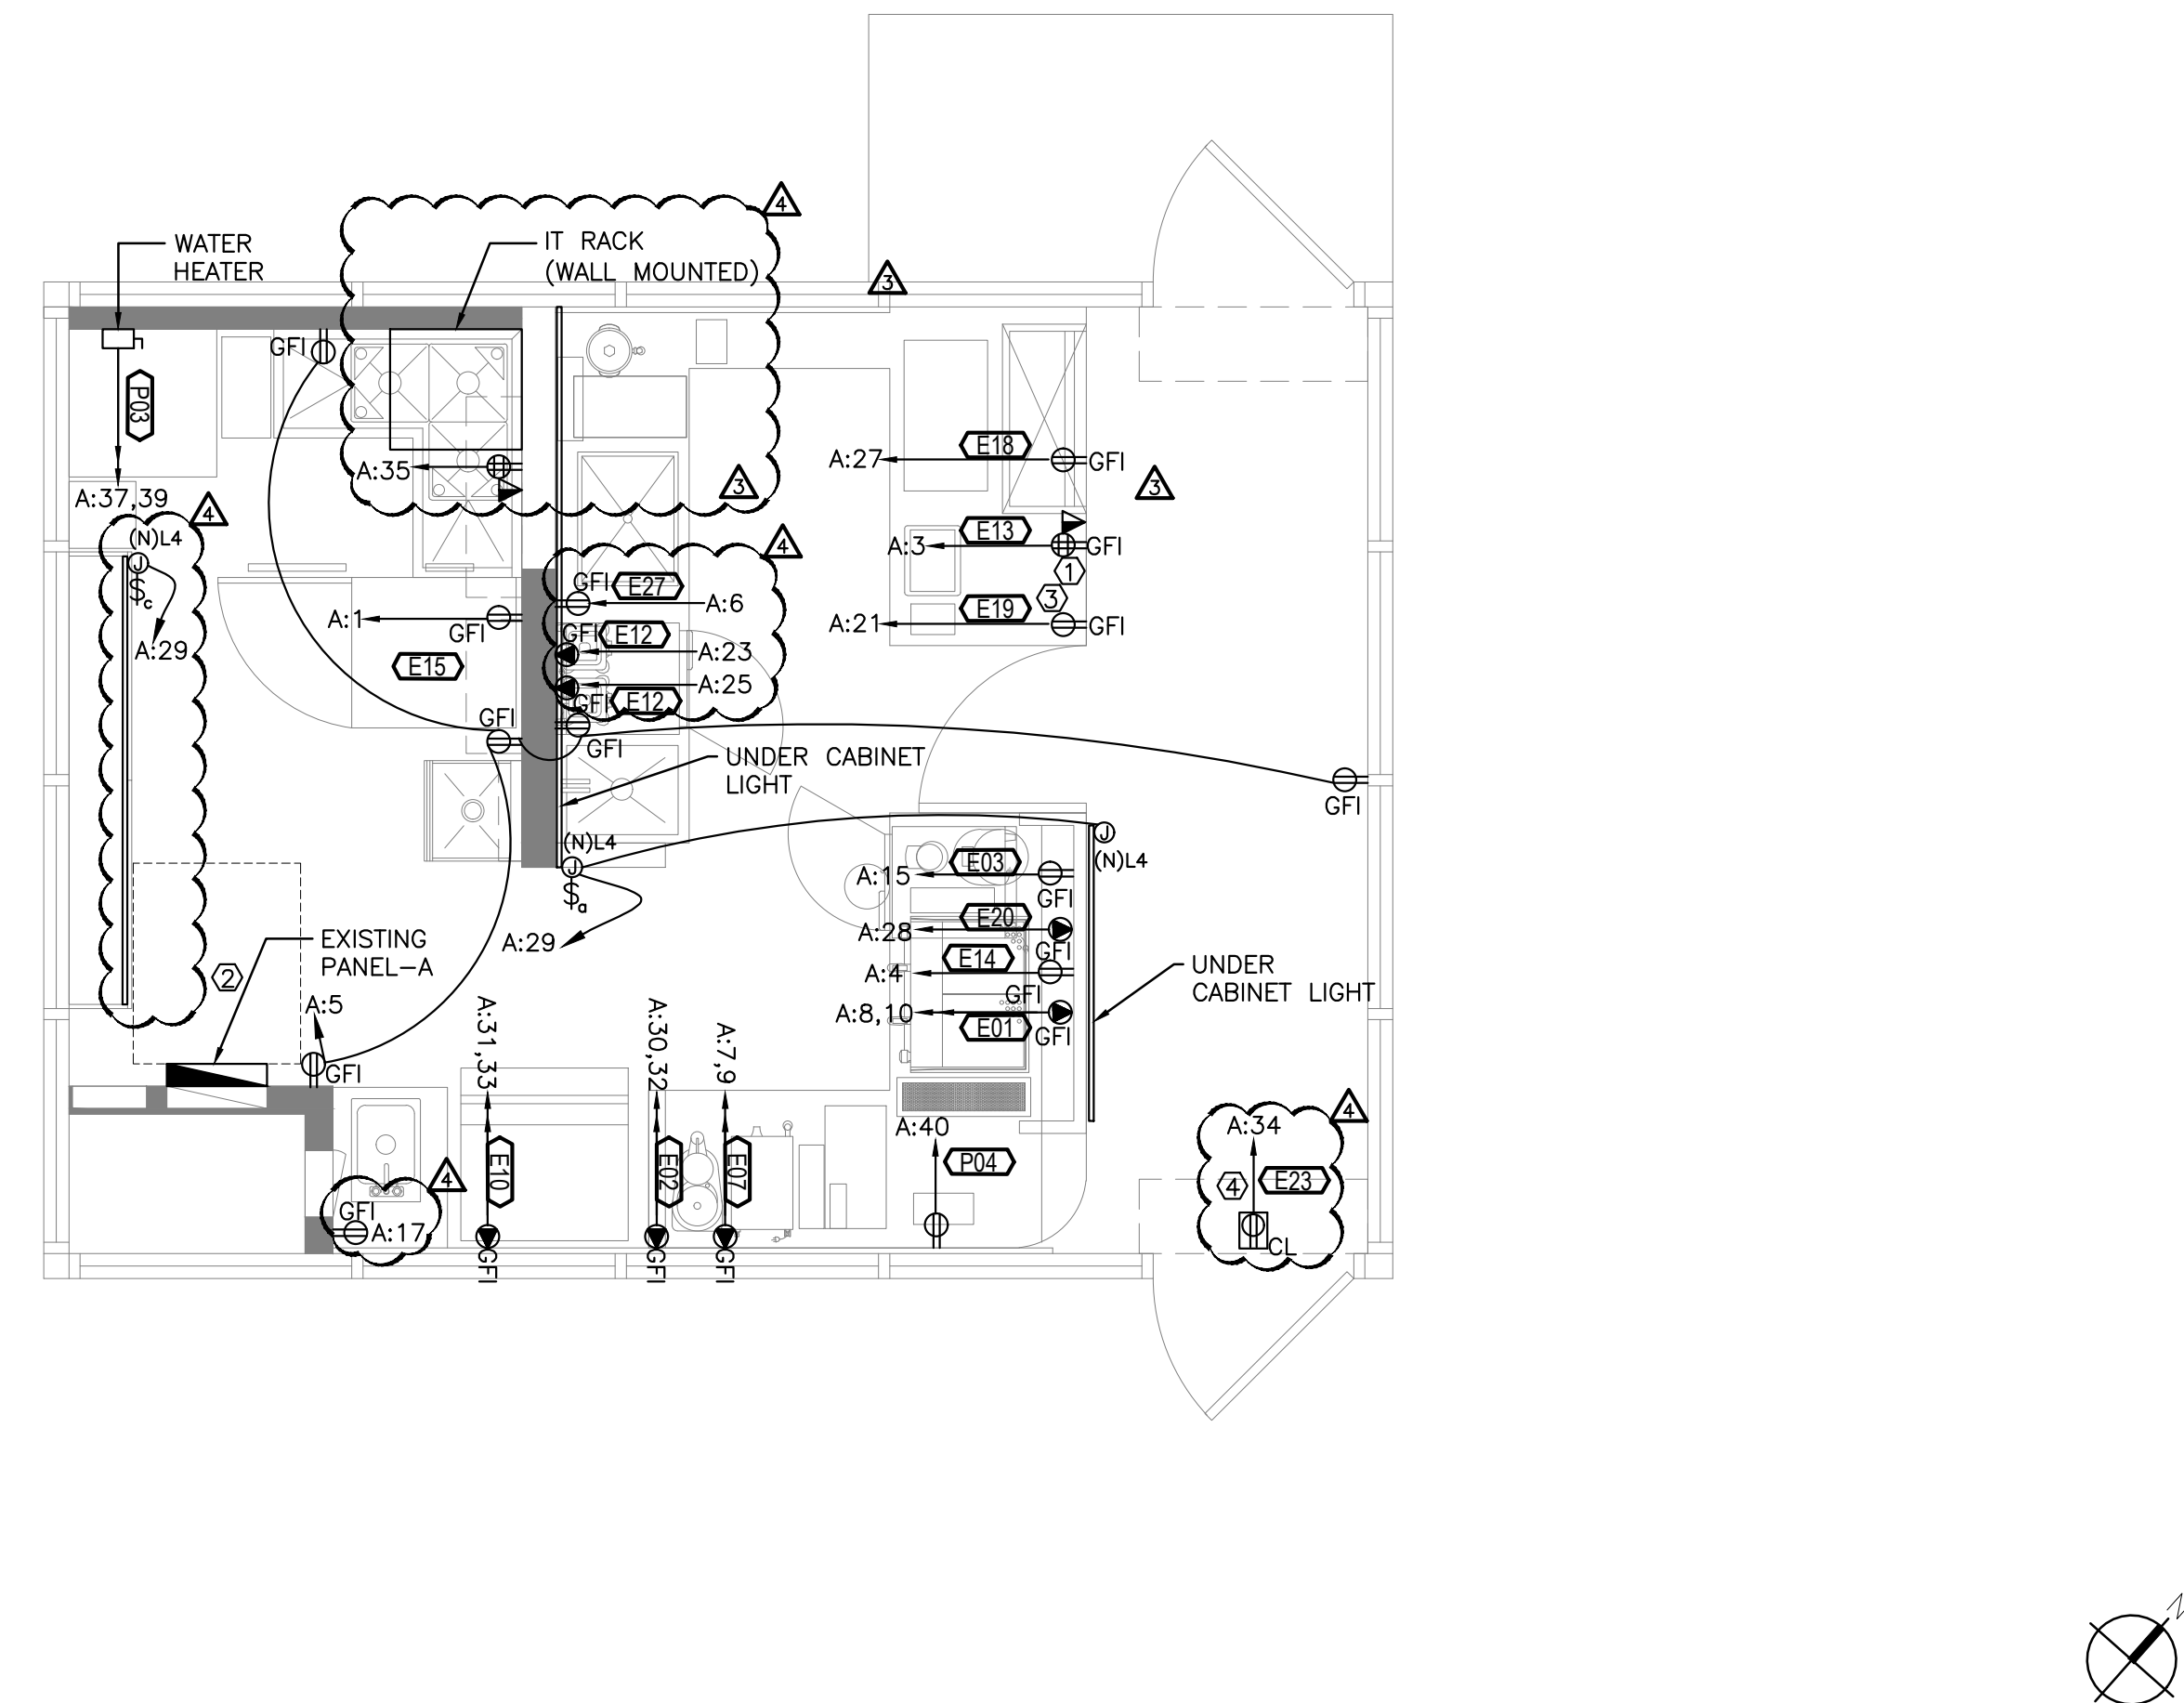

ELECTRICAL POWER PLAN

SCALE
3/8"=1'-0"

2

Project Owner:

Chamberlain
Coffee

Issue For Description:

Issue Date:

09.10.24

Revisions:


NO.	DESCRIPTION	DATE
1	ELECTRICAL COMMENTS	10.01.24
2	CITY COMMENTS	10.02.24
3	HEALTH DEPARTMENT COMMENTS	10.21.24
4	HEALTH DEPT/CLIENT REVISIONS	11.05.24

Sheet Title:

ELECTRICAL
LIGHTING AND
POWER PLAN

Sheet Number:

E100

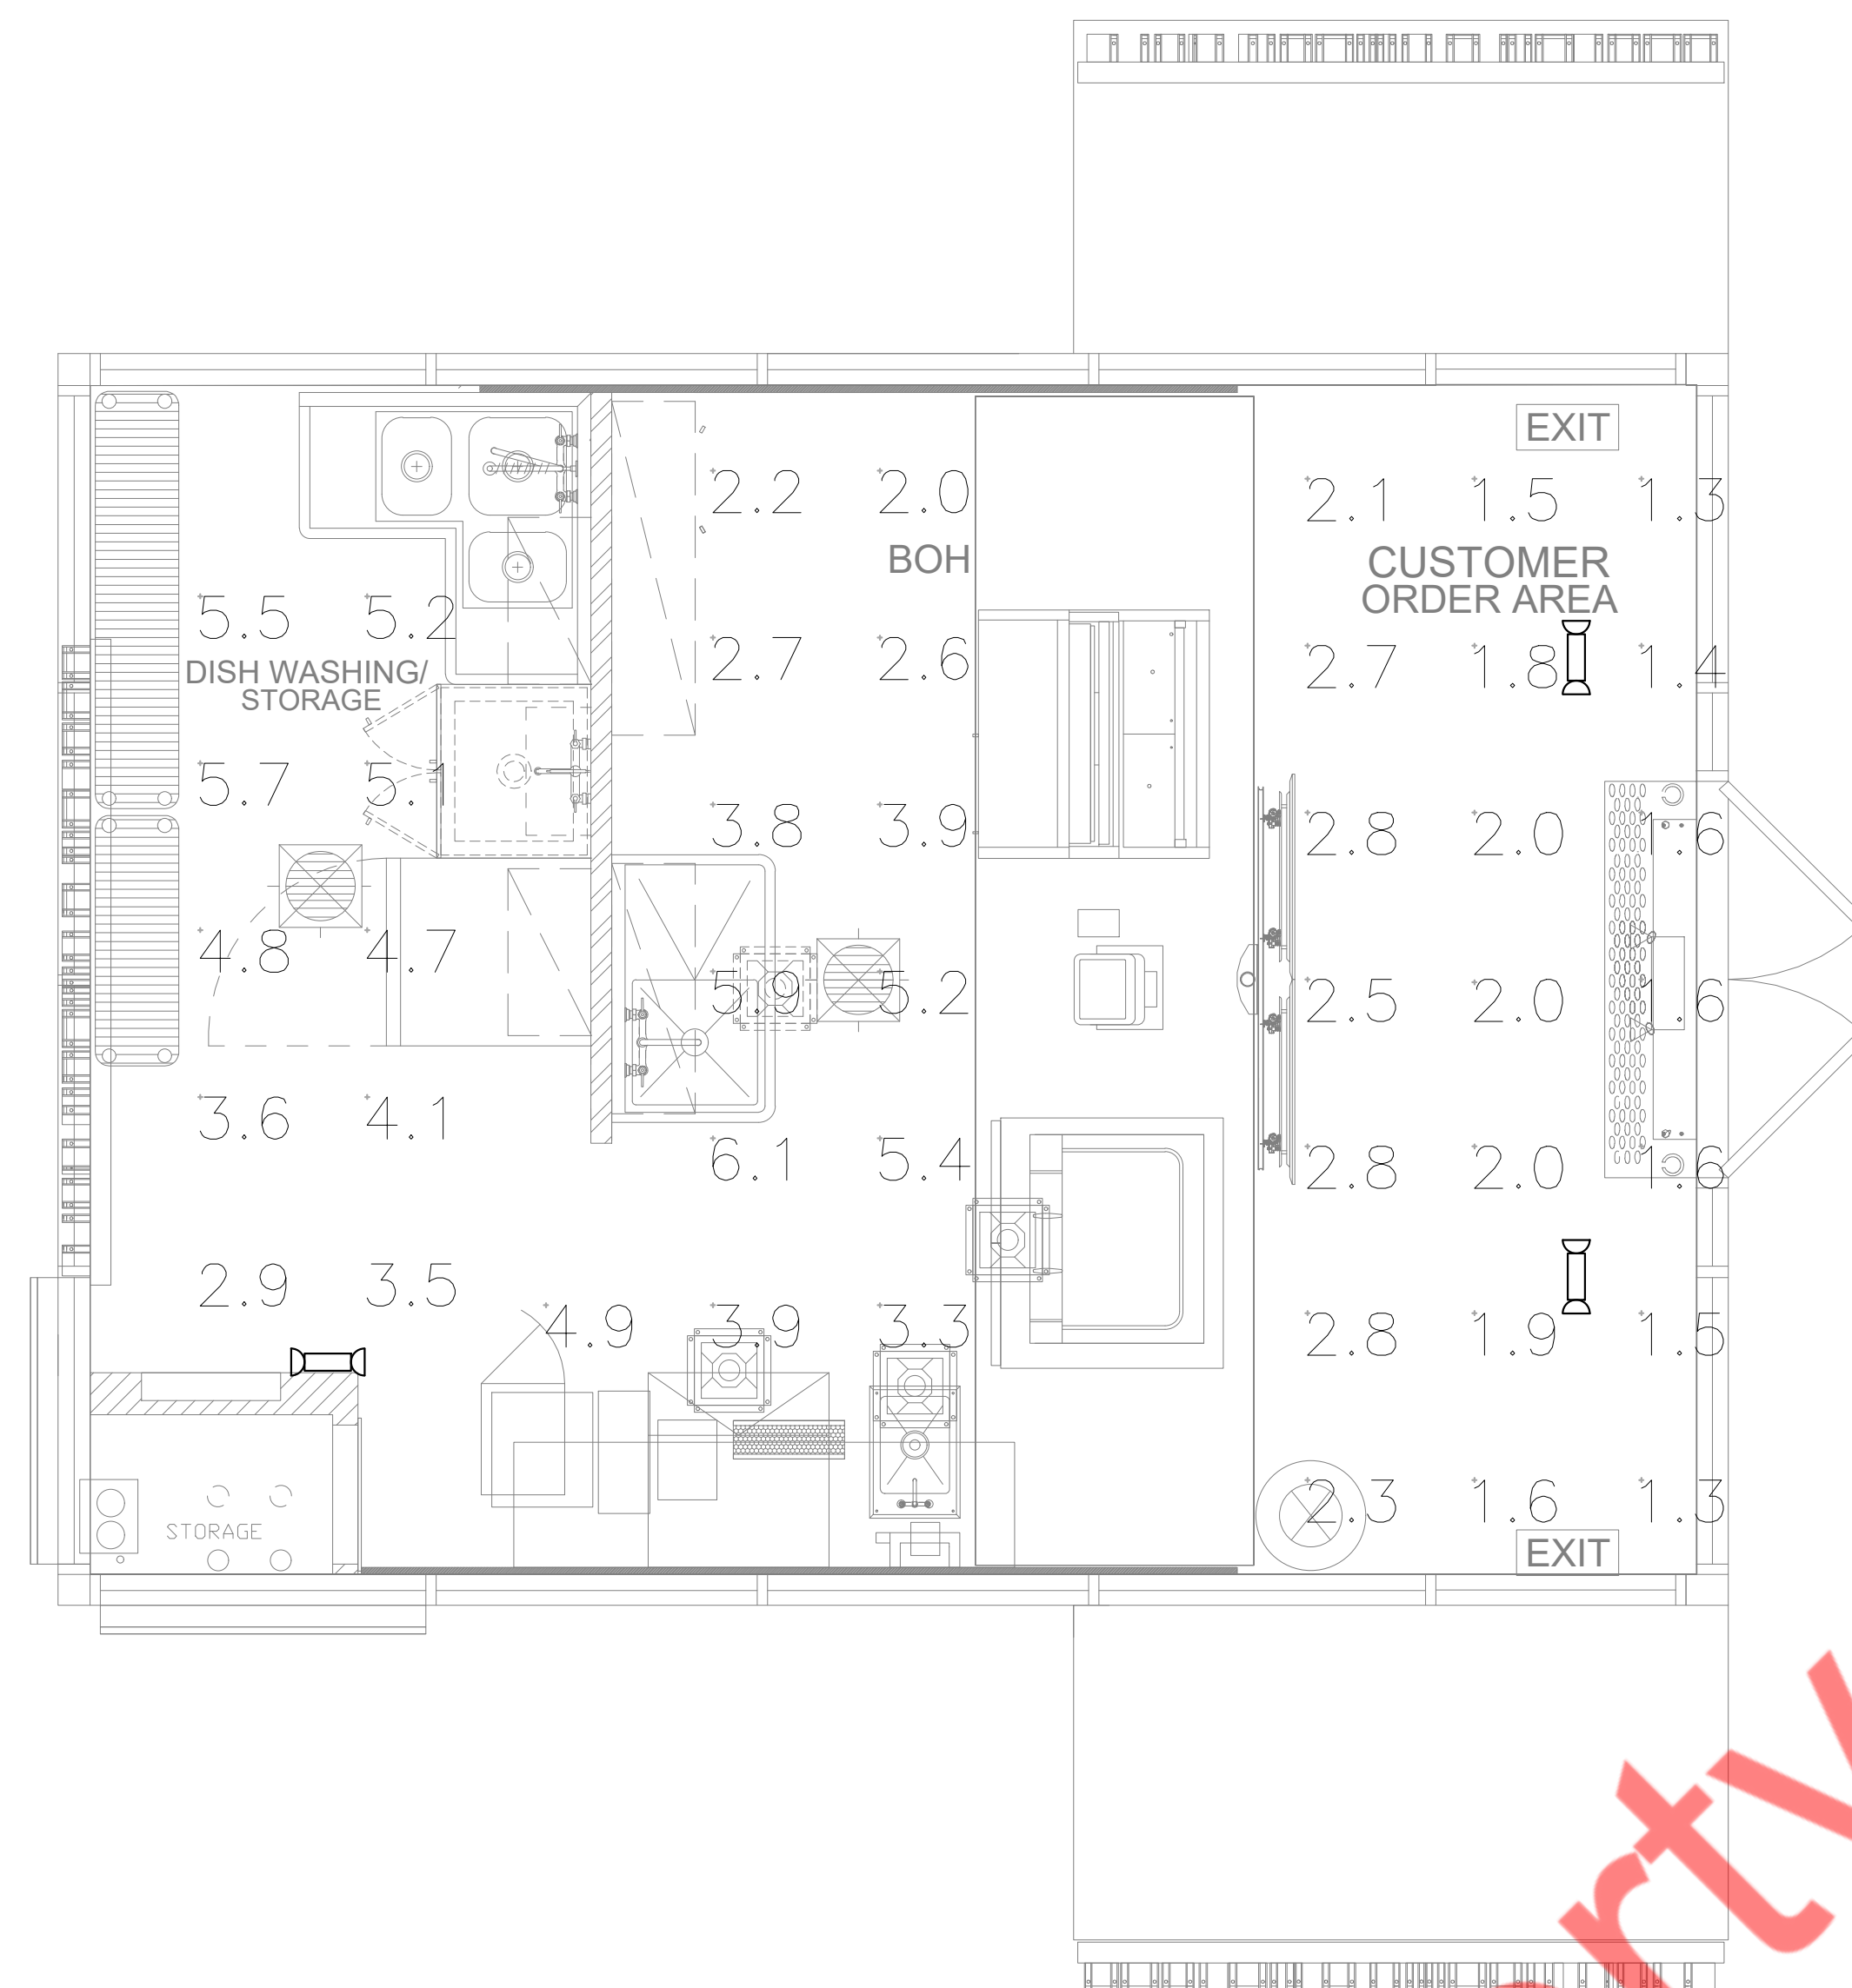

GENERAL NOTES:


1. CW/HW PIPING PROVIDED WITH INSULATION AS PER 2022 CALIFORNIA ENERGY CODE.
2. PROVIDE BRANCH PRV IF PRESSURE EXCEEDS 80 PSI.
3. PROVIDE ACCESS PANELS FOR WATER HAMMER ARRESTOR, CLEANOUTS & SHUT-OFF VALVES AS REQUIRED.
4. REFER RISER DIAGRAMS FOR ALL PIPE SIZES.
5. CONTRACTOR TO FIELD VERIFY THAT THE BACKFLOW PREVENTION DEVICE SHALL BE ASSE 1013 OR SIMILAR APPROVED AS PER LOCAL JURISDICTION. AND, PROVIDE REQUIRED AIR GAP TO AFFORD BACKFLOW PREVENTION PROTECTION AS PER 2022 CPC SECTION 603.3.1.
6. ANY UNUSED EXISTING PLUMBING PIPING MUST BE COMPLETELY REMOVED OR CAPPED. DO NOT ABANDON IN PLACE.

1. CW/HW PIPING PROVIDED WITH INSULATION AS PER 2022 CALIFORNIA ENERGY CODE.
2. PROVIDE BRANCH PRV IF PRESSURE EXCEEDS 80 PSI.
3. PROVIDE ACCESS PANELS FOR WATER HAMMER ARRESTOR, CLEANOUTS & SHUT-OFF VALVES AS REQUIRED.
4. REFER RISER DIAGRAMS FOR ALL PIPE SIZES.
5. CONTRACTOR TO FIELD VERIFY THAT THE BACKFLOW PREVENTION DEVICE SHALL BE ASSE 1013 OR SIMILAR APPROVED AS PER LOCAL JURISDICTION. AND, PROVIDE REQUIRED AIR GAP TO AFFORD BACKFLOW PREVENTION PROTECTION AS PER 2022 CPC SECTION 603.3.1.
6. ANY UNUSED EXISTING PLUMBING PIPING MUST BE COMPLETELY REMOVED OR CAPPED. DO NOT ABANDON IN PLACE.

WATER PIPING KEYED NOTES:

1. EXTEND AND CONNECT NEW 1" CW LINE TO EXISTING CW LINE. IN SPACE. CONTRACTOR TO FIELD VERIFY CW LINE CONDITION, LOCATION AND SIZE OF EXISTING CW LINE.
2. EXTEND AND CONNECT NEW ½" CW/HW LINE TO EXISTING CW/HW LINE. CONTRACTOR TO FIELD VERIFY EXISTING WATER LINE SIZE, ROUTING AND LOCATION.
3. EXTEND AND CONNECT NEW ¾" CW/HW LINE TO EXISTING CW/HW LINE. CONTRACTOR TO FIELD VERIFY EXISTING WATER LINE SIZE, ROUTING AND LOCATION.
4. NEW FILTRATION SYSTEM. COORDINATE WITH LANDLORD/ ARCHITECT FOR FINAL LOCATION.
5. CONTRACTOR TO VERIFY AVAILABILITY OF EXISTING BFP AND WATER METER, PROVIDE NEW IF NOT EXISTING. INSTALL BFP AND WATER METER AS PER LOCAL JURISDICTION REQUIREMENT. BASE BID ACCORDINGLY. COORDINATE WITH LANDLORD/ ARCHITECT FOR FINAL LOCATION.
6. CONTRACTOR TO FIELD VERIFY THE CONDITION OF EXISTING PIPING AND REUSE. PROVIDE NEW AS SHOWN ON PLAN IF NOT WORKING. BASE BID ACCORDINGLY.
7. PROVIDE ASSE 1022 APPROVED BACKFLOW PREVENTOR TO ICE MACHINE FOR BACKFLOW PREVENTION. INSTALL BFP AN ACCESSIBLE LOCATION.
8. ROUTE WATER HEATER T&P RELIEF DRAIN TO ADJACENT EXISTING FLOOR DRAIN. CONTRACTOR TO FIELD VERIFY EXACT LOCATION OF EXISTING FLOOR DRAIN.

1. EXTEND AND CONNECT NEW 1" CW LINE TO EXISTING CW LINE IN SPACE. CONTRACTOR TO FIELD VERIFY CW LINE CONDITION, LOCATION AND SIZE OF EXISTING CW LINE.
2. EXTEND AND CONNECT NEW ½" CW/HW LINE TO EXISTING CW/HW LINE. CONTRACTOR TO FIELD VERIFY EXISTING WATER LINE SIZE, ROUTING AND LOCATION.
3. EXTEND AND CONNECT NEW ¾" CW/HW LINE TO EXISTING CW/HW LINE. CONTRACTOR TO FIELD VERIFY EXISTING WATER LINE SIZE, ROUTING AND LOCATION.
4. NEW FILTRATION SYSTEM. COORDINATE WITH LANDLORD/ ARCHITECT FOR FINAL LOCATION.
5. CONTRACTOR TO VERIFY AVAILABILITY OF EXISTING BFP AND WATER METER, PROVIDE NEW IF NOT EXISTING. INSTALL BFP AND WATER METER AS PER LOCAL JURISDICTION REQUIREMENT. BASE BID ACCORDINGLY. COORDINATE WITH LANDLORD/ ARCHITECT FOR FINAL LOCATION.
6. CONTRACTOR TO FIELD VERIFY THE CONDITION OF EXISTING PIPING AND REUSE, PROVIDE NEW AS SHOWN ON PLAN IF NOT WORKING. BASE BID ACCORDINGLY.
7. PROVIDE ASSE 1022 APPROVED BACKFLOW PREVENTOR TO ICE MACHINE FOR BACKFLOW PREVENTION. INSTALL BFP AN ACCESSIBLE LOCATION.
8. ROUTE WATER HEATER T&P RELIEF DRAIN TO ADJACENT EXISTING FLOOR DRAIN. CONTRACTOR TO FIELD VERIFY EXACT LOCATION OF EXISTING FLOOR DRAIN.

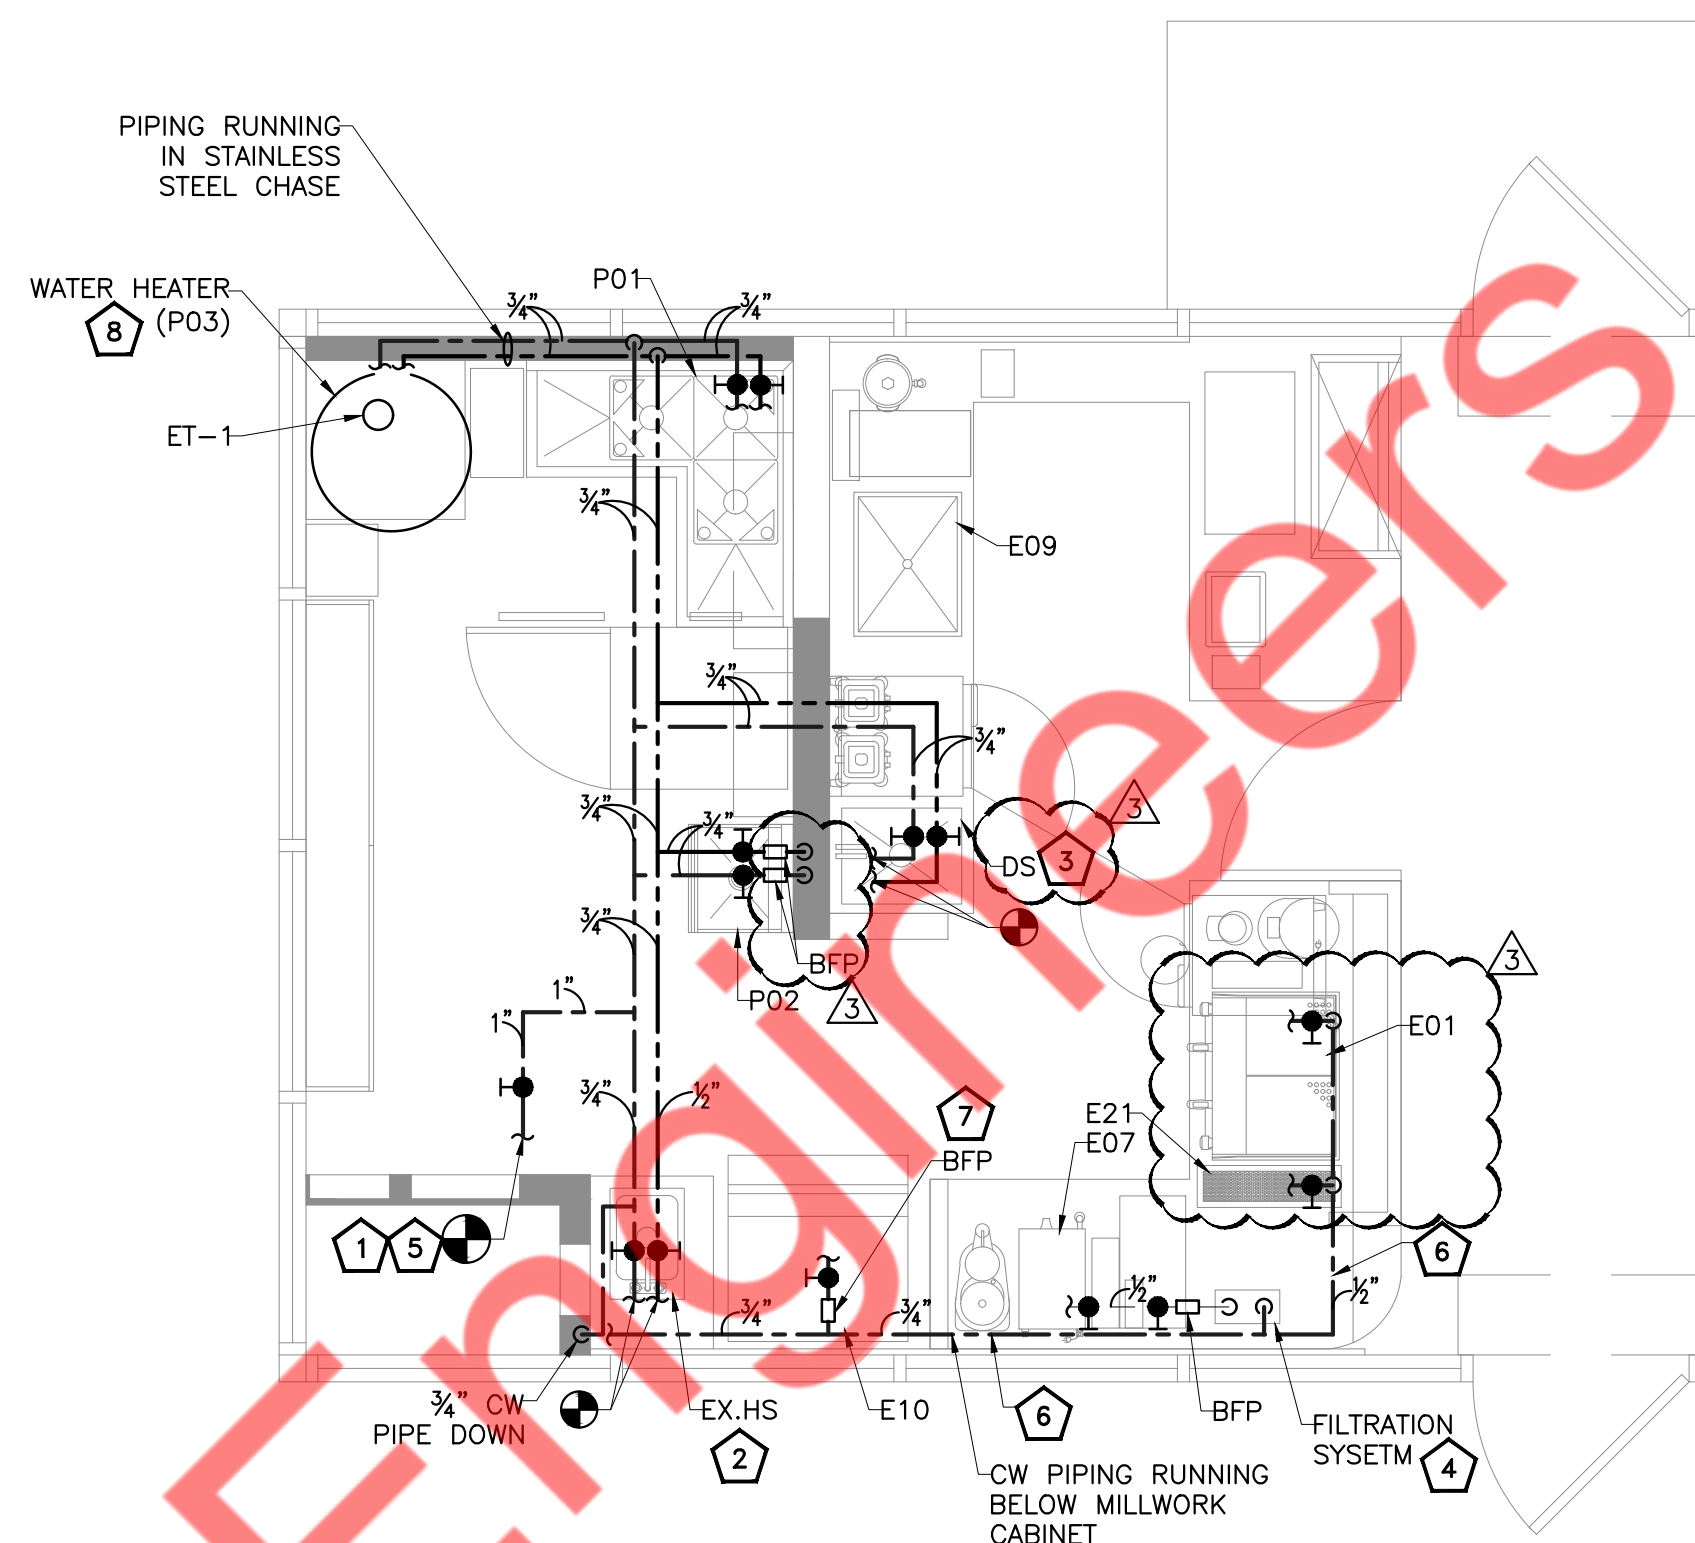

SCALE	1
3/8"=1' 0"	

SCALE
$3/8"=1'-0"$

[illegible]

GENERAL NOTES:


1. REFER RISER DIAGRAMS FOR ALL PIPE SIZES.
2. REUSE EXISTING PLUMBING PIPING AND FIXTURES WHERE EVER POSSIBLE. COORDINATE WITH ARCHITECT/LANDLORD BEFORE REUSE BASE BID ACCORDINGLY.
3. ANY UNUSED EXISTING PLUMBING PIPING MUST BE COMPLETELY REMOVED OR CAPPED. DO NOT ABANDON IN PLACE.

1. REFER RISER DIAGRAMS FOR ALL PIPE SIZES.
2. REUSE EXISTING PLUMBING PIPING AND FIXTURES WHERE EVER POSSIBLE. COORDINATE WITH ARCHITECT/LANDLORD BEFORE REUSE BASE BID ACCORDINGLY.
3. ANY UNUSED EXISTING PLUMBING PIPING MUST BE COMPLETELY REMOVED OR CAPPED. DO NOT ABANDON IN PLACE.

SANITARY PIPING KEYED NOTES:

- 1 PROVIDE REQUIRED SLOPE FOR THE SANITARY PIPING AS PER THE LOCAL CODE.
- 2 CONNECT NEW 4" GREASE WASTE PIPING TO EXISTING GREASE WASTE LINE IN SPACE. CONTRACTOR TO FIELD VERIFY SIZE, ROUTING AND INVERT. CONTRACTOR TO FIELD VERIFY THE LOCATION, CONDITION AND CAPACITY OF EXISTING GREASE INTERCEPTOR IS MORE OR EQUAL THAN 750 GALLONS AND PROVIDE NEW IF EXISTING IS NOT SUFFICIENT.
- 3 CONNECT NEW 3" VENT LINE CONNECT TO EXISTING VENT LINE IN SPACE. CONTRACTOR TO FIELD VERIFY EXISTING VENT LINE EXACT LOCATION AND SIZE. UPDATE IF REQUIRED.
- 4 REPLACE EXISTING PLUMBING FIXTURE WITH NEW MOP SINK (P02) WITH EXISTING WASTE, VENT PIPING WITH ASSOCIATED ACCESSORIES AND FITTINGS TO REMAIN. CONTRACTOR TO FIELD VERIFY EXISTING CONDITION AND SIZE OF PIPING, UPGRADE IF REQUIRED.
- 5 REROUTE DRAIN FROM EXISTING FLOOR SINK LOCATED BELOW 1-COMP SINK TO THE GREASE WASTE LINE IN SPACE. CONTRACTOR TO FIELD VERIFY EXACT LOCATION, SIZE AND INVERT PRIOR TO ROUGH-IN.
- 6 REPLACE EXISTING DUMP SINK WITH NEW DUMP SINK WITH EXISTING INDIRECT WASTE, VENT PIPING WITH ASSOCIATED ACCESSORIES AND FITTINGS TO REMAIN. CONTRACTOR TO FIELD VERIFY EXISTING CONDITION OF PIPING AND FIXTURE, REPLACE IF REQUIRED.
- 7 EXISTING HAND SINK WITH EXISTING SANITARY, VENT WITH ASSOCIATED ACCESSORIES AND FITTINGS TO REMAIN. CONTRACTOR TO FIELD VERIFY EXISTING CONDITION OF PIPING AND FIXTURE, REPLACE IF REQUIRED.
- 8 INDIRECT WASTE FROM DUMP SINK, ICE BIN (E09), 3-COMP SINK (P01) AND MOP SINK (P02) TO THE ADJACENT EXISTING FLOOR SINK WITH APPROVED AIR GAP.
- 9 ROUTE DRAIN LINE FROM WATER FILTER (E12) TO ADJACENT EXISTING FLOOR SINK WITH APPROVED AIR GAP.
- 10 EXISTING FLOOR DRAIN/FLOOR SINK WITH EXISTING SANITARY, VENT WITH ASSOCIATED ACCESSORIES AND FITTINGS TO REMAIN. CONTRACTOR TO FIELD VERIFY EXISTING CONDITION OF PIPING AND FIXTURE, REPLACE IF REQUIRED.
- 11 INDIRECT DRAIN FROM ICE MACHINE (E10), SINGLE COFFEE BREWER (E07), LINEA PB W (E01) AND PITCHER RINSE (E24) TO ADJACENT EXISTING FLOOR SINK WITH APPROVED AIR GAP.

- 1 PROVIDE REQUIRED SLOPE FOR THE SANITARY PIPING AS PER THE LOCAL CODE.
- 2 CONNECT NEW 4" GREASE WASTE PIPING TO EXISTING GREASE WASTE LINE IN SPACE. CONTRACTOR TO FIELD VERIFY SIZE, ROUTING AND INVERT. CONTRACTOR TO FIELD VERIFY THE LOCATION, CONDITION AND CAPACITY OF EXISTING GREASE INTERCEPTOR IS MORE OR EQUAL THAN 750 GALLONS AND PROVIDE NEW IF EXISTING IS NOT SUFFICIENT.
- 3 CONNECT NEW 3" VENT LINE CONNECT TO EXISTING VENT LINE IN SPACE. CONTRACTOR TO FIELD VERIFY EXISTING VENT LINE EXACT LOCATION AND SIZE. UPDATE IF REQUIRED.
- 4 REPLACE EXISTING PLUMBING FIXTURE WITH NEW MOP SINK (P02) WITH EXISTING WASTE, VENT PIPING WITH ASSOCIATED ACCESSORIES AND FITTINGS TO REMAIN. CONTRACTOR TO FIELD VERIFY EXISTING CONDITION AND SIZE OF PIPING, UPGRADE IF REQUIRED.
- 5 REROUTE DRAIN FROM EXISTING FLOOR SINK LOCATED BELOW 1-COMP SINK TO THE GREASE WASTE LINE IN SPACE. CONTRACTOR TO FIELD VERIFY EXACT LOCATION, SIZE AND INVERT PRIOR TO ROUGH-IN.
- 6 REPLACE EXISTING DUMP SINK WITH NEW DUMP SINK WITH EXISTING INDIRECT WASTE, VENT PIPING WITH ASSOCIATED ACCESSORIES AND FITTINGS TO REMAIN. CONTRACTOR TO FIELD VERIFY EXISTING CONDITION OF PIPING AND FIXTURE, REPLACE IF REQUIRED.
- 7 EXISTING HAND SINK WITH EXISTING SANITARY VENT WITH ASSOCIATED ACCESSORIES AND FITTINGS TO REMAIN. CONTRACTOR TO FIELD VERIFY EXISTING CONDITION OF PIPING AND FIXTURE, REPLACE IF REQUIRED.
- 8 INDIRECT WASTE FROM DUMP SINK, ICE BIN (E09), 3-COMP SINK (P01) AND MOP SINK (P02) TO THE ADJACENT EXISTING FLOOR SINK WITH APPROVED AIR GAP.
- 9 ROUTE DRAIN LINE FROM WATER FILTER (E12) TO ADJACENT EXISTING FLOOR SINK WITH APPROVED AIR GAP.
- 10 EXISTING FLOOR DRAIN/FLOOR SINK WITH EXISTING SANITARY, VENT WITH ASSOCIATED ACCESSORIES AND FITTINGS TO REMAIN. CONTRACTOR TO FIELD VERIFY EXISTING CONDITION OF PIPING AND FIXTURE, REPLACE IF REQUIRED.
- 11 INDIRECT DRAIN FROM ICE MACHINE (E10), SINGLE COFFEE BREWER (E07), LINEA PB W (E01) AND PITCHER RINSE (E24) TO ADJACENT EXISTING FLOOR SINK WITH APPROVED AIR GAP.

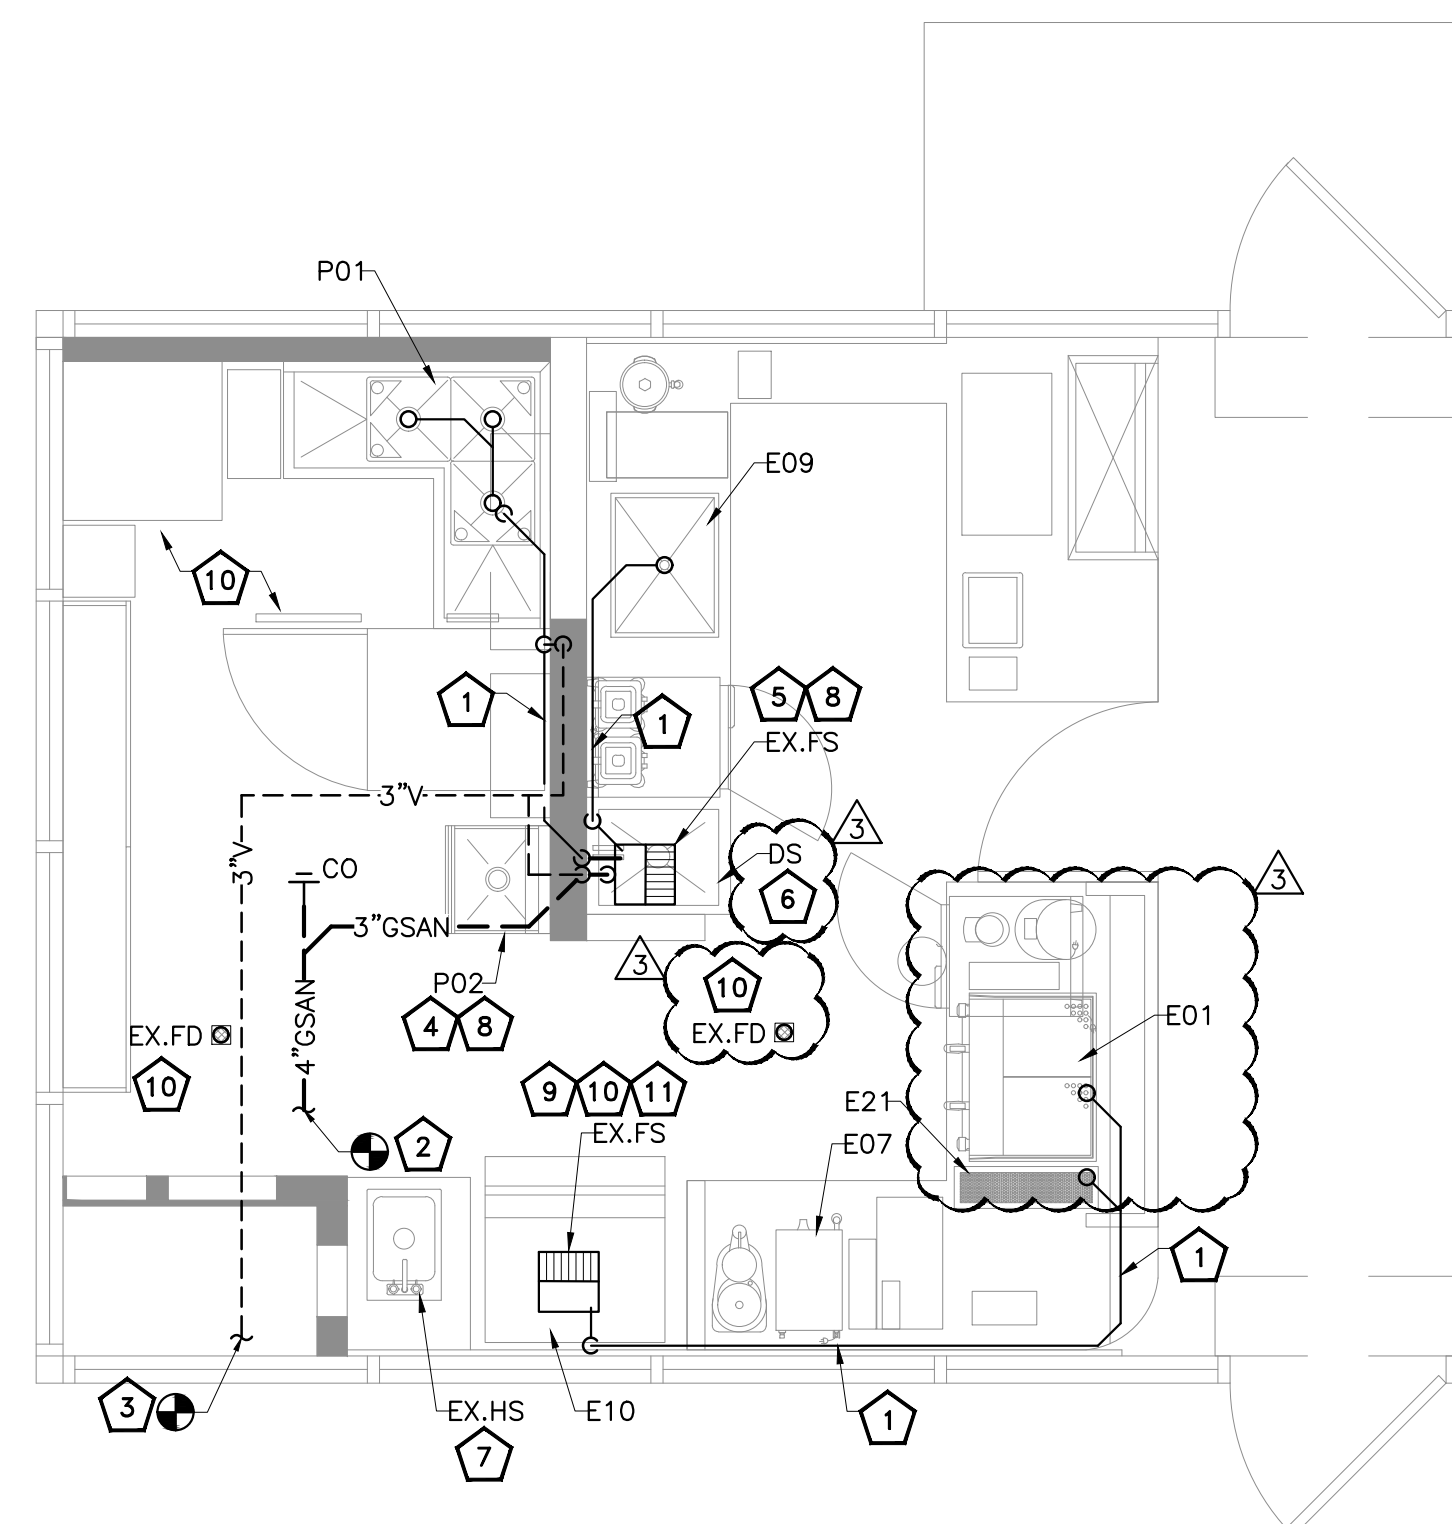

SCALE	2
3/8"=1'-0"	

SCALE
3/8"=1'-0"





2

Chamberlain
Coffee

09.10.24

[illegible]



P100

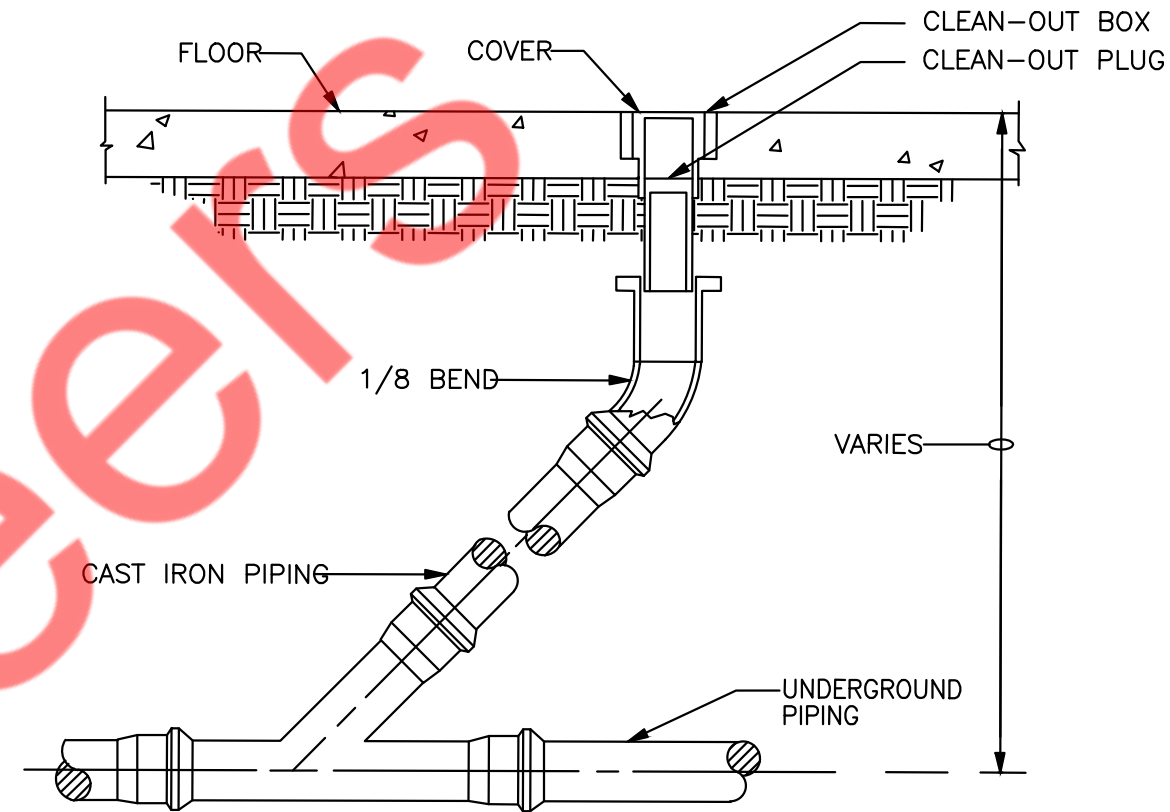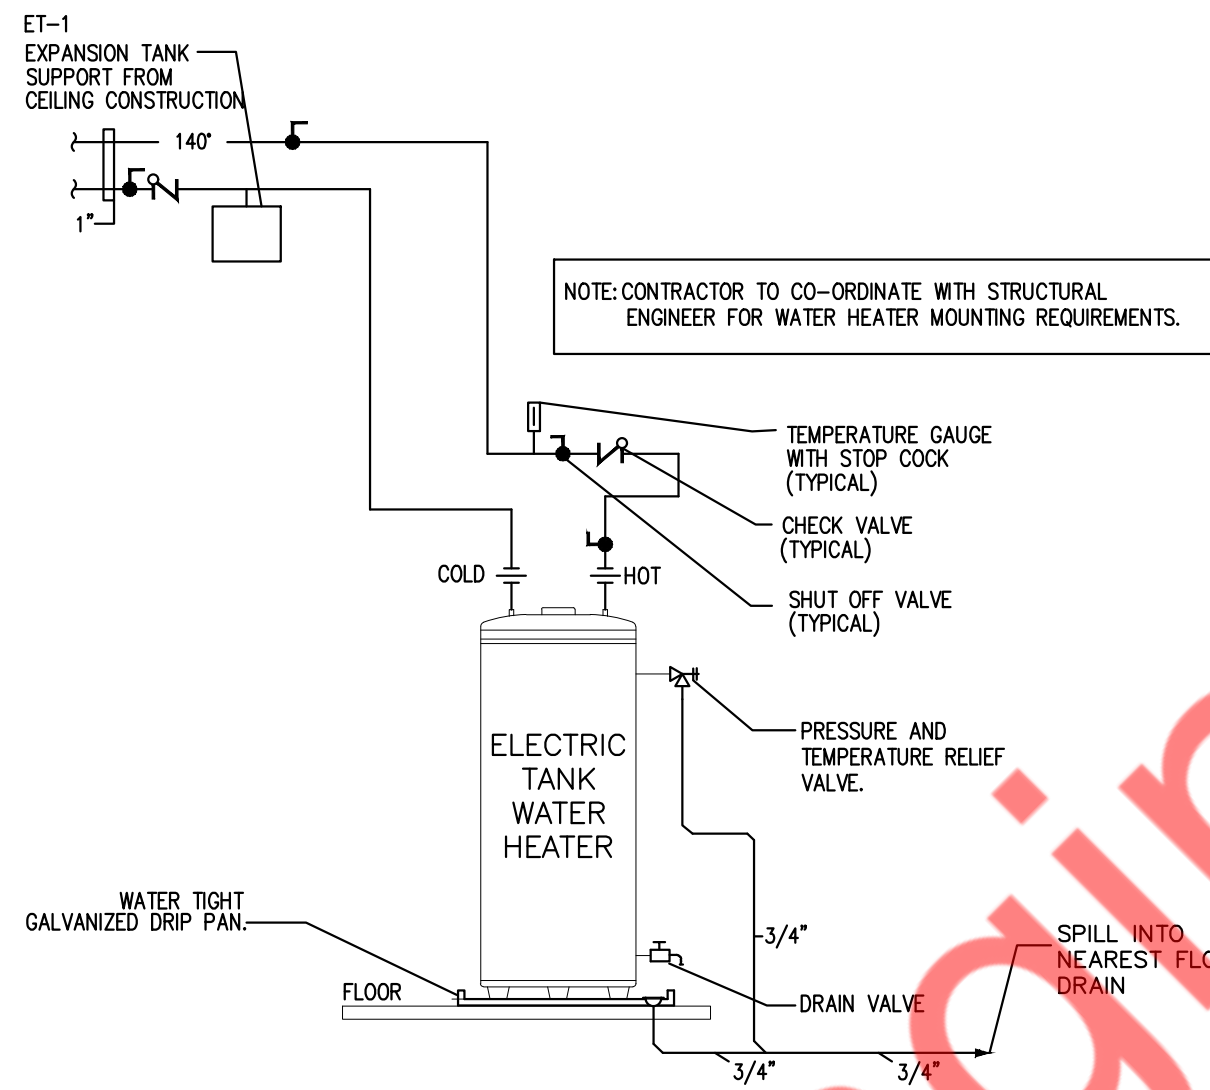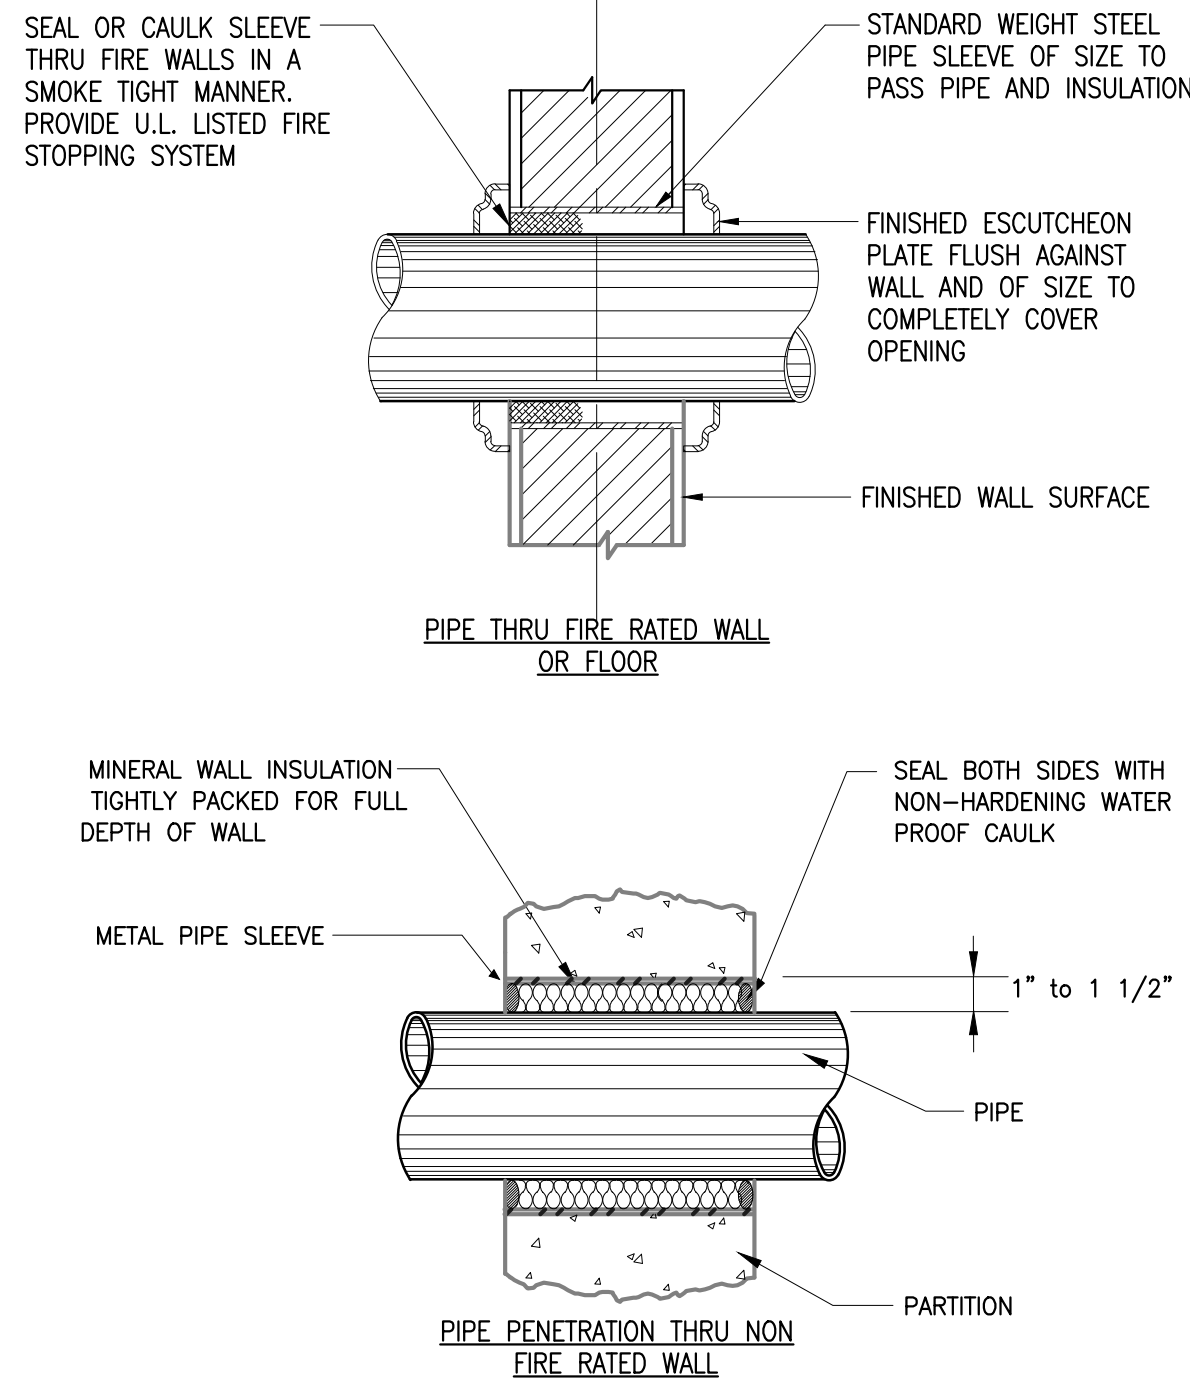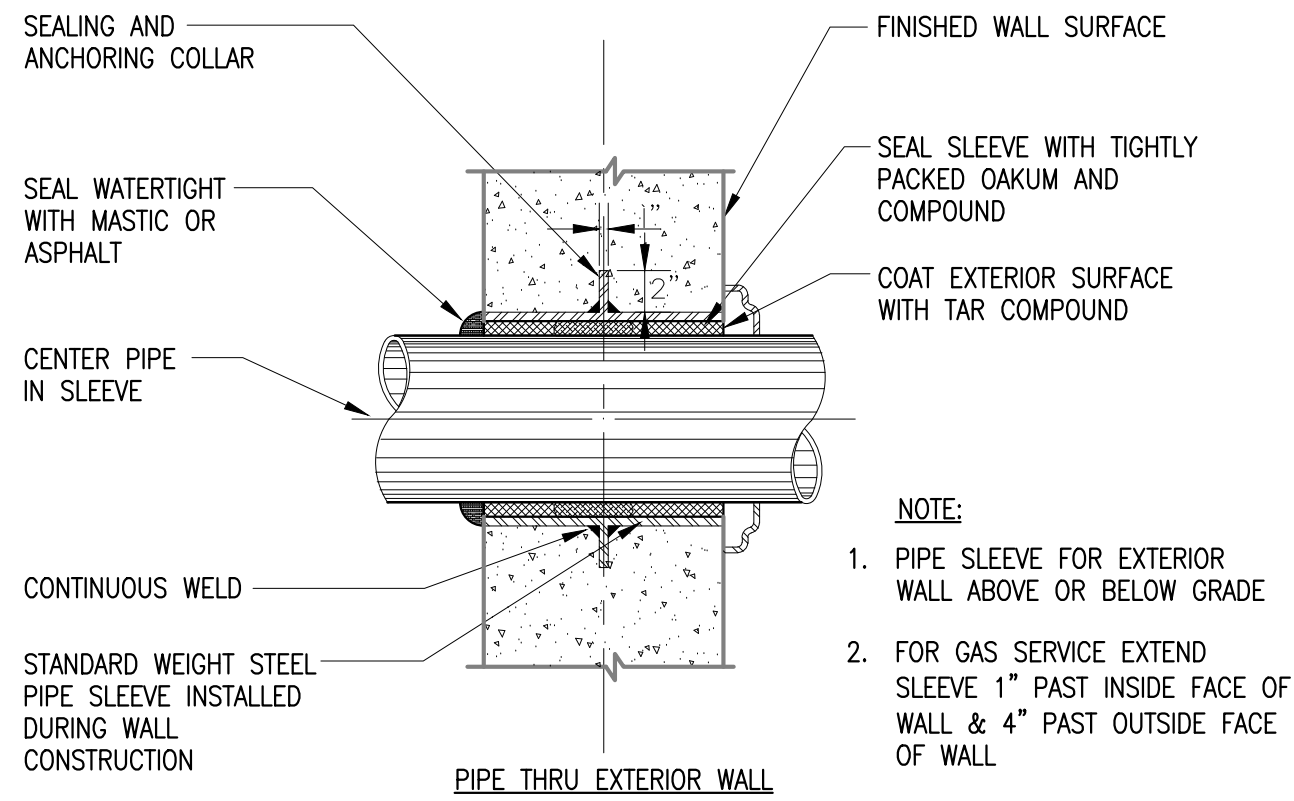


1 PIPE SLEEVE THRU WALL SECTION
P200 N.T.S

2 ELECTRIC WATER HEATER DETAILS
P200 N.T.S

3 FLOOR CLEANOUT DETAIL
P200 N.T.S

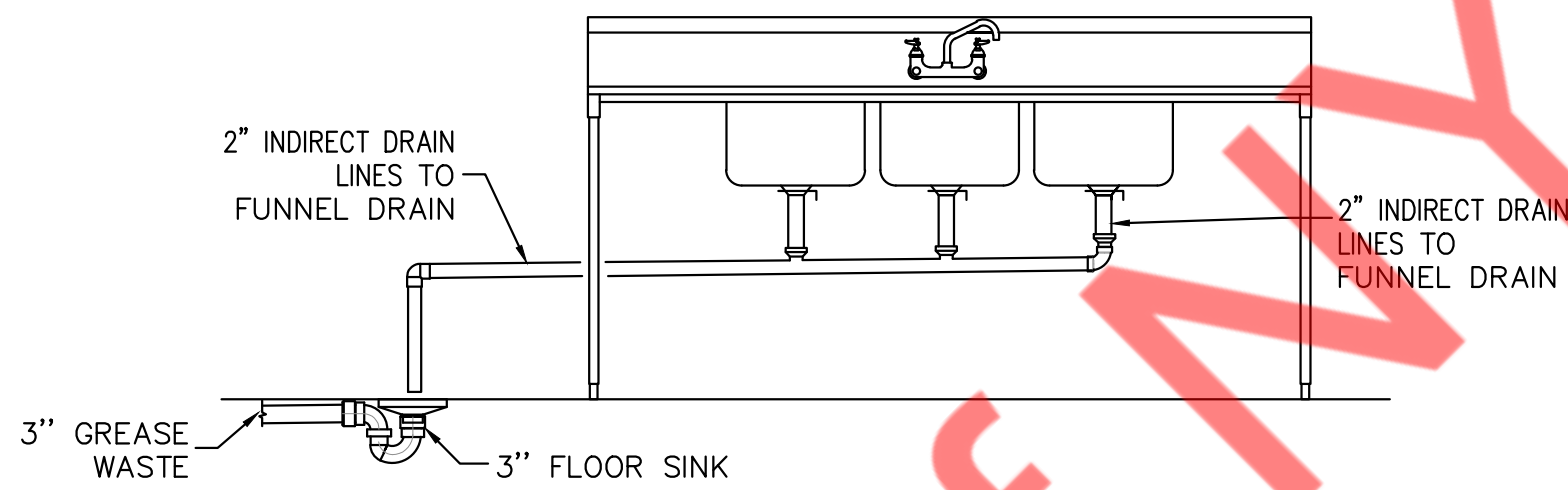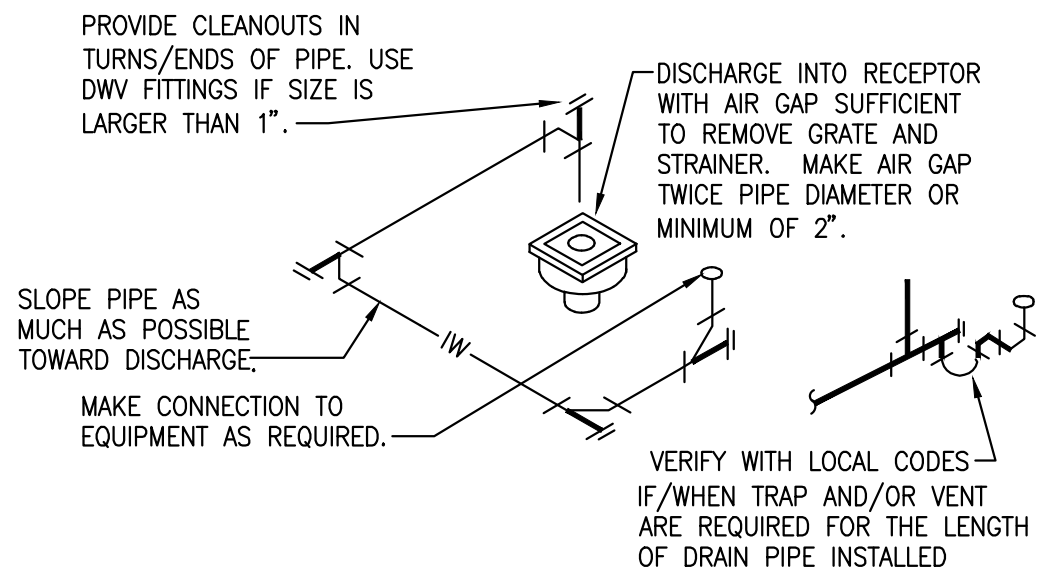


6 3-COMP. SINK/GREASE TRAP DETAIL
P200 N.T.S

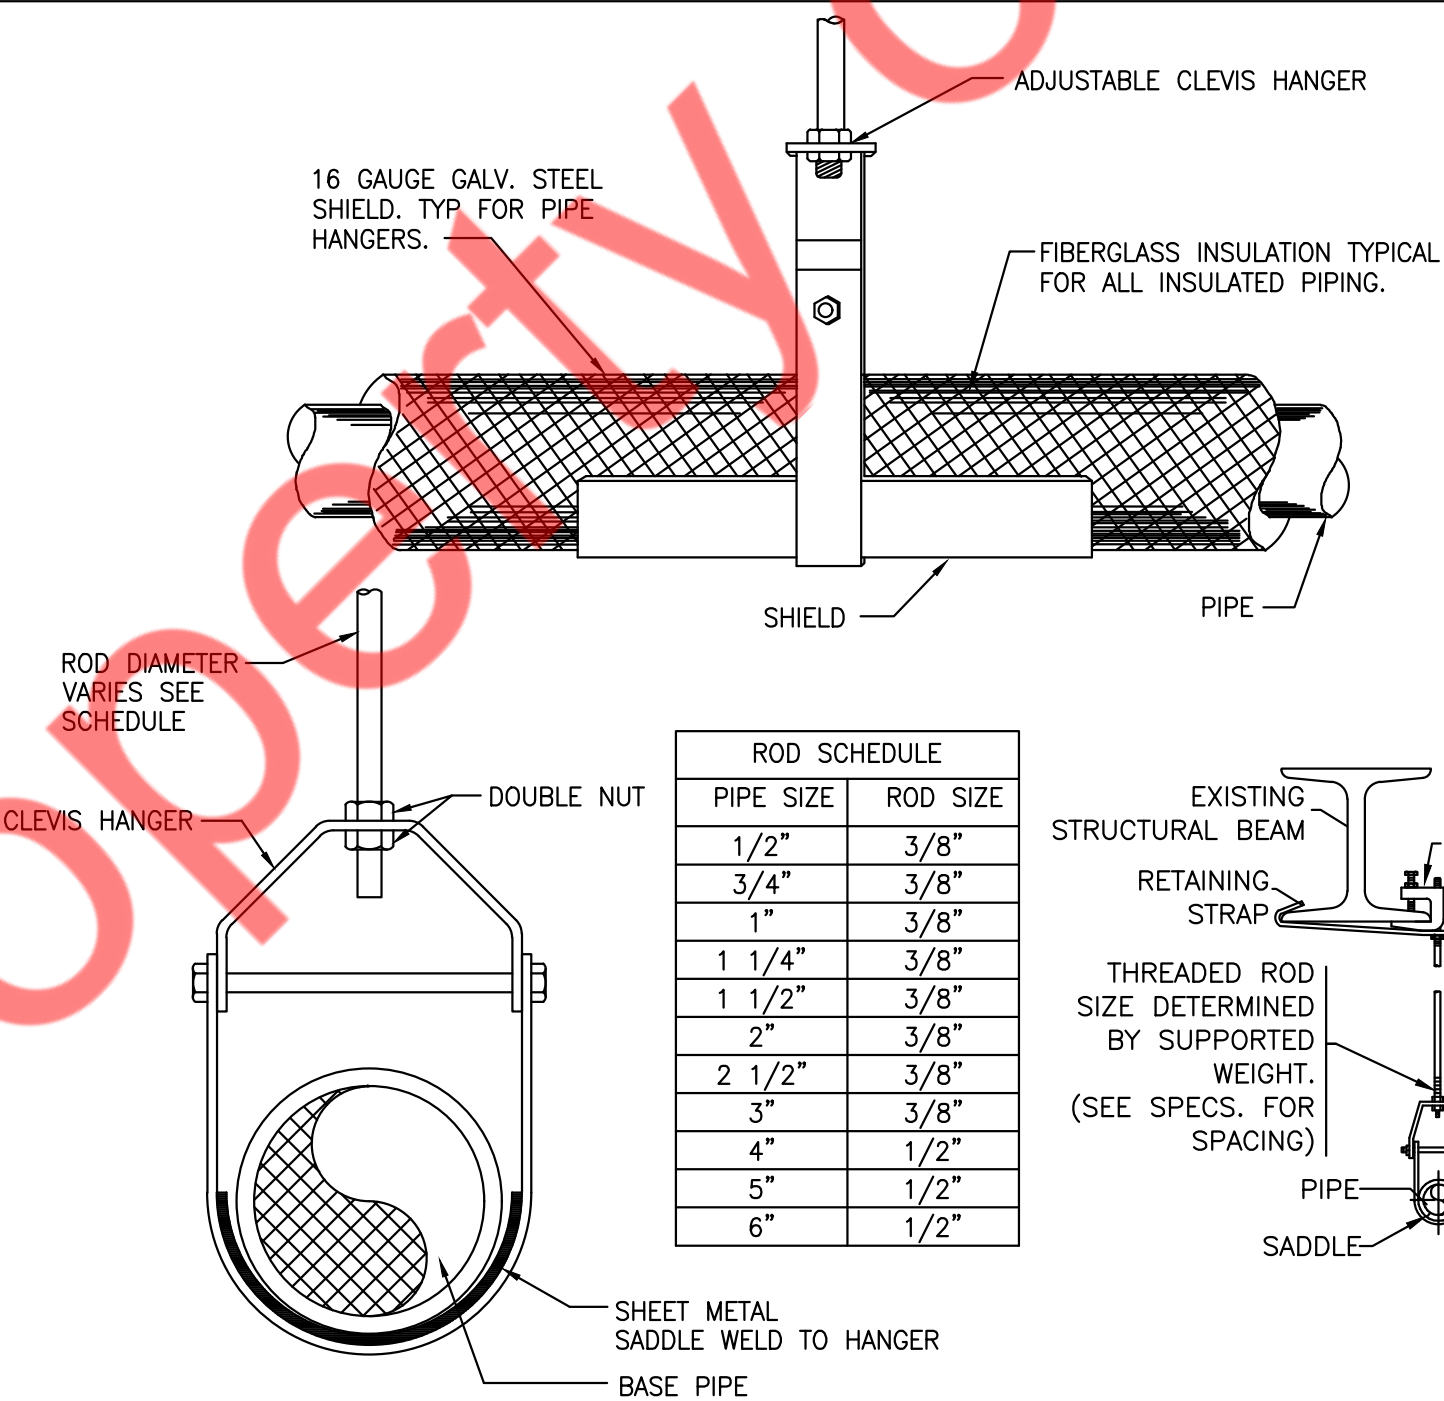


7 HANGER DETAIL
P200 N.T.S

8 NOT USED
P200 N.T.S

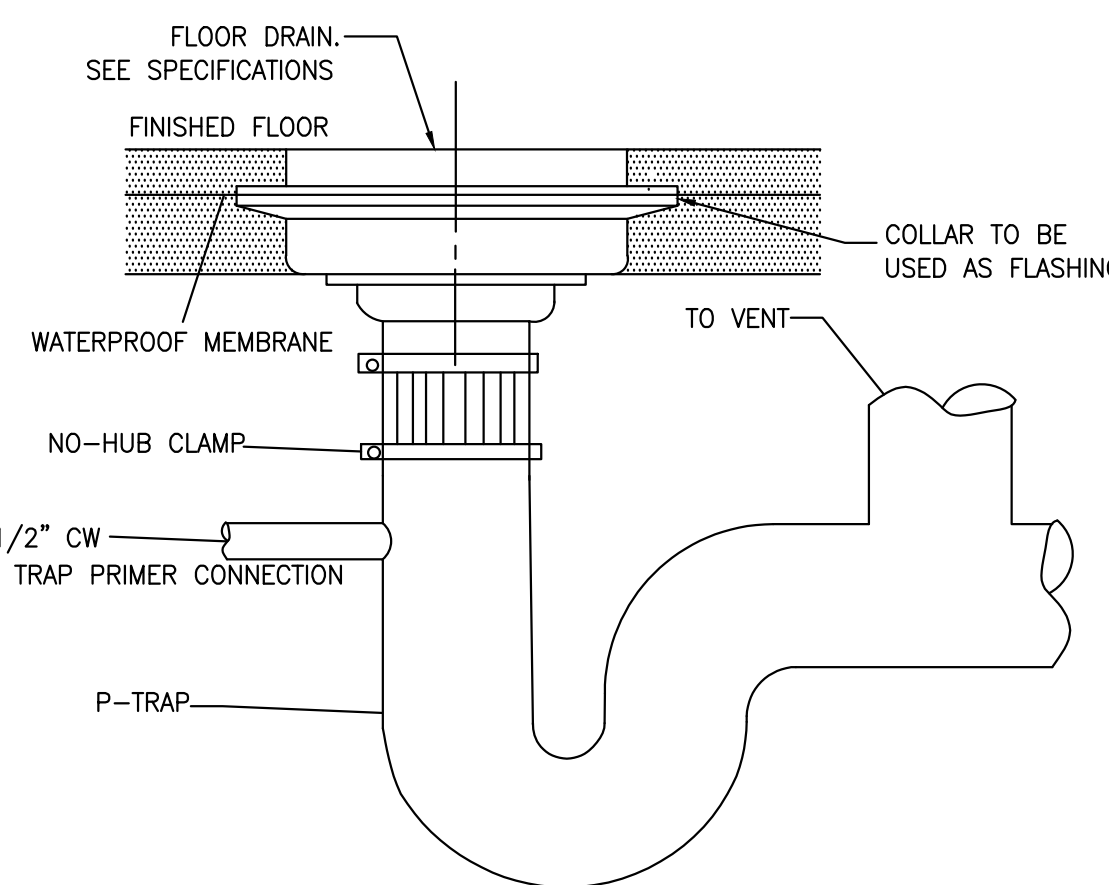

9 FLOOR DRAIN DETAIL
P200 N.T.S

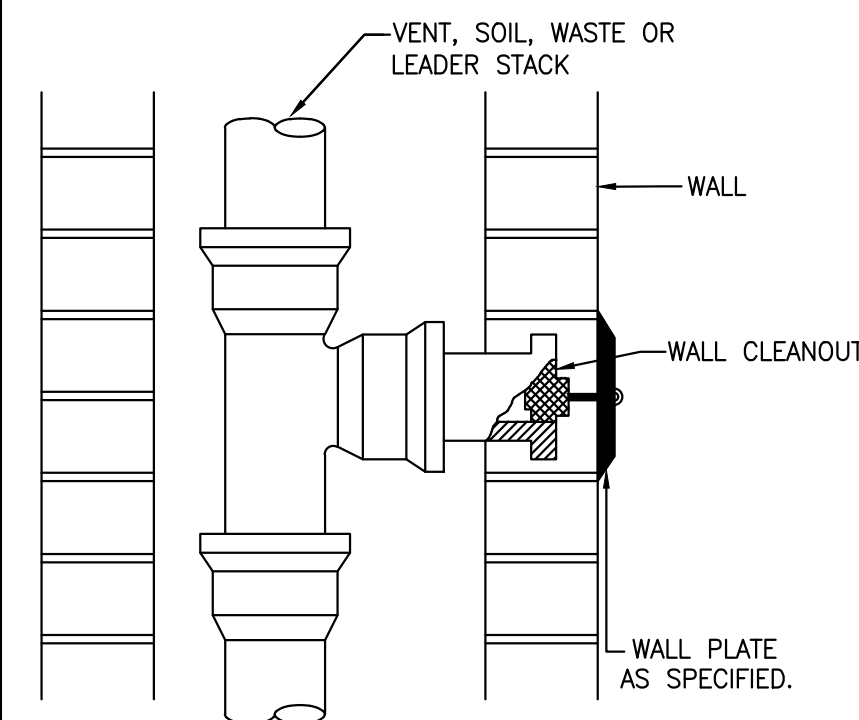

10 WALL CLEANOUT DETAIL
P200 N.T.S

Project Owner:
Chamberlain Coffee


Issue For Description:

Issue Date:
09.10.24

Revisions:		
NO.	DESCRIPTION	DATE
1	ELECTRICAL COMMENTS	10.01.24
2	CITY COMMENTS	10.02.24
3	HEALTH DEPARTMENT COMMENTS	10.21.24

Sheet Title:
PLUMBING DETAILS

Sheet Number:
P200

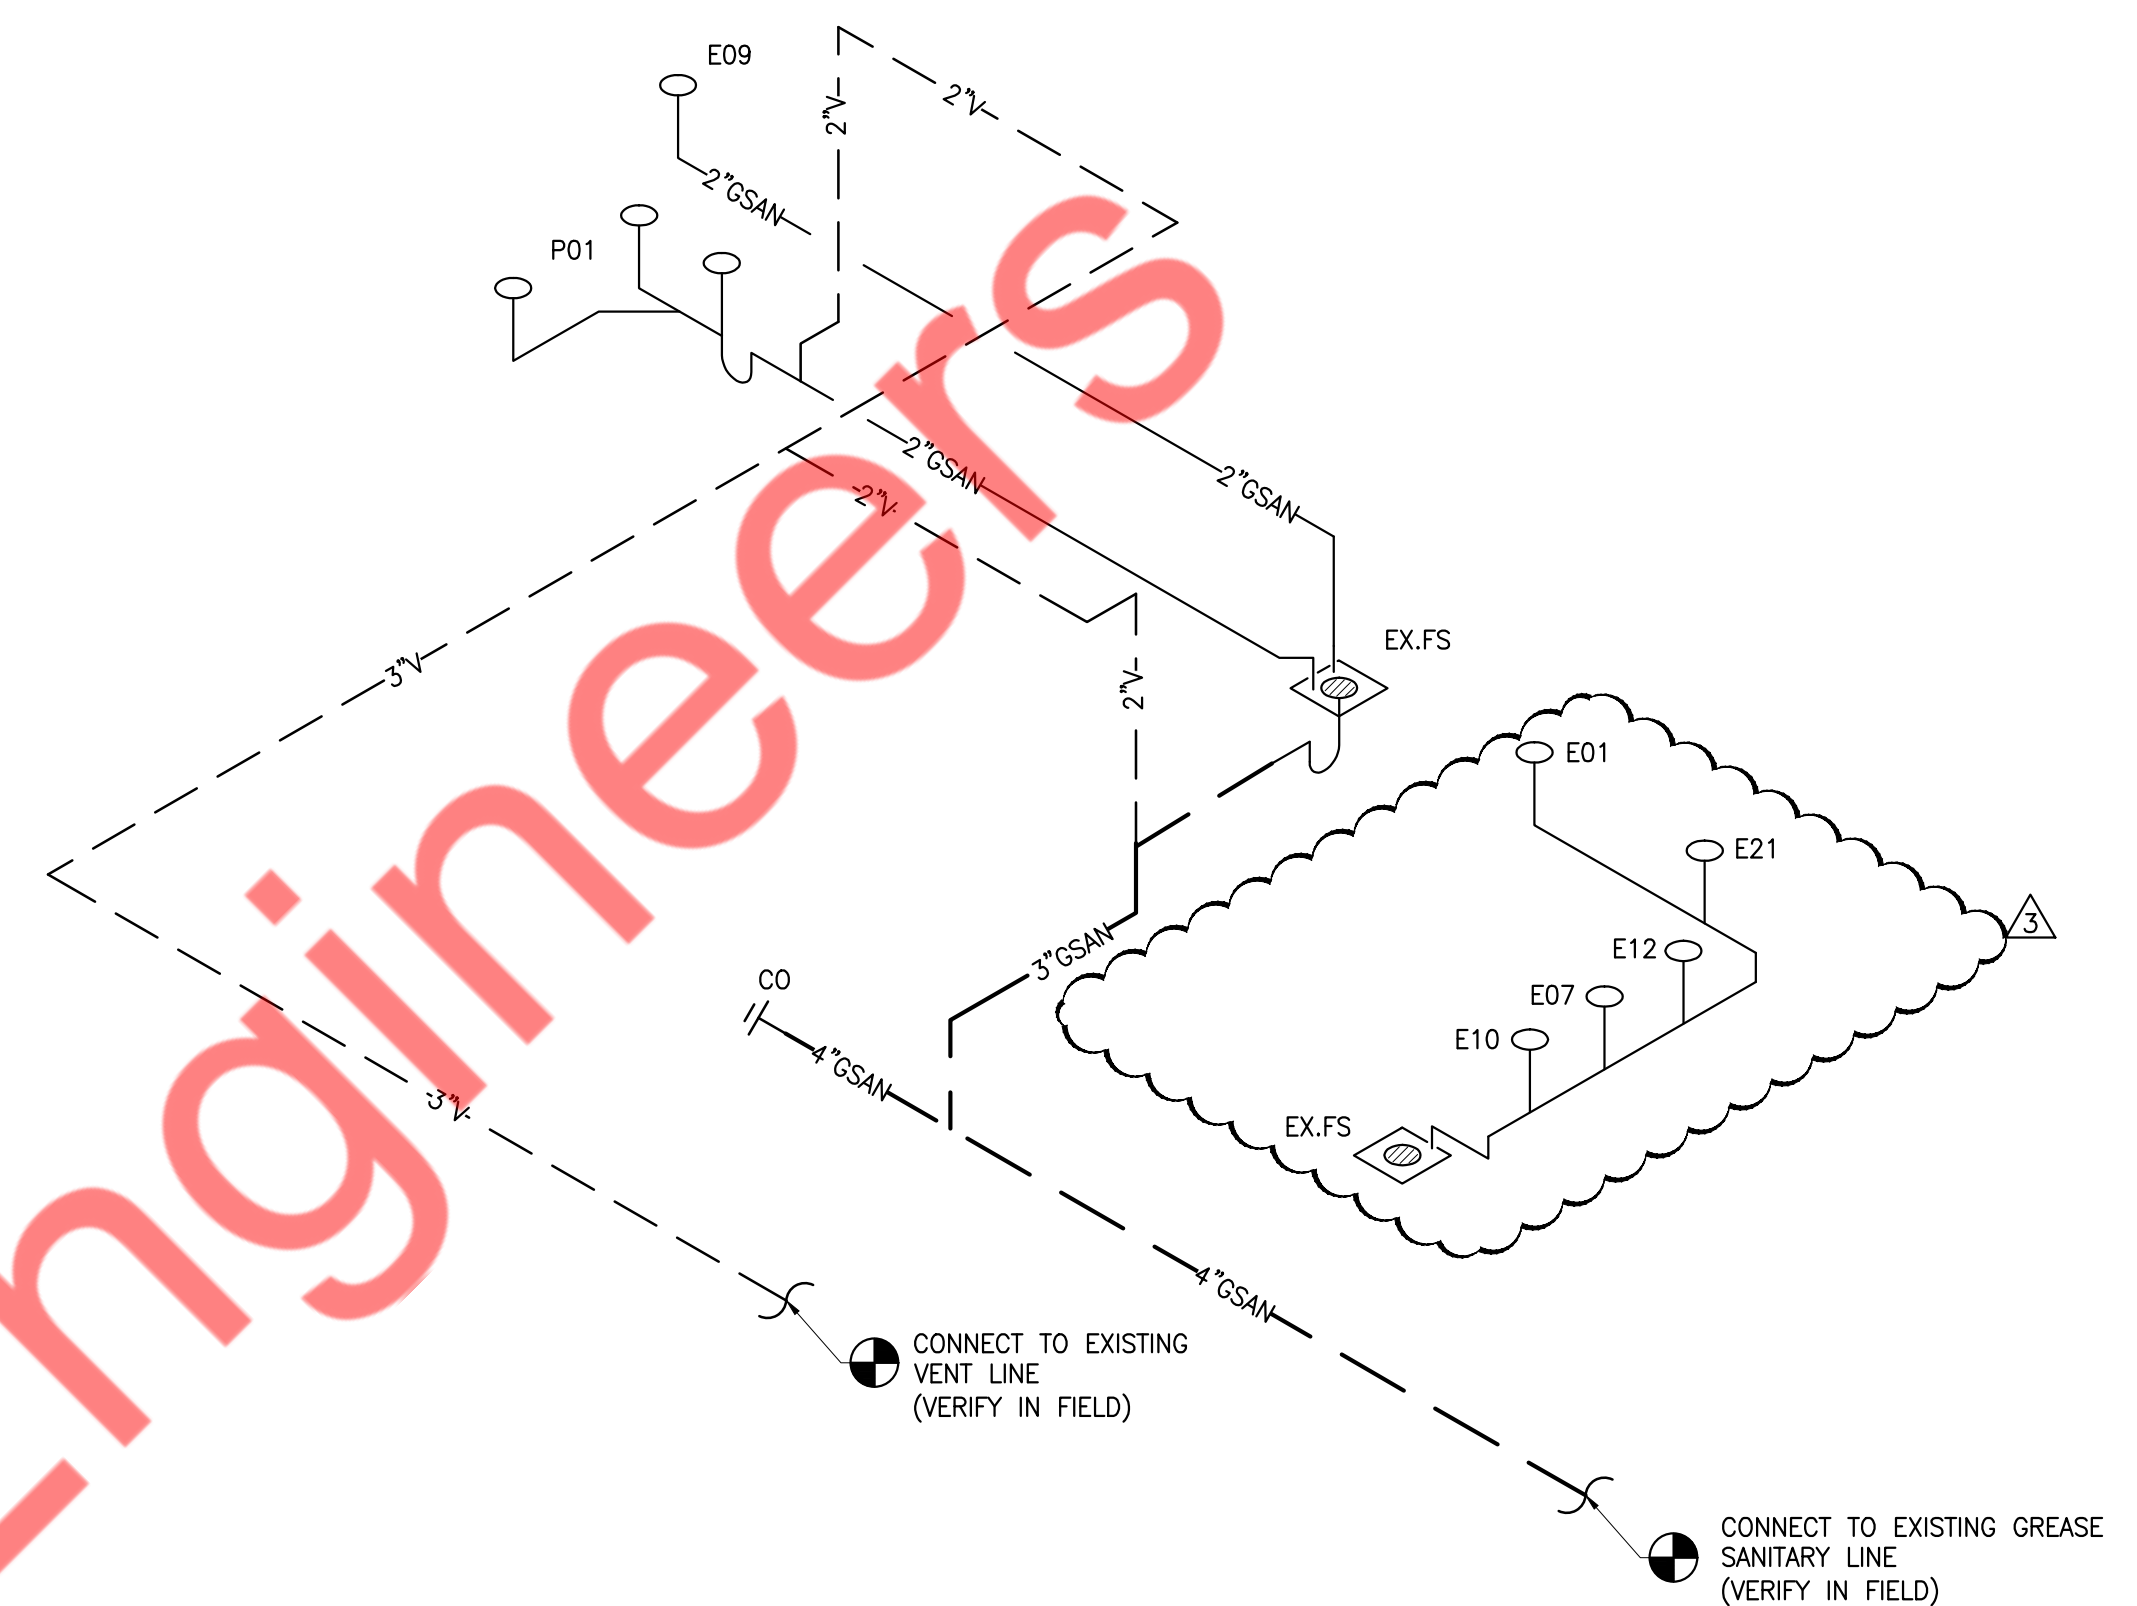

2
P300

SANITARY WASTE AND VENT RISER DIAGRAM
NOT TO SCALE

FIXTURE UNIT CALCULATION				
TAG	EQUIPMENT	QTY	WSFU	TOTAL
P01	3-COMP SINK	1	3	3
P02	MOP SINK	1	3	3
E01	LINEA PB W SCALE BUILT IN	1	0.5	0.5
E07	SINGLE COFFEE BREWER	1	0.5	0.5
E11	ICE MACHINE	1	0.5	0.5
EX.HS	HAND SINK	1	1	1
DS	DUMP SINK	1	3	3
TOTAL WATER SUPPLY FIXTURE UNIT				11 = 15GPM
WSFU VALUES AS PER CALIFORNIA PLUMBING CODE 2022 CHART A 103.1(2)				
PER CALIFORNIA PLUMBING CODE 2022, CHART A 105(1) FOR 15 GPM CALCULATED PIPE SIZE IS 1"				

NOTE:

1. CONTRACTOR TO COORDINATE WITH ARCHITECTURAL DRAWINGS FOR ALL PLUMBING FIXTURES SPECIFICATION.

EXPANSION TANKS SCHEDULE									
UNIT	NUMBER	MANUFACTURER & MODEL NUMBER	TANK VOLUME (GAL)	ACCEPTANCE VOLUME (GAL)	PRESSURE RATING (PSI)	DIMENSIONS		SHIPPING WEIGHT (LBS)	NOTES
						DIAMETER (INCH)	HEIGHT (INCH)		
ET-1	1	AMTROL ST-5C-DD	2.0	0.9	150	8	14	10	1.2

GENERAL NOTES:

1. SET THE TANK PRESSURE TO EQUAL THE SYSTEM OPERATING PRESSURE. TANK MUST BE DRAINED BEFORE ADJUSTING SET PRESSURE.
2. INSTALL PER MANUFACTURER'S RECOMMENDATIONS ON INCOMING COLD WATER LINE.

GREASE INTERCEPTOR SIZING				
FIXTURE	PIPE SIZE	DFU	QUANTITY	TOTAL DFU*
3 COMP SINK - P01 (I.D TO EX.FS)	2"	—	—	—
MOP SINK - P02	3"	3	1	3
DUMP SINK - DS (I.D TO EX.FS)	2"	—	—	—
EXISTING FLOOR SINK (EX.FS)	3"	6	1	6
TOTAL DRAINAGE FIXTURE (DFU) CONNECTED TO GREASE INTERCEPTOR				9
TOTAL MINIMUM REQUIRED GREASE INTERCEPTOR CAPACITY (GALLONS) UPC 2022 SECTION 1014.3.6				750
AVAILABLE EXISTING GREASE INTERCEPTOR CAPACITY ON SITE - 5000 GALLONS				