	MECHANICAL S'	YMBO	DLS LIS	T
AC-1 (TXF-1)	EQUIPMENT SYMBOL		MECHAN	IC <i>F</i>
XX	RISER SYMBOL		AC	A
X	THEER STANDE		AL	A
	AIR DEVICES		GD	(
	7 (III DE VICES		BOD	E
	CEILING DIFFUSER SUPPLY		BOE	E
	CEILING DIFFUSER RETURN		CFM	
			COP CP	
	CEILING DIFFUSER EXHAUST		CD	
D	UCT ACCESSORIES		DN	
[60]			EER	E
GD <del></del>	DACKED AFT DAMPED		EG	E
	BACKDRAFT DAMPER		FC	F
Τ^τ τ•			FD/AD	F
	VOLUME DAMPER W/ ACCESS DOOR		FD	F
			FSD	F
	HVAC PIPING		HSPF	F
——— CP ———	NEW CONDENSATE PIPING		IEER	
CON	TROLS AND SENSORS		RG	F
T	THERMOSTAT		SEER	5
T <sub>s</sub>	TEMPERATURE SENSOR		92211	E
S	DUCT MOUNTED SMOKE DETECTOR		SG	S
	DUCTWORK		VD W.M.S.	\ \ \
	BOCIVORK		FCU	V F
==	AIR DUCT W/ 1.5" ACOUSTICAL LINING		CU	C
<b>-</b> ~~-	FLEXIBLE DUCT		OAF	
FC FC	FLEXIBLE CONNECTION		ACCU	ļ
24X12	RECTANGULAR DUCT (WIDTH X DEPTH)			•
ø12	ROUND DUCT (DIAMETER)		BUILDIN	١G
\$	ROUND DUCT CROSS SECTION		ALL WORK AND I	
	SUPPLY AIR RECTANGULAR DUCT CROSS SECTION		AS ADOPTED A AUTHORITY. NOTH CONSTRUCTED TO THESE CODES OR	ND IING PEF
	RETURN AIR RECTANGULAR DUCT CROSS SECTION		PROJECT:  a. NEW JERSEY I	
CFM NECK	CFM/AIRFLOW TAG		b. NEW JERSEY	

MECHAIN	ICAL ABBREVIATION
AC	AIR CONDITIONING UNIT
AL	ACOUSTIC LINING
GD	GRAVITY DAMPER
BOD	BOTTOM OF DUCT
BOE	BOTTOM OF EQUIPMENT
CFM	CUBIC FEET OF AIR PER MINU
COP	COEFFICIENT OF PERFORMAN
СР	CONDENSATE PUMP
CD	CONDENSATE DRAIN PIPE
DN	DOWN
EER	ENERGY EFFICIENCY RATIO
EG	EXHAUST GRILLE
FC	FLEXIBLE CONNECTION
FD/AD	FIRE DAMPER W/ACCESS DOC
FD	FIRE DAMPER W/FUSIBLE LINK
FSD	FIRE SMOKE DAMPER
Hene	HEATING SEASONAL
HSPF	PERFORMANCE FACTOR
IEED	INTEGRATED ENERGY
IEER	EFFICIENCY RATIO
RG	RETURN GRILLE
OFFR	SEASONAL ENERGY
SEER	EFFICIENCY RATIO
SG	SUPPLY GRILLE
VD	VOLUME DAMPER
W.M.S.	WIRE MESH SCREEN
FCU	FAN COIL UNIT
CU	CONDENSING UNIT
OAF	OUTSIDE AIR INTAKE FAN
ACCU	AIR COOLED CONDENSER UNI

### BUILDING CODE COMPLIANCE

ALL WORK AND MATERIAL SHALL BE PERFORMED AND INSTALLED IN COMPLIANCE WITH THE FOLLOWING CODES AS ADOPTED AND AMENDED BY THE INSPECTING AUTHORITY, NOTHING IN THESE DRAWINGS IS TO BE CONSTRUCTED TO PERMIT WORK NOT CONFORMING TO THESE CODES OR OTHERS APPLICABLE TO THESE PROJECT:

- a. NEW JERSEY BUILDING CODE 2021.
- b. NEW JERSEY MECHANICAL CODE 2021.
- c. ENERGY CODE ASHRAE 90.1 (2019)
- d. NEW JERSEY FIRE CODE 2021.
- e. NEW JERSEY PLUMBING CODE 2021.
- . NEW JERSEY FUEL GAS CODE 2021.

	MECHANICAL DRAWING LIST
DWG. NO.	DRAWING NAME
M001	MECHANICAL SYMBOLS LIST, ABBREVIATIONS & GENERAL NOTES
M002	MECHANICAL NOTES & SPECIFICATIONS
M101	MECHANICAL FLOOR PLAN
M102	MECHANICAL ROOF PLAN
M201	MECHANICAL SCHEDULES (01 OF 02)
M202	MECHANICAL SCHEDULES (02 OF 02)
M401	MECHANICAL DETAILS (01 OF 02)
M402	MECHANICAL DETAILS (02 OF 02)

#### FAIRLAWN, NJ BUILDING DEPARTMENT NOTES

ALL WORK SHALL COMPLY WITH APPLICABLE SECTIONS OF THE 2021 NEW

JERSEY BUILDING CODE AND ALL AMENDMENTS AND RULES AND REGULATIONS OF THE DEPARTMENT OF BUILDINGS TO DATE.

- 1. THE CONTRACTOR SHALL ENGAGE THE THE SERVICES OF A PROFESSIONAL ENGINEER TO PROVIDE THE REQUIRED SPECIAL INSPECTIONS AND TESTS.
- 2. TESTS WILL BE CONDUCTED UNDER DIRECTION OF A LICENSED PROFESSIONAL ENGINEER, ARCHITECT OR OTHER PERSON HAVING NOT LESS THAN FIVE (5) YEARS EXPERIENCE SUPERVISING THE INSTALLATION OF SUCH MECHANICAL SYSTEMS.
- 3. THE LICENSED PROFESSIONAL ENGINEER, ARCHITECT OR OTHER PERSON HAVING NOT LESS THAN FIVE (5) YEARS EXPERIENCE SUPERVISING THE INSTALLATION OF SUCH MECHANICAL SYSTEMS AND CONDUCTING SUCH TESTS WILL FILE DOCUMENTATION AND REPORTS OF TESTS THAT THE SYSTEM COMPLIES WITH THE CONSTRUCTION DOCUMENTS AND APPLICABLE LAWS.
- 4. TESTS OF MECHANICAL SYSTEMS SHALL BE PERFORMED IN ACCORDANCE WITH 2021 INTERNATIONAL MECHANICAL CODE: A. VENTILATION SYSTEM BALANCING 2021 IMC 401.
- 7. THE FOLLOWING WORK ITEMS, COMPONENTS, MATERIALS, CAPACITIES, ETC. SHALL COMPLY WITH THE 2021 INTERNATIONAL MECHANICAL
- A. STANDARDS OF HEATING
- B. DUCT CONSTRUCTION AND INSTALLATION- 2021 IMC 603 AIR INTAKES, EXHAUSTS AND RELIEF- 2021 IMC 401.5, 401.5, 501.3.1 D. SMOKE DETECTORS AND FIRE AND SMOKE DAMPERS - 2021 IMC
- 606 & 607 RESPECTIVELY E. MANUAL AND AUTOMATIC FIRE AND SMOKE CONTROLS FOR AIR
- DISTRIBUTION SYSTEMS 2021 IMC 513 F. AIR FILTERS - 2021 IMC 605
- 8. A STATEMENT SHALL BE FILED BY THE OWNER OR TENANT IN POSSESSION THAT THE VENTILATION SYSTEM WILL BE KEPT IN CONTINUOUS OPERATION AT ALL TIMES DURING THE NORMAL OCCUPANCY OF THE STRUCTURE AS REQUIRED BY 2021 IMC 403.3
- 9. ALL FIRE DAMPERS SHALL BE ACCEPTED FOR USE BY THE NEW JERSEY BUILDING DEPARTMENTS. FIRE DAMPERS SHALL BE MANUFACTURED AND INSTALLED IN ACCORDANCE WITH UL 555, STANDARDS FOR FIRE DAMPERS AND CEILING DAMPERS.
- 10. COMBINATION FIRE/SMOKE DAMPERS AND SMOKE DAMPERS SHALL BE ACCEPTED FOR USE BY NEW JERSEY BUILDING DEPARTMENTS AND SHALL BE MANUFACTURED AND INSTALLED IN ACCORDANCE WITH UL
- 11. SMOKE DETECTION SYSTEMS SHALL BE INSTALLED AND SEQUENCED TO FOLLOW CONTROLS OPERATIONS WITH THE REQUIREMENTS OF SECTION 2021 IMC 606 TO CLOSE DAMPERS AND AUTOMATICALLY STOP
- DAMPERS AND CEILING DAMPERS LOCATED WITHIN THE AIR DISTRIBUTION AND SMOKE CONTROL SYSTEMS SHALL BE INSTALLED IN ACCORDANCE WITH THE REQUIREMENTS OF SECTION 2021 IMC 607.

12. FIRE DAMPERS, SMOKE DAMPERS, COMBINATION FIRE/SMOKE

- 13. REFER TO ARCHITECTURAL DRAWINGS FOR REQUIRED FIRE-RATED WALL AND SMOKE WALL CONSTRUCTION AND LOCATION.
- 14. THESE PLANS ARE APPROVED ONLY FOR THE WORK INDICATED ON THE APPLICATION SPECIFICATION SHEET, ALL OTHER MATTERS SHOWN ARE NOT TO BE RELIED UPON OR TO BE CONSIDERED AS EITHER BEING APPROVED OR IN ACCORDANCE WITH APPLICABLE CODES.
- 15. SMOKE DETECTOR SHALL MEET UL268A
- 16. ALL HEATING AND COOLING LOADS CALCULATED PER ASHRAE/ACCA

#### NOTE TO CONTRACTOR

- 1. THE WORK UNDER CONTRACT INCLUDES ALL LABOR, MATERIALS AND APPLIANCES NECESSARY FOR THE FURNISHING. INSTALLING AND TESTING. COMPLETE AND READY FOR SAFE OPERATION OF THE SYSTEMS AS DESCRIBED IN THE SPECIFICATIONS, FLOOR PLAN(S) DESIGN, DETAIL DRAWINGS, NOTES, RFI'S, ETC. FOR THIS PROJECT. WORK SHALL BE INSTALLED IN A NEAT, WORKMANLIKE MANNER.
- 2. THE CONTRACTOR SHALL GIVE NECESSARY NOTICE, FILE DRAWINGS AND SPECIFICATIONS WITH THE DEPARTMENT HAVING JURISDICTION, OBTAIN PERMITS OR LICENSES NECESSARY TO CARRY OUT THIS WORK AND PAY ALL FEES THEREFORE. THE CONTRACTOR SHALL ARRANGE FOR INSPECTION AND TESTS OF ANY OR ALL PARTS OF THE WORK IF SO REQUIRED BY AUTHORITIES AND PAY ALL CHARGES FOR SAME. THE CONTRACTOR SHALL PAY ALL COSTS FOR, AND FURNISH TO THE OWNER BEFORE FINAL BILLING, ALL CERTIFICATES NECESSARY AS EVIDENCE THAT THE WORK INSTALLED CONFORMS WITH ALL REGULATIONS WHERE THEY APPLY TO THIS WORK.
- 3. THE CONTRACTOR SHALL FURNISH A WRITTEN GUARANTEE TO REPLACE OR REPAIR PROMPTLY AND ASSUME RESPONSIBILITY FOR ALL EXPENSES INCURRED FOR ANY WORKMANSHIP AND EQUIPMENT IN WHICH DEFECTS DEVELOP WITHIN ONE YEAR FROM THE DATE OF FINAL CERTIFICATE FOR PAYMENT AND/OR FROM DATE OR ACTUAL USE OF EQUIPMENT OR OCCUPANCY OF SPACES, BY OWNER, INCLUDED UNDER THE VARIOUS PARTS OF THE WORK, WHICHEVER DATE IS EARLIER. THIS WORK SHALL BE DONE AS DIRECTED BY THE OWNER. THIS GUARANTEE SHALL ALSO PROVIDE THAT WHERE DEFECTS OCCUR, THE CONTRACTOR WILL ASSUME RESPONSIBILITY FOR ALL EXPENSES INCURRED IN REPAIRING AND REPLACING WORK OF OTHER TRADES AFFECTED BY DEFECTS, REPAIRS OR REPLACEMENTS IN EQUIPMENT SUPPLIED BY THE CONTRACTOR.

## GENERAL NOTES

- 1. CONTRACTOR SHALL SURVEY THE AREA OF THIS WORK BEFORE SUBMITTING A BID AND SHALL BE RESPONSIBLE FOR NOTIFYING THE ARCHITECT OF ANY CONDITIONS WHICH WOULD PREVENT THE INSTALLATION OF THE WORK AS SHOWN ON DRAWINGS
- 2. ALL APPLICABLE CODES, LAWS AND REGULATIONS GOVERNING OR RELATING TO ANY PORTION OF THIS WORK ARE HEREBY INCORPORATED INTO AND MADE A PART OF THESE SPECIFICATIONS, AND THEIR PROVISIONS SHALL BE CARRIED OUT BY THE CONTRACTOR WHO SHALL INFORM THE OWNER, PRIOR TO SUBMITTING A PROPOSAL, OF ANY WORK OR MATERIALS WHICH VIOLATE ANY OF THE ABOVE LAWS AND REGULATIONS. ANY WORK DONE BY THE CONTRACTOR CAUSING SUCH VIOLATION SHALL BE CORRECTED BY THE
- 3. BEFORE PROCEEDING WITH ANY WORK IN OCCUPIED OR USED AREAS, THE CONTRACTOR SHALL APPLY TO OWNER FOR PERMISSION TO ENTER SUCH AREAS. THE CONTRACTOR IS OBLIGED TO PERFORM HIS WORK ONLY AT THE TIMES DESIGNATED BY OWNER. THERE WILL BE NO ADDITIONAL COMPENSATION FOR THE WORK PERFORMED AFTER HOURS OR ON OFF-DAYS WITHOUT PRIOR WRITTEN APPROVAL.
- 4. THE WORK IN THE BUILDING SHALL BE DONE WHEN AND AS DIRECTED, AND IN A MANNER SATISFACTORY TO THE OWNER. THE WORK SHALL BE PERFORMED SO AS TO CAUSE THE LEAST POSSIBLE INCONVENIENCE AND DISTURBANCE TO THE PRESENT OCCUPANTS.
- 5. THE CONTRACTOR'S PROPOSAL FOR ALL WORK SHALL BE PREDICATED ON THE PERFORMANCE OF THE WORK DURING REGULAR WORKING HOURS. WHEN SO DIRECTED, HOWEVER, THE CONTRACTOR SHALL INSTALL WORK IN OVERTIME AND THE ADDITIONAL COST TO BE CHARGED THEREFORE SHALL BE ONLY THE "PREMIUM" PORTION OF THE WAGES PAID.
- 6. CONTRACTOR SHALL ASCERTAIN THE APPROPRIATE METHOD FOR BRINGING THE UNITS INTO AND THROUGH THE BUILDING TO POSITION UNIT IN LOCATION SHOWN ON THE PLANS. WHERE NECESSARY, EQUIPMENT SHALL BE SHIPPED FROM MANUFACTURER IN SECTIONS OF SIZE SUITABLE FOR MOVING THROUGH RESTRICTIVE SPACES. COORDINATE WITH BUILDING OWNER APPROPRIATE TIMES OF THE DAY SUCH THAT EQUIPMENT MAY BE MOVED THROUGH AREAS.
- 7. DUCTWORK IS SHOWN DIAGRAMMATICALLY AND DOES NOT SHOW ALL OFFSETS, DROPS AND RISES OF RUNS. THE CONTRACTOR SHALL MAKE ALLOWANCE IN PRICING FOR ROUTING OF DUCTWORK TO AVOID OBSTRUCTIONS. EXACT LOCATIONS ARE SUBJECT TO APPROVAL OF ARCHITECT. COORDINATION WITH THE OTHER TRADES IS REQUIRED.
- 8. SUPPORT ALL DUCTWORK FROM BUILDING STRUCTURE AND/OR FRAMING IN AN APPROVED MANNER. WHERE OVERHEAD CONSTRUCTION DOES NOT PERMIT FASTENING OR SUPPORTS FOR EQUIPMENT, FURNISH ADDITIONAL FRAMING. INSERTS SHALL BE STEEL, SLOTTED TYPE AND FACTORY PAINTED. SINGLE ROD SHALL BE SIMILAR TO GRINNELL FIG. 281. MULTI-ROD SHALL BE SIMILAR TO FEE & MASON SERIES 9000 WITH END CAPS AND CLOSURE STRIPS. MAXIMUM LOADING INCLUDING PIPES, DUCTWORK CONTENTS AND COVERING SHALL NOT EXCEED 75% OF RATED INSERT CAPABILITY. WHEN SUPPORTING FROM BUILDING USE BEAM CLAMPS IN APPROVED
- 9. PROVIDE ALL NECESSARY FLASHING AND COUNTER FLASHING TO MAINTAIN THE WATERPROOFING INTEGRITY OF THIS BUILDING AS REQUIRED BY THE INSTALLATION OR REMOVAL OF PIPES, DUCTS, LOUVERS, CONDUIT, AND EQUIPMENT. PROVIDE EQUIPMENT CURBS AND DUNNAGE STEEL AS REQUIRED.
- 10. SEAL OPENINGS AROUND DUCTS AND PIPING THROUGH PARTITIONS, WALLS AND FLOORS (NOT IN SHAFTS) WITH MINERAL WOOL OR OTHER NONCOMBUSTIBLE MATERIAL (FIBERGLASS INSULATION IS NOT ACCEPTABLE).
- 11. WHERE PENETRATIONS THROUGH FIRE RATED WALLS ARE NOT FIRE STOPPED THIS CONTRACTOR SHALL BE RESPONSIBLE TO SEAL SAME TO MAINTAIN THE RATED INTEGRITY.INSTALL WORK SO AS TO BE READILY ACCESSIBLE FOR OPERATION, MAINTENANCE AND REPAIR. MINOR DEVIATIONS FROM DRAWINGS MAY BE MADE TO ACCOMPLISH THIS, BUT CHANGES WHICH INVOLVE EXTRA COST SHALL NOT BE MADE WITHOUT
- ACCESS DOORS ARE REQUIRED FOR ALL BUILDING SERVICE VALVES THAT RUN THROUGH THE SPACE, AND ACCESS DOOR SHALL HAVE THE EQUAL RATED CAPACITY (1HR, 2HR, ETC.) AS WALL OR CEILING. COORDINATE ALL LOCATIONS OF ACCESS DOORS WITH THE ARCHITECT.
- REMOVABLE ACCESS TILE AND/OR ACCESS DOOR ARE REQUIRED IN HUNG CEILINGS, SHAFTS AND WALLS FOR ALL VOLUME AND FIRE DAMPERS, AUTOMATIC DAMPERS AND ALL OTHER MECHANICAL EQUIPMENT AND DEVICES. HVAC CONTRACTOR TO FURNISH ACCESS LOCATION REQUIREMENTS TO GENERAL CONTRACTOR. ACCESS TILE IDENTIFICATION: PROVIDE BUTTONS, TABS, AND MARKERS TO IDENTIFY LOCATION OF CONCEALED VALVES, DAMPERS AND EQUIPMENT.
- 14. THE CONTRACTOR SHALL KEEP ALL EQUIPMENT AND MATERIALS, AND ALL PARTS OF THE BUILDING, EXTERIOR SPACES AND ADJACENT STREETS, SIDEWALKS AND PAVEMENTS, FREE FROM MATERIAL AND DEBRIS RESULTING FROM THE EXECUTION OF THIS WORK. EXCESS MATERIALS WILL NOT BE PERMITTED TO ACCUMULATE EITHER ON THE INTERIOR OR THE EXTERIOR.
- 15. MATERIALS AND WORKMANSHIP, UNLESS OTHERWISE NOTED, SHALL BE IN ACCORDANCE WITH BUILDING STANDARDS.
- 16. ALL EQUIPMENT SHALL BE PROVIDED WITH ONE YEAR WARRANTY PARTS AND LABOR AND FIVE YEARS ON COMPRESSORS. WARRANTY PERIOD BEGINS UPON PROJECT

ACCEPTANCE

- 17. ALL MATERIAL AND EQUIPMENT TO BE NEW UNLESS OTHERWISE NOTED AND SHALL BE IN ACCORDANCE WITH BUILDING STANDARDS.
- 18. THE CONTRACTOR SHALL BE RESPONSIBLE FOR HIS WORK WITH ITS COMPLETION AND FINAL ACCEPTANCE. THE CONTRACTOR SHALL REPLACE ITEMS/MATERIAL WHICH WERE DAMAGED, LOST, OR STOLEN, WITHOUT ADDITIONAL COST TO THE OWNER.

### GENERAL HVAC NOTES

#### GENERAL:

- 1. PROVIDE ALL MATERIAL AND EQUIPMENT AND PERFORM ALL LABOR REQUIRED TO INSTALL COMPLETE AND OPERABLE MECHANICAL SYSTEMS AS INDICATED ON THE DRAWINGS, AS SPECIFIED AND AS
- 2. CONTRACT DOCUMENT DRAWINGS FOR MECHANICAL WORK (HVAC, PLUMBING, AND FIRE PROTECTION) ARE DIAGRAMMATIC AND ARE INTENDED TO CONVEY SCOPE AND GENERAL ARRANGEMENT ONLY.
- 3. THE LOCATIONS OF ALL ITEMS SHOWN ON THE DRAWINGS OR CALLED FOR IN THE SPECIFICATIONS THAT ARE NOT FIXED BY DIMENSIONS ARE APPROXIMATE ONLY. THE EXACT LOCATIONS NECESSARY TO SECURE THE BEST CONDITIONS AND RESULTS MUST BE DETERMINED BY THE PROJECT SITE CONDITIONS AND SHALL HAVE THE APPROVAL OF THE ENGINEER BEFORE BEING INSTALLED. DO NOT SCALE DRAWINGS.
- 4. WHEN MECHANICAL WORK (HVAC, PLUMBING, SHEET METAL, FIRE PROTECTION, ETC.) IS SUBCONTRACTED, IT SHALL BE THE MECHANICAL CONTRACTOR'S RESPONSIBILITY TO COORDINATE SUBCONTRACTORS AND THE ASSOCIATED CONTRACTS. WHEN DISCREPANCIES ARISE PERTAINING TO WHICH CONTRACTOR PROVIDES A PARTICULAR ITEM OF THE MECHANICAL CONTRACT OR WHICH CONTRACTOR PROVIDES FINAL CONNECTIONS FOR A PARTICULAR ITEM OF THE MECHANICAL CONTRACT. IT SHALL BE BROUGHT TO THE ATTENTION OF THE MECHANICAL CONTRACTOR. WHOSE DECISION SHALL BE FINAL.
- 5. COORDINATE CONSTRUCTION OF ALL MECHANICAL WORK WITH ARCHITECTURAL, STRUCTURAL, CIVIL, ELECTRICAL WORK, ETC., SHOWN ON OTHER CONTRACT DOCUMENT DRAWINGS.
- 6. INSTALL ALL MECHANICAL EQUIPMENT AND APPURTENANCES IN ACCORDANCE WITH MANUFACTURER'S RECOMMENDATIONS. CONTRACT DOCUMENTS, AND APPLICABLE CODES AND REGULATIONS.

CERTIFIED DRAWINGS. COORDINATE AND PROVIDE ALL DUCT

- 7. WHERE TWO OR MORE ITEMS OF THE SAME TYPE OF EQUIPMENT ARE REQUIRED, THE PRODUCT OF ONE MANUFACTURER SHALL BE USED. 8. COORDINATE ALL EQUIPMENT CONNECTIONS WITH MANUFACTURERS'
- TRANSITIONS REQUIRED FOR FINAL EQUIPMENT CONNECTIONS TO FURNISHED EQUIPMENT. FIELD VERIFY AND COORDINATE ALL DUCT DIMENSIONS BEFORE FABRICATION.
- ALL CONTROL WIRE AND CONDUIT SHALL COMPLY WITH THE NATIONAL LECTRIC CODE AND ELECTRICAL DIVISION OF THE SPECIFICATION.
- PROVIDE VIBRATION ISOLATION FOR ALL MECHANICAL EQUIPMENT TO PREVENT TRANSMISSION OF VIBRATION TO BUILDING STRUCTURE.
- LOCATE ALL TEMPERATURE, PRESSURE, AND FLOW MEASURING DEVICES IN ACCESSIBLE LOCATIONS WITH THE STRAIGHT SECTION OF DUCT UP- AND DOWNSTREAM AS RECOMMENDED BY THE MANUFACTURER FOR GOOD ACCURACY.
- ALL MISCELLANEOUS STEEL REQUIRED TO ENSURE PROPER INSTALLATION AND AS SHOWN IN THE DETAILS FOR DUCTWORK, AND EQUIPMENT (UNLESS OTHERWISE NOTED) SHALL BE FURNISHED AND STALLED BY THE MECHANICAL CONTRACTOR.
- 13. PROVIDE ACCESS PANELS FOR INSTALLATION IN WALLS AND CEILINGS, WHERE REQUIRED, TO SERVICE DAMPERS, VALVES, SMOKE DETECTORS, AND OTHER CONCEALED MECHANICAL EQUIPMENT. ACCESS PANELS SHALL BE TURNED OVER TO THE GENERAL CONTRACTOR FOR INSTALLATION. ACCESS PANELS SHALL HAVE THE EQUAL RATED CAPACITY (1HR, 2HR, ETC.) AS WALL.
- 14. MECHANICAL EQUIPMENT, DUCTWORK, SHALL NOT BE SUPPORTED FROM A METAL DECK.
- 15. ALL EQUIPMENT, DUCTWORK, ETC., SHALL BE SUPPORTED AS DETAILED, SPECIFIED AND REQUIRED TO PROVIDE A VIBRATION-FREE INSTALLATION.
- 16. ALL DUCTWORK, AND EQUIPMENT SUPPORTED FROM STRUCTURAL STEEL SHALL BE COORDINATED WITH THE GENERAL CONTRACTOR. ALL ATTACHMENTS TO STEEL BAR JOISTS, TRUSSES, OR JOIST GIRDERS SHALL BE AT PANEL POINTS. PROVIDE BEAM CLAMPS MEETING MSS STANDARDS. WELDING TO STRUCTURAL MEMBERS SHALL NOT BE PERMITTED. THE USE OF C-CLAMPS SHALL NOT BE
- 17. ALL ROOF-MOUNTED EQUIPMENT CURBS FOR EQUIPMENT PROVIDED BY THE MECHANICAL CONTRACTOR SHALL BE FURNISHED BY THE MECHANICAL CONTRACTOR AND INSTALLED BY THE GENERAL
- 18. LOCATIONS AND SIZES OF ALL FLOOR, WALL, AND ROOF OPENINGS SHALL BE COORDINATED WITH ALL OTHER TRADES INVOLVED.
- 19. ALL OPENINGS IN FIRE WALLS DUE TO DUCTWORK, CONDUIT, ETC., SHALL BE FIRE STOPPED WITH A PRODUCT SIMILAR TO 3M OR APPROVED EQUAL.
- 20. ALL AIR CONDITIONING CONDENSATE DRAIN LINES FROM EACH ROOF TOP UNIT SHALL BE FULL SIZE OF THE UNIT DRAIN OUTLET, WITH "P" TRAP, AND PIPED TO THE NEAREST DRAIN. SEE THE DETAILS SHOWN IN THE DRAWINGS OR THE CONTRACT SPECIFICATIONS FOR THE DEPTH OF THE AIR CONDITIONING CONDENSATE TRAP.
- 21. REFER TO TYPICAL DETAILS FOR DUCTWORK, AND EQUIPMENT INSTALLATION.
- 22. REINFORCEMENT, DETAILING, AND PLACEMENT OF CONCRETE SHALL CONFORM TO ASTM 315 AND ACI 318. CONCRETE SHALL CONFORM TO ASTM C94. CONCRETE WORK SHALL CONFORM TO ACI 318 PART ENTITLED "CONSTRUCTION REQUIREMENTS".COMPRESSIVE STRENGTH IN 28 DAYS SHALL BE 3,000 PSI. TOTAL AIR CONTENT OR EXTERIOR CONCRETE SHALL BE BETWEEN 5 AND 7 PERCENT BY VOLUME. SLUMP SHALL BE BETWEEN 3 AND 4 IN. CONCRETE SHALL BE CURED FOR 7 DAY AFTER PLACEMENT.
- 23. ALL TESTS SHALL BE COMPLETED BEFORE ANY MECHANICAL EQUIPMENT INSULATION IS APPLIED.
- 24. TESTING, ADJUSTING, AND BALANCING AGENCY SHALL BE A MEMBER OF THE ASSOCIATED AIR BALANCE COUNCIL (AABC) OR THE NATIONAL ENVIRONMENTAL BALANCING BUREAU (NEBB). TESTING, ADJUSTING, AND BALANCING SHALL BE PERFORMED IN ACCORDANCE WITH THE AABC STANDARDS.
- HVAC DUCTWORK SHEET METAL
- 1. CERTAIN ITEMS SUCH AS RISES AND DROPS IN DUCTWORK, ACCESS DOORS, VOLUME DAMPERS, ETC., ARE INDICATED ON THE CONTRACT DOCUMENT DRAWINGS FOR CLARITY FOR A SPECIFIC LOCATION REQUIREMENT AND SHALL NOT BE INTERPRETED AS THE EXTENT OF THE REQUIREMENTS FOR THESE ITEMS.
- 2. ALL NEW DUCTWORK WILL COMPLY WITH THE LATEST SMACNA GUIDELINES AND CONFORM WITH REQUIREMENTS OF THE LATEST HANDBOOKS PUBLISHED BY ASHRAE.
- 3. PROVIDE VOLUME DAMPER AT EACH TAP TO MAIN DUCT AND WHERE NECESSARY TO PROPERLY BALANCE SYSTEM.
- 4. SUPPLY AND RETURN DUCTWORK 10' FROM ALL AC UNITS SHALL BE LINED WITH 1.5" ACOUSTICAL LINING.
- 5. RE-INSULATE ALL DUCTWORK IN WHICH INSULATION HAS BEEN REMOVED OR DAMAGED WITH INSULATION EQUAL TO THE EXISTING INSULATION.
- 6. CONTRACTOR SHALL SUPPLY AND INSTALL ALL NECESSARY SUPPLY DIFFUSERS AND RETURN AIR REGISTERS WHERE INDICATED ON THE DRAWING. COORDINATE LOCATION OF DIFFUSERS AND REGISTERS WITH REFLECTED CEILING PLAN.

7. IN CORRIDORS WHERE CEILING SPEAKERS AND AIR DIFFUSERS ARE INDICATED BETWEEN THE SAME LIGHT FIXTURES, INSTALL BOTH

DEVICES AT THE QUARTER POINTS BETWEEN THE FIXTURES.

8. UNLESS OTHERWISE SHOWN, LOCATE ALL ROOM THERMOSTATS AND HUMIDISTAT 4'-0" (CENTER LINE) ABOVE THE FINISHED FLOOR. NOTIFY THE ENGINEER OF ANY ROOMS WHERE THE PRECEDING LOCATION CANNOT BE MAINTAINED OR WHERE THERE IS A QUESTION ON

- 9. ALL DUCTWORK SHALL CLEAR DOORS AND WINDOWS.
- 10. ALL DUCTWORK DIMENSIONS, AS SHOWN ON THE DRAWINGS, ARE INTERNAL CLEAR DIMENSIONS AND DUCT SIZE SHALL BE INCREASED TO COMPENSATE FOR DUCT LINING THICKNESS.
- 11. PROVIDE ALL 90-DEGREE SQUARE ELBOWS WITH DOUBLE RADIUS TURNING VANES UNLESS OTHERWISE INDICATED. ELBOWS IN DISHWASHER, KITCHEN, AND LAUNDRY EXHAUSTS SHALL BE OF UN-VANED SMOOTH RADIUS CONSTRUCTION WITH A RADIUS EQUAL TO 1-1/2 TIMES THE WIDTH OF THE DUCT. PROVIDE ACCESS DOORS
- 12. COORDINATE DIFFUSER, REGISTER, AND GRILL LOCATIONS WITH ARCHITECTURAL REFLECTED CEILING PLANS, LIGHTING, AND OTHER CEILING ITEMS AND MAKE MINOR DUCT MODIFICATIONS TO SUIT.

UPSTREAM OF ALL ELBOWS WITH TURNING VANES.

- 13. FIELD-ERECTED AND FACTORY-ASSEMBLED AIR HANDLING UNIT COILS SHALL BE ARRANGED FOR REMOVAL FROM THE UPSTREAM SIDE WITHOUT DISMANTLING SUPPORTS. PROVIDE GALVANIZED STRUCTURAL STEEL SUPPORTS FOR ALL COILS (EXCEPT THE LOWEST COIL) IN BANKS OVER TWO COILS HIGH TO PERMIT THE INDEPENDENT REMOVAL OF ANY COIL.
- 14. ALL AIR HANDLING UNITS SHALL OPERATE WITHOUT MOISTURE CARRYOVER.
- 15. LOCATE ALL MECHANICAL EQUIPMENT (SINGLE DUCT. DUAL DUCT. VARIABLE VOLUME. CONSTANT VOLUME. AND FAN-POWERED BOXES. FAN COIL UNITS, CABINET HEATERS, UNIT HEATERS, UNIT VENTILATORS, COILS, STEAM HUMIDIFIERS, ETC.) FOR UNOBSTRUCTED ACCESS TO UNIT ACCESS PANELS, CONTROLS, AND
- 16. PROVIDE FLEXIBLE CONNECTIONS IN ALL DUCTWORK SYSTEMS (SUPPLY, RETURN, AND EXHAUST) CONNECTED TO AIR HANDLING UNITS, FANS, AND OTHER EQUIPMENT THAT REQUIRE VIBRATION ISOLATION. FLEXIBLE CONNECTIONS SHALL BE PROVIDED AT THE POINT OF CONNECTION TO THE EQUIPMENT UNLESS OTHERWISE INDICATED.
- 17. UNLESS OTHERWISE NOTED, ALL DUCTWORK IS OVERHEAD, TIGHT TO THE UNDERSIDE OF THE STRUCTURE, WITH SPACE FOR INSULATION IF NEEDED.
- 18. RUNS OF FLEXIBLE DUCT SHALL NOT EXCEED 5 FT.
- 19. ALL DUCTWORK SHALL BE COORDINATED WITH ALL TRADES INVOLVED. OFFSETS IN DUCTS, INCLUDING DIVIDED DUCTS AND TRANSITIONS AROUND OBSTRUCTIONS, SHALL BE PROVIDED AT NO ADDITIONAL COST TO THE OWNER.
- 20. PROVIDE ACCESS DOORS IN DUCTWORK TO PROVIDE ACCESS FOR ALL SMOKE DETECTORS, FIRE DAMPERS, SMOKE DAMPERS, VOLUME DAMPERS, HUMIDIFIERS, COILS, AND OTHER ITEMS LOCATED IN THE DUCTWORK THAT REQUIRE SERVICE AND/OR INSPECTION.
- 21. PROVIDE ACCESS DOORS IN DUCTWORK FOR THE OPERATION. ADJUSTMENT, AND MAINTENANCE OF ALL FANS, VALVES, AND MECHANICAL EQUIPMENT.
- 22. ALL DUCTS SHALL BE GROUNDED ACROSS FLEXIBLE CONNECTIONS WITH FLEXIBLE COPPER GROUNDING STRAPS. GROUNDING STRAPS SHALL BE BOLTED OR SOLDERED TO BOTH THE EQUIPMENT AND THE
- 23. SMOKE DETECTORS SHALL BE FURNISHED AND WIRED BY THE ELECTRICAL CONTRACTOR. THE MECHANICAL CONTRACTOR SHALL BE RESPONSIBLE FOR MOUNTING THE SMOKE DETECTOR IN DUCTWORK AS SHOWN ON THE DRAWINGS AND IN ACCORDANCE WITH THE MANUFACTURER'S PRINTED INSTRUCTIONS.
- 24. SEE SPECIFICATIONS FOR DUCTWORK GAUGES, BRACING, HANGERS, AND OTHER REQUIREMENTS.

CONSULTANTS (ENGINEER):

**NEARBY ENGINEERS** 382 NE 191ST STREET SUITE 49674,

MIAMI, FL 33179

PH-914.257.3455

WWW.NY-ENGINEERS.COM

CONTRACTOR'S NOTES: VRITTEN DIMENSIONS HOLD PREFERENCE OVER SCALED DIMENSIONS. DO NOT SCALE THE DRAWINGS. THE CONTRACTORS MUST VISIT IOB SITE TO VERIEY ALL EXISTING CONDITIONS AND DIMENSIONS BEFORE SUBMITTING BIDS. REPORT ANY DISCREPANCIES OF ANY CONDITIONS WHICH MAY INTERFERE WITH THE PROPER

EXECUTION OF, THE CONTRACT TO THE TENANT'S REPRESENTATIVE, REPORT DISCREPANCIES DURING BIDDING PROCESS AND BEFORE START OF CONSTRUCTION. CHANGE ORDERS NEED TO BE APPROVED BY TOWNSQUARE CONSTRUCTION MANAGER FOR ISSUES ARISING FROM THE FIELD CONDITIONS OR CONFLICTS BETWEEN THE PLANS AND THE EXISTING CONDITIONS PRIOR TO THE

COMMENCEMENT OF WORK.

ISSUE 10.31.24 LL/CLIENT REVIEW SET 11.15.24 LL/CLIENT REVIEW SET

11.22.24 BD SUBMISSION

DATE REVISION



11.15.24 CLIENT COMMENTS

MECHANICAL SYMBOLS LIST, ABBREVIATIONS & GENERAL NOTES

#### **SPECIFICATIONS**

#### SECTION 0001 - NOTICE TO BIDDERS

### 1.1 BIDDERS REPRESENTATIONS

- A. THE BIDDER BY MAKING A BID REPRESENTS THAT: THE BIDDER HAS READ AND UNDERSTANDS THE BIDDING DOCUMENTS, TO THE EXTENT THAT SUCH DOCUMENTATION
- AND FOR OTHER PORTIONS OF THE PROJECT, IF ANY, BEING BID CONCURRENTLY OR PRESENTLY UNDER CONSTRUCTION.

B. THE BID IS MADE IN COMPLIANCE WITH THE BIDDING

DOCUMENTS. C. THE SPECIFICATIONS AND DRAWINGS ARE INTENDED TO SERVE JOINTLY AS A BASIS FOR THE BIDDER TO SUBMIT A

RELATES TO THE WORK FOR WHICH THE BID IS SUBMITTED.

CONTRACT PRICE FOR THE MATERIAL AND LABOR. D. SHOULD CONFLICTS OR DISCREPANCIES OCCUR WITHIN THE BIDDING DOCUMENTS, THE ITEM OR ITEMS IN DISPUTE

THAT REPRESENT THE GREATER COST SHALL PREVAIL IN

E. THE BID IS BASED UPON THE MATERIALS, EQUIPMENT AND SYSTEMS REQUIRED BY THE BIDDING DOCUMENTS WITHOUT EXCEPTION.

#### 1.2 EXISTING CONDITIONS AND COORDINATION

THE FINAL BID.

- A. THE BIDDER HAS VISITED THE SITE, BECOME FAMILIAR WITH LOCAL CONDITIONS UNDER WHICH THE WORK IS TO BE PERFORMED AND HAS CORRELATED THE BIDDER'S PERSONAL OBSERVATIONS WITH THE REQUIREMENTS OF
- THE PROPOSED BIDDING DOCUMENTS. B. THE BIDDER SHALL PROPOSE COORDINATION OF WORK SUCH THAT CONFLICTS WITH OTHER TRADES AND SPACE ALLOCATIONS ARE AVOIDED.

#### 1.3 RESPONSIBILITIES

- A. THE BIDDER UNDERSTANDS THAT ANY CONTRACTOR SHALL BE FULLY RESPONSIBLE FOR THE TIMELY COMPLETION AND ACCEPTANCE OF THEIR WORK AND THAT ANY ITEMS DAMAGED, LOST OR STOLEN DURING TIME OF CONSTRUCTION SHALL BE REPAIRED OR REPLACED WITHOUT ANY ADDITIONAL COST TO THE OWNER.
- B. THE BIDDER UNDERSTANDS THAT ANY PROPOSED WORK IN OCCUPIED TENANT SPACES SHALL BE PERFORMED DURING TIMES OF NON-TENANT OCCUPANCY OR AS SCHEDULED OR DIRECTED BY THE BUILDING MANAGER.
- C. THE BIDDER UNDERSTANDS THAT ANY PROPOSED SHUT-DOWN OF EXISTING SYSTEMS DURING CONSTRUCTION SHALL BE PRE-ARRANGED WITH THE BUILDING MANAGER AND THAT SUCH SHUT-DOWNS ARE TO BE KEPT TO A MINIMUM.

#### END OF SECTION 0001

## SECTION 0101 - QUALITY OF WORK

- A. ALL WORK SHALL BE FREE FROM DEFECTS IN MATERIALS AND WORKMANSHIP FOR A PERIOD OF ONE YEAR FROM DATE OF FINAL ACCEPTANCE.
- B. ALL DEFECTS WHICH DEVELOP OR ARE DISCOVERED WITHIN THIS PERIOD SHALL BE REPAIRED BY THE CONTRACTOR TO THE SATISFACTION OF THE ARCHITECT OR BUILDING MANAGER AT NO ADDITIONAL COST TO THE OWNER.
- C. UPON COMPLETION OF THE WORK THE CONTRACTOR SHALL REMOVE FROM THE SITE. ALL TOOLS, DEMOLISHED APPLIANCES AND ANY SURPLUS MATERIAL.

## 1.2 CODE COMPLIANCE

A. ALL WORK SHALL MEET ALL STATE AND LOCAL CODES HAVING JURISDICTION.

## END OF SECTION 0101

## SECTION 0102 - REQUIRED DOCUMENTS

## 1.1 SHOP DRAWINGS

A. A SET OF PRINTS FOR ANY MECHANICAL WORK INCLUDING BUT NOT LIMITED TO, DUCTWORK LAYOUT SHALL BE SUBMITTED FOR APPROVAL TO THE ENGINEER PRIOR TO CONSTRUCTION OR PURCHASE OF MATERIALS

## 1.2 SUBMITTALS

- A. EQUIPMENT SUBMITTALS OF ALL PROPOSED MECHANICAL AND ANCILLARY EQUIPMENT INCLUDING ALL ACCESSORIES SHALL BE SUBMITTED TO THE ENGINEER FOR REVIEW. ALL PERTINENT MODELS, SIZES, ACCESSORIES AND CHOICES SHALL BE CLEARLY CHECKED, PRINTED OR OTHERWISE INDICATED ON THE SUBMITTALS.
- 1.3 RECORD DRAWINGS
- A. UPON COMPLETION OF THE WORK, A RECORD DRAWING SHALL BE SUBMITTED TO THE OWNER DEPICTING ALL SUBSEQUENT CHANGES, ADDITIONS AND OR CORRECTIONS TO THE CONTRACT DRAWINGS AND OR CONTRACT SCOPE MADE DURING CONSTRUCTION. THIS DRAWING SHALL REPRESENT A COMPLETE RECORD OF THE WORK INSTALLED.
- 1.4 EQUIPMENT OPERATING INSTRUCTIONS
- A. ON COMPLETION AND ACCEPTANCE OF WORK, THIS CONTRACTOR SHALL FURNISH INSTRUCTIONS, EQUIPMENT MANUALS AND DEMONSTRATE TO THE OWNER THE PROPER OPERATION AND MAINTENANCE OF ALL EQUIPMENT AND APPARATUS FURNISHED UNDER THIS CONTRACT.

B. THESE INSTRUCTIONS SHALL BE TYPED ON 8-1/2 IN. X 11 IN. PAPER AND BOUND IN THREE-RING BINDERS WITH CLEAR ACETATE COVERS. THE CONTRACTOR SHALL GIVE THREE COPIES OF THE INSTRUCTIONS TO THE OWNER AND ONE ELECTRONIC COPY TO THE ENGINEER.

C. THE INSTRUCTION BOOKLET SHALL BE ORGANIZED IN SECTIONS, WITH ONE SECTION PER SYSTEM. THE COVER OF THE INSTRUCTION BOOKLET SHALL BEAR THE NAME, ADDRESS AND PHONE NUMBER OF THE PROJECT, ARCHITECT, ENGINEER, MECHANICAL CONTRACTOR AND SUBCONTRACTORS. END OF SECTION 0102

## SECTION 078413-PENETRATION FIRE-STOPPING

D. W-RATINGS: PER UL 1479.

- 1.1 QUALITY ASSURANCE A. INSTALLER QUALIFICATIONS: AN FM GLOBAL-APPROVED FIRE-STOP CONTRACTOR OR A UL-QUALIFIED FIRE-STOP CONTRACTOR.
- B. FIRE-TEST-RESPONSE CHARACTERISTICS: UL. INTERTEK ETL SEMKO OR FM GLOBAL
- 1.2 PENETRATION FIRESTOPPING A. PENETRATIONS IN FIRE-RESISTANCE-RATED WALLS:
- F-RATINGS PER ASTM E 814 OR UL 1479.
- B. PENETRATIONS IN HORIZONTAL ASSEMBLIES: F- AND T-RATINGS PER ASTM E 814 OR UL 1479:
- C. PENETRATIONS IN SMOKE BARRIERS: L-RATINGS PER UL 1479.

- 1.3 INSTALLATION A. IDENTIFICATION: PREPRINTED METAL OR PLASTIC LABELS.
  - 1.4 FIELD QUALITY CONTROL A. INSPECTION OF INSTALLED FIRE-STOPPING: BY OWNER-ENGAGED AGENCY ACCORDING TO ASTM E 2174.
  - 1.5 THROUGH-PENETRATION FIRESTOP SYSTEM SCHEDULE

WHERE UL-CLASSIFIED SYSTEMS ARE INDICATED, THEY REFER TO SYSTEM NUMBERS IN UL'S "FIRE RESISTANCE DIRECTORY" UNDER PRODUCT CATEGORY XHEZ.

### FOR THE FOLLOWING SYSTEMS:

- METALLIC AND NON-METALLIC CONDUIT, OR TUBING, ELECTRICAL CABLES, CABLE TRAYS WITH ELECTRIC CABLES, MISCELLANEOUS ELECTRICAL PENETRANTS, INSULATED GROUPINGS OF PENETRANTS, USE ONE OR MORE THE FOLLOWING MATERIALS:
- a. LATEX SEALANT
- b. SILICONE SEALANT c. INTUMESCENT PUTTY
- d. MORTAR
- h. SILICONE FOAM i. PILLOWS/BAGS

# k. INTUMESCENT COMPOSITE SHEET

## 1.6 MANUFACTURERS

END OF SECTION 078413

HVAC EQUIPMENT

1. HILTI CONSTRUCTION CHEMICAL, INC

j. INTUMESCENT WRAP STRIPS

- 3. 3M FIRE PROTECTION PRODUCTS

# SECTION 230529 - HANGERS AND SUPPORTS FOR

- 1.1 PERFORMANCE REQUIREMENTS A. DELEGATED DESIGN: DESIGN EQUIPMENT SUPPORTS, INCLUDING COMPREHENSIVE ENGINEERING ANALYSIS BY A QUALIFIED PROFESSIONAL ENGINEER, USING PERFORMANCE REQUIREMENTS AND DESIGN CRITERIA INDICATED.
- B. STRUCTURAL PERFORMANCE: HANGERS AND SUPPORTS FOR HVAC EQUIPMENT SHALL WITHSTAND THE EFFECTS OF GRAVITY LOADS AND STRESSES WITHIN LIMITS AND UNDER CONDITIONS INDICATED ACCORDING TO ASCE/SEI 7.
- 1. DESIGN EQUIPMENT SUPPORTS CAPABLE OF SUPPORTING COMBINED OPERATING WEIGHT OF SUPPORTED EQUIPMENT AND CONNECTED SYSTEMS
- 2. DESIGN SEISMIC-RESTRAINT HANGERS AND SUPPORTS FOR EQUIPMENT AND OBTAIN APPROVAL FROM AUTHORITIES HAVING JURISDICTION.

## 1.2 SUBMITTALS

- A. SHOP DRAWINGS: SIGNED AND SEALED BY A
- 1.3 QUALITY ASSURANCE A. AWS D1.1/D1.1M. "STRUCTURAL WELDING CODE - STEEL."
- 1.4 COMPONENTS
- A. METAL FRAMING SYSTEMS: MFMA MANUFACTURER
- B. FIBERGLASS STRUT SYSTEMS: COOPER B-LINE
- C. THERMAL-HANGER SHIELD INSERTS: D. FASTENER SYSTEMS: POWDER-ACTUATED FASTENERS OR
- MECHANICAL-EXPANSION ANCHORS E. EQUIPMENT SUPPORTS

# END OF SECTION 230529

#### SECTION 230548 - VIBRATION AND SEISMIC CONTROLS FOR HVAC EQUIPMENT

## PART 1 - GENERAL

1.1 PERFORMANCE REQUIREMENTS

A. SEISMIC-RESTRAINT LOADING:

- 1. SITE CLASS AS DEFINED IN THE IBC: A, B
- 2. ASSIGNED SEISMIC USE GROUP OR BUILDING CATEGORY AS
- DEFINED IN THE IBC: I II III a. COMPONENT IMPORTANCE FACTOR: 1.0
- b. COMPONENT RESPONSE MODIFICATION FACTOR: 2.5 c. COMPONENT AMPLIFICATION FACTOR: 2.5.
- 3. DESIGN SPECTRAL RESPONSE ACCELERATION AT SHORT PERIODS (0.2 SECOND) 18%

4. DESIGN SPECTRAL RESPONSE ACCELERATION AT 1-SECOND

## PERIOD: 8%

#### 1.2 COMPONENTS A. VIBRATION ISOLATORS:

- 1. ISOLATOR PADS: NEOPRENE, RUBBER, HERMETICALLY AND/OR SEALED COMPRESSED FIBERGLASS
- 2. MOUNTS: DOUBLE-DEFLECTION TYPE.
- 3. RESTRAINED MOUNTS: ALL DIRECTIONAL MOUNTINGS WITH SEISMIC RESTRAINT; CAST-DUCTILE-IRON HOUSING.
- 4. SPRING ISOLATORS: FREESTANDING, LATERALLY STABLE,
- OPEN-SPRING TYPE. 5. RESTRAINED SPRING ISOLATORS: FREESTANDING, STEEL,
- OPEN-SPRING TYPE WITH SEISMIC RESTRAINT. 6. HOUSED SPRING MOUNTS: DUCTILE-IRON OR STEEL HOUSING.
- WITH INTEGRAL, VERTICALLY ADJUSTABLE SEISMIC SNUBBERS. 7. ELASTOMERIC HANGERS: DOUBLE-DEFLECTION TYPE.
- 8. SPRING HANGERS: COMBINATION COIL-SPRING AN ELASTOMERIC-INSERT HANGERS WITH SPRING AND INSERT IN COMPRESSION.
- 9. SPRING HANGERS WITH VERTICAL-LIMIT STOP: COMBINATION COIL-SPRING AND ELASTOMERIC-INSERT HANGERS WITH SPRING AND INSERT IN COMPRESSION AND WITH VERTICAL-LIMIT STOP.

## B. AIR-MOUNTING SYSTEMS:

- 1. AIR MOUNTS: FREESTANDING, SINGLE OR MULTIPLE,
- 2. RESTRAINED AIR MOUNTS: HOUSED COMPRESSED-AIR BELLOWS.
- C. RESTRAINED VIBRATION ISOLATION ROOF-CURB RAILS: FACTORY-ASSEMBLED, FULLY ENCLOSED, INSULATED, AIR- AND WATERTIGHT CURB RAIL; WITH SPRING ISOLATORS MOUNTED ON ELASTOMERIC ISOLATION PADS, AND SNUBBER BUSHINGS.

## D. VIBRATION ISOLATION EQUIPMENT BASES:

- 1. STEEL BASE: FACTORY-FABRICATED, WELDED, STRUCTURAL-STEEL BASES AND RAILS.
- 2. INERTIA BASE: FACTORY-FABRICATED, WELDED, STRUCTURAL-STEEL BASES AND RAILS READY FOR FIELD-APPLIED, CAST-IN-PLACE CONCRETE.

## E. SEISMIC-RESTRAINT DEVICES:

- 1. SNUBBERS: WELDED STRUCTURAL-STEEL SHAPES AND REPLACEABLE RESILIENT ISOLATION WASHERS AND BUSHINGS.
- 2. CHANNEL SUPPORT SYSTEM: MFMA-3 SLOTTED STEEL
- 3. RESTRAINT CABLES: GALVANIZED OR STAINLESS STEEL
- 4. ANCHOR BOLTS: MECHANICAL OR ADHESIVE TYPE, SEISMIC 5. RESILIENT ISOLATION WASHERS AND BUSHINGS: MOLDED

## 1.3 FIELD QUALITY CONTROL

A. TESTING: BY EITHER: OWNER-ENGAGED AGENCY, CONTRACTOR-ENGAGED AGENCY, OR CONTRACTOR.

#### **PART-2 PRODUCTS**

- 1.4 VIBRATION ISOLATORS & SEISMIC-RESTRAINT DEVICES A. AVAILABLE MANUFACTURERS: SUBJECT TO COMPLIANCE WITH REQUIREMENTS, MANUFACTURERS OFFERING PRODUCTS THAT MAY BE INCORPORATED INTO THE WORK INCLUDE, BUT ARE NOT LIMITED TO, THE FOLLOWING:
- B. MANUFACTURERS: SUBJECT TO COMPLIANCE WITH REQUIREMENTS, PROVIDE PRODUCTS BY ONE OF THE FOLLOWING:
- 1. ACE MOUNTINGS CO., INC.
- AMBER/BOOTH COMPANY, INC.
- CALIFORNIA DYNAMICS CORPORATION. 4. COOPER B-LINE, INC.; A DIVISION OF COOPER INDUSTRIES.
- HILTI, INC.
- KINETICS NOISE CONTROL.
- 8. LOOS & CO.; CABLEWARE DIVISION.
- MASON INDUSTRIES.
- 10. TOLCO INCORPORATED; A BRAND OF NIBCO INC.

ISOLATION TECHNOLOGY, INC.

- 11. UNISTRUT; TYCO INTERNATIONAL, LTD. 12. VIBRATION ELIMINATOR CO., INC.
- 13. VIBRATION ISOLATION. VIBRATION MOUNTINGS & CONTROLS, INC.

#### END OF SECTION 230548

#### SECTION 230593 - TESTING, ADJUSTING, AND BALANCING FOR HVAC

- A. TESTING, ADJUSTING, AND BALANCING FOR THE FOLLOWING:
  - CONSTANT-VOLUME. DUAL-DUCT VARIABLE-AIR-VOLUME, MULTI-ZONE AND INDUCTION-UNIT

#### 2. EXISTING SYSTEMS.

1.2 QUALITY ASSURANCE

A. THE CONTRACTOR SHALL PROCURE THE SERVICES OF A TESTING, ADJUSTING AND BALANCING (TAB) SPECIALIST WHO SPECIALIZES IN HEATING, VENTILATION AND AIR CONDITIONING SYSTEMS. THE TAB AGENT SHALL HAVE THE FOLLOWING QUALIFICATIONS: AABC, NEBB OR TABB CERTIFIED.

## 1.3 EXECUTION

- A. THE TAB SPECIALIST SHALL PERFORM FLOW MEASUREMENTS OF ALL EXISTING AIR SYSTEMS THAT ARE TO REMAIN OR TO BE INCORPORATED INTO NEW WORK PRIOR TO THE STARTING OF WORK IN THE PROJECT SCOPE. A REPORT OF THESE MEASUREMENTS, INDICATING ANY AND ALL DEFICIENCIES SHALL BE
- SUBMITTED FOR OWNER REVIEW. B. THE TAB SPECIALIST SHALL PERFORM FLOW MEASUREMENTS OF ALL NEW AIR SYSTEMS AS LISTED ABOVE IN THE PROJECT SCOPE. A REPORT OF THESE MEASUREMENTS, INDICATING ANY AND ALL
- DEFICIENCIES SHALL BE SUBMITTED FOR OWNER REVIEW. C. THE REPORT SHALL INDICATE A SCHEMATIC DIAGRAM INDICATING LOCATIONS OF ALL EQUIPMENT TESTED AND MEASUREMENT
- LOCATIONS. D. PRIOR TO FINAL INSPECTION OF THE WORK, THE TAB SPECIALIST SHALL BALANCE ALL SYSTEMS AS INDICATED ABOVE TO THE REQUIREMENTS OF THE DESIGN.
- E. THE CONTRACTOR SHALL FURNISH AND INSTALL ALL ADDITIONAL BALANCING EQUIPMENT, PRESSURE TAPS, GAUGES AND OTHER EQUIPMENT AS REQUIRED FOR A PROPERLY BALANCED SYSTEM AT NO ADDITIONAL COST TO THE OWNER. SUCH ADDITIONAL EQUIPMENT SHALL ADHERE IN STRICT ACCORDANCE WITH THI RESPECTIVE EQUIPMENT MANUFACTURER'S RECOMMENDATIONS.
- F. THE CONTRACTOR SHALL HAVE THE TESTING AND BALANCING SPECIALIST COORDINATE ALL WORK OF THIS SECTION WITH THE BUILDING MANAGER. BALANCING WORK SHALL NOT CONFLICT WITH OTHER WORK SO AS TO MAINTAIN COMPLETION WITHIN THE SPECIFIED TIME.
- G. ALL INSTRUMENTS USED FOR TAB SHALL BE MAINTAINED IN GOOD
- WORKING CONDITION AND ACCURATELY CALIBRATED. H. TOLERANCES: PLUS OR MINUS 5 PERCENT OF DESIGN VALUES.
- I. INSPECTIONS: RANDOM CHECKS BY OWNER OR ARCHITECT TO VERIFY FINAL TESTING, ADJUSTING, AND BALANCING REPORT. ADDITIONAL TESTS: RANDOM TESTS WITHIN 90 DAYS OF

#### COMPLETING TAB TO VERIFY BALANCE CONDITIONS AND SEASONAL TESTS.

## END OF SECTION 230593

## ECTION 230713 - DUCT INSULATION

1.1 QUALITY ASSURANCE SURFACE-BURNING CHARACTERISTICS: ALL INSULATION SHALL HAVE COMPOSITE (INSULATION JACKET OR FACING AND ADHESIVE USED TO ADHERE THE FACING OR JACKET TO THE INSULATION) A FLAME-SPREAD INDEX OF 25, AND SMOKE-DEVELOPED INDEX OF 50 FOR INSULATION INSTALLED INDOOR, 75, AND SMOKE-DEVELOPED INDEX OF 150 FOR INSULATION INSTALLED OUTDOORS; ACCORDING

# 1.2 FIELD QUALITY CONTROL

PLENUM INSULATION:

**OUTSIDE OF BUILDING:** 

A. FIELD INSPECTIONS: BY OWNER-ENGAGED AGENCY.

WITHIN BUILDING ENVELOPE ASSEMBLY:

1.3 INDOOR DUCT AND PLENUM INSULATION SCHEDULE; A. CONCEALED. RECTANGULAR. ROUND AND FLAT-OVAL. SUPPLY-RETURN, OUTDOOR-AND EXHAUST-AIR DUCT AND AIR

R-12

R-12

B. FLEXIBLE ELASTOMERIC, MINERAL-FIBER BLANKET, MINERAL-FIBER BOARD OR POLYOLEFIN WITH MINIMUM INSTALLED THERMAL RESISTANCE AS FOLLOWS: UNCONDITIONED SPACES WITHIN BUILDING: R-6

- 1.4 ITEMS NOT INSULATED:
- 1. FIBROUS-GLASS DUCTS. 2. METAL DUCTS WITH DUCT LINER OR SUFFICIENT THICKNESS TO
- COMPLY WITH ENERGY CODE ANDASHRAE/IESNA 90.1.
- 3. FACTORY-INSILATED FLEXIBLE DUCTS.
- 4. FACTORY-INSULATED PLENUMS AND CASINGS.
- 6. VIBRATION-CONTROL DEVICES. 7. 'FACTORY-INSULATED ACCESS PANELS AND DOORS.
- 8. DUCTS THAT HAVE INTERNAL ACOUSTICAL LINING. 1.5 PRODUCTS

## THE FOLLOWING INSULATION MANUFACTURERS WILL BE ACCEPTABLE:

FLEXIBLE CONNECTORS.

 JOHNS-MANVILLE 2. OWENS-CORNING

### 1.6 ACOUSTICAL TREATMENT

1. WHERE SHOWN ON THE DRAWINGS, LOW PRESSURE DUCTWORK SHALL BE LINED WITH 1.5" THICK R-6 AS MANUFACTURED BY DUCTMATE, 1-1/2 POUND MINIMUM DENSITY, NEOPRENE COATED, FLEXIBLE FIBERGLASS DUCT LINER. LINING SHALL COMPLY WITH NFPA 90A AND SHALL HAVE A FLAME SPREAD CLASSIFICATION OF NOT MORE THAN 25 AND A SMOKE DEVELOPED RATING NOT MORE THAN 50. DUCT SIZES WHERE LINING IS INDICATED ON PLANS ARE

MINIMUM INSIDE CLEAR DIMENSIONS REQUIRED,

## END OF SECTION 230713

SECTION 233113 - METAL DUCTS

- 1.1 CONSTRUCTION A. EACH DUCT SYSTEM SHALL BE CONSTRUCTED FOR THE SPECIFIC SMACNA DUCT PRESSURE CLASSIFICATIONS SHOWN ON THE CONTRACT DRAWINGS. WHERE NO PRESSURE CLASSES ARE SPECIFIED BY THE DESIGNER, THE SMACNA 2-1/2 INCH WG PRESSURE CLASS IS THE BASIS OF COMPLIANCE WITH THESE STANDARDS, REGARDLESS OF THE VELOCITY IN THE DUCT.
- B. ALL DUCTWORK SHALL BE CONSTRUCTED TO SMACNA 2" WG DESIGN AND NOT LESS THAN THE FOLLOWING
- 1. DUCTWORK SHALL BE TRANSVERSELY JOINTED BY CONNECTING SEAMS OF COMPANION ANGLES. FORMED FROM 1-1/2"X1-1/2"X1/8" GALVANIZED ANGLES, TACK-WELDED OR RIVETED TO THE DUCT. THE ANGLE FRAME SHALL BE CONTINUOUSLY FLANGED UP INTO UPRIGHT OF ANGLE AND EACH CORNER SHALL BE FILLED IN AND GROUND SMOOTH. JOINTS SHALL BE GASKETED WITH 1/8" THICK REINFORCED GASKET, OVERLAPPED AT CORNERS,
- 2. RECTANGULAR FITTINGS AND ALL TRANSITION PIECES FROM RECTANGULAR TO ROUND SHALL BE NO. 16 GAUGE ALL WELDED CONSTRUCTION.

3. HORIZONTAL DUCTS SHALL BE SUPPORTED ON NOT

GASKET SIMILAR TO 3M-1202 OR APPROVED EQUAL.

- MORE THAN 6' CENTERS. VERTICAL RISERS SHALL BE SUPPORTED AT EACH FLOOR. FOR RECTANGULAR 4. LONGITUDINAL SEAMS DUCTWORK SHALL BE PITTSBURGH LOCK SEAMS WITH SEALING COMPOUND, EQUAL TO BENJAMIN FOSTER
- BRUSHED WITH NO. 30-02 AND COVERED WITH APPROVED SEALING TAPE 5. RECTANGULAR DUCTWORK 18 GAUGE AND HEAVIER FILLER RODS SHALL BE IN ACCORDANCE WITH SPECIFICATIONS FOR IRON AND STEEL GAS WELDING

NO. 30-03 INSERTED INTO SEAM. ALL SEAMS SHALL BE

- 6. ALL FITTINGS SUCH AS ELBOWS, TEES, ETC., SHALL BE NO. 20 GAUGE ZINC COATED STEEL. ELBOWS SHALL BE OF FIVE (5) PIECE WELDED AIRTIGHT CONSTRUCTION. WHERE LATEST EDITION OF SMACNA DOES NOT CLEARLY ATE GAUGES AND/OR STIFFENERS TO BE USED OR, WHERE
- IACNA STANDARDS REQUIRE INTERPRETATION, THE FOLLOWING MINIMUM METAL GAUGES AND BRACING SHALL USG MAX. SIDE TRANSVERSE JOINTS AND 22 S SLIP, DRIVE SLIP, ONE INCH UP TO 12

RODS, ASTM 215; AWG A5.2

13 TO 24

1.2 MATERIALS

1"X1"X1/8" ANGLES ON 2 **FOOT CENTERS** PROVIDE TAPPING IN DUCTS FOR THERMOMETERS WHERE

**FOOT CENTERS** 

1"X1"X1/8" ANGLES ON 4

POCKET LOCK ON 8 FOOT CENTERS

- SPECIFIED. IN ADDITION, PROVIDE AN AIRTIGHT PLUGGED TAPPING LOCATED AS FOLLOWS: 1. UPSTREAM OF EACH REHEAT COIL AND VAV BOX.
- 2. DOWNSTREAM OF EACH REHEAT COIL AND VAV BOX. E. FLAT OVAL OR ROUND DUCTWORK MAY BE PROVIDED IN LIEU RECTANGULAR DUCTWORK WITH THE REINFORCEMENT FOR FLAT SIDES SAME AS SPECIFIED FOR THE RECTANGULAR DUCTWORK, AND AS PER SMACNA FLAT OVAL DUCT CONSTRUCTION STANDARDS SHOWN IN FIG. 3-6 AND AS

## SHOWN IN FIG. 3-1 AND 3-2 FOR ROUND DUCTWORK.

- A. SINGLE-WALL RECTANGULAR DUCTS AND FITTINGS. B. DOUBLE-WALL RECTANGULAR DUCTS AND FITTINGS. 1. FIBROUS-GLASS OR FLEXIBLE ELASTOMERIC DUCT LINER
- FOR INTERSTITIAL INSULATION. 2. PERFORATED INNER DUCT. C. SINGLE-WALL ROUND AND FLAT-OVAL DUCTS AND FITTINGS.

D. DOUBLE-WALL ROUND AND FLAT-OVAL DUCTS AND FITTINGS.

- 1. FIBROUS-GLASS OR FLEXIBLE ELASTOMERIC DUCT LINER FOR INTERSTITIAL INSULATION.
- 2. PERFORATED INNER DUCT.
- E. SHEET METAL MATERIALS:
- 2. PVC-COATED, GALVANIZED SHEET STEEL 3. CARBON-STEEL SHEETS.

4. STAINLESS-STEEL SHEETS.

GALVANIZED SHEET STEEL

- ALUMINUM SHEETS. FACTORY-APPLIED ANTI-MICROBIAL COATING.
- 1. FIBROUS GLASS, TYPE I, FLEXIBLE a. WITH ANTI-MICROBIAL EROSION-RESISTANT

4. FLANGED JOINT SEALANT.

COATING. 2. FLEXIBLE ELASTOMERIC.

NATURAL FIBER.

F. DUCT LINER:

- G. SEALANT MATERIALS: 1. TWO-PART TAPE SEALING SYSTEM.
- 2. WATER-BASED JOINT AND SEAM SEALANT. SOLVENT-BASED JOINT AND SEAM SEALANT.
- FLANGE GASKETS. 6. ROUND DUCT JOINT O-RING SEALS.

- 1.3 SEISMIC-RESTRAINT DEVICES
- A. CHANNEL SUPPORT SYSTEM. B. STAINLESS-STEEL RESTRAINT CABLES.
- C. HANGER ROD STIFFENER: STEEL TUBE OR STEEL SLOTTED-SUPPORT-SYSTEM SLEEVE WITH INTERNALLY BOLTED CONNECTIONS OR REINFORCING STEEL ANGLE

- CLAMPED TO HANGER ROD.

#### 1.4 DUCT CLEANING

- A. CLEAN EXISTING DUCT SYSTEM(S) BEFORE TESTING, ADJUSTING, AND BALANCING.
- B. CLEAN THE FOLLOWING ITEMS:
- 1. AIR OUTLETS AND INLETS.
- 2. SUPPLY, RETURN, AND EXHAUST FANS.
- 3. AIR-HANDLING UNITS.
- 4. COILS AND RELATED COMPONENTS.
- 5. RETURN-AIR DUCTS, DAMPERS, ACTUATORS, AND TURNING VANES.

7. DEDICATED EXHAUST AND VENTILATION COMPONENTS

- 6. SUPPLY-AIR DUCTS, DAMPERS, ACTUATORS, AND TURNING VANES.
- AND MAKEUP AIR SYSTEMS. 1.5 DUCT SCHEDULE

#### A. ALL DUCTS SHALL BE GALVANIZED STEEL EXCEPT AS FOLLOWS:

MOIST ENVIRONMENT DUCT MATERIAL: ALUMINUM.

## END OF SECTION 233113

SHEET METAL WORK

- A. EXCEPT AS OTHERWISE SHOWN OR NOTED, ALL DUCTWORK AND OTHER SHEET METAL WORK SHALL BE GALVANIZED SHEET STEEL AND SHALL BE INSTALLED IN ACCORDANCE WITH THE LATEST EDITION OF SHEET METAL AND AIR CONDITIONING CONTRACTORS NATIONAL ASSOCIATION, INC. DUCT CONSTRUCTION STANDARDS, PRESSURE CLASSIFICATION 2 IN.
- B. DUCTWORK STATIC PRESSURE CLASSIFICATION: a. 2 IN OF W.G. UP TO 2 IN OF W.G.
- b. 6 IN OF W.G. ABOVE 2 IN & UP TO 6 IN WG SEALING OF DUCTWORK SHALL COMPLY WITH SECTION 603.9 OF THE MECHANICAL CODE OF MASSACHUSETTS STATE OR IN MASSACHUSETTS STATE, THE MASSACHUSETTS STATE CONSTRUCTION CODES.
- AT OTHER END. FOR INSULATED DUCTS, QUADRANTS MOUNTED ON COLLAR TO CLEAR INSULATION. INSTALL WITH LEVERS ACCESSIBLE.

VOLUME DAMPERS: GALVANIZED STEEL, PER SMACNA "LOW

VELOCITY MANUAL," EXCEPT PROVIDE BEARING AT ONE END OF

DAMPER ROD AND QUADRANT, WITH LEVER AND LOCKSCREW

- ACCESS DOORS: INSULATED OR UNINSULATED, SAME AS DUCT PROVIDE MINIMUM 20 IN. X 20 IN. (OR EQUIVALENT) ON ALL DUCTS, UNLESS OTHERWISE APPROVED, AT FIRE DAMPERS, AND AT ALL DUCT ACCESSORIES SUCH AS HUMIDIFIERS,
- 2) ACCESS DOORS SHALL BE LOCATED AT THE BOTTOM OF THE DUCT OR ON THE SIDE, AND NOT MORE THAN 16 INCHES FROM THE DUCT ACCESSORY THAT IT SERVES (FIRE DAMPER, FSD, ETC.).

3) WHERE DUCT SIZE DOES NOT PERMIT A 20 IN. X 20 IN. (OR

EQUIVALENT AREA) ACCESS DOOR. THE ACCESS DOOR

SHALL BE FABRICATED OF AN AREA EQUIVALENT TO A 20 IN. X

DUCT SMOKE DETECTORS, AUTO DAMPERS, AND LOUVERS.

- 20 IN. WITH THE SMALLER DIMENSION BEING 2 INCHES SMALLER THAN THE DUCT SIZE WHERE IT WILL BE LOCATED, AND LOCATED NOT LESS THAN 1" FROM ANY DUCT EDGE. 4) FOR DUCTS WHICH LARGEST DIMENSION IS 12 INCHES (WIDTH AND OR HEIGHT), IT IS PERMISSIBLE TO PROVIDE A 10 IN. X 10
- BOTTOM OR THE SIDE OF THE DUCT. THAN 5) ALL ACCESS DOORS TO BE HINGED, WITH LATCH SIMILAR TO VENTLOCK NO. 100.

IN. (OR EQUIVALENT AREA) ACCESS DOOR LOCATED AT THE

30 OZ PER SQ YD WITH SEWED AND CEMENTED SEAMS, SIMILAR TO VENT FABRICS. PROVIDE WITH METAL COLLARS. ALLOW MINIMUM MOVEMENT OF 1 IN. G. TURNING VANES: GALVANIZED STEEL SMALL DOUBLE-THICKNESS VANES WITH 2 IN. INSIDE RADIUS.

H. FIRE DAMPERS: UL LISTED, GALVANIZED STEEL

CONSTRUCTION, MULTIBLADED TYPE, SPRING LOADED,

EQUIPPED WITH FUSIBLE LINK, CONFORMING TO NFPA

F. FLEXIBLE CONNECTIONS: NEOPRENE-COATED GLASS FABRIC,

STANDARD 90A AND APPROVED BY MASSACHUSETTS STATE BOARD OF STANDARDS AND APPEALS FOR MASSACHUSETTS STATE CAL-100-65-5M. SIMILAR TO AIR BALANCE MODEL 319-P. RATED AS REQUIRED. SEE INSTALLATION ON DRAWING.

ALUMINUM FABRICATED ONE GAGE LARGER THAN GALVANIZED

FOR THE SAME PRESSURE CLASSIFICATION. THESE DUCTS

INCLUDE SHOWERS, OUTDOOR AIR INTAKE, HUMIDIFIERS, ETC.

J. ALL DUCT DIMENSIONS INDICATED ON PLANS ARE INSIDE CLEAR

I. DUCTWORK FOR AREAS WITH HIGH HUMIDITY SHALL BE

DIMENSIONS. K. AUTOMATIC DAMPERS: COMPLETE WITH LINKAGE AND ELECTRIC OPERATOR. OPPOSED BLADE DAMPER OR GALVANIZED STEEL MIN. 4 IN., MAX. 8 IN. WIDE WITH COMPRESSIBLE EDGE SEALS TO PREVENT LEAKAGE. FACTORY-ASSEMBLE STEEL LINKAGE AND SHAFT WITH NYLON OR OIL-IMPREGNATED BRONZE BEARINGS. MOTOR WITH SUFFICIENT POWER TO LIMIT LEAKAGE TO 10 CFM PER SQ FT. LINKAGE TO WITHSTAND LOAD EQUAL TO TWICE

MOUNTED IN WELDED STEEL CHANNEL FRAME.

THE FACTORY AT THE TIME OF FABRICATION.

OPENING TO RECEIVE FRAME.

MAXIMUM OPERATING FORCE WITHOUT DEFLECTION. DAMPER

L. WIRE MESH SCREEN (WMS): NO. 16 USSG, 3/4 SQUARE MESH, 1 IN.

M. COMBINATION FIRE AND SMOKE DAMPERS: UL LISTED.

GALVANIZED STEEL CONSTRUCTION MULTI-BLADED TYPE. BLADES

SHALL BE AIRFOIL SHAPED, DOUBLE SKIN, SINGLE PIECE

CONSTRUCTION, EQUIPPED WITH FUSIBLE LINK CONFORMING TO

NFPA STANDARD 90A, 92A & 92B, AND COMPLY WITH LATEST

STANDARD UL555 AND UL555S WITH LEAKAGE CLASS I SMOKE

DAMPERS, BLADE SEALS. SIMILAR TO RUSKIN MODEL FSD 60,

MASSACHUSETTS STATE BSA LISTING# 176-82-SM. ACTUATOR

SHALL BE ELECTRICALLY POWERED, 120 V/1 PH, AND MOUNTED IN

WIDE GALVANIZED STEEL ENCLOSING FRAME. FLANGED DUCT

#### 2. NOISE CONTROL

- A. ALL ROOM NC LEVELS SHALL BE 35 OR LESS.
- B. PROVIDE SOUND LINING FOR THE FOLLOWING DUCTWORK:
- 1) ALL DUCTWORK WITHIN MECHANICAL ROOMS AND NOT LESS THAN 20 FT ON EACH SIDE OF ALL FANS AND AC UNITS.
- 2) AIR TRANSFER DUCTS.
- 3) DOWNSTREAM OF ALL VARIABLE AIR VOLUME AND CONSTANT
- 4) ALL MIXED AIR PLENUMS, EXCEPT WHERE MOISTURE

5) FULL EXTENT OF SUPPLY DUCTS SERVING CONFERENCE

CARRYOVER FROM OUTDOOR AIR LOUVER WILL OCCUR.

VOLUME BOXES FOR A MINIMUM OF 15 FT.

6) ALL EXPOSED INTERIOR SUPPLY DUCTWORK

7) ALSO WHERE NOTED ON A DRAWING.

- C. SOUND LINING IN DUCTWORK: FIBROUS GLASS, MINIMUM 3 LB DENSITY, 1 IN. THICKNESS, MAXIMUM 0.25 K FACTOR AT 75 DEG F MEAN TEMPERATURE WITH ACRYLIC COATED FINISH FACTORY APPLIED EDGE COATING AND STENCILED IN ACCORDANCE WITH NFPA 90. FLAMESPREAD SHALL BE A MAXIMUM OF 25. LINING SHALL NOT SUPPORT MICROBIAL GROWTH AND SHALL BE TESTED IN ACCORDANCE WITH ASTM C 1071 AND ASTM G21/G22. SIMILAR TO MANVILLE PERMACOTE
- D. ALL SOUND LINING, ADHESIVES, FACES AND ACCESSORIES TO BE APPLIED IN ACCORDANCE WITH MANUFACTURER'S RECOMMENDATIONS, EXCEPT AS OTHERWISE NOTED.

THERMOSTATIC CONTROL NOTES

LINA COUSTIC.

A. 6.4.3.1.1 GENERAL THE SUPPLY OF HEATING AND COOLING ENERGY TO EACH ZONE SHALL BE INDIVIDUALLY CONTROLLED BY THERMOSTATIC CONTROLS RESPONDING TO TEMPERATURE WITHIN THE ZONE. FOR THE PURPOSES OF THIS SECTION, A DWELLING UNIT SHALL BE PERMITTED TO BE CONSIDERED A SINGLE ZONE.

#### B. 6.4.3.1.2 DEAD BAND WHERE USED TO CONTROL BOTH HEATING AND COOLING,

D. 6.4.3.3 OFF-HOUR CONTROLS

FOLLOWING:

UP TO TWO HOURS.

TO 30 MINUTES.

CONFIGURED TO PROVIDE A TEMPERATURE RANGE OR DEAD BAND OF AT LEAST 5°F WITHIN WHICH THE SUPPLY OF HEATING AND COOLING ENERGY TO THE ZONE IS SHUT OFF OR REDUCED TO A C. 6.4.3.2 SET-POINT OVERLAP RESTRICTION

WHERE HEATING AND COOLING TO A ZONE ARE CONTROLLED BY

SEPARATE ZONE THERMOSTATIC CONTROLS LOCATED WITHIN THE

ZONE. MEANS (SUCH AS LIMIT SWITCHES: MECHANICAL STOPS: OR.

FOR DDC SYSTEMS, SOFTWARE PROGRAMMING) SHALL BE PROVIDED

ZONE THERMOSTATIC CONTROLS SHALL BE CAPABLE OF AND

## TO PREVENT THE HEATING SET POINT FROM EXCEEDING COOLING SET POINT, MINUS ANY APPLICABLE PROPORTIONAL BAND.

SECTIONS 6.4.3.3.1 THROUGH 6.4.3.3.5. E. 6.4.3.3.1 AUTOMATIC SHUTDOWN

HVAC SYSTEMS SHALL HAVE THE OFF-HOUR CONTROLS REQUIRED BY

HVAC SYSTEMS SHALL BE EQUIPPED WITH AT LEAST ONE OF THE

a. CONTROLS THAT CAN START AND STOP THE SYSTEM UNDER

DIFFERENT TIME SCHEDULES FOR SEVEN DIFFERENT DAY TYPES PER

b. AN OCCUPANCY SENSOR THAT IS CAPABLE OF SHUTTING

THE SYSTEM OFF WHEN NO OCCUPANT IS SENSED FOR A PERIOD OF UP

c. A MANUALLY OPERATED TIMER CAPABLE OF BEING ADJUSTED TO

OPERATE THE SYSTEM FOR UP TO TWO HOURS.

PREVENT HIGH SPACE HUMIDITY LEVELS.

WEEK, ARE CAPABLE OF RETAINING PROGRAMMING AND TIME SETTING DURING LOSS OF POWER FOR A PERIOD OF AT LEAST TEN HOURS. AND INCLUDE AN ACCESSIBLE MANUAL OVERRIDE OR EQUIVALENT FUNCTION THAT ALLOWS TEMPORARY OPERATION OF THE SYSTEM FOR

d. AN INTERLOCK TO A SECURITY SYSTEM THAT SHUTS THE SYSTEM OFF WHEN THE SECURITY SYSTEM IS ACTIVATED. F. 6.4.3.3.2 SETBACK CONTROLS HEATING SYSTEMS SHALL BE EQUIPPED WITH CONTROLS CAPABLE OF AND CONFIGURED TO AUTOMATICALLY RESTART AND TEMPORARILY OPERATE THE SYSTEM AS REQUIRED TO MAINTAIN ZONE TEMPERATURES ABOVE AN ADJUSTABLE HEATING SET POINT AT LEAST 10°F BELOW THE OCCUPIED HEATING SET POINT COOLING SYSTEMS SHALL BE EQUIPPED WITH CONTROLS CAPABLE OF

AND CONFIGURED TO AUTOMATICALLY RESTART AND TEMPORARILY

OPERATE THE MECHANICAL COOLING SYSTEM AS REQUIRED TO

MAINTAIN ZONE TEMPERATURES BELOW AN ADJUSTABLE COOLING SET

POINT AT LEAST 5°F ABOVE THE OCCUPIED COOLING SET POINT OR TO

CONSULTANTS (ENGINEER):

**NEARBY ENGINEERS** 

382 NE 191ST STREET SUITE 49674,

MIAMI, FL 33179

PH-914.257.3455

WWW.NY-ENGINEERS.COM

CONTRACTOR'S NOTES VRITTEN DIMENSIONS HOLD PREFERENCE OVER SCALED DIMENSIONS. DO NOT SCALE THE DRAWINGS. THE CONTRACTORS MUST VISIT IOB SITE TO VERIEY ALL EXISTING CONDITIONS AND DIMENSIONS BEFORE SUBMITTING BIDS. REPORT ANY DISCREPANCIES OF AN CONDITIONS WHICH MAY INTERFERE WITH THE PROPER EXECUTION OF, THE CONTRACT TO THE TENANT'S

REPRESENTATIVE, REPORT DISCREPANCIES DURING

CONSTRUCTION. CHANGE ORDERS NEED TO BE

APPROVED BY TOWNSQUARE CONSTRUCTION

MANAGER FOR ISSUES ARISING FROM THE FIELD

CONDITIONS OR CONFLICTS BETWEEN THE PLANS AND

BIDDING PROCESS AND BEFORE START OF

THE EXISTING CONDITIONS PRIOR TO THE

OMMENCEMENT OF WORK


ISSUE 10.31.24 LL/CLIENT REVIEW SET

11.22.24 BD SUBMISSION

11.15.24 LL/CLIENT REVIEW SET

\ 11.15.24 CLIENT COMMENTS DATE REVISION

**MECHANICAL NOTES & SPECIFICATIONS** 

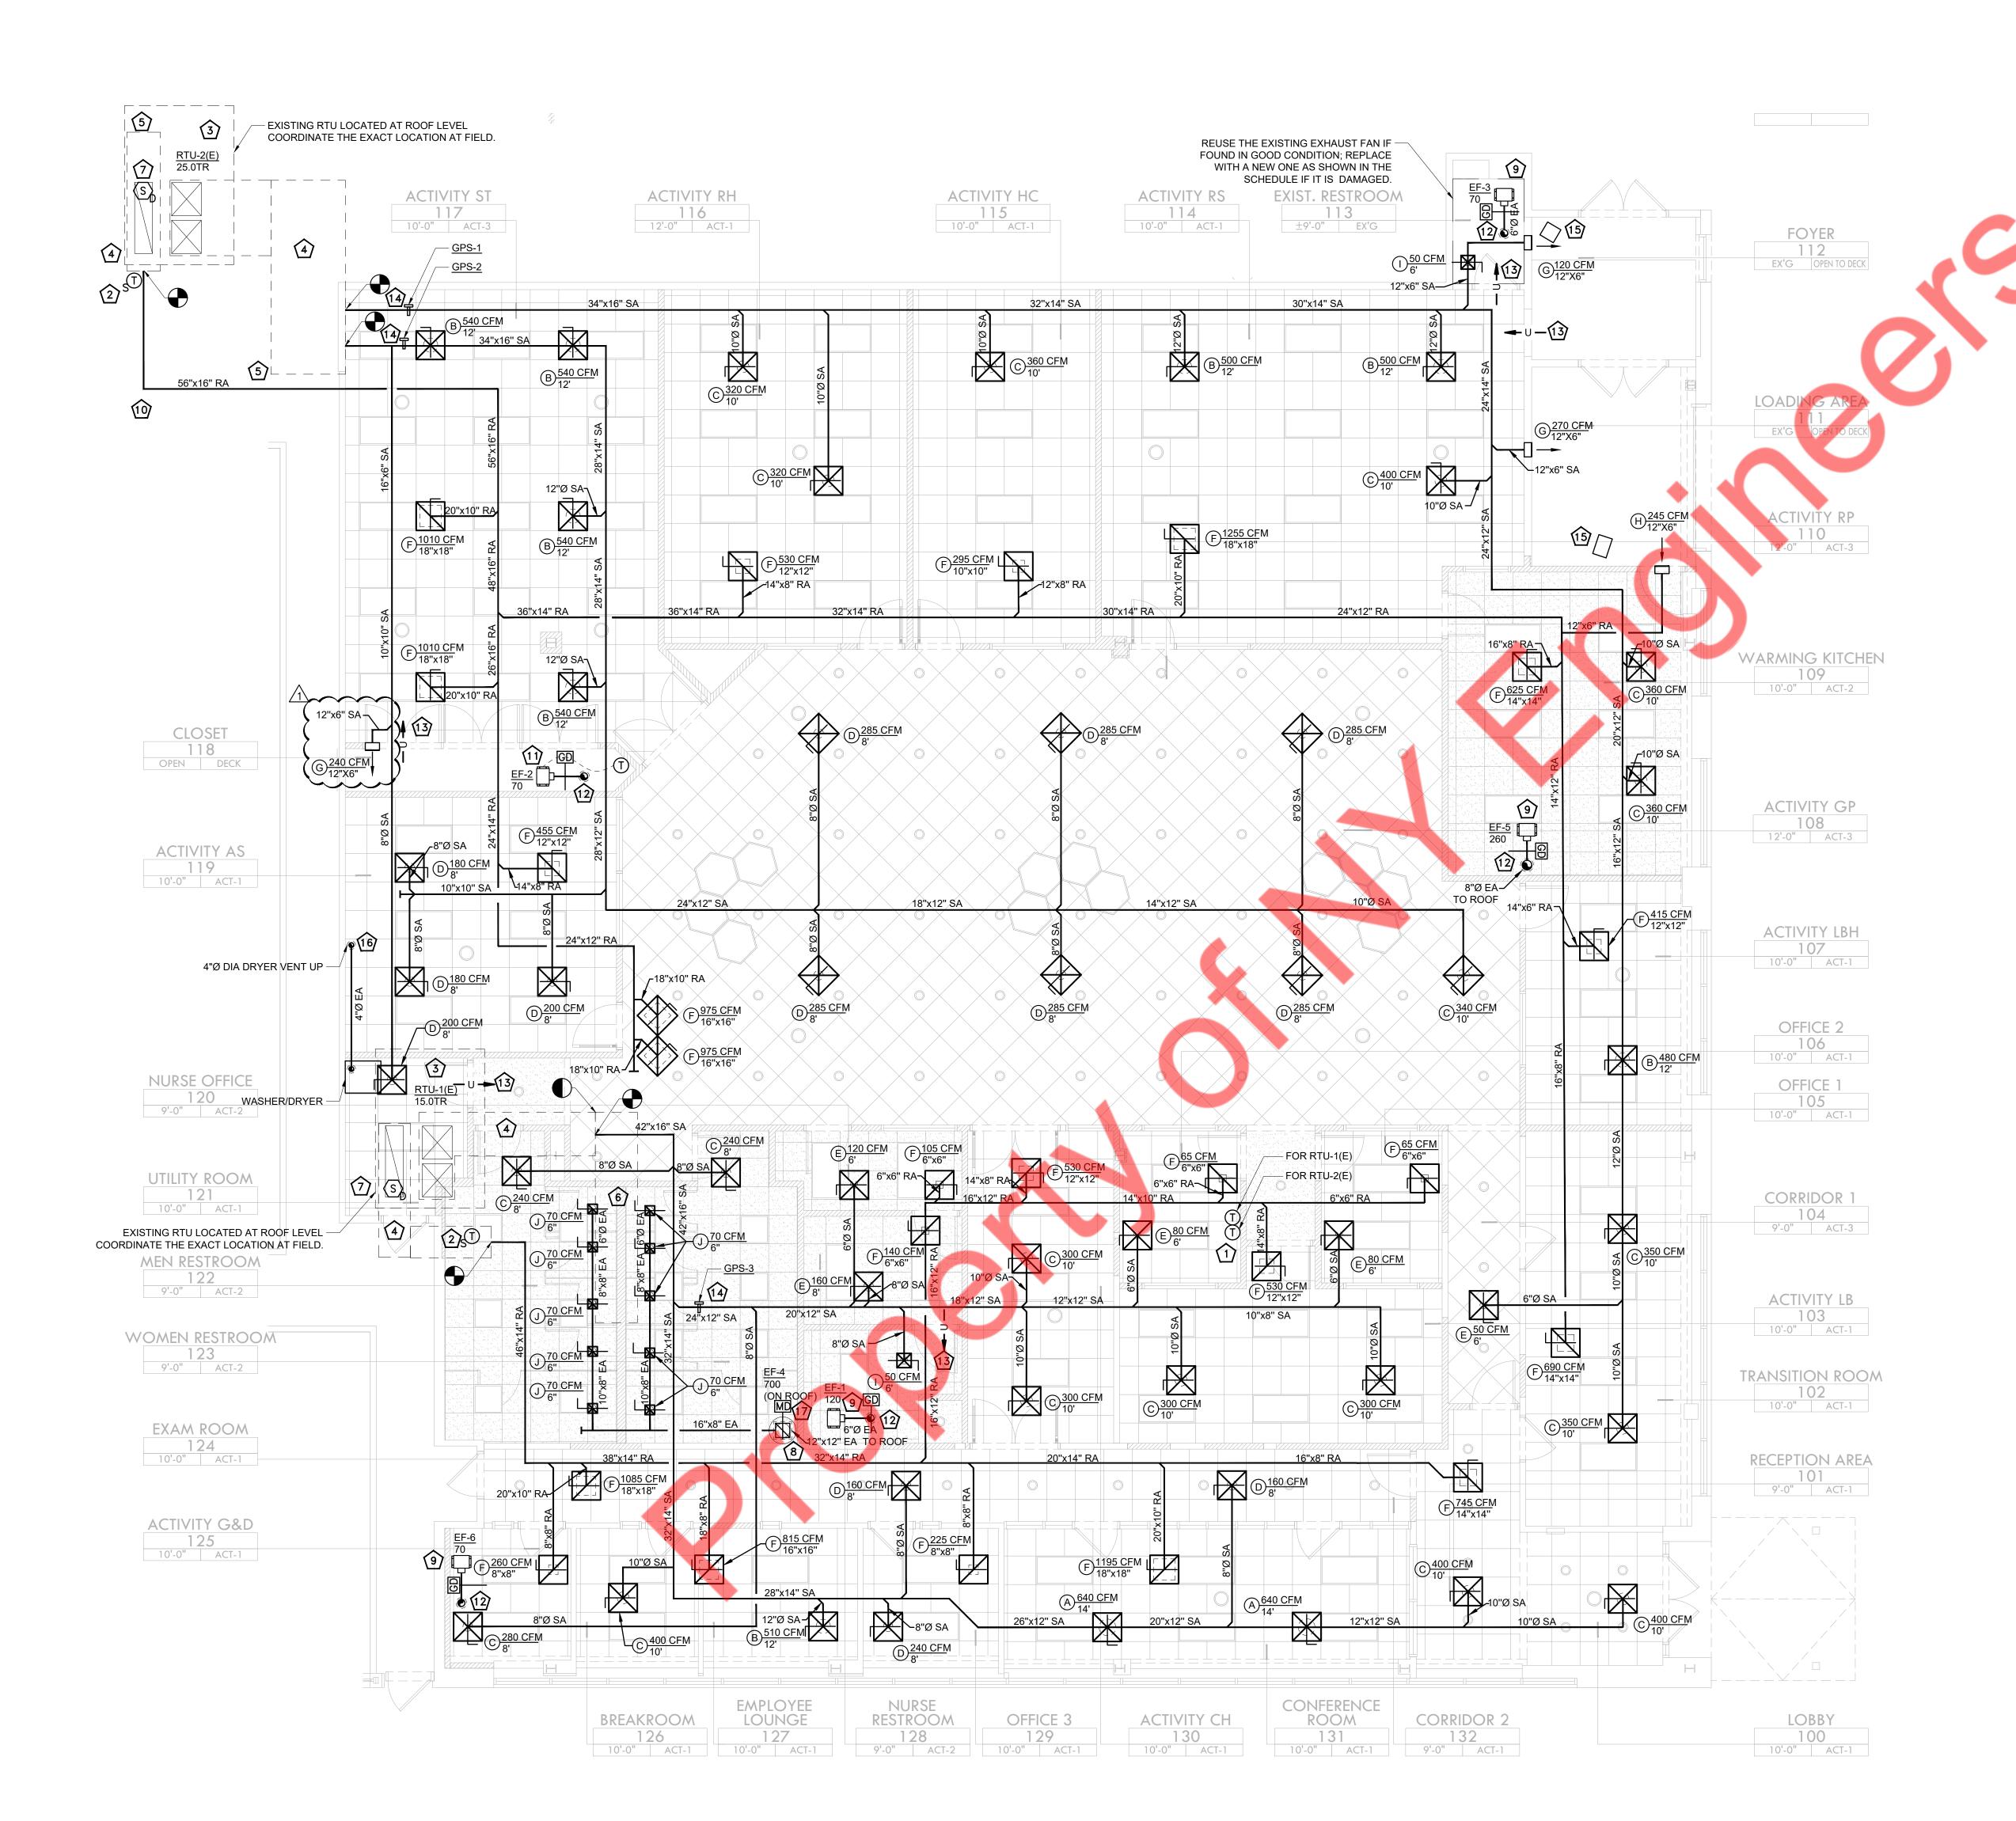

- A. DUCTWORK SHOWN ON PLAN ARE SCHEMATIC ONLY. CONTRACTOR SHALL COORDINATE WITH OTHER TRADES FOR PIPING AND DUCTWORK ROUTING. OFFEST AND RUN PIPING, DUCTWORK INSIDE THE STRUCTURE IF REQUIRED. PROVIDE ANY EXTRA PIPING, DUCTWORK, FITTINGS, INSULATIONS AND OTHER ACCESSORIES IN ORDER TO COMPLETE THE INSTALLATION.
- B. EQUIPMENT SIZES, DIMENSIONS AND REQUIRED CONNECTIONS SHALL BE VERIFIED WITH THE ACTUAL EQUIPMENT SELECTED VENDOR DRAWINGS BEFORE FABRICATION OF DUCTWORK,
- PIPING ETC.
  C. DUCT SIZES SHOWN ON PLANS ARE CLEAR INSIDE AIR STREAM DIMENSIONS.
- D. CONTRACTOR SHALL COORDINATE ALL ELECTRICAL REQUIREMENTS FOR ALL HVAC BASED ON ACTUAL EQUIPMENT SELECTED PRIOR TO INSTALLATION.

  E. CONTRACTOR SHALL COORDINATE EQUIPMENT WEIGHTS AND SUPPORTS BASED ON ACTUAL
- EQUIPMENT SELECTED.

  F. MOUNT DUCTWORK AS HIGH AS POSSIBLE.

  C. TEST AND BALANCE AIR SYSTEMS, PROVIDE REPORT TO C.C. AND OWNER, CONTRACTOR SHALL
- G. TEST AND BALANCE AIR SYSTEMS. PROVIDE REPORT TO G.C AND OWNER. CONTRACTOR SHALL BALANCE EACH DEVICE WITH THE CFM SHOWN ON PLAN.
   H. PROVIDE DUCT INSULATION REQUIRED AS PER THE CODE MINIMUM.
- I. PROVIDE FIRE OR FIRE+SMOKE DAMPER WHEREVER DUCTS ARE CROSSING FIRE/SMOKE RATED WALLS/BARRIERS. COORDINATE WITH ARCHITECTURAL DRAWINGS FOR FIRE RATINGS OF THE
- WALLS/BARRIERS. COORDINATE WITH ARCHITECTURAL DRAWINGS FOR FIRE RATINGS OF WALLS.

  J. 2" DOOR UNDER CUT TO BE PROVIDED FOR ALL THE DOORS WHEREVER SHOWN ON PLAN.
- K. DUCT GOING UP TO ROOF TO BE TERMINATED WITH APPROVED TERMINATION CAP.
   L. NEW CEILING MOUNTED SUPPLY AIR DIFFUSER/GRILLE, RETURN AIR DIFFUSER/GRILLE, EXHAUST DIFFUSER/GRILLE INCLUDING ALL DUCTWORK, CONTROL DAMPERS, HANGERS, SUPPORTS, ETC.
- AND BALANCE THE CFM AS SHOWN ON PLAN.

  M. NEW SUPPLY & RETURN DUCTWORK TO SPACE. CONTRACTOR TO ACOUSTICALLY LINE THE
- FIRST 10' OF BOTH SUPPLY & RETURN MAIN DUCTS.

  N. PROVIDE CABLE OPERATED DAMPER IN INACCESSIBLE CEILINGS.

## KEYED NOTES: (#)

 LOCATION OF DIGITAL THERMOSTAT CONTROL. INSTALL AND WIRE NEW 7-DAY PROGRAMMABLE THERMOSTAT. COORDINATE EXACT LOCATION WITH ARCHITECT AND OWNER PRIOR TO ROUGH-IN. PROVIDE LOCKABLE COVER.

. PROVIDE REMOTE TEMP./HUMIDITY SENSOR MOUNTED IN RETURN DUCT AND WIRE BACK TO

CONDITION REPAIR/REPLACE ANY ACCESSORIES AS REQUIRED TO PROVIDE A FULLY FUNCTIONING UNIT. VERIFY IN FIELD PRIOR TO BID. ENSURE UNIT OA INTAKE IS BALANCED AS

- T-STAT LOCATED IN OFFICE 2.

  3. EXISTING MECHANICAL ROOF TOP UNIT TO REMAIN ALONG WITH ALL ASSOCIATED ACCESSORIES, ALL OTHER SENSORS & CONTROLS. CLEAN & REFURBISH TO LIKE NEW
- SHOWN IN THE AIR BALANCING SCHEDULE ON SHEET M201.

  4. EXISTING DUCTWORK TO REMAIN SAME. CLEAN AND REFURBISH TO LIKE NEW CONDITION. REPAIR/ REPLACE IF REQUIRED.
- 5. PATCH AND SEAL THE DUCTWORK AIR TIGHT REPAIR/REPLACE INSULATION AS REQUIRED.
- REMOVE AND SCRAP THE EXISTING DUCTWORK.
   CONTRACTOR SHALL CLEAN AND REFURBISH EXISTING DUCT SMOKE DETECTOR IN RETURN DUCTWORK TO LIKE NEW CONDITION. ENSURE SMOKE DETECTOR IS IN GOOD WORKING
- ORDER. PROVIDE NEW IF REQUIRED.

  8. ROUTE EXHAUST 12"X12" DUCT UP TO THE ROOF & CONNECT TO ROOF MOUNTED EXHAUST FAN EF-4. CONTRACTOR TO FIELD VERIFY FIRE RATING OF ROOF. PROVIDE FIRE DAMPER AT
- 9. PROVIDE AND INSTALL NEW CEILING MOUNTED EXHAUST FAN ASSEMBLY. INCLUDING ALL DUCTWORK, SUPPORTS, CONTROLS, ETC. SEE DETAILS.

ROOF PENETRATION AS/IF REQUIRED BY LOCAL CODES.

- 10. INSTALL NEW DUCTS AS SHOWN IN THE PLAN. FIELD VERIFY & COORDINATE WITH LL FOR THE ROUTING OUTSIDE OF THE TENANT SPACE BEFORE THE BASE BID.
- EXHAUST FAN WITH T-STAT AND SET CUT ON TEMP TO 80°F.

  12. EXHAUST AIR DUCT UP THROUGH ROOF. TERMINATE ON ROOF WITH GOOSENECK AND BIRD

11. CEILING MOUNTED EXHAUST FAN INCLUDING ALL DUCTWORK, SUPPORTS ETC. INTERCONNECT

- SCREEN.
- 14. PROVIDE ELECTRICAL POWER FOR EACH GPS, COORDINATE WITH ELECTRICAL CONTRACTOR.

13. PROVIDE 2" DOOR UNDERCUT FOR AIR TRANSFER. COORDINATE WITH ARCHITECT.

- 15. EXISTING HEATER TO REMAIN SAME. COORDINATE WITH ARCH FOR THE FINAL REQUIREMENT.

  16. Ø4" DRYER VENT UP TO ROOF AS SHOWN. TERMINATE IN ACCORDANCE WITH
- MANUFACTURERS RECOMMENDATIONS AND SECTION 504 OF THE 2021 INTERNATIONAL MECHANICAL CODE. SCREEN SHALL NOT BE INSTALLED IN THE DUCT TERMINATION. FIRE/SMOKE DAMPERS & ANY SIMILAR DEVICE THAT WILL OBSTRUCT THE EXHAUST FLOW SHALL BE PROHIBITED IN EXHAUST DUCT.
- 17. INTERLOCK MOTORIZED DAMPER WITH EF-4.

CONSULTANTS (ENGINEER):

# NY ENGINEERS

NEARBY ENGINEERS
382 NE 191ST STREET SUITE 49674,
MIAMI, FL 33179
PH-914.257.3455
WWW.NY-ENGINEERS.COM

CONTRACTOR'S NOTES:

WRITTEN DIMENSIONS HOLD PREFERENCE OVER SCALED DIMENSIONS. DO NOT SCALE THE DRAWINGS. THE CONTRACTORS MUST VISIT JOB SITE TO VERIFY ALL EXISTING CONDITIONS AND DIMENSIONS BEFORE SUBMITTING BIDS. REPORT ANY DISCREPANCIES OF ANY CONDITIONS WHICH MAY INTERFERE WITH THE PROPER EXECUTION OF, THE CONTRACT TO THE TENANT'S REPRESENTATIVE. REPORT DISCREPANCIES DURING BIDDING PROCESS AND BEFORE START OF CONSTRUCTION. CHANGE ORDERS NEED TO BE APPROVED BY TOWNSQUARE CONSTRUCTION MANAGER FOR ISSUES ARISING FROM THE FIELD

DATE ISSUE
10.31.24 LL/CLIENT REVIEW SET
11.15.24 LL/CLIENT REVIEW SET
11.22.24 BD SUBMISSION

CONDITIONS OR CONFLICTS BETWEEN THE PLANS AND

THE EXISTING CONDITIONS PRIOR TO THE

COMMENCEMENT OF WORK.

11.15.24 CLIENT COMMENTS


DATE REVISION



TITI F:

MECHANICAL FLOOR PLAN

SHEET NUMBER:

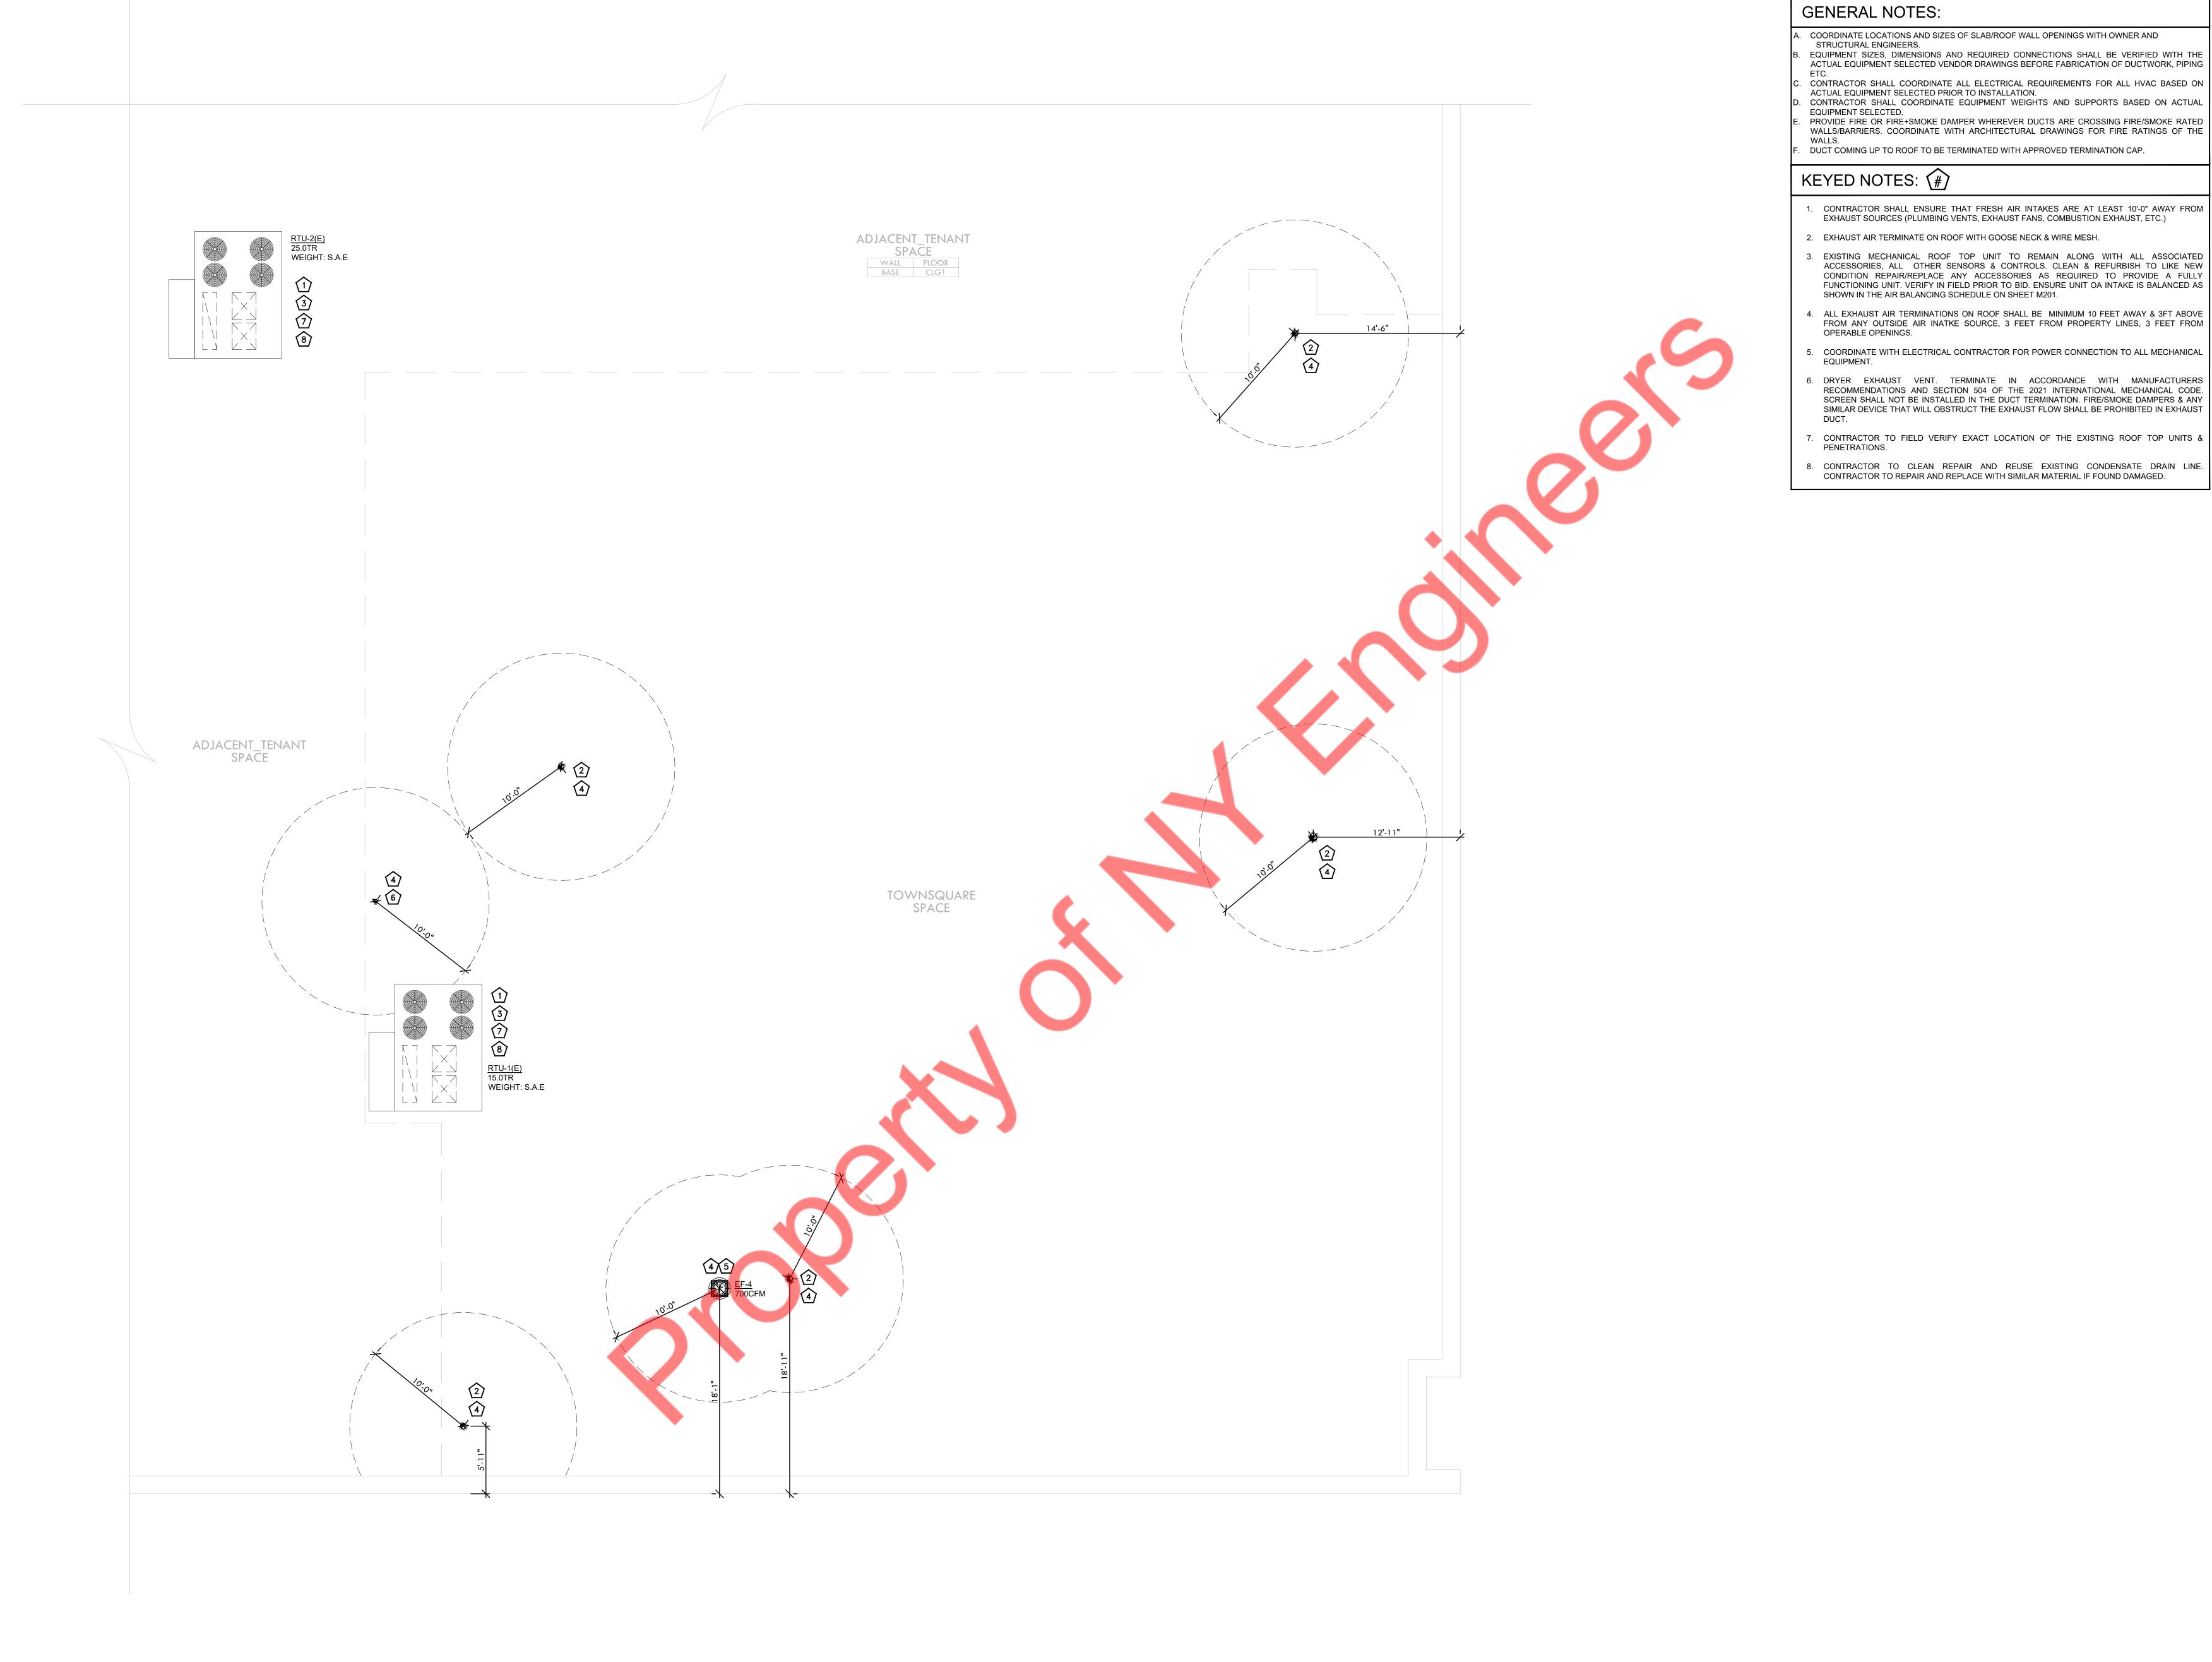

. COORDINATE LOCATIONS AND SIZES OF SLAB/ROOF WALL OPENINGS WITH OWNER AND

STRUCTURAL ENGINEERS. EQUIPMENT SIZES, DIMENSIONS AND REQUIRED CONNECTIONS SHALL BE VERIFIED WITH THE ACTUAL EQUIPMENT SELECTED VENDOR DRAWINGS BEFORE FABRICATION OF DUCTWORK, PIPING

CONTRACTOR SHALL COORDINATE ALL ELECTRICAL REQUIREMENTS FOR ALL HVAC BASED ON ACTUAL EQUIPMENT SELECTED PRIOR TO INSTALLATION.

CONTRACTOR SHALL COORDINATE EQUIPMENT WEIGHTS AND SUPPORTS BASED ON ACTUAL PROVIDE FIRE OR FIRE+SMOKE DAMPER WHEREVER DUCTS ARE CROSSING FIRE/SMOKE RATED WALLS/BARRIERS. COORDINATE WITH ARCHITECTURAL DRAWINGS FOR FIRE RATINGS OF THE

DUCT COMING UP TO ROOF TO BE TERMINATED WITH APPROVED TERMINATION CAP.

# KEYED NOTES: (#)

- 1. CONTRACTOR SHALL ENSURE THAT FRESH AIR INTAKES ARE AT LEAST 10'-0" AWAY FROM EXHAUST SOURCES (PLUMBING VENTS, EXHAUST FANS, COMBUSTION EXHAUST, ETC.)
- 2. EXHAUST AIR TERMINATE ON ROOF WITH GOOSE NECK & WIRE MESH. 3. EXISTING MECHANICAL ROOF TOP UNIT TO REMAIN ALONG WITH ALL ASSOCIATED ACCESSORIES, ALL OTHER SENSORS & CONTROLS. CLEAN & REFURBISH TO LIKE NEW
- 4. ALL EXHAUST AIR TERMINATIONS ON ROOF SHALL BE MINIMUM 10 FEET AWAY & 3FT ABOVE FROM ANY OUTSIDE AIR INATKE SOURCE, 3 FEET FROM PROPERTY LINES, 3 FEET FROM
- 5. COORDINATE WITH ELECTRICAL CONTRACTOR FOR POWER CONNECTION TO ALL MECHANICAL
- 6. DRYER EXHAUST VENT. TERMINATE IN ACCORDANCE WITH MANUFACTURERS RECOMMENDATIONS AND SECTION 504 OF THE 2021 INTERNATIONAL MECHANICAL CODE. SCREEN SHALL NOT BE INSTALLED IN THE DUCT TERMINATION. FIRE/SMOKE DAMPERS & ANY SIMILAR DEVICE THAT WILL OBSTRUCT THE EXHAUST FLOW SHALL BE PROHIBITED IN EXHAUST
- 7. CONTRACTOR TO FIELD VERIFY EXACT LOCATION OF THE EXISTING ROOF TOP UNITS & PENETRATIONS.
- 8. CONTRACTOR TO CLEAN REPAIR AND REUSE EXISTING CONDENSATE DRAIN LINE. CONTRACTOR TO REPAIR AND REPLACE WITH SIMILAR MATERIAL IF FOUND DAMAGED.

CONSULTANTS (ENGINEER):

**NEARBY ENGINEERS** 382 NE 191ST STREET SUITE 49674,

MIAMI, FL 33179 PH-914.257.3455 WWW.NY-ENGINEERS.COM

CONTRACTOR'S NOTES: DIMENSIONS. DO NOT SCALE THE DRAWINGS. THE CONTRACTORS MUST VISIT JOB SITE TO VERIFY ALL EXISTING CONDITIONS AND DIMENSIONS BEFORE SUBMITTING BIDS. REPORT ANY DISCREPANCIES OF ANY CONDITIONS WHICH MAY INTERFERE WITH THE PROPER EXECUTION OF, THE CONTRACT TO THE TENANT'S REPRESENTATIVE. REPORT DISCREPANCIES DURING BIDDING PROCESS AND BEFORE START OF CONSTRUCTION. CHANGE ORDERS NEED TO BE APPROVED BY TOWNSQUARE CONSTRUCTION MANAGER FOR ISSUES ARISING FROM THE FIELD CONDITIONS OR CONFLICTS BETWEEN THE PLANS AND

10.31.24 LL/CLIENT REVIEW SET 11.15.24 LL/CLIENT REVIEW SET

11.22.24 BD SUBMISSION

THE EXISTING CONDITIONS PRIOR TO THE

COMMENCEMENT OF WORK.

11.15.24 CLIENT COMMENTS

DATE REVISION



MECHANICAL ROOF PLAN

							EX	(ISTING R	OOF TOP	UNIT SCHEDUL	E											
				SI	JPPLY FAN	(V.I.F)	G	AS HEAT	(V.I.F)				co	OLING (V.I.F)					ELECTRIC	CAL (V.I.F		
UNIT ID MANUFACTURER	MODEL	AREA SERVED	NOMINAL TONS	TOTAL	OUTSIDE	ESP	TVDE	INPUT	OUTPUT	EFFIECIENCY	TOTAL	SENSIBLE	AMBIENT	ENTERING		רבס	IEED	VOLTS	DUACE	DACA(A)		APPROX.WEIGHT LBS
		SERVED	IUNS	CFM	AIR CFM	IN OF WC	TYPE	МВН	МВН	%	МВН	МВН	DB (°F)	DB/WB(°F)	DB/WB(°F)	EEK	IEER	VOLIS	PHASE	IVICA(A)	MOCP(A)	LDS
RTU-1(E) LENNOX (SAE)	LGH180H4BM2G (SAE)	SEE PLAN	15	6000	500	1.5	NATURAL GAS	360	288	S.A.E	S.A.E	S.A.E	95	80/67	S.A.E	SVE	S.A.E	480	3	50	60	S.A.E
RTU-2(E) LENNOX (SAE)	KGA300S4BH2G (SAE)	SEE PLAN	25	10000	1520	1.5	NATURAL GAS	480	384	J.A.L	S.A.E	S.A.E	95	80/67	S.A.E	J.A.L	J.A.L	480	3	62	70	J.A.L
NOTES / ACCESSORIES - SAE	E: SAME AS EXISTING, VI	F: VERIFY IN	FIELD.																			
1 EXISTING RTUs WI	ITH ALL ACCESSORIES TO	REMAIN SA	ME AND TO	BE REUSI	ED.																	
2 CONTRACTOR TO	FIELD VERIFY IF ALL RTU	s ARE WORK	ING AT THE	IR 100% R	ATED CAPA	CITY. INFORM	TO DESIGN ENGIN	EER IF AN	Y DISCREP	ANCIES ARE FO	UND IN P	PERFORMA	NCE PRIOR	TO CONSTRU	CTION.							

3 REPLACE FILTERS, IF REQUIRED.

4 CONTRACTOR TO FIELD VERIFY EXACT LOCATION AND CONFIGURATION OF RTUS ON SITE

5 BALANCE OUTSIDE AIR DAMPER AS PER CFM SHOWN ON SCHEDULE.

6 REMOTE SENSORS SHALL BE PROVIDED IN RETURN AIR DUCT & WIRED BACK TO PROGRAMMABLE, 24 HOUR, 7 DAY, THERMOSTATS

7 RETURN AIR SMOKE DETECTOR - UNIT MOUNTED.

8 CONTRACTOR TO ENSURE THE EXISTING UNIT HAS A MINIMUM OF 1.5 IN OF WC EXTERNAL STATIC PRESSURE. IF ANY DISCREPANCY FOUND CONTACT ENGINEER BEFORE THE BASE BID.

					VENTILATION CALC	CULATION				
					MIN OUTSIDE AIR	AS PER IMC 2021				
ROOM NAME	AREA (SQ.FT.)	NUMBER OF PEOPLE/1000sq.ft AS PER IMC 2021	NUMBER OF PEOPLE AS PER IMC 2021	FINAL PEOPLE NO.	CFM/PEOPLE	CFM/SQ.FT	CALCULATED VENT CFM	ZONE EFFECTIVENESS	PROVIDED OUTSIDE AIR (OA) CFM	PROVIDED EXHAUST
					RTU-1					
Lobby & Reception area	218	30	7	6	5	0.06	43	0.8	55	0
Corridor 2	330	0	0	0	0	0.06	20	0.8	25	0
Conference room	298	50	15	10	5	0.06	68	0.8	85	0
Activity room LB	259	5	1	8	5	0.06	56	0.8	70	0
Activity room CH	224	5	1	8	5	0.06	53	0.8	70	0
Office 1	90	5	0	1	5	0.06	10	0.8	15	0
Office 2	90	5	0	1	5	0.06	10	0.8	15	0
Office 3	100	5	1	1	5	0.06	11	0.8	15	0
Nurse Office	68	5	0	1	5	0.06	9	0.8	15	0
Exam Room	84	5	0	2	5	0.06	15	0.8	20	0
Nurse Restroom	88	0	0	0	0	0	0	-	0	120
Employee Lounge	113	70	8	4	7.5	0.18	50	0.8	65	0
Break Room	90	50	5	2	5	0.12	21	0.8	30	0
Activity room G&D	83	5	0	2	5	0.06	15	0.8	20	70
Women Restroom	234	0	0	0	0	0	0	-	0	350
Men Restroom	234	0	0	0	0	0	0	-	0	350
TOTAL	2603	1-	-	46	-	-	382	-	500	890
					RTU-2					
Activity room AS	340	5	2	12	5	0.06	80	0.8	105	0
Activity room LBH	200	5	_	8	5	0.06	52	0.8	65	0
Activity room GP & RP	2085	5	10	20	5	0.06	225	0.8	285	0
Warming Kitchen	364	20	7	4	7.5	0.12	74	0.8	95	260
Loading area	152	0	0	0	0	0.12	18	0.8	25	0
Foyer	115	30	3	0	5	0.06	7	0.8	10	0
Closet	58	0	0	0	0	0.12	7	0.8	10	70
Activity room ST	712	5	4	50	5	0.06	293	0.8	370	0
Activity room RH	422	5	2	12	5	0.06	85	0.8	110	0
Activity room HC	318	5	2	6	5	0.06	49	0.8	65	0
Activity room RS	705	5	4	40	5	0.06	242	0.8	305	0
Exist. Restroom	43	0	0	0	0	0	0	-	0	70
Transition Room	323	0	0	0	0	0.12	39	0.8	50	0
Corridor 1	96	0	0	0	0	0.06	6	0.8	10	0
Utility Room	89	0	0	0	0	0.12	11	0.8	15	0
TOTAL	6022	-		152	<del>-</del>		1188		1520	400

					FAN	S									
TAC	MANULEACTURED	MODEL	LOCATION	ADEA CEDVED	FAN	PERFO	RMANCE		Į.	мото	R DATA			WEIGHT	CONTROL
TAG	MANUFACTURER	MODEL	LOCATION	AREA SERVED	CFM	ESP	<b>FAN RPM</b>	WATTS	MCA	МОР	VOLTS	PHASE	HZ	LBS	CONTROL
EF-1	GREENHECK	SP-A390-VG	SEE PLAN	NURSE RESTROOM	120	0.5	1213	26	-	-	115	1	60	25	MOTION SENSOR
EF-2	GREENHECK	SP-A390-VG	SEE PLAN	IT CLOSET	70	0.5	1172	21	-	-	115	1	60	25	ROOM THERMOSTAT
EF-3	GREENHECK	SP-A390-VG	SEE PLAN	EXISTING RESTROOM	70	0.5	1172	21	-	)-	115	1	60	25	MOTION SENSOR
EF-4	GREENHECK	G-100-VG	ROOF	MEN'S, WOMENS RESTROOM	700	0.8	1460	I	4	15	115	1	60	70	MOTION SENSOR
EF-5	GREENHECK	SQ-98-VG	SEE PLAN	WARMING KITCHEN	260	0.8	1527	1	4	15	115	1	60	50	MOTION SENSOR
EF-6	GREENHECK	SP-A390-VG	SEE PLAN	ACTIVITY G&D	70	0.5	1172	21	-	-	115	1	60	25	MOTION SENSOR
NOTES														•	

1. PROVIDE FACTORY MOUNTED AND INSTALLED DISCONNECT. PROVIDE NEMA 3R DISCONNECT FOR ROOF MOUNTED FANS.

2. PROVIDE CURB FOR ROOF MOUNTED FANS.

3. INSTALL ALL FANS AS PER MANUFACTURER RECOMMENDATIONS. 4. ALL EQUIPMENT NORMAL POWER WIRING BY ELECTRICAL CONTRACTOR. COORDINATE EXACT POWER REQUIREMENT WITH ELECTRICAL CONTRACTOR.

5. ALL DIRECT DRIVE FANS TO HAVE ECM MOTORS.

6. PROVIDE FAN WITH A BACKDRAFT DAMPER, AND SPEED CONTROLLER FOR BALANCING PURPOSE. 7. REFER TO DETAILS, PROVIDE VIBRATION ISOLATORS FAN SHALL BE MOUNTED W/SUPPORT FRAMING BY OTHERS. PROVIDE FLEXIBLE CONNECTION AT DUCT CONNECTION TO FAN.

TAGS	MODULE	NECK	CFM RANGE	MAX NC	DEFLECTION	MOUNTING TYPE	MAKE & MODEL
A	24'x24'	14'	601-800	=<25	-	CEILING	TITUS TMS
B	24'x24'	12'	401-600	=<25	-	CEILING	TITUS TMS
©	24'x24'	10'	301-400	=<25	-	CEILING	TITUS TMS
D	24'x24'	8'	121-300	=<25	-	CEILING	TITUS TMS
E	24'x24'	6'	0-120	=<25	-	CEILING	TITUS TMS
F	24'x24'	SEE PLAN	375-1900	=<25	35°	CEILING	TITUS 350RL
G	12'x6'	SEE PLAN	120-280	=<25	35°	DUCT/WALL	TITUS 300FL
H	12'x6'	SEE PLAN	120-350	=<25	35°	DUCT/WALL	TITUS 350RL
	12'x12'	SEE PLAN	50-150	=<25	35°	CEILING	TITUS 300FL
J	12'x12'	SEE PLAN	50-250	=<25	35°	CEILING	TITUS 350RL
							_

1. ALL DIFFUSERS : CONTRACTOR SHALL COORDINATE WITH LATEST ARCHITECTURAL REFLECTED CEILING PLANS TO

ENSURE PROPER AIR DEVICE BORDER SELECTION.

2. REFER ARCHITECTURAL DRAWINGS FOR CEILING TYPE. COORDINATE COLOR/FINISH WITH ARCHITECT.

NOISE CRITERIA: <=20 dBA

5. PROVIDE VOLUME CONTROL DAMPER AS ACCESSARY FOR ALL AIR TERMINAL FOR AIR BALANCING.

	BUII	LDING AIR BALANCE		
UNIT	SUPPLY AIR	OUTSIDE AIR	RETURN AIR	EXHAUST AIR
RTU-1(E)	6000	500	5500	-
RTU-2(E)	10000	1520	8480	-
EF-1	1	-	-	120 CFM
EF-2	1	-	-	70 CFM
EF-3	•	-	-	70 CFM
EF-4	-	-	-	700 CFM
EF-5	1	-	-	260 CFM
EF-6	T.	-	-	70 CFM
TOTAL:	16000 CFM	2020 CFM	13980 CFM	1290 CFM
BUILDING	PRESSURE:		730 CFM	POSITIVE
•	-	-	•	

						ELECTRICAL			WEIGH
TAG	MANUFACTURER	MODEL	QUANTITY	LOCATION	POWER (W)	INPUT VOLTAGE	PHASE	HZ	(LBS)
GPS-1		DM48-AC	1	RTU-1(E)	14	24 /110-240 VAC	1	60	4
GPS-2	GLOBAL PLASMA SOLUTIONS	DM48-AC	1	RTU-1(E)	14	24 /110-240 VAC	1	60	4
GPS-3		DM48-AC	1	RTU-2(E)	14	24 /110-240 VAC	1	60	4 4

1. ALL TUBES SHALL BE MOUNTED ON THE SUPPLY DUCTWORK AS PER PLANS & MANUFACTURER-INSTRUCTIONS 2. COORDINATE WITH ELECTRICAL FOR POWER REQUIREMENTS.

CONSULTANTS (ENGINEER):

382 NE 191ST STREET SUITE 49674, MIAMI, FL 33179 PH-914.257.3455 WWW.NY-ENGINEERS.COM

CONTRACTOR'S NOTES:
WRITTEN DIMENSIONS HOLD PREFERENCE OVER SCALED DIMENSIONS. DO NOT SCALE THE DRAWINGS. THE CONTRACTORS MUST VISIT JOB SITE TO VERIFY ALL EXISTING CONDITIONS AND DIMENSIONS BEFORE SUBMITTING BIDS. REPORT ANY DISCREPANCIES OF ANY CONDITIONS WHICH MAY INTERFERE WITH THE PROPER EXECUTION OF, THE CONTRACT TO THE TENANT'S REPRESENTATIVE. REPORT DISCREPANCIES DURING BIDDING PROCESS AND BEFORE START OF CONSTRUCTION. CHANGE ORDERS NEED TO BE APPROVED BY **TOWNSQUARE** CONSTRUCTION MANAGER FOR ISSUES ARISING FROM THE FIELD
CONDITIONS OR CONFLICTS BETWEEN THE PLANS AND
THE EXISTING CONDITIONS PRIOR TO THE

10.31.24 LL/CLIENT REVIEW SET 11.15.24 LL/CLIENT REVIEW SET 11.22.24 BD SUBMISSION

COMMENCEMENT OF WORK.

11.15.24 CLIENT COMMENTS DATE REVISION



MECHANICAL SCHEDULE ( 01 OF 02 )

SHEET NUMBER:



Zone Tag	Facility Type	Zone Use	Zone Floor Area (square ft) Az	Occupancy Pz	Occupant Rp	cfm/ft2 Ra	Pz * Rp	Az * Ra	Effectiveness Ez	Ez correction (Vbz/Ez)
RTU-1 (E)	General	Daycare sickroom	2,738.0	70.0	10.0	0.18	700	493	0.8	1491
		_								OA required per VRP
Zone Height (feet)	10.0									
Desired Outside Air (Vo) IAQP (CF	735	(1-R)V <sub>F</sub>	*		Air Changes Per Hour	10.5		VRP OA C	FM per person	21.3
Supply Air (Vs) (CFM)	4,790		0		Outside Air Per VRP	1491	CFM	IAQ OA C	FM per person	10.5
Return Air (Vr)	4055	E <sub>f</sub> ]A		9	Outside Air Per IAQ	735	CFM			
Recirc. Flow Factor (R)	0.85	PRV v	u 0	. V.	Outside Air Savings	756	CFM		Winter He	ating Savings
Ventilation Effectiveness (Ez)	0.8	V.,C. [E	] <b>B</b>	-	OA Summer Drybulb	92.	6	OA Winter	Design DB (F)	11.4
Level of Physical Activity	Sedentary	Fr	$(V_r + V_o)$	·   ·	OA Summer Wetbulb	74.	1	Supply Air I	DB Setpoint (F)	95
Filter Location	В	<b>⊤</b>		•	Coil Leaving Air Drybulb (F	56.	0	MBH Saved	d Winter	68.6
HVAC Flow Type	Constant		Occupied Zone e, N, C <sub>s</sub>		Coil Leaving Air Wetbulb (F	54.	0	KW Saved	Winter	20.1
Outdoor Air Flow Type	Constant	° 5° °	200		OA MBH Saved Summer*	51.	100			
			G		OA Tons Saved Summer*	4.3		*OA = Outs	side Air	

		Steady State (lb/ft3)	Steady State (lb/ft3)	Is Steady State Level	Contaminant			***OSHA, N	IOSH & W	HO most conserv	ative values used
Indoor Contaminants	Maximum Threshold Value	Using the VRP*	Using the IAQ Method	Acceptable at Reduced	Generation	Filtration	Cognizant	http://www	v.cdc.gov/r	iosh/npg/npgsyn-	a.html
Generated By People & From Outdoors	Based on OSHA or NIOSH (PPM)	(Prescribed OA) Ionization Off	(Reduced OA) Ionization On	OA Levels?	Rate lb/person/min	Effectiveness	Authority***		CO2 St	teady State (	PPM)
Acetaldehyde	100.0	2.0063E-09	6.4782E-10	Yes	1.2903E-08	50%	OSHA	6000 —			
Acetone	250.0	7.8122E-09	4.6659E-09	Yes	1.2993E-07	50%	NIOSH		5000		
Ammonia	25.00	1.7919E-07	1.0896E-07	Yes	3.0522E-06	50%	NIOSH	5000 —			
Benzene	1.0	9.0686E-09	5.2869E-09	Yes	1.4602E-07	50%	OSHA				
2- Butanone (MEK)	200.0	5.1876E-07	3.1552E-07	Yes	8.8396E-06	50%	NIOSH	4000 —			
Carbon dioxide**	5000	4.6405E-05	4.7895E-05	Yes	2.4692E-05	0%	NIOSH				
Chloroform	2.0	1.6108E-08	9.7688E-09	Yes	2.7342E-07	50%	NIOSH	3000 —			
Dioxane	100.0	0.0000E+00	0.0000E+00	Yes	0.0000E+00	50%	OSHA	2000			
Hydrogen Sulfide	10.0	0.0000E+00	0.0000E+00	Yes	0.0000E+00	50%	NIOSH	2000 —			1384
Methane	NA	6.8698E-08	6.8698E-08	Yes	0.0000E+00	0%	NA	1000 —		885	
Methanol	200.0	6.5507E-09	1.3289E-08	Yes	1.1163E-07	0%	NIOSH	1000 —			
Methylene Chloride	25.0	4.7116E-07	2.8651E-07	Yes	8.0262E-06	50%	OSHA	0 —			
Propane	1000.0	1.1242E-09	1.1242E-09	Yes	0.0000E+00	0%	NIOSH		1	2	3
Tetrachloroethane	5.0	0.0000E+00	0.0000E+00	Yes	0.0000E+00	50%	OSHA		:		
Tetrachloroethylene	100.0	5.3500E-07	3.2534E-07	Yes	9.1140E-06	50%	OSHA				
Toluene	100.0	2.5874E-09	1.0013E-09	Yes	2.2806E-08	50%	NIOSH	1 = NIOSH	CO2 Limit		
1,1,1 - Trichloroethane	350.0	2.2487E-05	1.3677E-05	Yes	3.8318E-04	50%	NIOSH	2 = CO2 Le	vel at Vent	ilation Rate OA F	low Rate
	<del> </del>						<del> </del>	l			

Building materials and furnishings assumed to have no VOCs and off-gassing is complete

Is IAQ acceptable at reduced outside air lev

GPS INDOOR AIR QUALITY SOFTWARE© COPYRIGHT 2021 GPS AIR,INC - ALL RIGHTS RESERVED

UNAUTHORIZED USE OR COPYING STRICTLY PROHIBITED

50% OSHA 3 = CO2 Level at IAQ Procedure OA Flow Rate \*Carbon dioxide has been provided for reference only for gathering demand control ventilation (DCV) setpoints. The National Research Council was commissioned by the US Navy to prove CO2 is not a contaminant of concern when using air cleaning devices to control the other contaminants of concern, as found on submarines.

The University of Denmark conducted a study to confirm CO2 levels at 5,000 PPM had no impact on cognitive function. Zhang X, Wargocki P, Lian Z, Human Responses to Carbon Dioxide, a Follow-up Study at Recommended Exposure Limits in

16-10-2024 Job Name Engineer Contractor

6.2453E-10

9.3626E-11

reduced outside air levels?

IMC 2006 & later allows for ASHRAE 62 IAQP through the engineered exception found in Section 403.2 Exhaust flow rates may differ from Table 6.5 based on ASHRAE 62 IAQP via Section 6.5.2

0.0000E+00



Job Name

Engineer Contractor

Representative

				Max	OA per	Table 6.1	Pz * Rp	Az * Ra	Ventilation	Zone (CFM) with
	1		Zone Floor Area (square ft)	Occupancy	Occupant	cfm/ft2	·		Effectiveness	Ez correction
Zone Tag	Facility Type	Zone Use	Az	Pz	Rp	Ra	Pz * Rp	Az * Ra	Ez	(Vbz/Ez)
RTU-2 (E)	General	Daycare sickroom	986.0	23.0	10.0	0.18	230	177	0.8	509
					•				<u> </u>	OA required per V
ne Height (feet)	10.0									
sired Outside Air (Vo) IAQP (CI	225	(1-R)V <sub>r</sub>	,	·	Air Changes Per Hour	12.0		VRP OA C	FM per pe <mark>rso</mark> n	22.1
ıpply Air (Vs) (CFM)	1,970	EFIA	o		Outside Air Per VRP		CFM	IAQ OA CI	FM per person	9.8
eturn Air (Vr)	1745		D		Outside Air Per IAQ		CFM			
ecirc. Flow Factor (R)	0.89	RV r		. Vr	Outside Air Savings	284	CFM	1	Winter Hea	iting Savings
entilation Effectiveness (Ez)	0.8	V.C. Er	]B		OA Summer Drybulb	92.6	6	OA Winter I	Design DB (F)	11.4
vel of Physical Activity	Sedentary	. Fr	$(\mathbf{V}_r + \mathbf{V}_o)$		OA Summer Wetbulb	74.	1	Supply Air [	DB Setpoint (F)	95
ter Location	В	.   🕇			Coil Leaving Air Drybulb (F	56.0	0	MBH Saved		25.8
/AC Flow Type	Constant		Occupied Zone e, N, C <sub>s</sub>		Coil Leaving Air Wetbulb (F			KW Saved		7.6
utdoor Air Flow Type	Constant		**************************************		OA MBH Saved Summer*	19.2	2			
					OA Tons Saved Summer*	1.6		*OA = Outs	ide Air	
		Steady State (lb/ft3)	Steady State (lb/ft3)	Is Steady State Level	Contaminant			***OSHA, N	IIOSH & WHO m	ost conservative value
Indoor Contaminants	Maximum Threshold Value	Using the VRP*	Using the IAQ Method	Acceptable at Reduced	Generation	Filtration	Cognizant	http://www	w.cdc.gov/niosh/r	npg/npgsyn-a.html
Generated By People	Based on OSHA or NIOSH	(Prescribed OA)	(Reduced OA)	OA Levels?	Rate	Effectiveness	Authority***			
& From Outdoors	(PPM)	Ionization Off	Ionization On	OA Levels !	lb/person/min	LifeCtivelless	Authority		CO2 Stead	y State (PPM)
etaldehyde	100.0	1.9774E-09	5.1259E-10	Yes	1.2903E-08	50%	OSHA	6000 —	·	
etone	250.0	7.5213E-09	3.7647E-09	Yes	1.2993E-07	50%	NIOSH	1	5000	
nmonia	25.00	1.7236E-07	8.7949E-08	Yes	3.0522E-06	50%	NIOSH	5000 —	0000	
enzene	1.0	8.7416E-09	4.2635E-09	Yes	1.4602E-07	50%	OSHA	1		
Butanone (MEK)	200.0	4.9897E-07	2.5469E-07	Yes	8.8396E-06	50%	NIOSH	4000 —		
arbon dioxide**	5000	4.6350E-05	4.8111E-05	Yes	2.46 <mark>92</mark> E-05	0%	NIOSH	1		
nloroform	2.0	1.5496E-08	7.8848E-09	Yes	2.7342E-07	50%	NIOSH	3000 —		
oxane	100.0	0.0000E+00	0.0000E+00	Yes	0.0000E+00	50%	OSHA	1		
/drogen Sulfide	10.0	0.0000E+00	0.0000E+00	Yes	0.0000E+00	50%	NIOSH	2000 —		1456
ethane	NA	6.8698E-08	6.8698E-08	Yes	0.0000E+00	0%	NA	1000 —		867
ethanol	200.0	6.3008E-09	1.4264E-08	Yes	1.1163E-07	0%	NIOSH	1000 —		
ethylene Chloride	25.0	4.5318E-07	2.3127E-07	Yes	8.0262E-06	50%	OSHA	1		
opane	1000.0	1.1242E-09	1.1242E-09	Yes	0.0000E+00	0%	NIOSH	1   ~	1	2 3
trachloroethane	5.0	0.0000E+00	0.0000E+00	Yes	0.0000E+00	50%	OSHA			
trachloroethylene	100.0	5.1459E-07	2.6261E-07	Yes	9.1140E-06	50%	OSHA	1		
luene	100.0	2.5363E-09	7.9790E-10	Yes	2.2806E-08	50%	NIOSH	1 = NIOSH	CO2 Limit	
1,1 - Trichloroethane	350.0	2.1629E-05	1.1040E-05	Yes	3.8318E-04	50%	NIOSH	2 = CO2 Le	evel at Ventilation	Rate OA Flow Rate
rlene	100.0	6.2453E-10	7.0411E-11	Yes	0.0000E+00	50%				dure OA Flow Rate
+						**Carbon dioxid	le has been p	rovided for i	reference only for	gathering demand co
			Is IAQ acceptable at							cil was commissioned

GPS INDOOR AIR QUALITY SOFTWARE® COPYRIGHT 2021 GPS AIR, INC - ALL RIGHTS RESERVED UNAUTHORIZED USE OR COPYING STRICTLY PROHIBITED 16-10-2024

NY Engineers

IMC 2006 & later allows for ASHRAE 62 IAQP through the engineered exception found in Section 403.2 Exhaust flow rates may differ from Table 6.5 based on ASHRAE 62 IAQP via Section 6.5.2

The University of Denmark conducted a study to confirm CO2 levels at 5,000

PPM had no impact on cognitive function. Zhang X, Wargocki P, Lian Z, Human

Responses to Carbon Dioxide, a Follow-up Study at Recommended Exposure Limits in



				Zone	Table 6.1				Table 6.2	Outdoor Air to
				Max	OA per	Table 6.1	Pz * Rp	Az * Ra	Ventilation	Zone (CFM) with
			Zone Floor Area (square ft)	Occupancy	Occupant	cfm/ft2	·		Effectiveness	Ez correction
Zone Tag	Facility Type	Zone Use	Az	Pz	Rp	Ra	Pz * Rp	Az * Ra	Ez	(Vbz/Ez)
RTU-1 ( E )	General	Daycare sickroom	3,137.0	82.0	10.0	0.18	820	565	0.8	1731
					-					OA required per VRP
Zone Height (feet)	10.0									
Desired Outside Air (Vo) IAQP (C		(1-R)V <sub>c</sub>	a		Air Changes Per Hour	9.1			FM per person	21.1
Supply Air (Vs) (CFM)	4,770	EFJA	0		Outside Air Per VRP		CFM	IAQ OA C	FM per person	9.3
Return Air (Vr)	4010	L L Z			Outside Air Per IAQ		CFM			
Recirc. Flow Factor (R)	0.84			. Ve	Outside Air Savings	971	CFM		Winter He	ating Savings
entilation Effectiveness (Ez)	0.8	V.,C. [E	В	a	OA Summer Drybulb	92.	6	OA Winter	Design DB (F)	11.4
evel of Physical Activity	Sedentary	Fr	$(\mathbf{V}_x + \mathbf{V}_o)$		OA Summer Wetbulb	74.	1	Supply Air I	DB Setpoint (F)	95
ilter Location	В	·   •			Coil Leaving Air Drybulb (F	56.	0	MBH Saved	d Winter	88.1
IVAC Flow Type	Constant		Occupied Zone e, N, C <sub>s</sub>		Coil Leaving Air Wetbulb (I			KW Saved	Winter	25.8
Outdoor Air Flow Type	Constant	٠ .			OA MBH Saved Summer*	65.				
	_				OA Tons Saved Summer*	5.5	5	*OA = Outs		
		Steady State (lb/ft3)	Steady State (lb/ft3)	Is Steady State Level	Contaminant			***OSHA, N	NOSH & WHO m	nost conservative values use
Indoor Contaminants	Maximum Threshold Value	Using the VRP*	Liging the IAO Method	Acceptable at Reduced	Generation	Filtration	Cognizant	http://www	w odo gov/pioch	/png/pngsyn a html
muoor Contaminants	waxiiiluiii Tiilesiiola value	Using the VKP	Using the IAQ Method	Acceptable at Reduced	Generation	Filliation	Cognizant	TILD.//www	w.cuc.gov/mosn/	<u>/npg/npgsyn-a.html</u>
Generated By People	Based on OSHA or NIOSH	(Prescribed OA)	(Reduced OA)	OA Levels?	Rate	Effectiveness	  Authority***		000.01	L O( ( (DDM)
& From Outdoors	(PPM)	Ionization Off	Ionization On		lb/person/min			1	CO2 Stead	dy State (PPM)
cetaldehyde	100.0	2.0132E-09	7.348 <mark>9E</mark> -10	Yes	1.2903E-08	50%	OSHA	6000 —		
Acetone	250.0	7.8820E-09	5.4749E-09	Yes	1.2993E-07	50%	NIOSH		5000	
Ammonia	25.00	1.8083E-07	1.2794E-07	Yes	3.0522E-06	50%	NIOSH	5000 —		
	<del>                                     </del>	0.44=0=.00	0.40707.00							

& From Outdoors	(PPM)	Ionization Off	Ionization On		lb/person/min			OOZ Gloddy Glate (1 1 W)
cetaldehyde	100.0	2.0132E-09	7.348 <mark>9E</mark> -10	Yes	1.2903E-08	50%	OSHA	6000 —
cetone	250.0	7.8820E-09	5.474 <mark>9E-</mark> 09	Yes	1.2993E-07	50%	NIOSH	5000
mmonia	25.00	1.8083E-07	1.2794E-07	Yes	3.0522E-06	50%	NIOSH	5000
enzene	1.0	9.1470E-09	6.1978E-09	Yes	1.4602E-07	50%	OSHA	
Butanone (MEK)	200.0	5.2350E-07	3. <mark>705</mark> 0E-07	Yes	8.8396E-06	50%	NIOSH	4000 —
arbon dioxide**	5000	4.6418E-05	4.8286E-05	Yes	2.4692E-05	0%	NIOSH	
nloroform	2.0	1.6254E-08	1.1470E-08	Yes	2.7342E-07	50%	NIOSH	3000
oxane	100.0	0.0000E+00	0.0000E+00	Yes	0.0000E+00	50%	OSHA	2000
ydrogen Sulfide	10.0	0.0000E+00	0.0000E+00	Yes	0.0000E+00	50%	NIOSH	20001515
ethane	NA	6.8698E-08	6.8698E-08	Yes	0.0000E+00	0%	NA	1000
ethanol	200.0	6.61 <mark>06E-0</mark> 9	1.5055E-08	Yes	1.1163E-07	0%	NIOSH	1000
ethylene Chloride	25.0	4.7546E-07	3.3642E-07	Yes	8.0262E-06	50%	OSHA	0
ropane	1000.0	1.1242E-09	1.1242E-09	Yes	0.0000E+00	0%	NIOSH	1 2 3
etrachloroethane	5.0	0.0000E+00	0.0000E+00	Yes	0.0000E+00	50%	OSHA	]
etrachloroethylene	100.0	5.3989E-07	3.8202E-07	Yes	9.1140E-06	50%	OSHA	1
oluene	100.0	2.5996E-09	1.1499E-09	Yes	2.2806E-08	50%	NIOSH	1 = NIOSH CO2 Limit
1,1 - Trichloroethane	350.0	2.2692E-05	1.6060E-05	Yes	3.8318E-04	50%	NIOSH	2 = CO2 Level at Ventilation Rate OA Flow Rate
ylene	100.0	6.2453E-10	9.7042E-11	Yes	0.0000E+00	50%	OSHA	3 = CO2 Level at IAQ Procedure OA Flow Rate
								provided for reference only for gathering demand contr
uilding materials and furnishing	s assumed to have no VO	Cs and off-gassing is complete	Is IAQ acceptable at	Yes		ventilation (DC	V) setpoints.	The National Research Council was commissioned by
All valleys abaded beyon rea	and the second s		الأمامينما مامامام مامام مامام مارام مسا	1 63		Alea LIC Navasta	000:	

GPS INDOOR AIR QUALITY SOFTWARE© COPYRIGHT 2021 GPS AIR,INC - ALL RIGHTS RESERVED UNAUTHORIZED USE OR COPYING STRICTLY PROHIBITED

reduced outside air levels?

devices to control the other contaminants of concern, as found on submarines. The University of Denmark conducted a study to confirm CO2 levels at 5,000 PPM had no impact on cognitive function. Zhang X, Wargocki P, Lian Z, Human Responses to Carbon Dioxide, a Follow-up Study at Recommended Exposure Limits in

the US Navy to prove CO2 is not a contaminant of concern when using air cleaning

16-10-2024 Job Name NY Engineers

IMC 2006 & later allows for ASHRAE 62 IAQP through the engineered exception found in Section 403.2 Exhaust flow rates may differ from Table 6.5 based on ASHRAE 62 IAQP via Section 6.5.2

CONSULTANTS (ENGINEER):

**NEARBY ENGINEERS** 382 NE 191ST STREET SUITE 49674, MIAMI, FL 33179 PH-914.257.3455 WWW.NY-ENGINEERS.COM

CONTRACTOR'S NOTES: DIMENSIONS. DO NOT SCALE THE DRAWINGS. THE CONTRACTORS MUST VISIT JOB SITE TO VERIFY ALL EXISTING CONDITIONS AND DIMENSIONS BEFORE SUBMITTING BIDS. REPORT ANY DISCREPANCIES OF ANY CONDITIONS WHICH MAY INTERFERE WITH THE PROPER EXECUTION OF, THE CONTRACT TO THE TENANT'S REPRESENTATIVE. REPORT DISCREPANCIES DURING BIDDING PROCESS AND BEFORE START OF CONSTRUCTION. CHANGE ORDERS NEED TO BE APPROVED BY TOWNSQUARE CONSTRUCTION MANAGER FOR ISSUES ARISING FROM THE FIELD CONDITIONS OR CONFLICTS BETWEEN THE PLANS AND

THE EXISTING CONDITIONS PRIOR TO THE

COMMENCEMENT OF WORK.


10.31.24 LL/CLIENT REVIEW SET 11.15.24 LL/CLIENT REVIEW SET 11.22.24 BD SUBMISSION

11.15.24 CLIENT COMMENTS

DATE REVISION

MECHANICAL SCHEDULE (02 OF 02)

SHEET NUMBER:

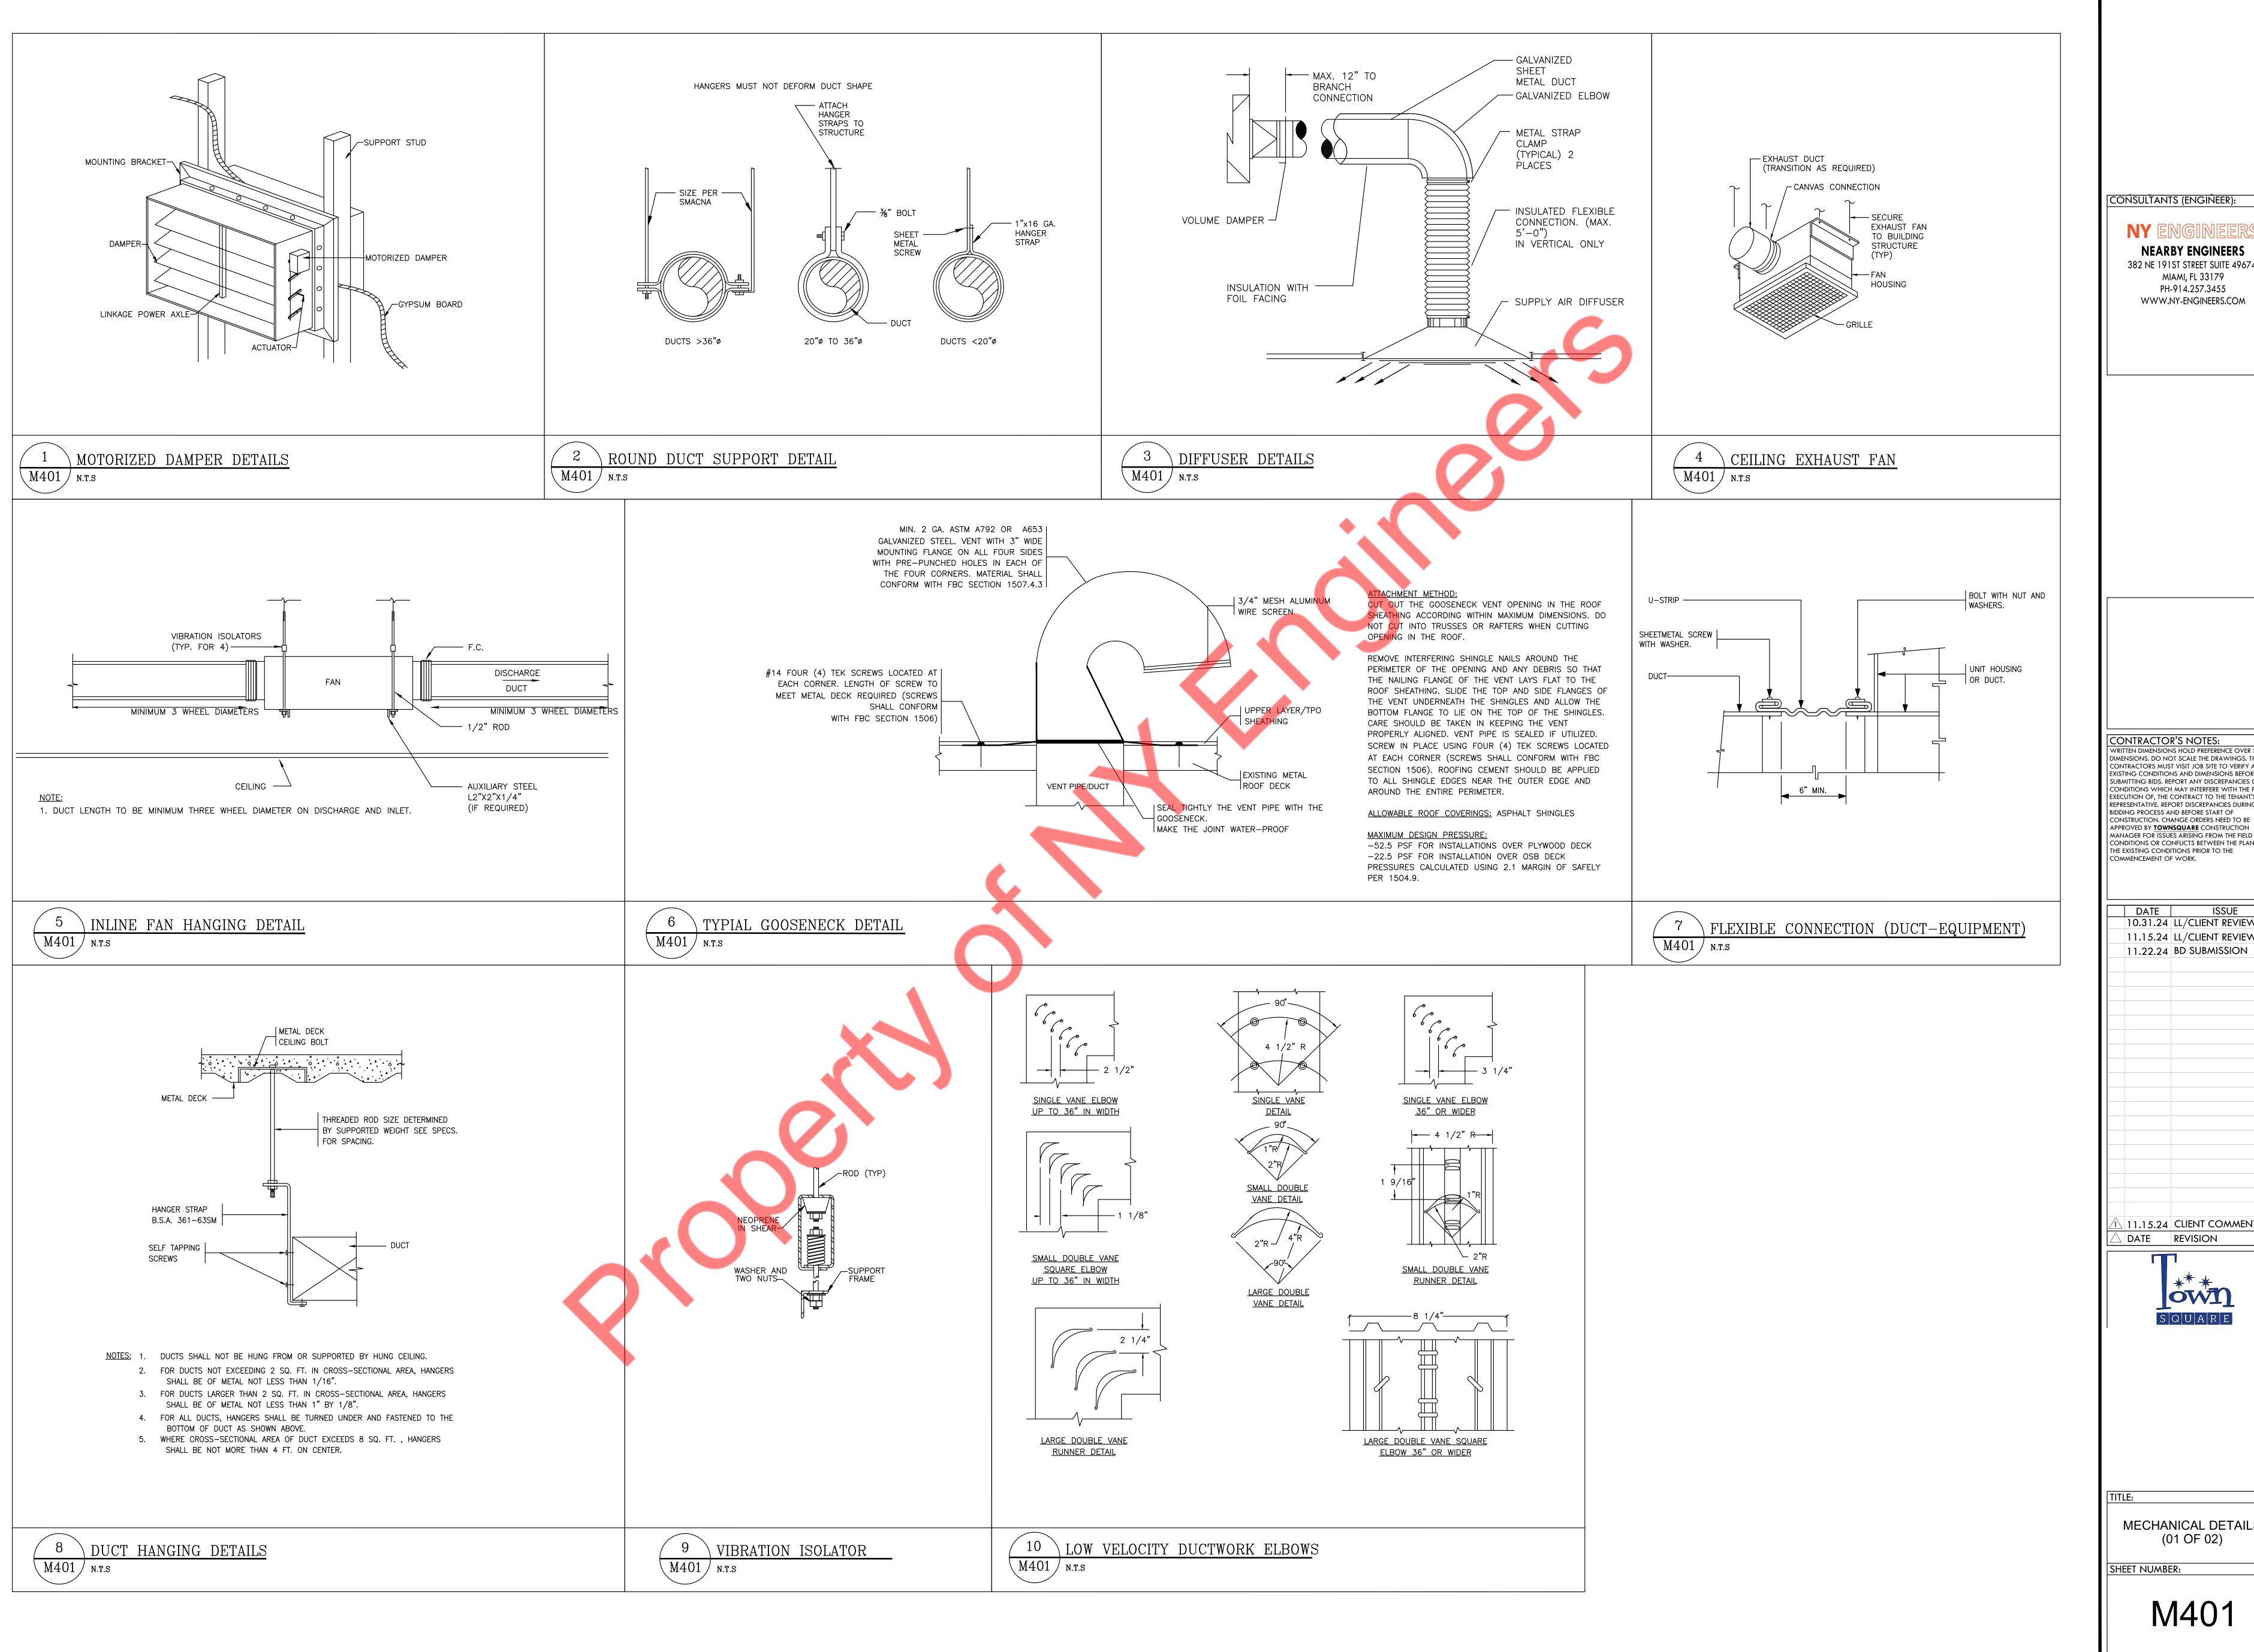

CONSULTANTS (ENGINEER):

**NEARBY ENGINEERS** 

382 NE 191ST STREET SUITE 49674, MIAMI, FL 33179 PH-914.257.3455 WWW.NY-ENGINEERS.COM

**CONTRACTOR'S NOTES:** DIMENSIONS. DO NOT SCALE THE DRAWINGS. THE CONTRACTORS MUST VISIT JOB SITE TO VERIFY ALL EXISTING CONDITIONS AND DIMENSIONS BEFORE SUBMITTING BIDS. REPORT ANY DISCREPANCIES OF ANY CONDITIONS WHICH MAY INTERFERE WITH THE PROPER EXECUTION OF, THE CONTRACT TO THE TENANT'S BIDDING PROCESS AND BEFORE START OF CONSTRUCTION. CHANGE ORDERS NEED TO BE APPROVED BY TOWNSQUARE CONSTRUCTION MANAGER FOR ISSUES ARISING FROM THE FIELD CONDITIONS OR CONFLICTS BETWEEN THE PLANS AND


10.31.24 LL/CLIENT REVIEW SET 11.15.24 LL/CLIENT REVIEW SET


1 11.15.24 CLIENT COMMENTS




MECHANICAL DETAILS (01 OF 02)

SHEET NUMBER:

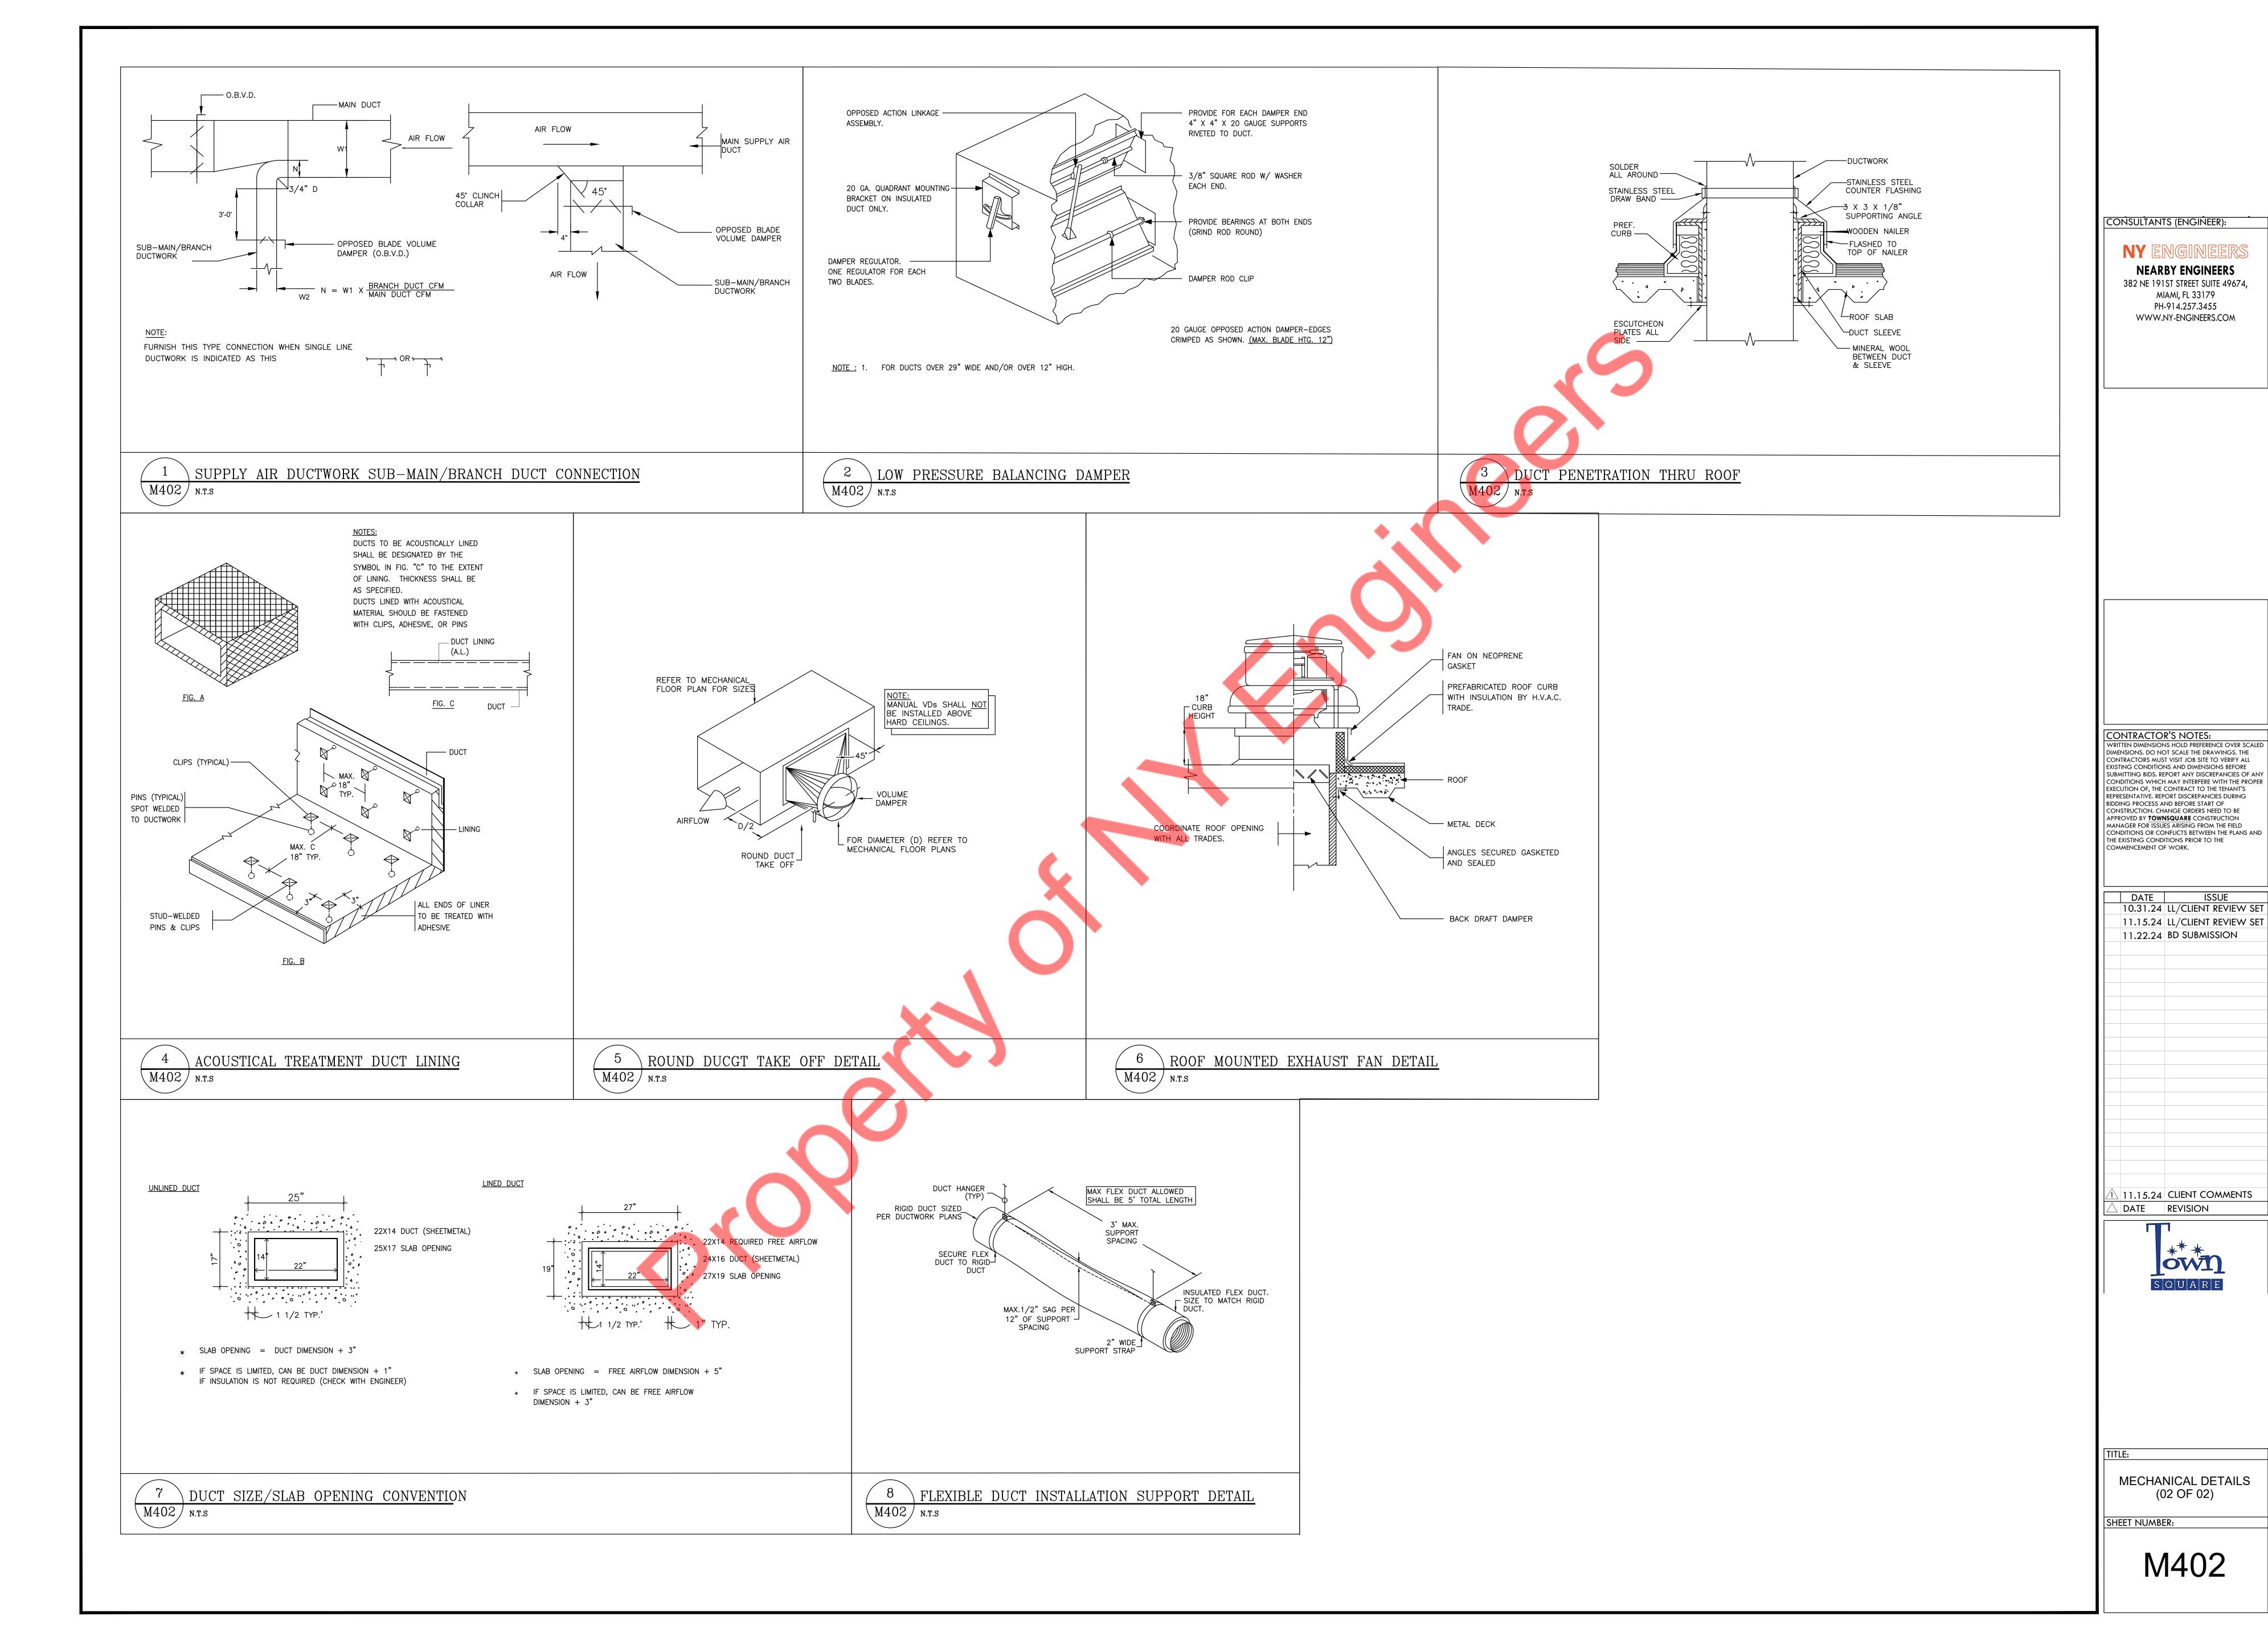

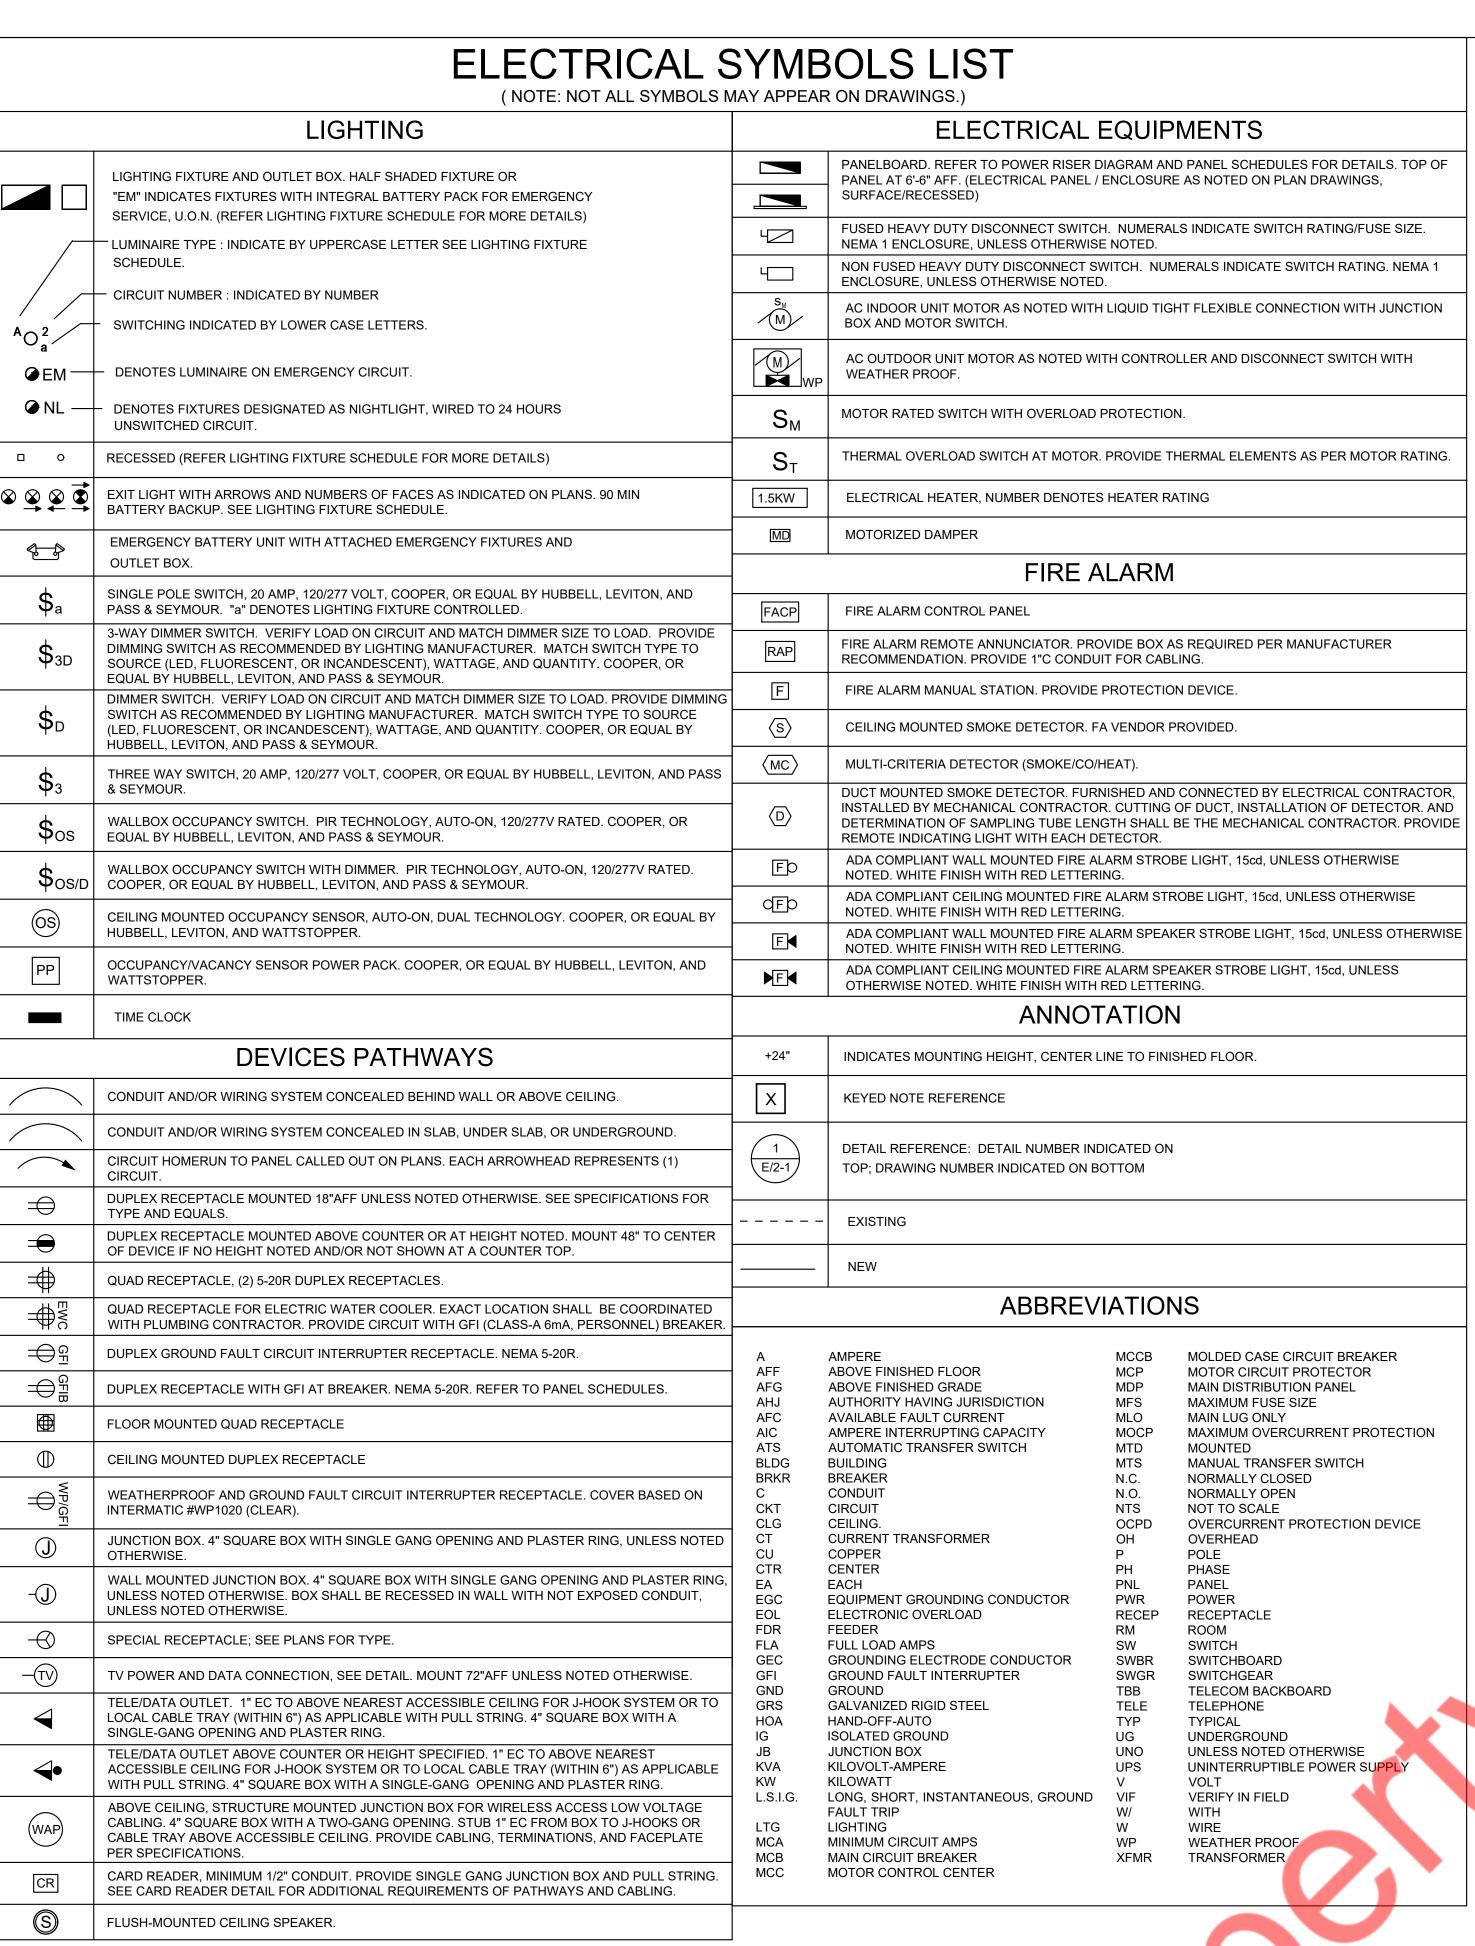

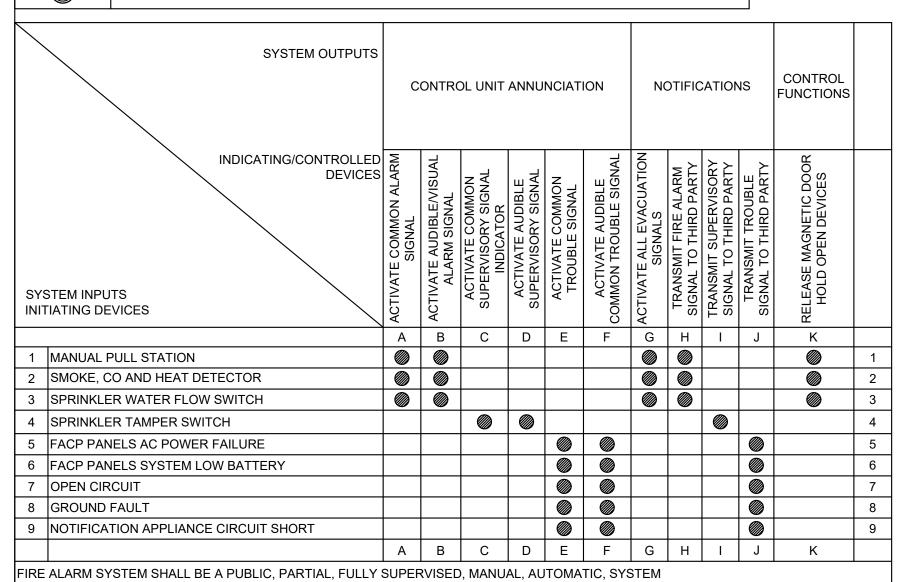


SINGLE AND MULTI STATION SMOKE ALARMS ARE NOT ALLOWED

PRIVATE FIRE ALARM SYSTEM IS NOT ALLOWED

AIR SUPPLY OR RETURN CEILING -SMOKE, HEAT, OR CO 12", UNLESS CEILING IS DETECTOR HIGHER THAN 12'-0", THEN 24" ABOVE DOOR. TV OUTLET ► 🖁 • FIRE ALARM HORN OR STROBE LIGHT EXIT ALIGN WHEN MOUNTED-ROOM LIGHT SWITCH -ON SAME WALL FIRE ALARM PULL STATION— (5' MAXIMUM FROM DOOR) -RECEPTACLE TOP OF COUNTER BACKSPLASH - DUPLEX RECEPTACLE -TELEPHONE/DATA 8" MAXIMUM TO FIRST DEVICE :--**FLOOR** — SPECIAL PURPOSE – QUAD RECEPTACLE SINGLE RECEPTACLE LOCATIONS WHERE TV MOUNT IS BACK TO BACK ON SAME WALL, AN OFFSET OF 8-12" WILL BE NEEDED FOR INSTALLATION OF JACK/RECEPTACLE. 2. DEVICES ABOVE COUNTER TOPS SHALL BE A MAXIMUM OF 48" TO TOP OF DEVICE.

MOUNTING HEIGHTS OF DEVICES - ELEVATIONS

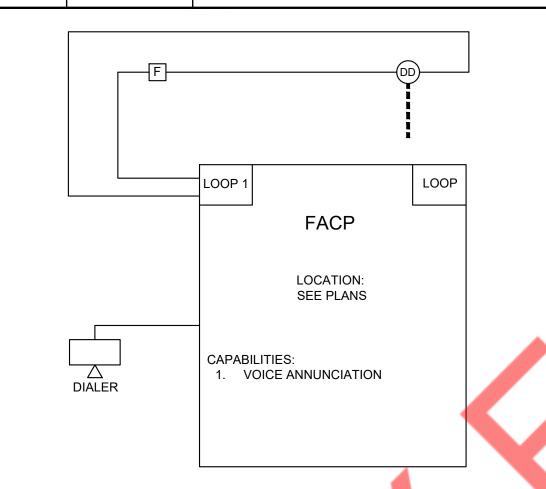

N.T.S.

- FACP SHALL BE FULLY ANALOG ADDRESSABLE.
   FACP IS SHALL BE TO A UL APPROVED CENTRAL STATION.
   ZONE PER NFPA 72, 2019 AND MANUFACTURER'S RECOMMENDATIONS WITH NO ONE ZONE EXCEEDING 15,000 S.F. PER FLOOR.
- COORDINATE QUANTITY AND LOCATIONS OF DEVICES WITH CONTRACT DRAWINGS.
   LOCATE FIRE ALARM PULL STATION WITHIN 5' OF THE EXIT DOOR.
   LOCATE SMOKE/HEAT DETECTOR WITHIN 5' OF THE FA FOLIPMENT (FACE FATC)
- 6. LOCATE SMOKE/HEAT DETECTOR WITHIN 5' OF THE FA EQUIPMENT (FACP, FATC).
  7. LOCATION OF CEILING MOUNTED SMOKE/HEAT DETECTOR SHALL BE FIELD COORDINATED PRIOR
- TO ROUGH IN. THE DETECTOR SHALL BE A MINIMUM OF 2' AWAY FROM LIGHT FIXTURE AND A MINIMUM OF 3' AWAY FROM AIR DISTRIBUTION DEVICES.
   ACTIVATION OF AN ALARM ZONE SHALL CAUSE ALL AIR HANDLING EQUIPMENT TO SHUT DOWN (ALL DAMPERS, AIR HANDLERS AND EXHAUST FANS MUST STOP).
   ELECTRICAL CONTRACTOR SHALL COORDINATE EXACT LOCATIONS OF ALL FLOW, PRESSURE, &
- TAMPER SWITCHES WITH FIRE PROTECTION CONTRACTOR PRIOR TO INSTALLATION.
  10. ALL VISUAL DEVICES WITHIN THE SAME AREA SHALL BE SYNCHRONIZED. IT SHALL BE A THREE BEAT TEMPORAL PATTERN.
  11. FIRE ALARM CABLING SHALL BE PLENUM RATED.
  12. ALL NOTIFICATION DEVICES SHALL BE SPEAKER TYPE AND VOICE CAPABLE. NAC SHALL BE VOICE

(IN WALL) AS REQUIRED BY LOCAL AHJ/ENGINEER.


- CAPABLE.

  13. THE FIRE ALARM SYSTEM MANUFACTURER SHALL PROVIDE NOTIFICATION APPLIANCE CIRCUIT (NAC) POWER EXTENDERS AS REQUIRED.

  14. THE CIRCUIT FEEDING THE FIRE ALARM PANEL IS DEDICATED FOR THE FIRE ALARM ONLY. BREAKER SHALL BE PROVIDED WITH A LABEL "FIRE ALARM CIRCUIT" AND SHALL BE RED.

  15. CONTRACTOR SHALL INCLUDE IN BID LABOR AND MATERIAL FOR UP TO (2) DUCT DETECTORS. (5) ANNUNCIATION DEVICES, (2) SMOKE DETECTORS AND (2) PULL STATIONS 100' FROM LOCAL PANEL
- 16. CONTRACTOR RESPONSIBLE FOR SHOP DRAWINGS AS REQUIRED BY LOCAL AHJ.

  17. THIS SYSTEM SHALL EMPLOY A SINGLE TELEPHONE LINE (NUMBER) AS WELL AS AN ADDITIONAL TELEPHONE LINE (NUMBER) THAT IS CAPABLE OF THE FOLLOWING:
- A. THE DACT IS PROGRAMMED TO CALL A SECOND DACR LINE (NUMBER) WHEN THE SIGNAL TRANSMISSION SEQUENCE TO THE FIRST CALLED LINE (NUMBER) IS UNSUCCESSFUL.
   B. THE DACT IS CAPABLE OF SELECTING THE OPERABLE MEANS OF TRANSMISSION IN THE EVENT
- B. THE DACT IS CAPABLE OF SELECTING THE OPERABLE MEANS OF TRANSMISSION IN THE EVENT OF FAILURE OF THE OTHER MEANS.
  C. EACH TELEPHONE LINE IS TESTED IN ACCORDANCE WITH 26.6.4.1.4(B) OR AT ALTERNATING 6-HOUR INTERVALS.
- FIRE ALARM RISER DIAGRAM

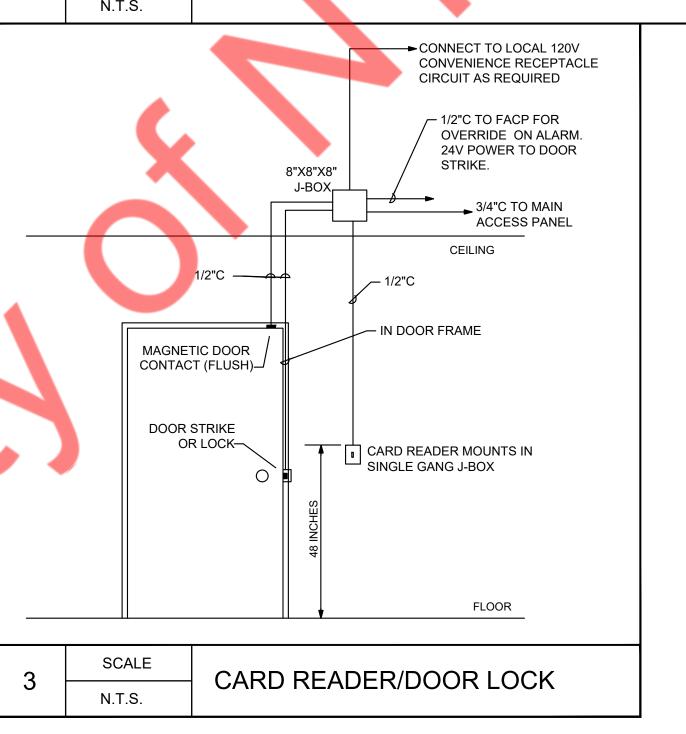

#### GENERAL NOTES:

- ALL WORK SHALL BE PERFORMED IN STRICT ACCORDANCE WITH THE CURRENT VERSION OF THE UCC ELECTRICAL SUBCODE (ADOPTS NFPA 70, 2020 WITH AMENDMENTS), LOCAL JURISDICTION REQUIREMENTS, AND ALL GOVERNING LOCAL CODES, LAWS, AND REGULATIONS.
- 2. CONTRACTOR SHALL VISIT THE SITE AND BECOME FAMILIAR WITH ALL EXISTING CONDITIONS THAT MAY AFFECT THE WORK. NO ADDITIONAL COMPENSATION WILL BE
- CONSIDERED FOR FAILURE TO DO SO.

  3. CONTRACTOR SHALL OBTAIN AND PAY FOR ALL PERMITS, TEST REPORTS, AND
- 4. FIRE STOP ALL PENETRATIONS OF FIRE RATED CONSTRUCTION IN A CODE APPROVED MANNER IN ORDER TO MAINTAIN FIRE RATING. ALL PENETRATIONS SHALL BE SLEEVED AND SEALED WATERTIGHT.

CERTIFICATIONS FOR TEMPORARY AND FINAL CERTIFICATE OF OCCUPANCY.

- 5. SECURE ALL SUPPORTS TO BUILDING STRUCTURE UTILIZING TOGGLE BOLTS (HOLLOW MASONRY), EXPANSION SHIELDS OR INSERTS (CONCRETE AND BRICK), MACHINE SCREWS (METAL), BEAM CLAMPS (FRAMEWORK), WOOD SCREWS (WOOD) OR PAN THRU STRAPS (METAL DECK). NAILS, RAWL PLUGS AND WOOD PLUGS ARE NOT PERMITTED. WHERE REQUIRED BY STRUCTURE, PROVIDE THRU BOLTS AND FISH PLATES. SUPPORT HORIZONTAL RUNS OF METALLIC RACEWAYS NOT MORE THAN 10 FT APART. SUPPORT RACEWAY RISERS AT EACH FLOOR LEVEL. RUN EXPOSED RACEWAYS PARALLEL WITH OR AT RIGHT ANGLES TO WALLS.
- 6. LEAVE WIRES WITH SUFFICIENT SLACK TO PERMIT MAKING FINAL CONNECTIONS. RACEWAYS OVER 10 FT LONG IN WHICH WIRING IS NOT INSTALLED: FURNISH FISH WIRE.
- 7. VERIFY LOCATIONS OF OUTLETS AND SWITCHES IN FINISHED ROOMS WITH ARCHITECTURAL DRAWINGS OF INTERIOR DETAILS AND FINISH. IN CENTERING OUTLETS AND LOCATING BOXES AND OUTLETS, ALLOW FOR OVERHEAD PIPES, DUCTS AND MECHANICAL EQUIPMENT, EQUIPMENT, VARIATIONS IN FIREPROOFING AND PLASTERING, WINDOW AND DOOR TRIM, PANELING, HUNG CEILINGS AND THE LIKE. CORRECT ANY INACCURACY RESULTING FROM FAILURE TO DO SO WITHOUT EXPENSE TO OWNER.
- 8. CONTRACTOR SHALL PROVIDE A WARRANTY ON ALL MATERIALS, EQUIPMENT, AND WORKMANSHIP FOR A PERIOD OF ONE YEAR FROM THE DATE OF FINAL ACCEPTANCE.
- 9. ALL UNUSED MATERIALS AND DEBRIS SHALL BE LEGALLY REMOVED AND DISPOSED OF AWAY FROM THE PREMISES ON A DAILY BASIS.
- 10. CONTRACTOR SHALL PATCH, PAINT, AND RESTORE EXISTING SURFACES DAMAGED DURING THE COURSE OF THIS CONSTRUCTION TO PRE-EXISTING CONDITIONS OR
- 11. MINIMUM SIZE OF CONDUIT SHALL BE ¾", AND TYPE SHALL BE ELECTRICAL METALLIC TUBING (EMT), UNLESS OTHERWISE NOTED. PROVIDE NYLON DRAG LINE AND CONDUIT CAP FOR ALL EMPTY CONDUITS.
- 12. CONNECT CONDUIT TO MOTOR CONDUIT TERMINAL BOXES WITH FLEXIBLE CONDUIT (MINIMUM 18 IN. LENGTH AND 50% SLACK). DO NOT TERMINATE IN OR FASTEN RACEWAYS

TO MOTOR FOUNDATION.

ACCESSIBLE.

13. PULL AND JUNCTION BOXES WHERE INDICATED ON THE DRAWINGS, SHALL BE CONSIDERED SHOWN AT THEIR APPROXIMATE LOCATION. THE CONTRACTOR SHALL LOCATE THEM AS FIELD CONDITIONS DICTATE. ADDITIONAL PULL AND JUNCTION BOXES NOT SHOWN ON DRAWINGS SHALL BE PROVDED WHERE REQUIRED BY APPLICABLE CODE PROVISIONS OR WHERE CALLED FOR BY FIELD CONDITIONS. PULL AND JUNCTION BOXES SHALL BE SURFACE TYPE IN UNFINISHED AREAS AND INSTALLED CANCEALED IN

FINISHED AREAS, AND ALL COVERS TO PULL & JUNCTION BOXES SHALL BE READILY

- 14. SUPPORT PANEL, JUNCTION AND PULLBOXES INDEPENDENTLY TO BUILDING STRUCTURE WITH NO WEIGHT BEARING ON RACEWAYS.
- 15. FOR EXACT LOCATION AND MOUNTING HEIGHT OF LIGHTING FIXTURES AND SWITCH/RECEPTACLE OUTLETS, REFER TO ARCHITECTURAL REFLECTED CEILING AND POWER PLANS.
- 16. ALL ELECTRICAL ACCESSORIES AND EQUIPMENT INSTALLED OUTSIDE OR EXPOSED TO WEATHER SHALL HAVE NEMA 3R ENCLOSURES AND SHALL BE TIGHTLY GASKETED FOR A COMPLETE RAINTIGHT INSTALLATION. ALL BUILDING EXTERIOR MOUNTED RECEPTACLES SHALL BE GFCI RATED AND MOUNTED IN WEATHERPROOF ENCLOSURE.
- 17. ALL ACCESS PANEL LOCATIONS SHALL BE REVIEWED BY ARCHITECT PRIOR TO INSTALLATION.
- 18. ELECTRICAL CONTRACTOR SHALL COORDINATE THE LOCATION AND INSTALLATION OF NEW WORK WITH THE GENERAL CONTRACTOR AND OTHER ASSOCIATED TRADES IN A TIMELY MANNER. THE CONTRACTOR IS RESPONSIBLE FOR FIELD VERIFYING ALL DIMENSIONS AND CONDITIONS PRIOR TO CONSTRUCTION. REFER TO ALL GENERAL, MECHANICAL, AND ELECTRICAL, DRAWINGS AND SPECIFICATIONS FOR THIS PROJECT.
- 19. ALL CONDUITS AND EQUIPMENT TO BE CONCEAL ED IN FINISHED SPACES UNLESS OTHERWISE NOTED. CONDUITS SHALL BE ENCASED IN THE CONCRETE FLOOR SLAB.
- 20. ALL EQUIPMENT AND MATERIALS INSTALLED IN PLENUM CEILINGS SHALL BE APPROVED FOR THAT APPLICATION.

UNLESS FIRE-RATED BOXES OR PUTTY PADS ARE UTILIZED.

DEVICES WITH THE ARCHITECTURAL DRAWINGS AND DETAILS.

- 21. OUTLET BOXES AND JUNCTION BOXES ON OPPOSITE SIDES OF FIRE-RATED WALLS SHALL BE SEPARATED BY A HORIZONTAL DISTANCE OF NOT LESS THAN 24 INCHES,
- 22. COORDINATE ALL FLOOR PENETRATIONS WITH THE STRUCTURAL AND ARCHITECTURAL DRAWINGS. CONFIRM PENETRATION LOCATIONS WITH THE ENGINEER AND OWNER BEFORE INSTALLATION.
- 23. COORDINATE THE MOUNTING HEIGHT AND LOCATION OF RACEWAYS, COMMUNICATIONS OUTLETS, AND RECEPTACLES WITH THE ARCHITECTURAL CASEWORK DRAWINGS AND

DETAILS. COORDINATE LOCATIONS OF LIGHT FIXTURES, SWITCHES, AND RELATED

- 24. REFER TO ARCHITECTURAL PLANS FOR FINAL LOCATIONS OF ALL LUMINARIES AND SWITCHES, AND FOR ALL FINISHED CEILING HEIGHTS.
- 25. REFER TO ARCHITECTURAL PLANS FOR FINAL LOCATIONS OF ALL ELECTRICAL DEVICES, AND FOR FINAL CEILING AND WALL HEIGHTS AND LAYOUTS.
- 26. LIGHTING FIXTURES DESIGNATED AS EMERGENCY TYPE OR PROVIDED WITH EMERGENCY BATTERY PACKS AND INDICATED WITH SWITCH CONTROL SHALL BE WIRED WITH BATTERY CHARGING/SENSING CIRCUIT WIRED AHEAD OF SWITCH CONTROL DEVICE
- 27. NUMBER(S) SHOWN AT RECEPTACLES, JUNCTION BOXES AND EQUIPMENT INDICATES CIRCUIT NUMBERS IN PANELBOARD. PROVIDE WIRE AND CONDUIT TO INTERCONNECT EQUIPMENT AND DEVICES WITH SAME CIRCUIT NUMBERS AND RUN TO PANELBOARD.
- 28. PROVIDE RACEWAY, BACK-BOXES, GROUNDING PROVISIONS AND 120V POWER AS NECESSARY FOR LOW VOLTAGE SYSTEMS (SECURITY, TELEPHONE DATA, CABLE TELEVISION, PAGING, INTERCOM. ETC. AS APPLICABLE TO PROJECT). REFER TO ASSOCIATED CONSULTANT'S DRAWING FOR EXACT REQUIREMENTS AND LOCATIONS OF DEVICES.
- 29. PROVIDE HANDLE TIES TO ALLOW FOR SIMULTANEOUS DISCONNECTION OF CONDUCTORS IN ANY MULTI-BRANCH CIRCUITS WITH A SHARED NEUTRAL.

CONSULTANTS (ENGINEER):

NY ENGINEERS

NEARBY ENGINEERS
382 NE 191ST STREET SUITE 49674,
MIAMI, FL 33179
PH-914.257.3455
WWW.NY-ENGINEERS.COM

CONTRACTOR'S NOTES:

WRITTEN DIMENSIONS HOLD PREFERENCE OVER SCALED DIMENSIONS. DO NOT SCALE THE DRAWINGS. THE CONTRACTORS MUST VISIT JOB SITE TO VERIFY ALL EXISTING CONDITIONS AND DIMENSIONS BEFORE SUBMITTING BIDS. REPORT ANY DISCREPANCIES OF ANY CONDITIONS WHICH MAY INTERFERE WITH THE PROPER EXECUTION OF, THE CONTRACT TO THE TENANT'S REPRESENTATIVE. REPORT DISCREPANCIES DURING BIDDING PROCESS AND BEFORE START OF CONSTRUCTION. CHANGE ORDERS NEED TO BE APPROVED BY TOWNSQUARE CONSTRUCTION

MANAGER FOR ISSUES ARISING FROM THE FIELD

THE EXISTING CONDITIONS PRIOR TO THE

OMMENCEMENT OF WORK

CONDITIONS OR CONFLICTS BETWEEN THE PLANS AND

DATE ISSUE
10.31.24 LL/CLIENT REVIEW SET
11.15.24 LL/CLIENT REVIEW SET
11.22.24 BD SUBMISSION

11.15.24 CLIENT COMMENTS

DATE REVISION



ITI F.

ELECTRICAL SYMBOL LIST, ABBREVIATIONS & GENERAL NOTES

SHEET NUMBER:

E001

#### 1. GENERAL:

- A. THE WORK COVERED BY THESE SPECIFICATIONS CONSISTS OF FURNISHING ALL LABOR, A. EQUIPMENT. MATERIALS AND SUPPLIES AS NECESSARY FOR THE COMPLETE AND SATISFACTORY OPERATING ELECTRICAL SYSTEMS AS SHOWN ON THE PLANS.
- B. ALL WORK SHALL BE IN ACCORDANCE WITH UCC ELECTRICAL SUBCODE (ADOPTS NFPA 70, 2020 WITH AMENDMENTS), STATE BUILDING CODE, AND ANY OTHER LOCAL REQUIREMENTS THAT MAY APPLY. C. CONTRACTOR SHALL OBTAIN AND PAY FOR ALL ELECTRICAL PERMITS AND INSPECTION FEES. ALL
- MATERIALS AND EQUIPMENT SHALL BE NEW AND SHALL BE LISTED BY THE UNDERWRITER'S D. LABORATORIES, INC. OR BY A STATE APPROVED THIRD PARTY TESTING AGENCY FOR THE USE INTENDED WHERE A STANDARD FOR SUCH MATERIALS AND USE EXISTS. ALL ITEMS OF THE SAME
- TYPE AND RATING SHALL BE IDENTICAL AND OF THE SAME MANUFACTURER. E. CONTRACTOR SHALL SUBMIT SHOP DRAWINGS AND CATALOG DATA IN ELECTRONIC FORMAT (PDF) FOR ALL ELECTRICAL ITEMS IN THE SCOPE OF WORK, INCLUDING, BUT NOT LIMITED TO, RACEWAYS, BOXES, FITTINGS, CONDUCTORS, LUMINAIRES, LAMPS, BALLASTS, WIRING DEVICES, SAFETY SWITCHES, DISCONNECTS, TRANSFORMERS, PANELBOARDS, FIRE ALARM, TELECOMMUNICATIONS, ETC. FOR APPROVAL AS APPLICABLE FOR THE PROJECT. ONE COMPLETE SET OF APPROVED
- SUBMITTALS SHALL BE MAINTAINED AT THE JOB SITE. F. ALL COST ASSOCIATED WITH SUBSTITUTED EQUIPMENT TO COMPLY WITH THE BASIS OF DESIGN. INCLUDING PROVIDING MAINTENANCE ACCESS, CLEARANCE, CONDUIT, WIRING, REPLACEMENT OF OTHER SYSTEM COMPONENTS, BUILDING ALTERATIONS, METHODS, ETC., SHALL BE INCLUDED IN THE ORIGINAL BASE BID. NO ADDITIONAL COSTS ASSOCIATED WITH SUBSTITUTED EQUIPMENT WILL BE APPROVED AFTER BIDS HAVE BEEN ACCEPTED AND ALL COSTS WILL BE THE RESPONSIBILITY OF THE ELECTRICAL CONTRACTOR. CREDITS SHALL BE GIVEN TO THE OWNER WHERE SUCH EQUIPMENT AND METHODS RESULT IN LESS EXPENSE TO THE CONTRACTOR.
- G. ONE COMPLETE SET OF THE LATEST CONSTRUCTION PLANS OF ALL TRADES SHALL BE MAINTAINED AT THE JOB SITE. IN ADDITION, ALL ADDENDUMS, BULLETINS, AND/OR SKETCHES SHALL BE INCORPORATED INTO THE ON-SITE CONSTRUCTION PLANS AS THE JOB PROGRESSES.
- H. COMPLETELY ADEQUATE HOUSING SHALL BE PROVIDED FOR ALL MATERIALS STORED ON JOB SITE. ONLY CONDUIT MAY BE STORED OUTSIDE, BUT NOT IN CONTACT WITH THE GROUND. THE CONDUIT AND NEUTRAL SYSTEM SHALL BE GROUNDED AT THE MAIN SERVICE EQUIPMENT.
- I. GROUNDING ELECTRODE SYSTEM SHALL BE INSTALLED PER NEC 250. J. PROVIDE AN INTERSYSTEM BONDING TERMINATION DEVICE AT THE MAIN ELECTRICAL SERVICE PER
- WIRING SHALL BE REPLACED AT NO ADDITIONAL EXPENSE TO THE OWNER. PROVIDE ALL CUTTING AND PATCHING FOR INSTALLATION OF WORK AND REPAIR ANY DAMAGE DONE M. THE ELECTRICAL CONTRACTOR SHALL CONNECT ALL EQUIPMENT REQUIRING ELECTRICAL CONNECTIONS (UNLESS OTHERWISE NOTED), EXCEPT FOR CONTROL WIRING FOR EQUIPMENT NOT

PROVIDED BY THE ELECTRICAL CONTRACTOR. CONTROL WIRING FOR SUCH EQUIPMENT SHALL BE

K. WIRING SHALL BE TESTED FOR CONTINUITY AND GROUNDS BEFORE BEING ENERGIZED. FAULTY

- PROVIDED BY THE RESPECTIVE DISCIPLINE. N. ALL ELECTRICAL JUNCTION BOXES, SWITCHGEAR, CABLING, VOICE/DATA OUTLETS, LOW VOLTAGE CABINETS, EMERGENCY RECEPTACLES, ETC. SHALL BE LABELED ACCORDING TO PANEL/RACK AND
- O. UPON COMPLETION OF WORK, CONTRACTOR SHALL PRESENT ENGINEER WITH CERTIFICATE OF APPROVAL FROM LOCAL INSPECTOR AND/OR AUTHORITY HAVING JURISDICTION BEFORE WORK WILL
- BE APPROVED FOR FINAL PAYMENT. P. CONTRACTOR SHALL GUARANTEE ALL WORK AND MATERIALS FOR A PERIOD OF ONE YEAR EFFECTIVE THE DATE THE PROJECT IS ACCEPTED BY THE OWNER. ANY IMPERFECT MATERIALS OR WORKMANSHIP SHALL BE REPLACED WITHOUT ADDED COST TO THE PROJECT.
- Q. IT SHALL NOT BE THE INTENT OF ISSUED PLANS AND/OR SPECIFICATIONS TO SHOW EVERY MINOR DETAIL OF CONSTRUCTION. THE ELECTRICAL CONTRACTOR IS EXPECTED TO FURNISH AND INSTALL ALL NECESSARY ITEMS FOR A COMPLETE AND OPERATING SYSTEM.
- R. THE WORD "PROVIDE" MEANS THAT THIS CONTRACTOR SHALL FURNISH, FABRICATE, ERECT, CONNECT, AND COMPLETELY INSTALL SYSTEMS IN PROPER OPERATING CONDITION. ALL LABOR, PRODUCT OPTIONS, ACCESSORIES AND INCIDENTAL MATERIALS REQUIRED SHALL BE INCLUDED AS PART OF THIS WORK TO COMPLETE THE INSTALLATION. S. THE WORD "CONNECT" MEANS THAT THIS CONTRACTOR SHALL PROVIDE (SEE DEFINITION ABOVE)
- ALL DISCONNECTING MEANS, OVERCURRENT PROTECTION AND WIRING REQUIRED TO PLACE THE EQUIPMENT AND SYSTEMS IN PROPER OPERATING CONDITION AND TO COMPLY WITH CODE
- T. CONTRACTOR SHALL COORDINATE THE ROUGH-IN OF ALL OUTLET LOCATIONS WITH ARCHITECTURAL FLOOR PLANS, ELEVATIONS, AND MILLWORK SHOP DRAWINGS PRIOR TO ROUGH-IN.
- U. ELECTRICAL CONTRACTOR SHALL NOT SCALE PLANS CONTRACTOR SHALL REFER TO ARCHITECTURAL PLANS AND ELEVATIONS FOR EXACT LOCATIONS OF ALL EQUIPMENT, UNLESS OTHERWISE NOTED.
- V. CONTRACTOR SHALL TEST ALL "LIFE SAFETY" EQUIPMENT AND SYSTEMS FOR PROPER FUNCTION V. AND OPERATION. UPON SUCCESSFUL COMPLETION OF TESTS, CONFIRMATION SHALL BE SENT TO THE ENGINEER OF RECORD IN THE FORM OF A LETTER STATING THE TESTS PERFORMED, THE RESULTS, AND THE DATE TESTS WERE SUCCESSFULLY COMPLETE. "LIFE SAFETY" EQUIPMENT AND SYSTEMS CONSIST OF THOSE AS SPECIFIED IN THE STATE BUILDING CODE. THE NATIONAL ELECTRICAL CODE (NEC), NFPA 101, AND ANY OTHER LOCAL REQUIREMENTS THAT MAY APPLY.
- W. IF DURING THE COURSE OF WORK, THE CONTRACTOR DISCOVERS A PROBLEM WITH THE PERFORMANCE OF THE INSTALLATION RELATIVE TO THE PLANS AND SPECIFICATIONS, THE NEC, OR OTHER CODES OR REQUIREMENTS, THE CONTRACTOR SHALL IMMEDIATELY BRING THE PROBLEM TO THE ATTENTION OF THE ARCHITECT AND/OR ENGINEER FOR RESOLUTION PRIOR TO THE EXECUTION
- X. WHERE THERE ARE CONFLICTS BETWEEN THE PLANS AND SPECIFICATIONS, THE CONTRACTOR SHALL BRING THE ISSUE TO THE ATTENTION OF THE ENGINEER FOR RESOLUTION PRIOR TO THE EXECUTION OF THE WORK OR ORDERING ANY MATERIALS. NO ADDITIONAL COSTS SHALL BE WARRANTED WITHOUT A CHANGE TO THE PROJECT SCOPE.

#### 2. RACEWAY:

- A. CONDUIT SHALL BE MANUFACTURED BY ALLIED, WHEATLAND, REPUBLIC CONDUIT, WESTERN TUBE, OR APPROVED EQUIVALENT.
- B. FOR INTERIOR WORK, CONDUIT SHALL BE ZINC COATED EMT EXCEPT WHERE NOT PERMITTED BY CODE. USE SCHEDULE 40 PVC BELOW CONCRETE SLAB, IN DUCTBANKS, AND FOR EXTERIOR WORK WHERE NOT SUBJECT TO DAMAGE. USE IMC WHERE SUBJECT TO PHYSICAL DAMAGE.
- C. EMT FITTINGS SHALL BE COMPRESSION GLAND TYPE, OF MALLEABLE STEEL. CONNECTORS SHALL HAVE INSULATED THROATS. CAST, SET SCREW, OR INDENTER TYPE FITTINGS ARE NOT ACCEPTABLE. ALL FITTINGS FOR EMT SHALL BE MADE OF STEEL.
- D. ALL RACEWAY SHALL BE RUN CONCEALED, UNLESS OTHERWISE NOTED. FISH ALL NEW OUTLETS IN EXISTING WALLS, WHERE POSSIBLE. ALL RUNS SHALL BE NEAT AND SQUARE. E. LOW VOLTAGE CABLING NOT SPECIFIED TO BE INSTALLED IN CONDUIT, SHALL BE INSTALLED IN A E.
- CABLE TRAY SYSTEM OR J-HOOK SYSTEM CONSISTING OF MINIMUM 2" DIAMETER HOOKS LOCATED ON 3'-0" CENTERS IN ALL ACCESSIBLE CEILINGS. WHERE THERE ARE INACCESSIBLE CEILINGS, PROVIDE CONDUIT FOR ENTIRE LENGTH OF INACCESSIBILITY. F. RACEWAYS USED FOR LOW VOLTAGE SYSTEMS SUCH AS TELECOMMUNICATIONS, FIRE ALARM, SECURITY, CCTV, CONTROLS, AND SIMILAR CONDUITS ABOVE THE CEILING AND BACKBOARD(S)
- SHALL BE PROVIDED WITH INSULATED THROAT BUSHINGS AT EACH CONDUIT TERMINATION. THESE BUSHINGS SHALL BE BE INSTALLED PRIOR TO PULLING LOW-VOLTAGE CABLES. G. RACEWAY PENETRATIONS THROUGH FLOOR SLABS AND FIRE-RATED WALLS SHALL BE FILLED WITH IMPERVIOUS, NON-SHRINK GROUT SUFFICIENTLY TIGHT TO PREVENT THE TRANSFER OF SMOKE,
- WATER, AND DUST. ROOF PENETRATIONS SHALL BE WITHIN THE EQUIPMENT ROOF CURB. H. SUPPORT ALL CONDUIT WITH STRAPS AND CLAMPS. I. ALL CONDUIT SHALL BE RUN PARALLEL OR PERPENDICULAR TO BUILDING LINES, WHETHER EXPOSED
- OR NOT AND SUPPORTED FROM STRUCTURE AND PROPERLY SECURED. J. WHERE CONDUITS PASS THROUGH A BUILDING EXPANSION JOINT, PROVIDE GALVANIZED EXPANSION FITTINGS WITH BONDING JUMPERS. K. MINIMUM CONDUIT SIZE SHALL BE 3/4" FOR INTERIOR WORK, 1" FOR EXTERIOR WORK.
- PROVIDE MINIMUM 210# TEST NYLON PULL CORD AND NYLON BUSHINGS IN ALL EMPTY RACEWAYS. M. LIQUID-TIGHT METAL CONDUIT SHALL ONLY BE USED FOR FINAL CONNECTIONS TO EQUIPMENT AND ALL OTHER ROTATING AND VIBRATING EQUIPMENT, MAXIMUM LENGTH OF 3'-0".
- N. FLEXIBLE METAL CONDUIT, MINIMUM SIZE 3/8", SHALL ONLY BE USED FOR FINAL CONNECTION TO N. LIGHTING FIXTURES, MAXIMUM LENGTH OF 6'-0". O. PROVIDE PULL BOXES, SUCH THAT NO SINGLE CONDUIT RUN HAS BENDS IN EXCESS OF 360°. PULL O.
- BOXES SHALL BE SUITABLE AND APPROVED FOR THE INTENDED USE. WHERE CONDUITS PASS UNDER PAVED AREAS, THEY SHALL BE RGS. P. ALL CONDUIT BENDS/ELBOWS EMERGING FROM UNDERGROUND SHALL BE IMC AND SHALL EXTEND A
- MINIMUM OF 18" BELOW GRADE. Q. ALL UNDERGROUND RACEWAYS SHALL BE THOROUGHLY COATED WITH TWO COATS OF ASPHALTUM
- R. ALL CONDUITS INSTALLED UNDERGROUND OR IN CONCRETE SHALL HAVE JOINTS MADE WATERTIGHT BY USE OF POLYETRA-FLUOROETHYLENE TAPE. S. THE USE OF AC OR NM CABLE IS NOT PERMITTED.

## 3. OUTLET BOXES:

- A. JUNCTION AND PULL BOXES SHALL BE CODE GAUGE GALVANIZED STEEL. ACCEPTED MANUFACTURERS SHALL BE STEEL CITY (THOMAS & BETTS), RACO, CROUSE-HINDS, APPLETON (EMERSON), OR APPROVED EQUIVALENT
- B. OUTLET BOXES SHALL NOT BE MOUNTED BACK TO BACK IN COMMON WALLS. C. ATTACH EMT WITH CONNECTORS HAVING INSULATED THROAT.
- D. ATTACH BOXES TO STUD WORK USING CADDY BAR STRAPS THAT CONNECT TO TWO ADJACENT STUDS TO PREVENT TWISTING OF BOX IN WALL E. ALL OUTLET BOXES (INCLUDING TELEPHONE, CABLE TV, AND COMPUTER) SHALL HAVE COVER
- PLATES, BLANK IF NOT USED. F. ALL EXTERIOR BOXES SHALL BE WATER-TIGHT

## 4. CONDUCTORS

- A. CONDUCTORS SHALL BE MANUFACTURED BY SOUTHWIRE (SIMPULL), ENCORE (SUPERSLICK), A. UNITED COPPER (SLK), CERRO (SLP), OR APPROVED EQUAL, "PRE-LUBRICATED" BY THE MANUFACTURER.
- B. ALL CONDUCTORS SHALL BE COPPER, RATED 75° C WET/DRY EXCEPT WHERE OTHERWISE NOTED B.
- OR REQUIRED BY U.L. OR OTHER CODES. C. ALL CONDUCTORS SHALL BE SINGLE INSULATED CONDUCTOR, THHN/THWN-2. SIZES #10 AWG C. AND SMALLER SHALL BE SOLID, SIZES #8 AWG AND LARGER SHALL BE STRANDED.

BROWN/ORANGE/YELLOW FOR 277/480 VOLT SYSTEMS FOR A. B. AND C PHASES. RESPECTIVELY.

BRANCH CIRCUITS SHALL NOT BE SMALLER THAN #12 AWG. CONTROL WIRING MAY BE #14 AWG. CONDUCTORS SHALL BE COLOR CODED BLACK/RED/BLUE FOR 120/208 VOLT SYSTEMS AND

- NEUTRAL SHALL BE WHITE FOR 120/208 VOLT SYSTEMS AND NATURAL GRAY FOR 277/480 VOLT SYSTEMS. GROUND CONDUCTOR SHALL BE GREEN ON ALL SYSTEMS. ALL CONDUCTOR SIZES SHALL HAVE COLOR-CODED INSULATION. THE USE OF COLORED TAPE ON LARGER WIRE SIZES SHALL NOT INSULATION SHALL BE DUAL RATED TYPE THHN/THWN-2 FOR FEEDERS AND BRANCH CIRCUITS.
- FIXTURE TAPS SHALL BE #12 THHN/THWN-2 IN FLEX WITH GREEN #12 AWG GROUNDING CONDUCTOR. G. ALL CONDUCTORS SHALL BE IN CONDUIT.
- H. WIRING TO LIGHTING FIXTURES SHALL BE AS REQUIRED BY UL LABEL. I. MULTI-WIRE BRANCH CIRCUITS SHALL NOT BE ALLOWED, UNLESS EXPLICITLY INDICATED ON THE I. DRAWINGS. WHERE EXPLICITLY INDICATED ON THE DRAWINGS: 1) ALL 20A MULTI-WIRE RECEPTACLE CIRCUITS SHALL UTILIZE A #10 AWG NEUTRAL CONDUCTOR.
- 2) ONLY WHERE PERMITTED UNDER "RACEWAYS". MC CABLE ASSEMBLIES CAN BE AFC "SUPER NEUTRAL" OR EQUAL, UNLESS OTHERWISE INDICATED ON THE DRAWINGS. WHERE MULTI-WIRE BRANCH CIRCUITS ARE EXPLICITLY INDICATED ON THE DRAWINGS, THEY SHALL BE INSTALLED

- PER NEC 210.4. MEANS SHALL BE PROVIDED TO SIMULTANEOUSLY DISCONNECT ALL UNGROUNDED CONDUCTORS AT THE POINT WHERE THE BRANCH CIRCUIT ORIGINATES IN
- ADDITION TO OTHER REQUIREMENTS PER NEC 210.4. J. JOINTS IN #10 AWG AND SMALLER SHALL BE MADE UP WITH CRIMPED CONNECTORS WITH INSULATING CAPS (NO TAPE) OR WIRENUTS (MAXIMUM OF 3 CONDUCTORS UNDER ANY CONNECTOR OR
- WIRENUT). LARGER WIRE SHALL USE SPLIT BOLTS OR BOLTED CLAMPS. K. ALL WIRING LUGS THROUGHOUT THE PROJECT, INCLUDING, BUT NOT LIMITED TO, BREAKERS, PANELBOARD/SWITCHBOARD LUGS, SAFETY SWITCH LUGS, MOTOR STARTER LUGS, TRANSFORMERS LUGS, WIRING DEVICE TERMINALS, AND ALL EQUIPMENT LUGS/TERMINALS SHALL BE RATED FOR USE WITH 75 DEGREE INSULATED CONDUCTORS AT THEIR 75 DEGREE AMPACITY AND SHALL BE SIZED AND SELECTED TO MATCH THE CONDUCTOR SIZE AND MATERIAL.
- CIRCUIT JOINTS SHALL NOT BE MADE ON DEVICE TERMINALS.
- M. WIRE WITHIN PANELBOARDS SHALL BE NEATLY TRAINED, SQUARED, BUNCHED, AND TAGGED. N. ALL SYSTEM FURNITURE CONNECTIONS SHALL COMPLY WITH NEC 605.
- O. GROUND ALL EQUIPMENT PER NEC ARTICLE 250. BOND WHERE CONDUITS ENTER ENCLOSURES O. THROUGH CONCENTRIC KNOCKOUTS. ALL FLEX, INCLUDING FIXTURE TAPS, SHALL INCLUDE GREEN GROUNDING CONDUCTOR, #12 AWG MINIMUM. PROVIDE GREEN INSULATED EQUIPMENT GROUNDING CONDUCTOR IN EACH CONDUIT AND FOR EACH CIRCUIT, SIZED PER NEC 250-122.

P. ALL CONDUCTORS INSTALLED IN VERTICAL RACEWAYS SHALL BE SUPPORTED AT INTERVALS AS

FIRST DEVICE ON THE BRANCH CIRCUIT AND ACHIEVE A MAXIMUM OF 5% VOLTAGE DROP ACROSS

REQUIRED PER NEC 300-19. Q. THE ELECTRICAL CONTRACTOR SHALL FOLLOW AND APPLY THE TABLE BELOW, REGARDLESS WHAT THE PANEL SCHEDULE INDICATES, FOR SIZING ALL 120V & 277V, 20 AMP BRANCH CIRCUITS (COPPER CONDUCTORS) TO ALLOW A MAXIMUM OF 3% VOLTAGE DROP FROM THE CIRCUIT BREAKER TO THE

VOLTAGE	CONDUCTOR LENGTH *	BRANCH CIRCUIT
120	0' - 50'	#12
120	51' - 90'	#10
120	91' - 140'	#8
120	141' - 225'	#6

\* - THE LENGTH IS MEASURED FROM THE CIRCUIT BREAKER TO THE FIRST DEVICE WHICH THE BRANCH CIRCUIT SERVES. WHERE THE DISTANCE EXCEEDS ABOVE, CONSULT WITH THE ENGINEER.

#### 5. WIRING DEVICES:

A. WIRING DEVICES SHALL BE SPECIFICATION GRADE, MINIMUM, EQUAL TO COOPER QUALITY A. INDICATED BELOW OR AS MANUFACTURED BY HUBBELL, LEGRAND-PASS & SEYMOUR, LEVITON, OR APPROVED EQUAL, UNLESS OTHERWISE NOTED: DUPLEX RECEPTACLES SHALL HAVE A NYLON FACE AND SHALL BE AS FOLLOWS:

SWITCHES (120/277V) SHALL BE AS FOLLOWS: SINGLE-POLE 20 AMP COOPER AH1221 DOUBLE-POLE 20 AMP COOPER AH1222 THREE-WAY 20 AMP COOPER AH1223

THE ENTIRE BRANCH CIRCUIT:

FOUR-WAY 20 AMP COOPER AH1224 DUPLEX RECEPTACLES SHALL HAVE A NYLON FACE AND SHALL BE AS FOLLOWS: 15 AMP DUPLEX **COOPER 5252** 

20 AMP DUPLEX COOPER 5352 15 AMP DUPLEX GFCI COOPER SGF15F 20 AMP DUPLEX GFCI COOPER SGF20F

THE PART NUMBERS ABOVE ARE FOR WIRING DEVICE TYPE ONLY. SEE BELOW FOR WIRING DEVICE COLOR AND PLATE MATERIAL/COLOR.

- B. SEE MOUNTING HEIGHT ELEVATION DETAIL FOR STANDARD MOUNTING HEIGHTS OF ALL DEVICES, B. UNLESS OTHERWISE NOTED. C. THE COLOR OF ALL WIRING DEVICES (SWITCHES AND RECEPTACLES) SHALL BE AS DIRECTED BY THE
- ARCHITECT, UNLESS OTHERWISE NOTED. ALL COVER PLATES SHALL BE 302 STAINLESS STEEL. COVER PLATES IN MASONRY WALLS SHALL BE JUMBO SIZE. D. EACH DUPLEX RECEPTACLE INDICATED TO BE ON A DEDICATED CIRCUIT SHALL BE 20 AMP TYPE. ADJACENT DEVICES SHALL HAVE A COMMON WALL PLATE.
- WEATHERPROOF COVERS SHALL BE "WHILE-IN-USE" SO PLUGS MAY BE INSTALLED WITHOUT COMPROMISING THE WP FUNCTION. COOPER #WIU-2 DOUBLE-GANG WITH CLEAR COVER OR
- APPROVED EQUAL. G. A MAXIMUM OF 10 GENERAL PURPOSE RECEPTACLES SHALL BE ON EACH BRANCH CIRCUIT. H. DIMMERS SHALL BE LINEAR SLIDE, PRESENT ON/OFF, SQUARE LAW DIMMING, W/RFI FILTERING AND
- VOLTAGE COMPENSATION CIRCUITING. I. ALL WALL MOUNTED OCCUPANCY/VACANCY SENSORS/SWITCHES SHALL BE INSTALLED WITH AN EQUIPMENT GROUNDING CONDUCTOR.
- GROUND-FAULT CIRCUIT-INTERRUPTER (GFCI) PROTECTION FOR PERSONNEL SHALL BE PROVIDED FOR ALL LOCATIONS PER NEC 210.8, INSTALLED IN A READILY ACCESSIBLE LOCATION, WHERE A DEVICE LOCATION IS NOT ACCESSIBLE, THE GFCI PROTECTION SHALL BE PROVIDED WITH THE BREAKER SERVING THE DEVICE
- K. ALL GFCI RECEPTACLES SHALL HAVE AUTO-MONITORING / SELF-TEST FUNCTION AND REVERSE LINE-LOAD MISFIRE FUNCTION AND MEET ALL REQUIREMENTS OF UL 943 (LATEST EDITION).

#### 6. <u>SUPPORTS:</u>

- A. ALL EQUIPMENT SHALL BE ADEQUATELY SUPPORTED FROM STRUCTURE. B. INSERTS IN MASONRY SHALL BE LEAD OR FIBER IN DRILLED HOLES, OR CAST IN PLACE.
- NAILS OR POWDER ACTUATED FASTENERS SHALL NOT BE USED. D. EMT/IMC/RGS SUPPORTS SHALL BE A MAXIMUM OF 8'-0" APART AND A MAXIMUM OF 3'-0" FROM BOXES. E. LIGHTING FIXTURES MOUNTED IN OR ON CEILING SHALL BE SUPPORTED FROM STRUCTURE VIA 12 GAUGE STEEL WIRE. PROVIDE A MINIMUM OF FOUR WIRES, ONE ATTACHED TO EACH CORNER OF LAY-IN FIXTURES. RECESSED DOWNLIGHT FIXTURES SHALL BE SUPPORTED THE SAME. DO NOT SUPPORT RACEWAY OR FIXTURES FROM CEILING GRID OR DUCT WORK. USE U.L. LISTED GRID CLIPS

## 7. PAINTING:

A. SUITABLE FINISH COAT SHALL BE PROVIDED FOR ALL EQUIPMENT. PANEL TUBS, COVERS, ETC. SHALL BE PRIMED AND ENAMELED TO BLEND WITH ADJACENT SURFACES, OR SHALL BE MANUFACTURER'S STANDARD COLOR BAKED ENAMEL FINISH, OR AS DIRECTED BY THE ARCHITECT.

## 8. TELECOMMUNICATIONS:

ON ALL LAY-IN FIXTURES.

- A. FURNISH A COMPLETE TELEPHONE CONDUIT SYSTEM AS INDICATED ON THE DRAWINGS. B. TELECOMMUNICATION OUTLETS SHALL CONSIST OF A 4" SQUARE DEEP BOX WITH SINGLE GANG PLASTER RING. PROVIDE BLANK PLATE WITH KNOCKOUTS FOR OUTLETS, AS PERMANENT COVERS
- WILL BE PROVIDED BY A SEPARATE INSTALLER. PROVIDE MINIMUM 1" RACEWAY, UNLESS OTHERWISE NOTED, FROM EACH BOX TO ABOVE NEAREST ACCESSIBLE CEILING SPACE FOR J-HOOK SYSTEM OR TO CABLE TRAY AS APPLICABLE. PROVIDE MINIMUM 210# TEST NYLON PULL CORD AND NYLON BUSHINGS IN ALL EMPTY RACEWAYS.
- PROVIDE RACEWAYS FOR ALL EXTERIOR AND/OR EXPOSED LOCATIONS. E. PROVIDE GROUNDING FOR ALL TELEPHONE/DATA SYSTEMS AND EQUIPMENT PER REQUIREMENTS AND SPECIFICATIONS PROVIDED BY THE OWNERS DESIGNATED VENDOR.

## 9. LIGHTING FIXTURES:

F. ALL LOW-VOLTAGE CABLING SHALL BE PLENUM-RATED.

- A. TYPES AND MANUFACTURERS ARE SCHEDULED ON THE PLANS. EQUIVALENT FIXTURES BY OTHERS MAY BE SUBMITTED ONLY AS INDICATED ON THE PLANS AND ARE SUBJECT TO THE APPROVAL OF
- B. ALL FIXTURES SHALL BE U.L. LISTED AND LABELED. C. LAMPS SHALL BE GENERAL ELECTRIC, PHILIPS, OR OSRAM/SYLVANIA EXCEPT WHERE OTHERWISE NOTED IN THE LIGHTING FIXTURE SCHEDULE OR OTHERWISE NOTED. ALL FIXTURES SHALL BE
- BALLASTS SHALL BE AS INDICATED IN THE LIGHTING FIXTURE SCHEDULE OR AS OTHERWISE NOTED. E. ALL FIXTURES SHALL BE PROVIDED FOR PROPER VOLTAGE BASED ON THE CIRCUIT ASSIGNMENT
- INDICATED ON THE PLANS. F. CATALOG NUMBERS ARE FOR GENERAL IDENTIFICATION OF FIXTURES ONLY. ALL RELATED PARTS, SUCH AS PLASTER RINGS, JUNCTION BOXES, LOUVERS, SHIELDS, MOUNTING STEMS, CANOPIES, CONNECTORS, STRAPS, NIPPLES, HARDWARE, ACCESSORIES, ETC., TO FIT THEM PROPERLY TO THE CONSTRUCTION, SHALL BE FURNISHED AND INSTALLED BY THIS CONTRACTOR. CONTRACTOR SHALL PROVIDE SUITABLE TRIM AND APPURTENANCES TO MOUNT FIXTURES IN TYPE OF CEILING OR WALL
- G. ALL FIXTURES SHALL BE GROUNDED PER THE NEC H. FIXTURES CONNECTED WITH FLEX TO THE RIGID RACEWAY PORTION OF THE WIRING SYSTEM SHALL CARRY A GREEN BONDING JUMPER WITHIN THE FLEX. THE JUMPER SHALL BE FASTENED TO BOTH THE FIXTURE AND THE RACEWAY SYSTEM WITH A STEEL CITY "G" CLIP OR APPROVED EQUIVALENT. PHASE AND GROUND CONDUCTORS RUN IN FLEX SHALL BE #12 AWG MINIMUM. MAXIMUM FLEX MOUNT ALL FIXTURES PLUMB AND SQUARE WITH ROWS ALIGNED.

AS SPECIFIED IN ARCHITECTURAL FINISH SCHEDULES REGARDLESS OF CATALOG NUMBER GIVEN.

- J. SEE ARCHITECTURAL REFLECTED CEILING PLANS FOR EXACT LOCATION OF FIXTURES. K. CONTRACTOR SHALL COORDINATE FIXTURE TYPE AND TRIM WITH CEILING CONSTRUCTION AND
- ADJUST ACCORDINGLY WITHOUT ADDITIONAL EXPENSE. L. ALL LIGHTING FIXTURES SHALL BE THERMALLY PROTECTED PER THE NEC.

## 10. EQUIPMENT IDENTIFICATION:

- A. PROVIDE ENGRAVED PHENOLIC NAMEPLATES FOR ALL ELECTRICAL EQUIPMENT SUPPLIED FOR THE PROJECT, INCLUDING BUT NOT LIMITED TO, WIRING TROUGHS, SAFETY SWITCHES, DISCONNECTS, TRANSFORMERS, PANELBOARDS, ETC. NAMEPLATE SHALL INDICATE THE DEVICE NAME, SYSTEM VOLTAGE (VOLTAGE/PHASE/WIRE), AND UPSTREAM DEVICE AND CIRCUIT. PROVIDE NAMEPLATES FOR CIRCUIT BREAKERS IN SWITCHGEARS, SWITCHBOARDS AND DISTRIBUTION PANELS.
- 120/208V EQUIPMENT BLUE SURFACE WITH WHITE CORE EMERGENCY SYSTEMS GREEN SURFACE WITH WHITE CORE BRIGHT RED SURFACE WITH WHITE CORE FIRE ALARM SYSTEM SECURITY SYSTEMS BURGUNDY SURFACE WITH WHITE CORE ORANGE SURFACE WITH WHITE CORE TELEPHONE SYSTEMS DATA SYSTEMS BROWN SURFACE WITH WHITE CORE TV SYSTEMS PURPLE SURFACE WITH WHITE CORE
- WHITE SURFACE WITH BLACK CORE PAGING SYSTEMS NAMEPLATES UP TO 8 SQUARE INCHES SHALL NOT BE LESS THAN 1/16" THICK. NAMEPLATES LARGER THAN 8 SQUARE INCHES SHALL NOT LESS THAN 1/8" THICK.
- D. LETTERING HEIGHT SHALL BE 1/2" MINIMUM. E. NAMEPLATES SHALL BE ATTACHED WITH SELF-DRILLING/SELF-TAPPING SCREWS, EXCEPT RIVETS SHALL BE USED WHERE END OF SCREW IS NOT PROTECTED. QUANTITY AS FOLLOWS: UP TO 5 SQUARE INCHES: 2 SCREWS.
  - 5 TO 12 SQUARE INCHES: 4 SCREWS. ABOVE 12 SQUARE INCHES: 6 SCREWS.

B. NAMEPLATE COLORS SHALL BE AS FOLLOWS:

### 11. DISCONNECTS:

- A. DISCONNECT SWITCHES SHALL BE HEAVY-DUTY TYPE IN NEMA 1 ENCLOSURES. UNLESS OTHERWISE NOTED, FUSED OR NON-FUSED AS INDICATED. SWITCHES SHALL HAVE REJECTION-TYPE FUSE CLIPS. SWITCHES SHALL BE BY EATON, SQUARE-D. GENERAL ELECTRIC, OR APPROVED EQUAL, WHERE FED
- FROM A LOAD CENTER, GENERAL-DUTY SWITCHES SHALL BE PERMITTED. B. FUSES LESS THAN 60A SHALL BE CLASS RK5, DUAL-ELEMENT, TIME-DELAY WITH INDICATION FUSES GREATER THAN 60A SHALL BE CLASS J, DUAL-ELEMENT, TIME-DELAY WITH INDICATION. D. A SET OF 3 SPARE FUSES OF EACH SIZE AND TYPE SHALL BE FURNISHED TO THE OWNER

### 12. PANELBOARDS:

- A. PANELBOARDS SHALL BE PROVIDED AS MANUFACTURED BY EATON, SQUARE-D, GENERAL A. ELECTRIC, OR APPROVED EQUAL. ALL NEW EQUIPMENT FOR THE PROJECT SHALL BE BY THE SAME MANUFACTURER. LOAD CENTER TYPE PANELBOARDS SHALL BE USED WHERE THE PANELBOARD SERVES A DWELLING UNIT.
- B. ALL BUSSING, INCLUDING NEUTRAL AND GROUND, SHALL BE COPPER. C. ALL BREAKERS SHALL BE AUTOMATIC THERMAL-MAGNETIC TYPE MOLDED CASE BOLT-ON TYPE,
- CALIBRATED FOR 40 DEGREE C, OR AMBIENT COMPENSATION, UNLESS OTHERWISE NOTED. D. PANELS SHALL BE FULLY RATED (AIC). NO SERIES AIC RATINGS ARE ALLOWED.
- E. PANELS SHALL HAVE FULL SIZE EQUIPMENT GROUNDING BARS AND NEUTRAL BARS, EXCEPT WHERE INDICATED TO BE 200%. F. ALL PANELBOARD AND BREAKER LUGS SHALL BE SIZED AND RATED PER THE CONDUCTOR SIZE AND
- G. LIGHTING AND APPLIANCE PANELS (100A-600A) SHALL HAVE FRONT ACCESSIBLE HINGED DOOR-IN-DOOR COVERS WITH DEAD FRONT, SHALL BE 20" WIDE MINIMUM WITH MINIMUM 4" WIDE
- H. DISTRIBUTION PANELS (600A-1200A) SHALL HAVE FRONT ACCESSIBLE DEAD FRONT COVERS. . PROVIDE HANDLE LOCK-ON DEVICES FOR ALL CIRCUIT BREAKERS CONNECTED TO EMERGENCY, EXIT, NIGHT LIGHTING, FIRE ALARM, TELEPHONE BOARDS, AND SECURITY SYSTEMS.
- J. BREAKERS USED FOR SWITCHING SHALL BE SWITCHING DUTY (SWD) RATED. K. BREAKERS USED FOR HEATING, AIR-CONDITIONING AND/OR REFRIGERATION SHALL BE HACR RATED. L. GROUND-FAULT CIRCUIT-INTERRUPTER (GFCI) PROTECTION FOR PERSONNEL SHALL BE PROVIDED FOR ALL LOCATIONS PER NEC 210.8, INSTALLED IN A READILY ACCESSIBLE LOCATION. WHERE A DEVICE LOCATION IS NOT ACCESSIBLE, THE GFCI PROTECTION SHALL BE PROVIDED WITH THE
- M. ARC-FAULT CIRCUIT-INTERRUPTER (AFCI) PROTECTION SHALL BE PROVIDED FOR ALL LOCATIONS PER NEC 210.12, INSTALLED IN A READILY ACCESSIBLE LOCATION. THIS INCLUDES ALL 120V, 15A AND 20A BRANCH CIRCUITS IN DWELLING UNITS, DORMITORY/STUDENT HOUSING UNITS AND HOTEL/MOTEL GUEST ROOMS/SUITES AS DEFINED BY THE NEC. N. ALL OVERCURRENT DEVICES WHICH COMPRISE THE EMERGENCY SYSTEM OR LEGALLY REQUIRED

STANDBY SYSTEM SHALL BE SELECTIVELY COORDINATED. THE ELECTRICAL CONTRACTOR SHALL

PROVIDE MANUFACTURER DOCUMENTATION INDICATING COMPLIANCE WITH THE SELECTIVE

COORDINATION REQUIREMENTS PER THE NEC. O. ALL PANELBOARDS SHALL HAVE METAL DIRECTORY FRAME. FOR EACH PANELBOARD, PROVIDE TYPED CIRCUIT DIRECTORY PER NEC 408.4. SPARE CIRCUIT BREAKERS SHALL BE LABELED SPARE AND IN THE OFF POSITION.

## 13. FIRE ALARM SYSTEM:

BREAKER SERVING THE DEVICE.

- A. NEW DEVICES SHALL BE CONNECTED TO THE EXISTING FIRE ALARM SYSTEM IN COMPLIANCE WITH ALL APPLICABLE NFPA 72 AND OTHER STANDARDS AS WELL AS THE AMERICAN'S WITH DISABILITIES ACT (ADA). ALL FINAL CONNECTIONS, TESTING AND ADJUSTMENTS SHALL BE PERFORMED BY OR UNDER DIRECT SUPERVISION OF AN AUTHORIZED FACTORY REPRESENTATIVE. NEW DEVICES SHALL BE COMPATIBLE WITH THE EXISTING FIRE ALARM SYSTEM. THE CONTRACTOR SHALL FIELD VERIFY EXACT SYSTEM MANUFACTURER AND TYPE AND CAPABILITY TO MEET THE INTENT INDICATED ON THE DRAWINGS
- B. INITIATING DEVICE ACTIVATION SHALL CAUSE OPERATION OF THE PROPER ALARM CIRCUIT IN T CONTROL PANEL, AND OPERATE ALL AUDIBLE AND VISUAL INDICATING ALARMS. ALL AIR HANDLING UNITS SHALL BE STOPPED UPON ANY ALARM INPUT. EACH AIR HANDLER UNIT SHALL BE PROVIDED WITH A SYSTEM CONTROLLED RELAY TO EFFECT SHUTDOWN. ALL ALARM DEVICES AND LAMPS SHALL CONTINUE TO OPERATE UNTIL THE INITIATING DEVICE IS RESET. SUBSEQUENT ALARMS SHALL RESOUND THE SYSTEM. AN AUDIBLE AND VISUAL SIGNAL SHALL INDICATE SYSTEM TROUBLE. THE CONTROL PANEL SHALL PROVIDE FOR ACTIVATING A UL LISTED CENTRAL STATION SIGNAL FOR NOTIFYING THE FIRE DEPARTMENT. C. MANUAL STATIONS SHALL BE NON-CODED, WITH DUAL-ACTION PULL AND KEY TYPE RESET,
- SEMI-FLUSH MOUNTED. COMBINATION LIGHT AND HORN SIGNALS SHALL BE FLUSH MOUNTED. WIRING SHALL BE IN CONDUIT AS PREVIOUSLY SPECIFIED, #14 AWG MINIMUM, THHN. ALL J-BOXES USED FOR THE FIRE ALARM SYSTEM SHALL BE PAINTED RED.
- D. CONDUCTORS SHALL BE PLENUM-RATED AND INSTALLED IN CONDUIT AND INSTALLED IN COMPLIANCE WITH NFPA 70, ARTICLE 760; IN ADDITION TO WIRING METHODS 300.4. ALL FIRE ALARM WIRING SHALL BE CLASS B.
- F. PROVIDE ALL REQUIRED MODULES, POWER EXTENDERS, PROGRAMMING, ETC. FOR A COMPLETE AND G. SUBMIT FIRE ALARM SHOP DRAWINGS CONSISTING OF PRODUCT DATA, TO THE ENGINEER AND FOR
- H. FILL OUT NFPA 72 CERTIFICATION REPORT AND SUBMIT TO ENGINEER AND AUTHORITY HAVING JURISDICTION. I. WARRANTY - ALL WORK PERFORMED AND ALL MATERIALS AND EQUIPMENT FURNISHED UNDER. THIS CONTRACT SHALL BE FREE FROM DEFECTS AND SHALL REMAIN SO FOR A PERIOD OF AT LEAST TWO (2) YEARS FROM THE DATE OF ACCEPTANCE BY THE PROFESSIONAL ENGINEER AND/OR OWNER. THE FULL COST OF MAINTENANCE, LABOR, AND MATERIALS REQUIRED TO CORRECT ANY DEFECT DURING THIS TWO YEAR PERIOD SHALL BE IMMEDIATELY CORRECTED AT NO ADDITIONAL COST TO THE OWNER, ANY DEFECTS THAT RENDER THE SYSTEM INOPERATIVE SHALL BE REPAIRED WITHIN 24
- HOURS OF THE OWNER NOTIFYING THE CONTRACTOR. OTHER DEFECTS SHALL BE REPAIRED WITHIN 48 HOURS OF THE OWNER NOTIFYING THE CONTRACTOR. J. AUDIBLE DEVICES WITHIN SLEEPING ROOMS SHALL PROVIDE A SQUARE WAVE 520HZ TONE

#### COMPATIBLE WITH NFPA 72 18.4.5.3. 14. FIRE STOPPING:

A. ALL PENETRATIONS OF RATED ASSEMBLIES SHALL BE SEALED WITH RATED MATERIALS MEETING ASTM F-8 B. PROVIDE FIRESTOPPING DEVICE(S) OR SYSTEM(S) WHICH HAVE BEEN TESTED AND LISTED AS COMPLYING WITH ASTM E-814.INSTALL THE DEVICE(S) OR SYSTEM(S) IN ACCORDANCE WITH THE CONDITIONS OF THEIR LISTING. PROVIDE THE APPROPRIATE DEVICE(S) OR SYSTEM(S) WITH AN 'F'

RATING EQUAL TO THE RATING OF THE ASSEMBLY BEING PENETRATED.

# DEVICE(S) AND/OR SYSTEM(S) SHALL BE BY HILTI, 3M OR EQUIVALENT.

THE ELECTRICAL CONTRACTOR SHALL BE FULLY RESPONSIBLE FOR PROVIDING SEISMIC SUPPORT AND BRACING OF ELECTRICAL COMPONENTS TO RESIST THE EFFECTS OF EARTHQUAKES ON THE ELECTRICAL SYSTEM AS WELL AS ANY REQUIRED SPECIAL INSPECTIONS BASED ON THE SPECIFIC GEOGRAPHIC LOCATION AS REQUIRED. THE SEISMIC RESTRAINTS AND SPECIAL INSPECTIONS SHALL MEET ALL APPLICABLE STATE AND LOCAL BUILDING CODE REQUIREMENTS AS WELL AS ASCE-7

## 16. **ELECTRICAL COORDINATION WITH OTHER TRADES:**

A. THE ELECTRICAL CONTRACTOR SHALL CONNECT AND/OR PROVIDE FINAL CONNECTIONS TO ALL EQUIPMENT SUPPLIED BY OTHERS APPLICABLE TO THE PROJECT, INCLUDING BUT NOT LIMITED TO, MECHANICAL, PLUMBING, FIRE PROTECTION AND SUPPRESSION, OWNER FURNISHED, KITCHEN, LABORATORY, ETC. UNLESS OTHERWISE NOTED.

EQUIPMENT. ALL STARTERS, OTHER THAN MANUAL STARTER SWITCHES, SHALL BE PROVIDED BY

- B. THE ELECTRICAL CONTRACTOR SHALL COORDINATE ALL CONNECTIONS PRIOR TO ROUGH-IN USING APPROVED CATALOG SHEETS AND SHOP DRAWINGS. C. THE ELECTRICAL CONTRACTOR SHALL PROVIDE AND INSTALL ALL MANUAL MOTOR STARTER SWITCHES, DISCONNECT SWITCHES, RECEPTACLES, ETC. TO MECHANICAL AND PLUMBING
- OTHERS, BUT INSTALLED BY THE ELECTRICAL CONTRACTOR. D. ALL DISCONNECT SWITCHES AND FUSE SIZES SHALL BE COORDINATED WITH SHOP DRAWINGS PRIOR TO ORDERING OR INSTALLING. ANY EQUIPMENT INSTALLED INCORRECTLY BECAUSE OF LACK OF COORDINATION WILL BE REMOVED AND INSTALLED CORRECTLY AT THE EXPENSE OF THE
- ELECTRICAL CONTRACTOR. E. THE ELECTRICAL CONTRACTOR SHALL COORDINATE ALL CONDUIT RUNS AND LIGHT FIXTURE LOCATIONS ABOVE THE CEILING WITH OTHER TRADES PRIOR TO INSTALLATION. F. ALL DUCT SMOKE DETECTORS SHALL BE PROVIDED AND CONNECTED BY THE ELECTRICAL

G. THE ELECTRICAL CONTRACTOR SHALL PROVIDE ALL NECESSARY OUTLETS FOR HEAT TAPE

CONNECTIONS FOR MECHANICAL SYSTEMS. PROVIDE CLASS B (30mA) GFCI PROTECTION ON THE

CONTRACTOR, BUT INSTALLED BY THE MECHANICAL CONTRACTOR.

BREAKER SUPPLYING THE HEAT TAPE H. THE ELECTRICAL CONTRACTOR SHALL PROVIDE 120V POWER AT EACH HVAC UNIT HAVING A CONTROLS POWER SUPPLY. CIRCUIT(S) SHALL BE DEDICATED 20A SERVING A MAXIMUM OF 10 HVAC UNITS PER CIRCUIT. COORDINATE ALL LOCATIONS WITH THE MECHANICAL CONTRACTOR.

CONSULTANTS (ENGINEER):

**NEARBY ENGINEERS** 

382 NE 191ST STREET SUITE 49674, MIAMI, FL 33179 PH-914.257.3455 WWW.NY-ENGINEERS.COM

CONTRACTOR'S NOTES DIMENSIONS. DO NOT SCALE THE DRAWINGS. THE CONTRACTORS MUST VISIT IOB SITE TO VERIEY ALL EXISTING CONDITIONS AND DIMENSIONS BEFORE SUBMITTING BIDS. REPORT ANY DISCREPANCIES OF ANY CONDITIONS WHICH MAY INTERFERE WITH THE PROPER EXECUTION OF, THE CONTRACT TO THE TENANT'S REPRESENTATIVE, REPORT DISCREPANCIES DURING BIDDING PROCESS AND BEFORE START OF CONSTRUCTION. CHANGE ORDERS NEED TO BE APPROVED BY **TOWNSQUARE** CONSTRUCTION

MANAGER FOR ISSUES ARISING FROM THE FIELD

THE EXISTING CONDITIONS PRIOR TO THE

COMMENCEMENT OF WORK

CONDITIONS OR CONFLICTS BETWEEN THE PLANS AND


10.31.24 LL/CLIENT REVIEW SET 11.15.24 LL/CLIENT REVIEW SET 11.22.24 BD SUBMISSION


DATE REVISION


11.15.24 CLIENT COMMENTS

SHEET NUMBER:

ELECTRICAL SPECIFICATION

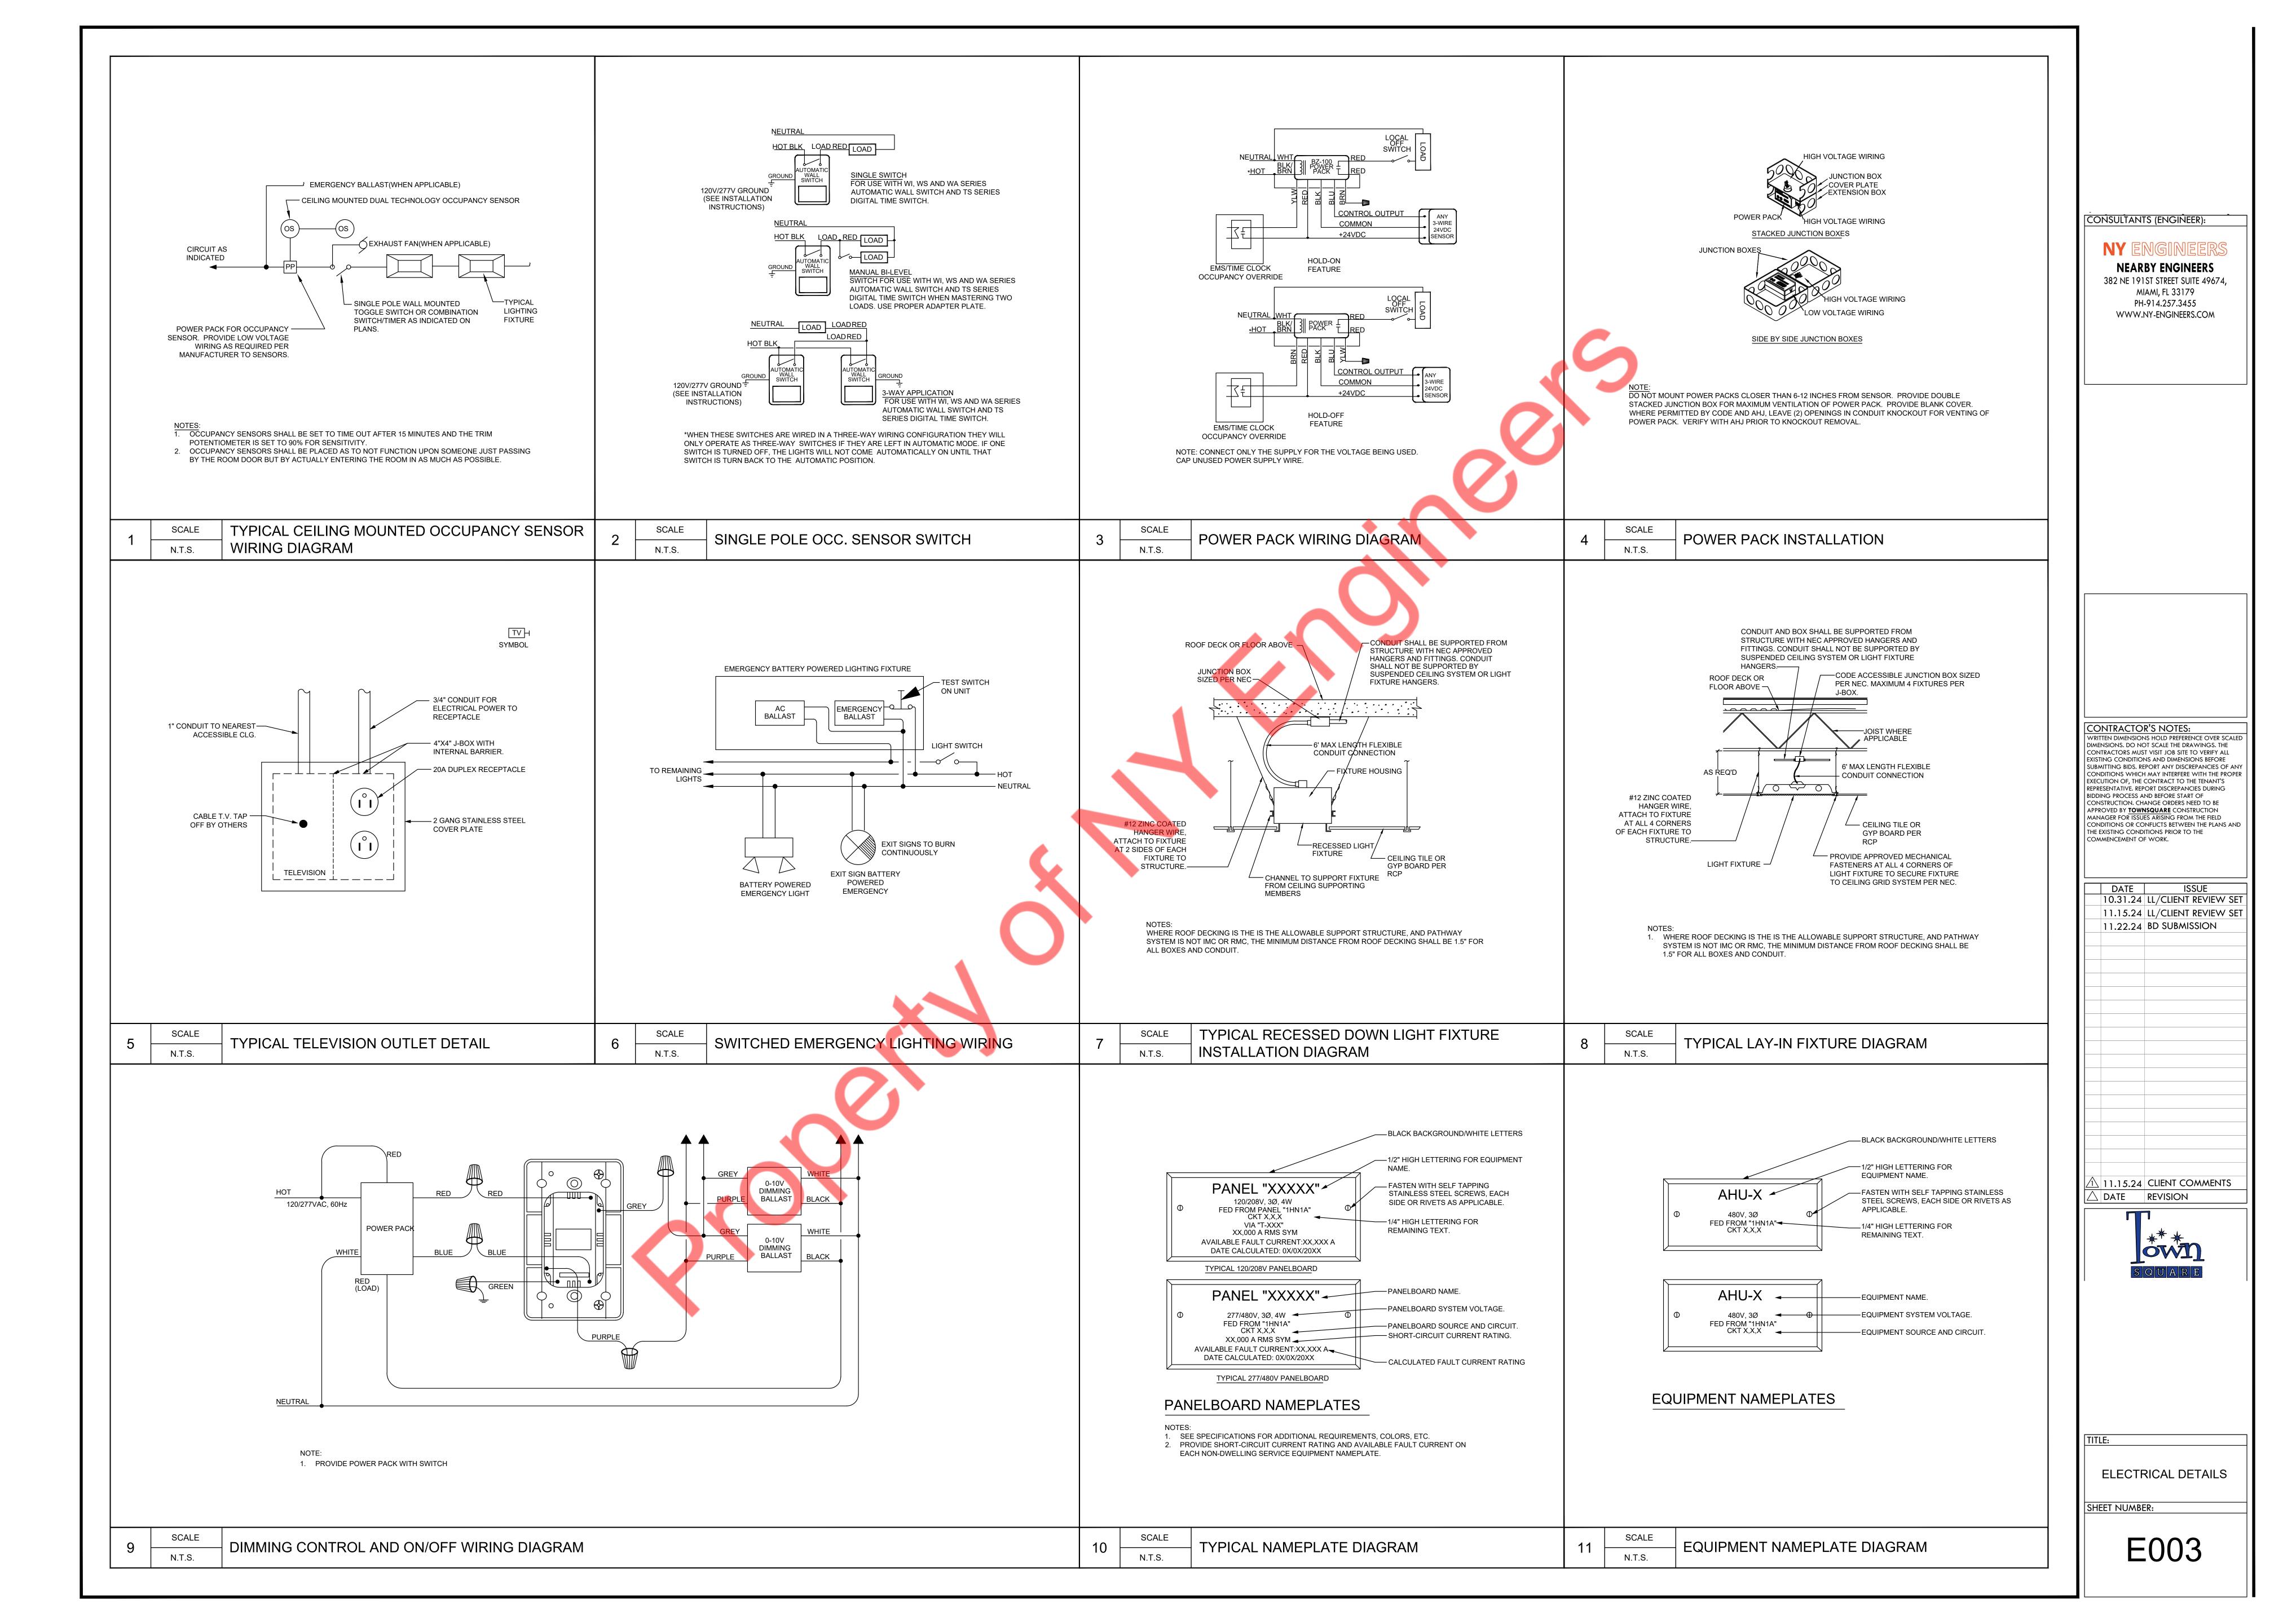

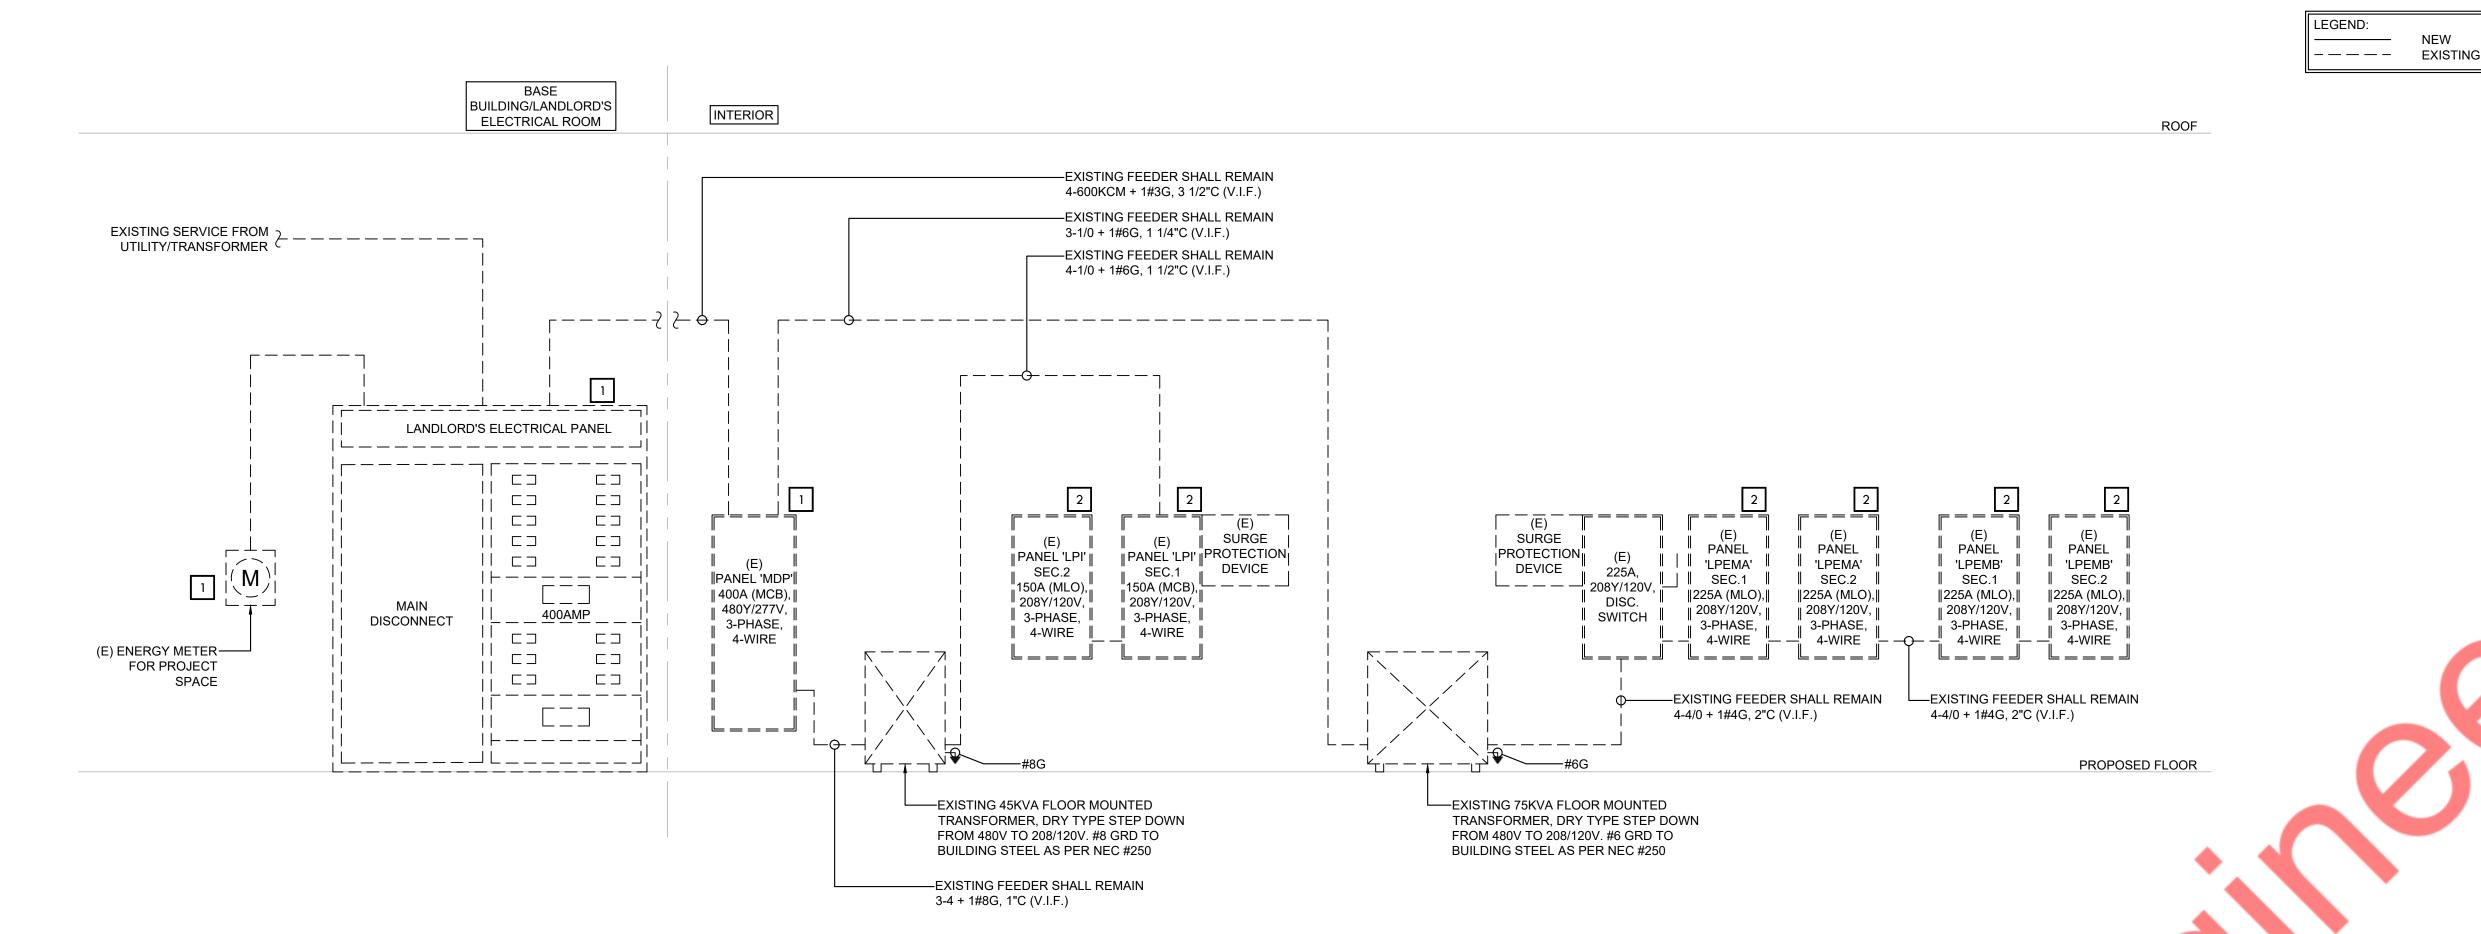

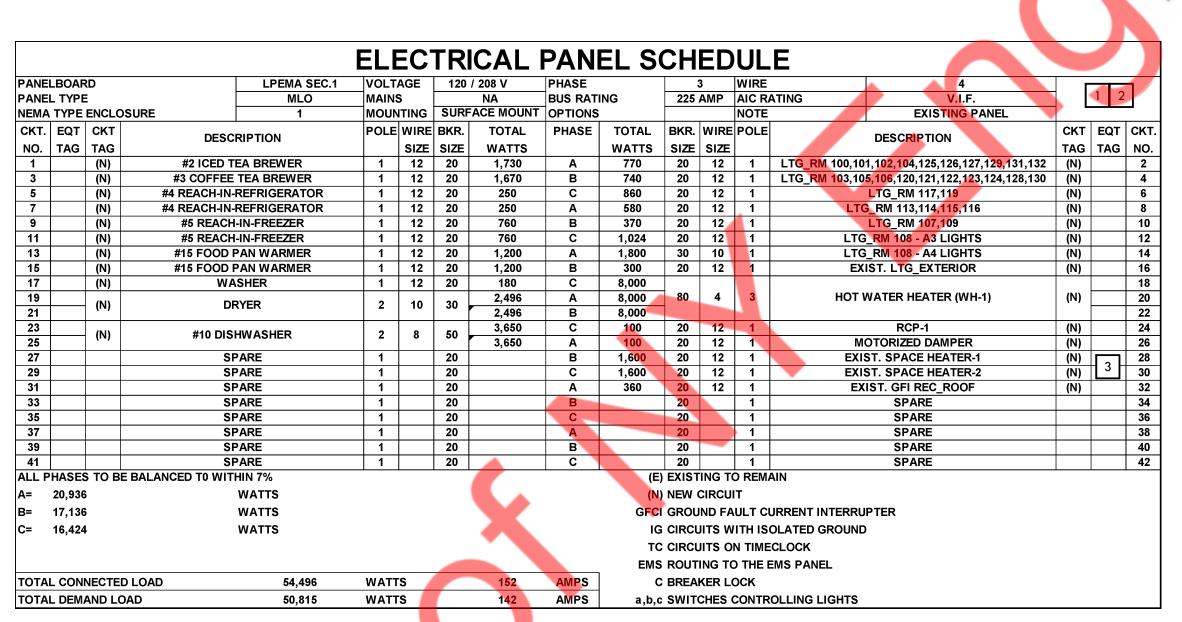

					Ε	LE	CT	RIC	CAL	PANI	EL SO	CH	ED	UL	.E				
PANEI	BOAR	RD		LPEMA S	SEC.2	VOLT	AGE	120	/ 208 V	PHASE		;	3	WIRE	,	4	1		
PANE	_ TYPE	<u> </u>		MLC	)	MAIN	S		NA	BUS RATI	NG	225	AMP	AIC R	ATING	V.I.F.	7		
NEMA	TYPE	<b>ENCLOSUR</b>	E	1		MOUN	ITING	SURFA	CE MOUNT	OPTIONS				NOTE		EXISTING PANEL			
CKT.	EQT	СКТ				POLE	WIRE	BKR.	TOTAL	PHASE	TOTAL	BKR.	WIRE	POLE			СКТ	EQT	CKT.
NO.	TAG	TAG	DESCR	RIPTION			SIZE	SIZE	WATTS		WATTS	SIZE	SIZE		DE	SCRIPTION	TAG	TAG	NO.
43			SPA	ARE		1		20		Α		20		1		SPARE			44
45			SPA	ARE		1		20		В		20		1		SPARE			46
47			SPA	ARE		1		20		С		20		1		SPARE			48
49			SP	ARE		1		20		Α		20		1		SPARE			50
51			SP	ARE		1	•	20		В		20		1		SPARE			52
53			SPA	ARE		1		20		С		20		1		SPARE			54
55				ARE		1		20		Α		20		1		SPARE			56
57				ARE		1		20		В		20		1		SPARE			58
59				ARE		1		20		С		20		1		SPARE			60
61				ARE		1		20		Α		20		1		SPARE			62
63				ARE		1		20		В						SPACE			64
65				ARE		1		20		С						SPACE			66
67				ACE						A						SPACE			68
69				ACE						В						SPACE			70
71	LIA CEC	TO DE DAI		ACE						С	<b>(F)</b>	EVICE	I TO TO		l	SPACE			72
	HASES	S TO BE BAL	ANCED TO V								٠,		TING TO		AIN				
A=	U			WATTS							(N)	NEW	CIRCUI	IT					
B= \	0			WATTS							GFCI	GROU	JND FA	ULT C	URRENT INTERRU	PTER			
C=	0			WATTS							IG	CIRCL	JITS W	ITH IS	OLATED GROUND				
											TC	CIRCL	JITS O	N TIME	ECLOCK				
								EMS ROUTING TO THE EMS PANEL											
TOTA	CON	NECTED LO	AD	0		WATT	s		0	AMPS	С	BREA	KER LO	оск					
TOTA	DEMA	AND LOAD		0		WATT	S		0	AMPS	a,b,c	SWIT	CHES (	CONTR	ROLLING LIGHTS				

	ELECTRICAL LO	DAD SU	JMM	ARY	
DESCRIPTION	NEC CONNECTED kW	VOLT	PHASE	NEC DEMAND FACTOR	NEC DEMAND kW
LIGHTING- 120V	6.4	120	1	1.25	8.1
INTERIOR SIGN	4.8	120	1	1.25	6.0
RECEPTACLES	23.8	120	1	>10kW=10+[0.5*(kW-10)]	16.9
STOREFRONT SIGN	1.2	120	1	1.25	1.5
MOTORIZED DAMPER	0.1	120	1	1.00	0.1
OTHER EQUIPMENT	5.0	208	1	1.00	5.0
KITCHEN EQUIPMENT	15.1	208	1	0.65	9.8
SPACE HEATER	3.2	120	1	1.00	3.2
ROOFTOP UNITS	93.1	480	3	1.00	93.1
HOT WATER HEATER	26.4	208	3	1.00	26.4
TOTALS	179.2				170.1
** 125% OF THE LARGEST *** N.E.C. ARTICLE 220-12 I	F THE TWO CATEGORIES. MOTOR OR COMPRESSOR IN SYSTE REQUIREMENT (200 VA PER FOOT O WINDOW LIGHTING KVA.			ONE UNIT.	
N.E.C. DEMAND kVA x SYSTEM VOLTAGE x 1.7	<del></del>	MINIMUI	M FEEDER	AMPERAGE	
<u>170.1</u> <u>x 1000 =</u>	<u>170,081</u> 204.	6 AMPS	USE (EXI	STING) 400AMP SERVICE.	

NEW

1. HVAC CIRCUIT BREAKERS TO BE "HACR" TYPE WHERE REQUIRED BY EQUIPMENT NAMEPLATE PER N.E.C.

AVAILABLE IN ELECTRICAL ROOM/AREA PRIOR TO INSTALLATION OF ELECTRICAL EQUIPMENT.

- 2. BALANCE ALL PANELS AND ELECTRICAL EQUIPMENT, UNDER LOAD CONDITIONS, TO ±7% BETWEEN PHASES: A/B, B/C, C/A REGARDLESS OF CIRCUITING INDICATED. PROVIDE BALANCE SHEET TO CONSTRUCTION MANAGER AT PUNCHLIST.
- 3. PROPER CLEARANCE MUST BE MAINTAINED ABOUT ELECTRICAL EQUIPMENT PER N.E.C. FIELD VERIFY EXACT MOUNTING SPACE
- 4. MAKE ALL FINAL ELECTRICAL CONNECTIONS FOR A COMPLETE ELECTRICAL DISTRIBUTION SYSTEM. ALL CONNECTIONS/DISCONNECTIONS TO LANDLORDS/UTILITIES SERVICE EQUIPMENT SHALL BE AS DIRECTED BY LANDLORDS/UTILITIES SITE REPRESENTATIVE. TENANT GENERAL CONTRACTOR SHALL BE RESPONSIBLE FOR ALL TERMINATION/DETERMINATION EXPENSES.
- 5. SYSTEM SHALL BE GROUNDED TO THE MAIN BUILDING'S GROUNDING SYSTEM.
- 6. DISCONNECT SWITCHES AND PANELS SHALL BE INSTALLED ON PLYWOOD BACKERBOARDS.
- 7. TENANT CONTRACTOR MUST VERIFY ELECTRICAL SERVICE, SUB-FEED WIRING AND PANELS PRIOR TO START OF TENANT'S ELECTRICAL WORK. TENANT GENERAL CONTRACTOR SHALL MAKE APPLICATION TO THE LOCAL UTILITY FOR CONTINUED METERED ELECTRIC SERVICE IN THE TENANT'S NAME. TENANT GENERAL CONTRACTOR SHALL CONFIRM ALL LOCAL UTILITY GUIDELINES AND REQUIREMENTS PRIOR TO BID, SHALL INCLUDE THE COSTS OF THESE REQUIREMENTS IN THE BID, AND SHALL COMPLY WITH THEM DURING CONSTRUCTION. AVAILABLE FAULT CURRENT AT SERVICE EQUIPMENT SHALL BE LEGIBLY MARKED IN THE FIELD WITH THE MAXIMUM AVAILABLE FAULT CURRENT PER NATIONAL ELECTRICAL CODE ARTICLE 110.24.
- 8. CONTRACTOR SHALL VERIFY INCOMING SERVICE AMPERAGE, WIRE SIZING AND DISTRIBUTION.
- 9. CONTRACTOR SHALL COORDINATE WITH BASE BUILDING FOR THE EXACT LOCATION OF THE EXISTING SWITCH GEAR AND EXACT POWER DISTRIBUTION .
- 10. CONTRACTOR SHALL VERIFY OPERABLE CONDITION INFIELD OF ALL EXISTING TO REMAIN ELECTRICAL DEVICES/EQUIPMENTS AND REPLACE WITH NEW IF FOUND INOPERABLE.

# KEYED NOTES: #

- EXISTING SERVICE AND EQUIPMENTS FOR THE PROJECT SPACE SHALL REMAIN. CONTRACTOR SHALL COORDINATE THE EXACT LOCATION, RATING, VOLTAGE, PHASE, ELECTRICAL DISTRIBUTION AND OPERABLE CONDITION WITH ARCHITECT/OWNER IN FIELD.
- EXISTING ELECTRICAL PANELS FOR THE PROJECT SPACE TO REMAIN. CONTRACTOR SHALL VERIFY THE EXACT RATING. VOLTAGE, PHASE & OPERABLE CONDITION & LOCATION WITH ARCHITECT/OWNER IN FIELD. INFORM ENGINEER IF FOUND ANY DISCREPANCY. BASE BID ACCORDINGLY.

## VERIFY THE FOLLOWING PRIOR TO BID/ PRICING:

- EXISTING CONDUIT AND FEEDERS SIZE BETWEEN TENANT SPACE AND LANDLORD SWITCHBOARD.
- EXISTING MAIN SERVICE DISCONNECT RATING. • EXISTING METER.

PROVIDE NEW IF FOUND INOPERABLE. BASE BID ACCORDINGLY.

IF THE EXISTING SERVICE DISCONNECT AND FEEDERS ARE RATED FOR LESS THAN THE RATING SHOWN ON THIS RISER. NOTIFY THE PROJECT MANAGER AND ENGINEER IMMEDIATELY PRIOR TO SUBMITTING BID/ PRICING PACKAGE SO DRAWINGS CAN BE REVISED AND

PANE	LBOAF	RD		LPEMB SEC.1	VOLT	AGE	120	/ 208 V	PHASE		;	3	WIRE		4			
PANE	L TYPI	<b>=</b>		MLO	MAIN	S		NA	BUS RAT	ING	225	AMP /	AIC RA	ATING V.I.F.				
NEM/	A TYPE	<b>ENCLOS</b> I	JRE	1	√MOUN	NTING	SURFA	CE MOUNT	OPTIONS				NOTE		<b>EXISTING PANEL</b>			
CKT.	EQT	CKT			POLE	WIRE	BKR.	TOTAL	PHASE	TOTAL	BKR.	WIRE	POLE			СКТ	EQT	СКТ
NO.	TAG	TAG	DESCRI	PHON		SIZE	SIZE	WATTS		WATTS	SIZE	SIZE		DESCRII	PIION	TAG	TAG	NO.
1			SPA	.RE					Α					SPA	RE			2
3			SPA	RE					В					SPA	RE			4
5			SPA	RE					С					SPA	RE			6
7			SPA	RE					Α					SPA	RE			8
9			SPA	RE					В					SPA	RE			10
11			SPA						С					SPA	RE			12
13			SPA						Α					SPA				14
15			SPA						В					SPA				16
17			SPA						С					SPA				18
19			SPA						Α					SPA	·			20
21			SPA						В					SPA				22
23			SPA						С					SPA				24
25			SPA						A					SPA				26
27			SPA						В					SPA				28
29			SPA						С		1			SPA				30
31			SPA SPA						A					SPA SPA				32
33 35			SPA						B		1			SPA				34 36
37			SPA						A					SPA				38
39			SPA						B					SPA				40
41			SPA						C		<u> </u>			SPA				42
	PHASE	S TO BE F	BALANCED TO WI		ı	l				(E)	EXIST	ING TO	REMA					
λ= -	0			WATTS								CIRCUIT						
3=	0			WATTS										URRENT INTERRUPT	ED			
D- C=	0			WATTS											EN			
<b>_</b>	U			WAIIS										OLATED GROUND				
										TC	CIRCL	JITS ON	ITIME	CLOCK				
										EMS	ROUT	ING TO	THE E	EMS PANEL				
TOTA	L CON	NECTED L	OAD	0	WAT	rs		0	AMPS	C	BREA	KER LO	CK					
TOTA	L DEM	AND LOA	D	0	WATI	rs		0	AMPS	ahc	SWIT	CHES C	ONTR	OLLING LIGHTS				

PANE	LBOAF	RD.		LPEMB SEC.2	VOLT	AGE	120	/ 208 V	PHASE		;	3	WIRE		4			
PANE	L TYPE			MLO	MAIN	S		NA	BUS RATI	NG	225	AMP	AIC R	ATING	V.I.F.	1		
NEMA	TYPE	ENCLOSU	RE	1	MOUN	NTING	SURFA	CE MOUNT	OPTIONS				NOTE		EXISTING PANEL			
CKT.	EQT	СКТ	DESCR	RIPTION	POLE	WIRE	BKR.	TOTAL	PHASE	TOTAL	BKR.	WIRE	POLE	DESCR	IDTION	СКТ	EQT	СКТ
NO.	TAG	TAG	DESCR	ar HON		SIZE	SIZE	WATTS		WATTS	SIZE	SIZE		DESCR	IPTION	TAG	TAG	NO.
43			SP	ARE	1		20		Α		20		1	SPA	ARE			44
45			SP	ARE	1		20		В		20		1	SPA	ARE			46
47			SP	ARE	1		20		С		20		1	SPA	\RE			48
49			SP	ARE	1		20		Α		20		1	SPA	ARE			50
51			SP	ARE	1		20		В		20		1	SPA	ARE			52
53			SP	ARE	1		20		С		20		1	SPA	ARE			54
55			SP	ARE	1		20		Α		20		1	SPA	ARE			56
57				ARE	1		20		В		20		1	SPA				58
59				ARE	1		20		С		20		1	SPA				60
61				ARE	1		20		Α		20		1	SPA				62
63				ARE	1		20		В		20		1	SPA				64
65				ARE	1		20		С		20		1	SPA				66
67				ARE	1		20		Α		20		1	SPA				68
69				ARE	1		20		В		20		1	SPA				70
71				ARE	1		20		С		20		1	SPA	ARE			72
		S TO BE BA	ALANCED TO V							` '		TING TO		AIN				
Α=	0			WATTS						(N)	NEW	CIRCUI	Т					
B=	0			WATTS						GFCI	GROU	JND FAI	ULT C	URRENT INTERRU	PTER			
C=	0			WATTS						IG	CIRCL	JITS WI	ITH IS	OLATED GROUND				
										то	CIRCL	O STIL	N TIME	CLOCK				
										FMS	ROUT	ING TO	THE	EMS PANEL				
ΤΟΤΔ	CON	NECTED LO	DAD	0	WATI	rs .		0	AMPS			KER LC						
		AND LOAD		0	WATI			0	AMPS	_				OLLING LIGHTS				

## EXISTING PANELBOARD KEYED NOTE: #

- NEW BREAKERS MAY BE REQUIRED FOR USE IN THE EXISTING PANELBOARD TO MATCH RATING INDICATED IN THE PANEL SCHEDULE PRIOR TO BID/PRICING, THE ELECTRICAL CONTRACTOR SHALL VERIFY ALL EXISTING-TO-REMAIN PANELBOARD MANUFACTURER AND MODEL NUMBER TO ENSURE THAT REPLACEMENT BREAKERS ARE AVAILABLE. WHERE BREAKER AVAILABILITY ISSUES ARISE, NOTIFY THE PROJECT MANAGER PRIOR TO BID/PRICING.
- DESIGNATED CIRCUIT NUMBER SHOWN ON THE PANEL SCHEDULE FOR A CERTAIN LOAD, MAY BE DIFFERENT THAN THE ACTUAL CIRCUIT NUMBER IN THE EXISTING PANELBOARD. ALL EXISTING-TO-REMAIN ELECTRICAL LOADS SHALL REMAIN CONNECTED TO THE SAME BREAKER AND CIRCUIT DESIGNATION. AVAILABLE SPARES AND SPACES SHALL BE UTILIZED TO FEED THE NEW LOADS.
- E.C. SHALL VERIFY THE EXACT ELECTRICAL REQUIREMENT, LOCATION & OPERABLE CONDITION OF EXISTING SPACE HEATER IN FIELD. E.C. SHALL REROUTE THE EXISTING ELECTRICAL CONNECTION TO THE RESPECTIVE PANEL OR PROVIDE NEW CIRCUIT AS REQUIRED/AS SHOWN. BASE BID ACCORDINGLY.

CIRCUIT ABBREVATIONS										
PANEL	CIRCUIT PREFIX	CIRCUIT NUMBER								
LPI - SEC1	P1	1								
LPI -SEC2	P2	1								
LPEMA - SEC1	A1	1								
LPEMA - SEC2	A2	1								
LPEMB - SEC1	B1	1								
LPEMB - SEC2	B2	1								

CONSULTANTS (ENGINEER):

**NEARBY ENGINEERS** 

382 NE 191ST STREET SUITE 49674, MIAMI, FL 33179 PH-914.257.3455 WWW.NY-ENGINEERS.COM

CONTRACTOR'S NOTES DIMENSIONS. DO NOT SCALE THE DRAWINGS. THE CONTRACTORS MUST VISIT JOB SITE TO VERIEY ALL EXISTING CONDITIONS AND DIMENSIONS BEFORE SUBMITTING BIDS. REPORT ANY DISCREPANCIES OF AN CONDITIONS WHICH MAY INTERFERE WITH THE PROPER EXECUTION OF, THE CONTRACT TO THE TENANT'S REPRESENTATIVE, REPORT DISCREPANCIES DURING BIDDING PROCESS AND BEFORE START OF CONSTRUCTION, CHANGE ORDERS NEED TO BE

APPROVED BY TOWNSQUARE CONSTRUCTION

MANAGER FOR ISSUES ARISING FROM THE FIELD

THE EXISTING CONDITIONS PRIOR TO THE

COMMENCEMENT OF WORK.

CONDITIONS OR CONFLICTS BETWEEN THE PLANS AND

10.31.24 LL/CLIENT REVIEW SET 11.15.24 LL/CLIENT REVIEW SET

11.22.24 BD SUBMISSION


DATE REVISION

11.15.24 CLIENT COMMENTS

RISER DIAGRAM 8 PANEL SCHEDULE

SHEET NUMBER:

E004

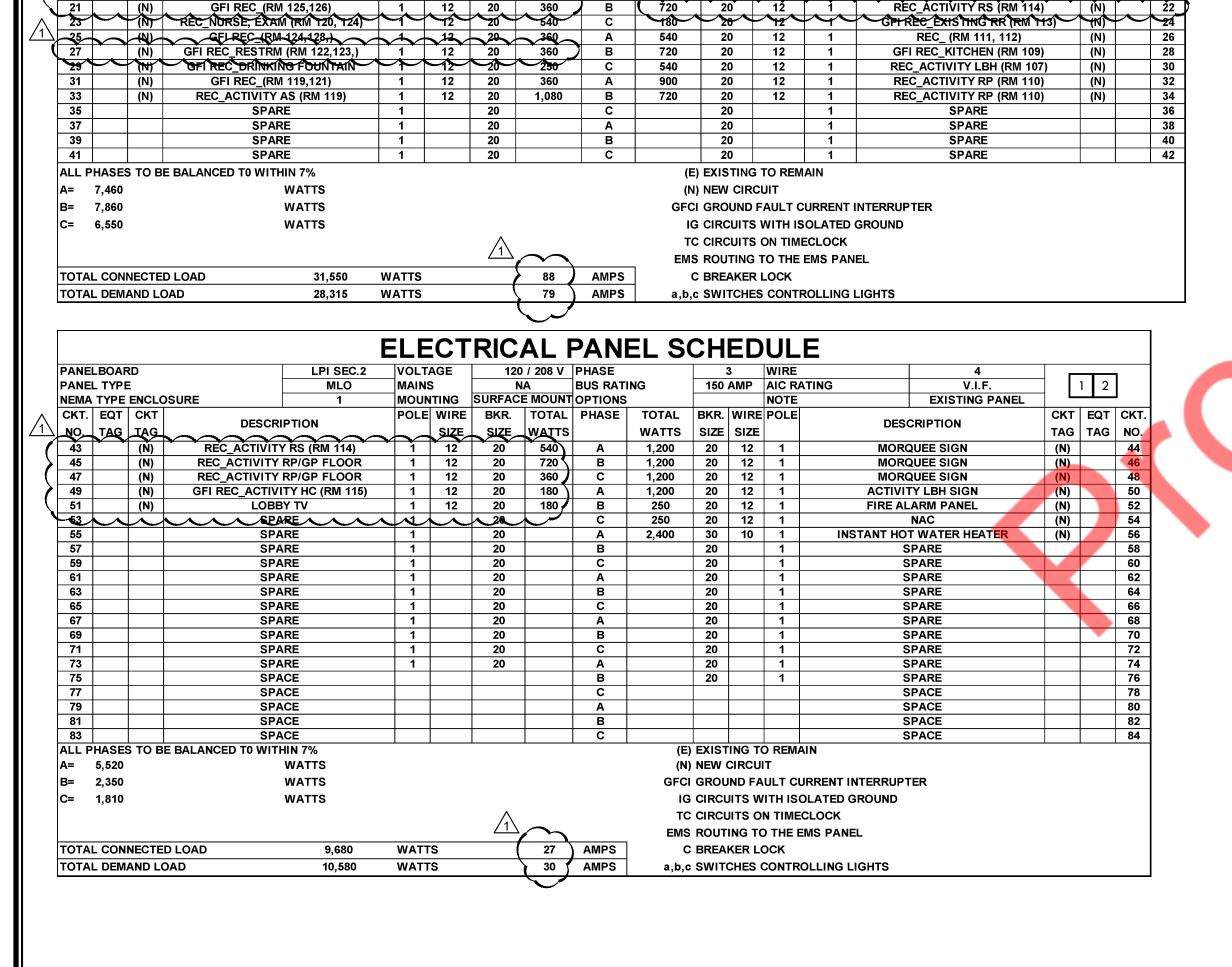

**ELECTRICAL PANEL SCHEDULE** 

POLE WIRE BKR. TOTAL PHASE TOTAL BKR. WIRE POLE

AMPS

WATTS SIZE SIZE

(E) EXISTING TO REMAIN

TC CIRCUITS ON TIMECLOCK

EMS ROUTING TO THE EMS PANEL

a,b,c SWITCHES CONTROLLING LIGHTS

GFCI GROUND FAULT CURRENT INTERRUPTER

IG CIRCUITS WITH ISOLATED GROUND

(N) NEW CIRCUIT

C BREAKER LOCK

**ELECTRICAL PANEL SCHEDULE** 

150 AMP BUS RATING

SURFACE MOUNT OPTIONS

SPARE

SPARE

EXISTING PANEL

STOREFRONT SIGN

RECEPTION SIGN

REC\_CLOSET (RM 118)

REC CLOSET (RM 118)

**REC CLOSET (RM 118)** 

REC\_ACTIVITY ST (RM 117

EC\_POPCORN MACHINE (RM 1

 VOLTAGE
 277 / 480 V
 PHASE

 MAINS
 400 AMP
 BUS RATING

MOUNTING SURFACE MOUNT OPTIONS

SIZE SIZE WATTS

3 6 50 13.856 R 17.426

PANELBOARD

PANEL TYPE

A= 64,953

B= 58,383

C= 55,821

TOTAL CONNECTED LOAD

NEMA TYPE ENCLOSURE

TOTAL DEMAND LOAD

PANELBOARD

PANEL TYPE

NEMA TYPE ENCLOSURE

(E) EXIST. 45KVA TRANSFORMER

ALL PHASES TO BE BALANCED TO WITHIN 7%

EXIST. RTU #2

WATTS

WATTS

REC\_RECEPTION (RM 101


REC OFFICE-1 (RM 105)

REC\_OFFICE-2 (RM 106)

GFI REC\_ACTIVITY G&D (RM 125)

179,157 WATTS

172,241 WATTS

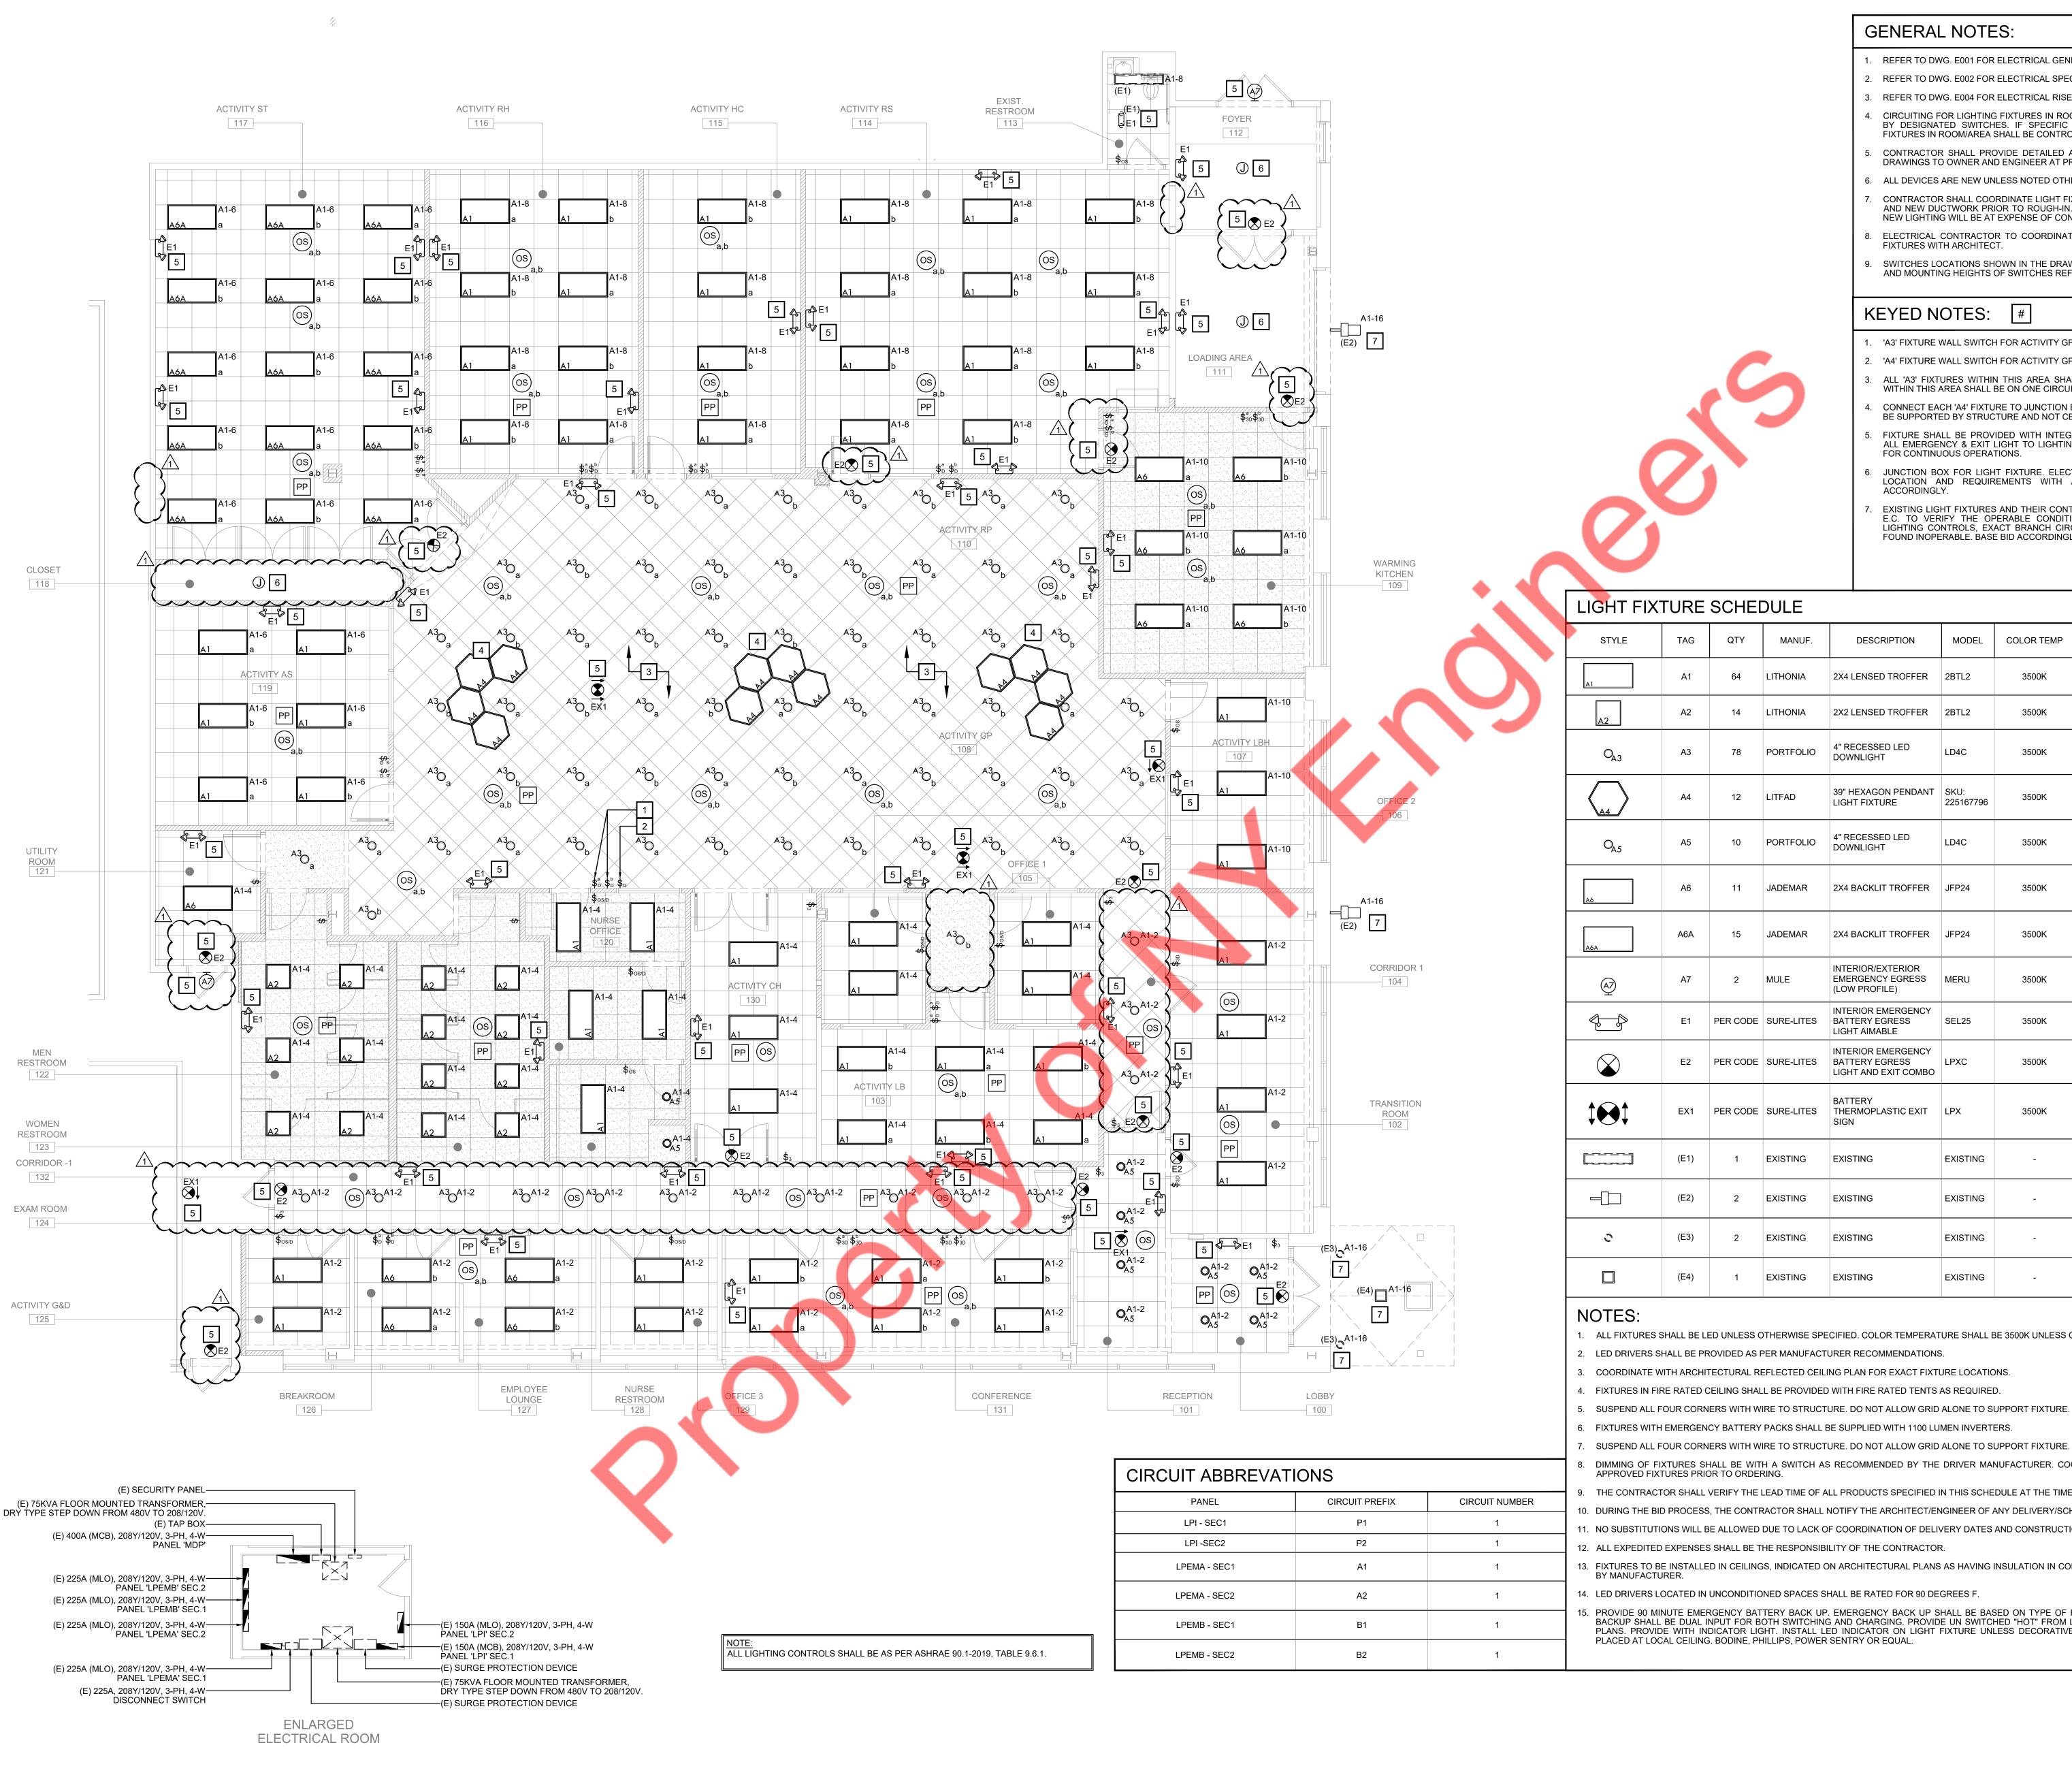

- . REFER TO DWG. E001 FOR ELECTRICAL GENERAL NOTES, SYMBOL LIST & ABBREVIATIONS.
- 2. REFER TO DWG. E002 FOR ELECTRICAL SPECIFICATIONS.
- 3. REFER TO DWG. E004 FOR ELECTRICAL RISER DIAGRAM.
- 4. CIRCUITING FOR LIGHTING FIXTURES IN ROOMS/AREA WITH SWITCHES SHALL BE CONTROLLED BY DESIGNATED SWITCHES. IF SPECIFIC DESIGNATION IS NOT INDICATED, ALL LIGHTING FIXTURES IN ROOM/AREA SHALL BE CONTROLLED BY THE SWITCH INDICATED.
- CONTRACTOR SHALL PROVIDE DETAILED AS-BUILT DRAWINGS. PROVIDE COPY OF AS-BUILT DRAWINGS TO OWNER AND ENGINEER AT PROJECT COMPLETION.
- 6. ALL DEVICES ARE NEW UNLESS NOTED OTHERWISE.
- CONTRACTOR SHALL COORDINATE LIGHT FIXTURE LOCATION WITH MECHANICAL CONTRACTOR AND NEW DUCTWORK PRIOR TO ROUGH-IN. RELOCATION OF DUCTWORK FOR CONFLICT WITH NEW LIGHTING WILL BE AT EXPENSE OF CONTRACTOR.
- ELECTRICAL CONTRACTOR TO COORDINATE EXACT LOCATION AND MOUNTING HEIGHTS OF FIXTURES WITH ARCHITECT.
- . SWITCHES LOCATIONS SHOWN IN THE DRAWINGS ARE DIAGRAMMATIC, FOR ACTUAL LOCATION AND MOUNTING HEIGHTS OF SWITCHES REFER TO ARCHITECTURAL PLANS.

## KEYED NOTES: #

- 1. 'A3' FIXTURE WALL SWITCH FOR ACTIVITY GP (108) & ACTIVITY RP (110) AREA.
- 2. 'A4' FIXTURE WALL SWITCH FOR ACTIVITY GP (108) & ACTIVITY RP (110) AREA.
- ALL 'A3' FIXTURES WITHIN THIS AREA SHALL BE ON ONE CIRCUIT, A1-12. ALL 'A4' FIXTURES WITHIN THIS AREA SHALL BE ON ONE CIRCUIT, A1-14.
- CONNECT EACH 'A4' FIXTURE TO JUNCTION BOX CENTERED ABOVE FIXTURE. JUNCTION BOX TO BE SUPPORTED BY STRUCTURE AND NOT CEILING GRID.
- FIXTURE SHALL BE PROVIDED WITH INTEGRAL 90-MINUTE MINIMUM BATTERY BACKUP. WIRE ALL EMERGENCY & EXIT LIGHT TO LIGHTING CIRCUIT AHEAD OF ALL CONTROL & SWITCHING FOR CONTINUOUS OPERATIONS.
- JUNCTION BOX FOR LIGHT FIXTURE. ELECTRICAL CONTRACTOR SHALL COORDINATE EXACT LOCATION AND REQUIREMENTS WITH ARCHITECT PRIOR TO ROUGH IN. BASE BID
- EXISTING LIGHT FIXTURES AND THEIR CONTROLS SHALL REMAIN. RETROFIT WITH LED LIGHTS. E.C. TO VERIFY THE OPERABLE CONDITION OF EXISTING LIGHTING FIXTURES, EXISTING LIGHTING CONTROLS, EXACT BRANCH CIRCUITS. PROVIDE AND INSTALL NEW AS SHOWN IF FOUND INOPERABLE. BASE BID ACCORDINGLY.

## LIGHT FIXTURE SCHEDULE

STYLE	TAG	QTY	MANUF.	DESCRIPTION	MODEL	COLOR TEMP	PROV. BY	INSTAL L BY	REMARKS
A1	A1	64	LITHONIA	2X4 LENSED TROFFER	2BTL2	3500K	GC	GC	DLC LISTED LENSED, RIBBED REFLECTOR
A2	A2	14	LITHONIA	2X2 LENSED TROFFER	2BTL2	3500K	GC	GC	DLC LISTED LENSED, RIBBED REFLECTOR
O <sub>A3</sub>	А3	78	PORTFOLIO	4" RECESSED LED DOWNLIGHT	LD4C	3500K	GC	GC	MINIMUM 10% DIMMING DLC/ENERGY STAR LISTED BLACK TRIM WET LOCATION LISTED
<u>A4</u>	A4	12	LITFAD	39" HEXAGON PENDANT LIGHT FIXTURE	SKU: 225167796	3500K	GC	GC	COORDINATE FINISH WITH ARCHITECT/OWNER CONFIRM FIXTURE IS DIMMABLE W/ MANUF.
$O_{\!\!\!A5}$	A5	10	PORTFOLIO	4" RECESSED LED DOWNLIGHT	LD4C	3500K	GC	GC	MINIMUM 10% DIMMING DLC/ENERGY STAR LISTED WHITE TRIM WET LOCATION LISTED
A6	A6	11	JADEMAR	2X4 BACKLIT TROFFER	JFP24	3500K	GC	GC	ETL LISTED DAMP LOCATIONS A6 SHALL BE WHITE TRIM A6A SHALL BE BLACK TRIM
A6A	A6A	15	JADEMAR	2X4 BACKLIT TROFFER	JFP24	3500K	GC	GC	ETL LISTED DAMP LOCATIONS A6 SHALL BE WHITE TRIM A6A SHALL BE BLACK TRIM
<b>₽</b>	A7	2	MULE	INTERIOR/EXTERIOR EMERGENCY EGRESS (LOW PROFILE)	MERU	3500K	GC	GC	UL LISTED WET LOCATION LS CODE 101 COMPLIANT PROVIDE 90 MIN. REMOTE BATTERY
	E1	PER CODE	SURE-LITES	INTERIOR EMERGENCY BATTERY EGRESS LIGHT AIMABLE	SEL25	3500K	GC	GC	TEST SWITCH PROVIDED SEALED 90 MIN. BATTERY
	E2	PER CODE	SURE-LITES	INTERIOR EMERGENCY BATTERY EGRESS LIGHT AND EXIT COMBO	LPXC	3500K	GC	GC	TEST SWITCH PROVIDED SEALED 90 MIN. BATTERY
<b>‡€‡</b>	EX1	PER CODE	SURE-LITES	BATTERY THERMOPLASTIC EXIT SIGN	LPX	3500K	GC	GC	NICKEL CADMIUM BATTERY EXIT SIGN 90 MIN. OPERATION TEST SWITCH PROVIDED UL LISTED FOR DAMP LOCATIONS
	(E1)	1	EXISTING	EXISTING	EXISTING	-	-	-	-
	(E2)	2	EXISTING	EXISTING	EXISTING	-	-	-	-
C	(E3)	2	EXISTING	EXISTING	EXISTING	-	-	-	-
	(E4)	1	EXISTING	EXISTING	EXISTING	-	-	-	-

- ALL FIXTURES SHALL BE LED UNLESS OTHERWISE SPECIFIED. COLOR TEMPERATURE SHALL BE 3500K UNLESS OTHERWISE NOTED.
- 2. LED DRIVERS SHALL BE PROVIDED AS PER MANUFACTURER RECOMMENDATIONS.
- 3. COORDINATE WITH ARCHITECTURAL REFLECTED CEILING PLAN FOR EXACT FIXTURE LOCATIONS. 4. FIXTURES IN FIRE RATED CEILING SHALL BE PROVIDED WITH FIRE RATED TENTS AS REQUIRED.
- 5. SUSPEND ALL FOUR CORNERS WITH WIRE TO STRUCTURE. DO NOT ALLOW GRID ALONE TO SUPPORT FIXTURE.
- 6. FIXTURES WITH EMERGENCY BATTERY PACKS SHALL BE SUPPLIED WITH 1100 LUMEN INVERTERS.
- DIMMING OF FIXTURES SHALL BE WITH A SWITCH AS RECOMMENDED BY THE DRIVER MANUFACTURER. COORDINATE COMPATIBILITY OF ALL SWITCHES WITH APPROVED FIXTURES PRIOR TO ORDERING.
- THE CONTRACTOR SHALL VERIFY THE LEAD TIME OF ALL PRODUCTS SPECIFIED IN THIS SCHEDULE AT THE TIME OF PACKAGE QUOTE.
- 10. DURING THE BID PROCESS, THE CONTRACTOR SHALL NOTIFY THE ARCHITECT/ENGINEER OF ANY DELIVERY/SCHEDULING ISSUES.
- 1. NO SUBSTITUTIONS WILL BE ALLOWED DUE TO LACK OF COORDINATION OF DELIVERY DATES AND CONSTRUCTION SCHEDULE AFTER BID.
- 12. ALL EXPEDITED EXPENSES SHALL BE THE RESPONSIBILITY OF THE CONTRACTOR.
- 13. FIXTURES TO BE INSTALLED IN CEILINGS, INDICATED ON ARCHITECTURAL PLANS AS HAVING INSULATION IN CONTACT WITH CEILING SURFACE, SHALL BE IC RATED BY MANUFACTURER.
- 14. LED DRIVERS LOCATED IN UNCONDITIONED SPACES SHALL BE RATED FOR 90 DEGREES F.
- 15. PROVIDE 90 MINUTE EMERGENCY BATTERY BACK UP. EMERGENCY BACK UP SHALL BE BASED ON TYPE OF FIXTURE, LED DRIVER, BALLAST, ETC. EMERGENCY BACKUP SHALL BE DUAL INPUT FOR BOTH SWITCHING AND CHARGING. PROVIDE UN SWITCHED "HOT" FROM LOCAL CIRCUIT UNLESS OTHERWISE INDICATED ON PLANS. PROVIDE WITH INDICATOR LIGHT. INSTALL LED INDICATOR ON LIGHT FIXTURE UNLESS DECORATIVE. DECORATIVE FIXTURES SHALL HAVE INDICATOR PLACED AT LOCAL CEILING. BODINE, PHILLIPS, POWER SENTRY OR EQUAL.

CONSULTANTS (ENGINEER):

**NEARBY ENGINEERS** 382 NE 191ST STREET SUITE 49674, MIAMI, FL 33179 PH-914.257.3455 WWW.NY-ENGINEERS.COM

CONTRACTOR'S NOTES DIMENSIONS. DO NOT SCALE THE DRAWINGS. THE CONTRACTORS MUST VISIT JOB SITE TO VERIFY ALL EXISTING CONDITIONS AND DIMENSIONS BEFORE SUBMITTING BIDS. REPORT ANY DISCREPANCIES OF ANY CONDITIONS WHICH MAY INTERFERE WITH THE PROPER EXECUTION OF, THE CONTRACT TO THE TENANT'S REPRESENTATIVE. REPORT DISCREPANCIES DURING BIDDING PROCESS AND BEFORE START OF CONSTRUCTION. CHANGE ORDERS NEED TO BE APPROVED BY TOWNSQUARE CONSTRUCTION

MANAGER FOR ISSUES ARISING FROM THE FIELD CONDITIONS OR CONFLICTS BETWEEN THE PLANS AND

THE EXISTING CONDITIONS PRIOR TO THE

COMMENCEMENT OF WORK.


10.31.24 LL/CLIENT REVIEW SET 11.15.24 LL/CLIENT REVIEW SET

11.22.24 BD SUBMISSION

DATE REVISION

11.15.24 CLIENT COMMENTS

LIGHTING PLAN

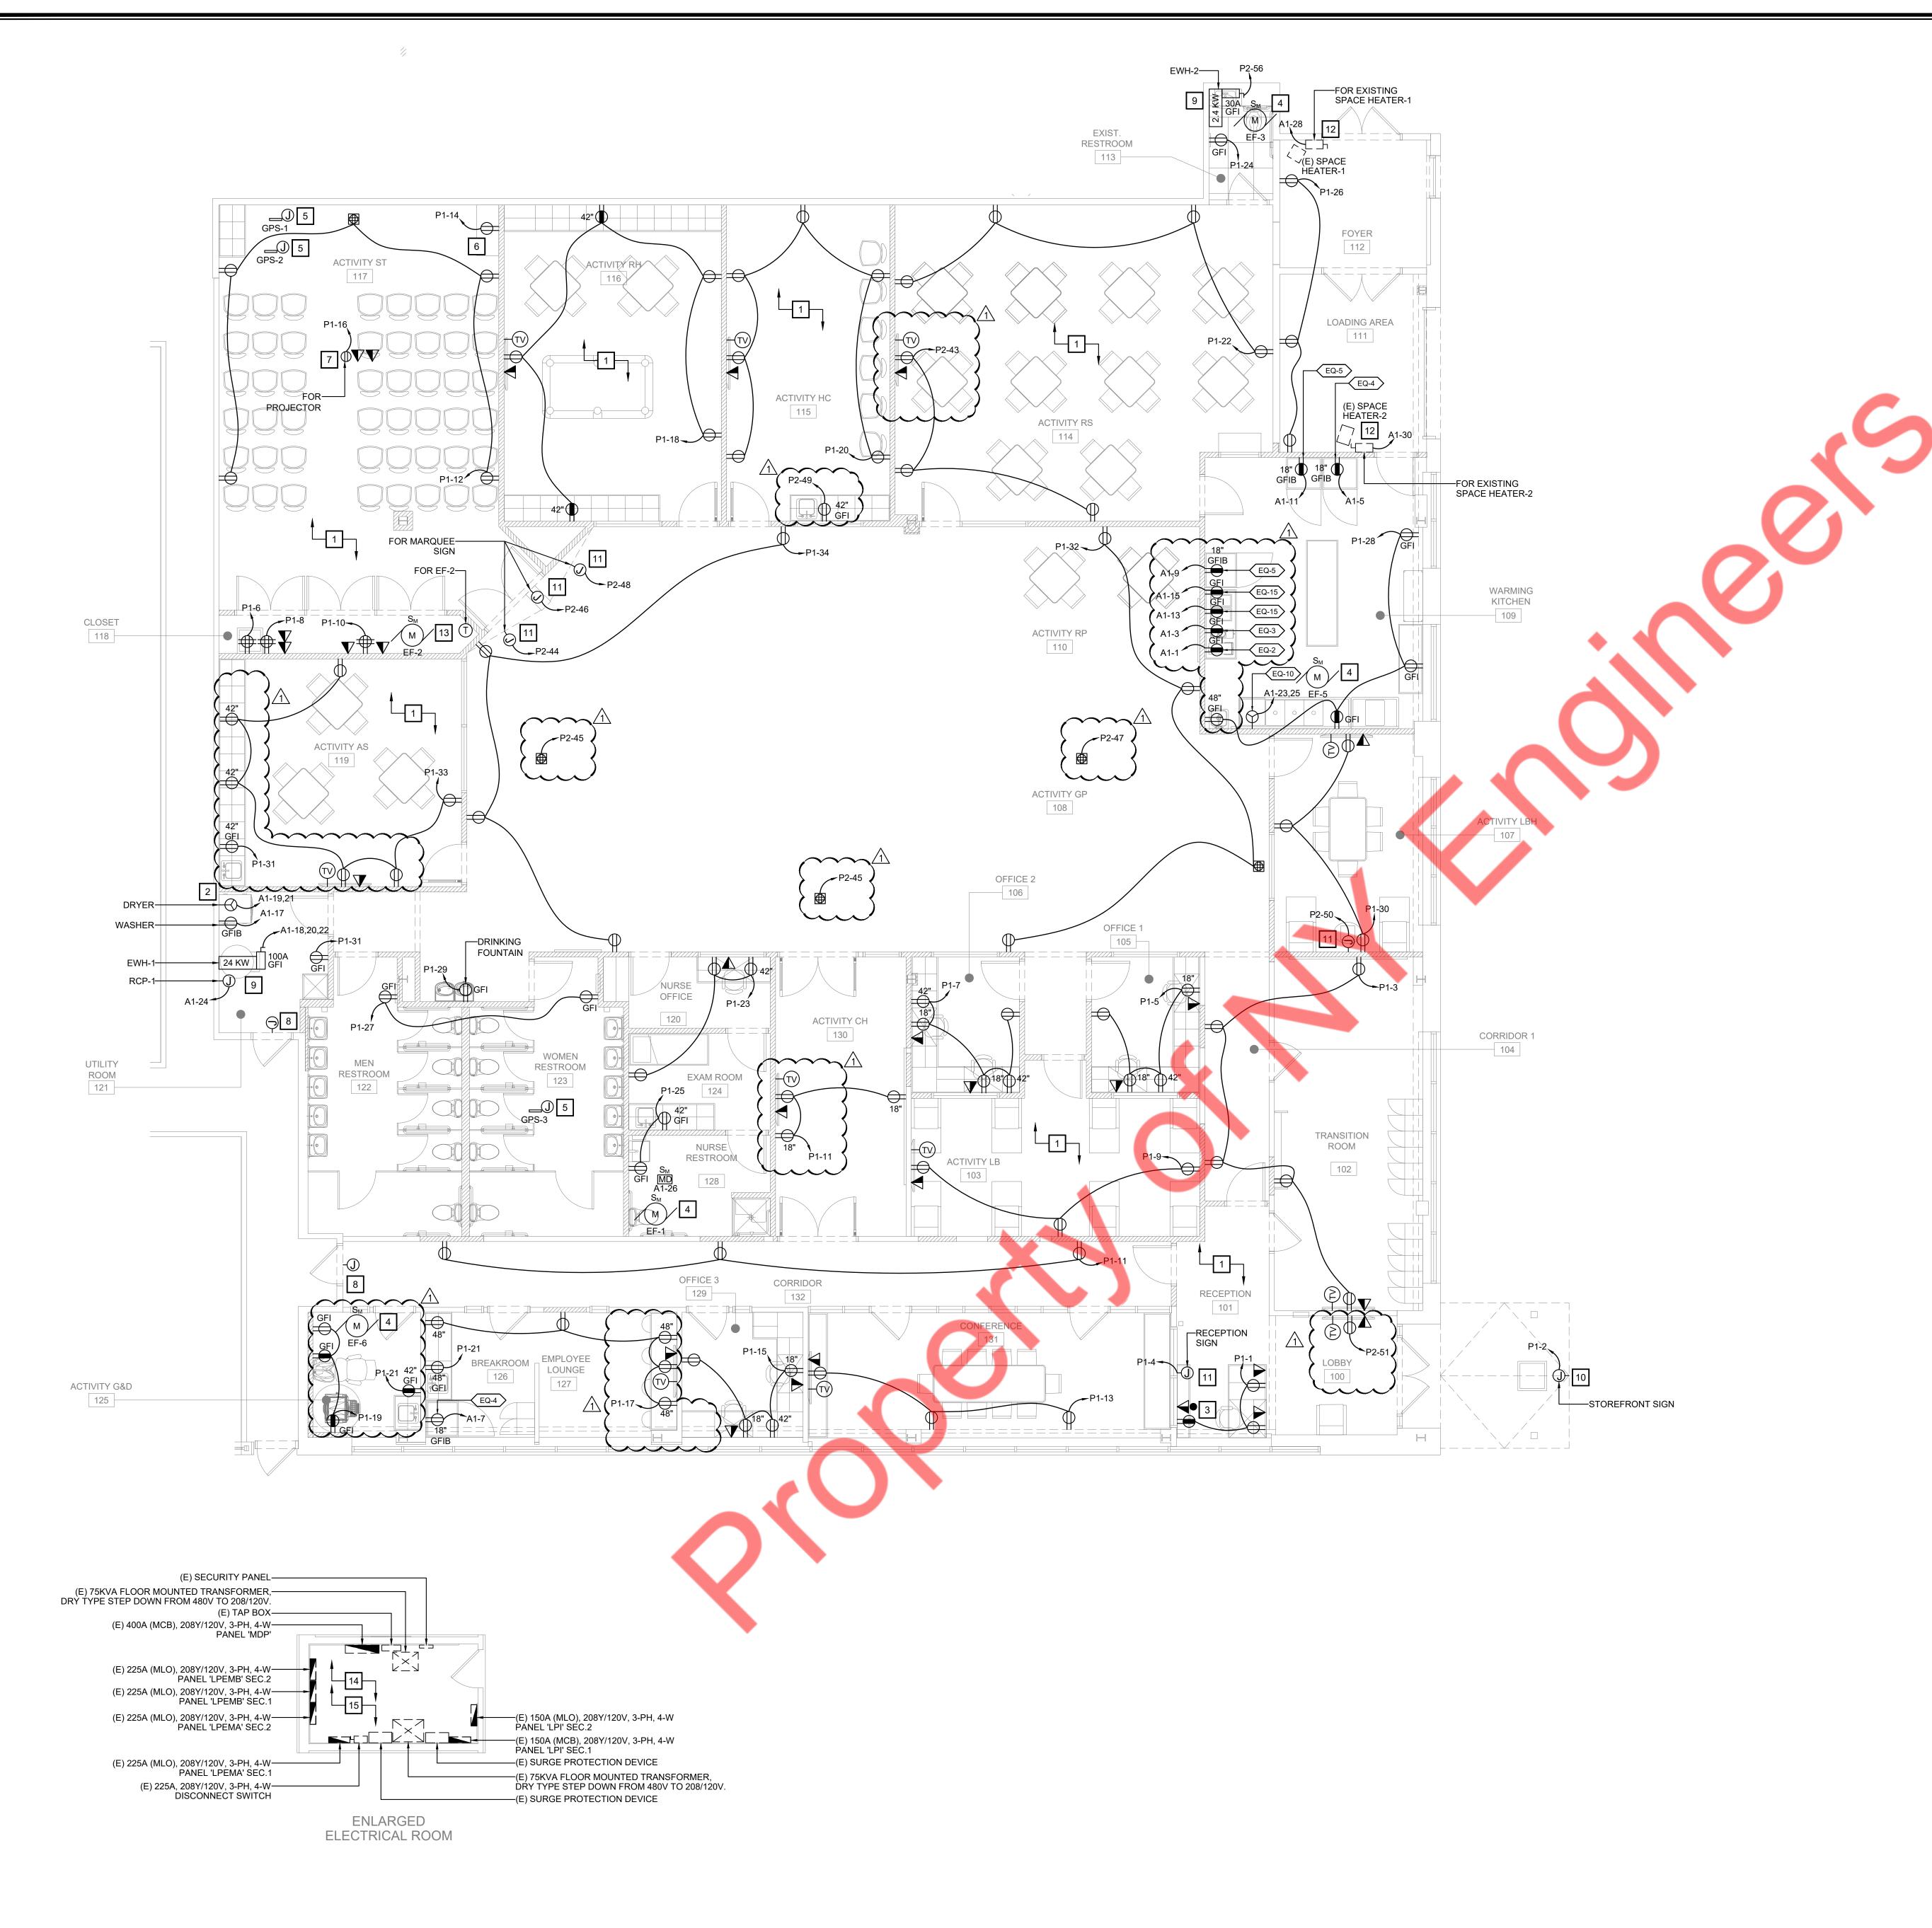

- 1. REFER TO DWG. E001 FOR ELECTRICAL GENERAL NOTES, SYMBOL LIST & ABBREVIATIONS.
- 2. REFER TO DWG. E002 FOR ELECTRICAL SPECIFICATIONS.
- 3. REFER TO DWG. E004 FOR ELECTRICAL RISER DIAGRAM.
- 4. CONTRACTOR SHALL PROVIDE DETAILED AS-BUILT DRAWINGS. PROVIDE COPY OF AS-BUILT DRAWINGS TO OWNER AND ENGINEER AT PROJECT COMPLETION.
- 5. ALL DEVICES ARE NEW UNLESS NOTED OTHERWISE.
- CONDUIT PERMITTED.

  7 COOPDINATE ELOOP BOY LOCATIONS WITH ELIPHITLIPE PRIOR TO POLICH IN AND CLITTING
- 7. COORDINATE FLOOR BOX LOCATIONS WITH FURNITURE PRIOR TO ROUGH-IN AND CUTTING OF FLOOR TILES.

6. ALL CONDUIT SHALL BE CONCEALED BEHIND WALLS AND ABOVE CEILINGS. NO EXPOSED

- 8. LABEL ALL RECEPTACLES WITH CIRCUIT AND PANEL INFORMATION.
- 9. PROVIDE PLASTIC BUSHINGS ON CONDUIT ENDS FOR ALL CONDUITS STUBBED ABOVE CEILING.
- 10. FINAL CONDUIT/CABLE ROUTING SHALL BE DETERMINED IN-FIELD, AND PRIOR TO THE COMMENCEMENT OF WORK, COORDINATED WITH OTHER TRADE CONTRACTORS AND THE
- 11. OUTLETS' LOCATION SHOWN IN THE DRAWING ARE DIAGRAMMATIC, FOR ACTUAL LOCATION AND MOUNTING HEIGHT REFER ARCHITECTURAL PLAN.
- 12. CONTRACTOR SHALL COORDINATE EXACT RECEPTACLE TYPE FOR EQUIPMENT WITH EQUIPMENT VENDOR/MANUFACTURER.
- 13. ALL WIRING TO BE #12AWG WITH #12AWG GND IN 3/4" CONDUIT UNLESS OTHERWISE NOTED OR REQUIRED.

## KEYED NOTES: #

- RECEPTACLE INSTALLED WITHIN THIS ROOM SHALL BE TAMPER-RESISTANT PER NEC 406.12(5).
- 2. INSTALL L6-30 RECEPTACLE FOR DRYER. CONFIRM DRYER SPECIFICATIONS BEFORE ORDERING
- POWER FOR AUDIO-VISUAL MASTER STATION FOR SIGNAL SYSTEM. COORDINATE ALL REQUIREMENTS WITH OWNER AND EQUIPMENT SUPPLIER PRIOR TO ROUGH-IN.
   CONNECT TO LOCAL LIGHTING CIRCUIT. FAN TO BE CONTROLLED WITH ROOM LIGHTING CONTROLS. E.C. SHALL COORDINATE THE EXACT LOCATION IN FIELD AND PROVIDE THE ELECTRICAL CONNECTION ACCORDINGLY.
- 5. INSTALL JUNCTION BOX IN CEILING FOR AIR IONIZATION DEVICE IN MECHANICAL EQUIPMENT. CONNECT TO LOCAL RECEPTACLE CIRCUIT. COORDINATE EXACT LOCATION WITH M.C.
- 6. INSTALL RECEPTACLE FOR POPCORN MACHINE. COORDINATE EXACT REQUIREMENTS AND LOCATION WITH OWNER.
- PROJECTOR POWER AND DATA MOUNTED TO 2x2 PLYWOOD. COORDINATE EXACT LOCATION WITH ARCHITECTURAL DRAWINGS PRIOR TO ROUGH-IN.
- 8. INSTALL JUNCTION BOX FOR DELAYED EGRESS DOOR HARDWARE. PROVIDE CONDUIT TO CEILING FOR FIRE ALARM WIRING TO NAC PANEL. COORDINATE JUNCTION BOX MOUNTING LOCATION WITH HARDWARE MANUFACTURER DOCUMENTS.
- 9. ALL MECHANICAL/PLUMBING EQUIPMENT SHALL BE PROVIDED WITH THE REQUIRED ROUGH-INS, MOCP, AND WIRE SIZE REQUIREMENTS. THE ELECTRICAL CONTRACTOR MUST COORDINATE WITH THE MANUFACTURER FOR THE EXACT TYPE OF ROUGH-INS AND WIRE SIZE THE COMMENCEMENT OF WORK. E.C. SHALL COORDINATE THE EXACT LOCATION IN FIELD AND PROVIDE THE ELECTRICAL CONNECTION ACCORDINGLY.
- 10. JUNCTION BOX WITH TOGGLE DISCONNECT PER NEC FOR CONNECTION TO BUILDING-MOUNTED SIGNAGE. THE ELECTRICAL CONTRACTOR SHALL VERIFY THE EXACT LOCATION, MOUNTING HEIGHT AND CONNECT TO THE SIGN PER THE MANUFACTURER'S INSTRUCTIONS. ROUTE CIRCUIT TO PANEL VIA EXTERIOR LIGHTING/SIGNAGE'S TIME CLOCK AS REQUIRED
- 11. JUNCTION BOX WITH TOGGLE DISCONNECT PER NEC FOR CONNECTION TO SIGNAGE. THE ELECTRICAL CONTRACTOR SHALL VERIFY THE EXACT LOCATION, MOUNTING HEIGHT AND CONNECT TO THE SIGN PER THE MANUFACTURER'S INSTRUCTIONS.
- 12. E.C. SHALL VERIFY THE EXACT ELECTRICAL REQUIREMENT, LOCATION & OPERABLE CONDITION OF EXISTING SPACE HEATER IN FIELD. E.C. SHALL REROUTE THE EXISTING ELECTRICAL CONNECTION TO THE RESPECTIVE PANEL OR PROVIDE NEW CIRCUIT AS REQUIRED/AS SHOWN. BASE BID ACCORDINGLY.
- 13. CONNECT TO LOCAL LIGHTING CIRCUIT. FAN TO BE CONTROLLED WITH THERMOSTAT. E.C. SHALL COORDINATE THE EXACT LOCATION IN FIELD AND PROVIDE THE ELECTRICAL CONNECTION ACCORDINGLY.
- 14. EXISTING ELECTRICAL PANELS FOR THE PROJECT SPACE TO REMAIN. CONTRACTOR SHALL VERIFY THE EXACT RATING, VOLTAGE, PHASE, OPERABLE CONDITION & LOCATION WITH ARCHITECT/OWNER IN FIELD. INFORM ENGINEER IF FOUND ANY DISCREPANCY. BASE BID ACCORDINGLY.
- 15. EXISTING ELECTRICAL PANELS AND TRANSFORMERS ASSOCIATED WITH THE PROJECT SPACE ARE LOCATED IN THE ADJACENT AREA ELECTRICAL ROOM, CONTRACTOR TO COORDINATE WITH ARCHITECT/OWNER AND RUN ALL NEW BRANCH CIRCUITS THROUGH THE ADJOINING SPACE TO PROJECT SPACE.

# KITCHEN EQUIPMENT SCHEDULE:

TAG	QTY	DESCRIPTION	VOLTAGE	PHASE	AMPS	KW	DIRECT	PLUG	NEMA	REMARKS
2	1	ICED TEA BREWER	120	1	14.4	1.73		Х	5-15R	
3	1	COFFEE BREWER	120	1	14	1.67		Х	5-15R	
4	2	REACH-IN-REFRIGERATOR	115	1	2.1	0.25		Х	5-15R	
5	2	REACH-IN-FREEZER	115	1	6.3	0.76		Х	5-15R	
15	2	FOOD PAN WARMER	120	1	10	1.2		Х	5-15R	
10	1	DISHWASHER	208	1	35	6.5		Х	6-50R	

## NOTES

- 1. COORDINATE ALL LOCATIONS, MOUNTING HEIGHTS, CONNECTION TYPES, BREAKER SIZES, ETC. WITH APPROVED KITCHEN EQUIPMENT SUBMITTALS PRIOR TO ROUGH-IN AND INSTALLATION.
- ALL ROUGH-INS SHALL BE REVIEWED AND APPROVED BY KITCHEN EQUIPMENT SUPPLIER, OWNER, AND ARCHITECT IN FIELD PRIOR TO COVERING OF WALLS.

  2. ELECTRICAL CONTRACTOR SHALL PULL A GROUND AND NEUTRAL WITH ALL CIRCUITS, WHETHER DESIGNATED OR NOT.
- 3. GROUND FAULT CIRCUIT-INTERRUPTER PROTECTION FOR PERSONNEL SHALL BE PROVIDED AS REQUIRED IN NEC 210.8(A) THROUGH (E). THE GROUND-FAULT CIRCUIT INTERRUPTER SHALL BE INSTALLED IN A READILY ACCESSIBLE LOCATION. ALL SINGLE PHASE RECEPTACLES RATED 150 VOLTS TO GROUND OR LESS, 50 AMPERES OR LESS INSTALLED IN THE KITCHEN SHALL BE GFCI PROTECTED, WHETHER DESIGNATED OR NOT ON THIS PLAN.

## CIRCUIT ABBREVATIONS

PANEL	CIRCUIT PREFIX	CIRCUIT NUMBER
LPI - SEC1	P1	1
LPI -SEC2	P2	1
LPEMA - SEC1	A1	1
LPEMA - SEC2	A2	1
LPEMB - SEC1	B1	1
LPEMB - SEC2	B2	1

CONSULTANTS (ENGINEER):

NY ENGINEERS

NEARBY ENGINEERS
382 NE 191ST STREET SUITE 49674,
MIAMI, FL 33179
PH-914.257.3455

WWW.NY-ENGINEERS.COM

CONTRACTOR'S NOTES:

WRITTEN DIMENSIONS HOLD PREFERENCE OVER SCALED DIMENSIONS. DO NOT SCALE THE DRAWINGS. THE CONTRACTORS MUST VISIT JOB SITE TO VERIFY ALL EXISTING CONDITIONS AND DIMENSIONS BEFORE SUBMITTING BIDS. REPORT ANY DISCREPANCIES OF ANY CONDITIONS WHICH MAY INTERFERE WITH THE PROPER EXECUTION OF, THE CONTRACT TO THE TENANT'S REPRESENTATIVE. REPORT DISCREPANCIES DURING BIDDING PROCESS AND BEFORE START OF CONSTRUCTION. CHANGE ORDERS NEED TO BE APPROVED BY TOWNSQUARE CONSTRUCTION MANAGER FOR ISSUES ARISING FROM THE FIELD

DATE ISSUE
10.31.24 LL/CLIENT REVIEW SET
11.15.24 LL/CLIENT REVIEW SET
11.22.24 BD SUBMISSION

CONDITIONS OR CONFLICTS BETWEEN THE PLANS AND

THE EXISTING CONDITIONS PRIOR TO THE

OMMENCEMENT OF WORK.

DATE REVISION

11.15.24 CLIENT COMMENTS




TITI F:

ELECTRICAL POWER PLAN

SHEET NUMBER:

E201

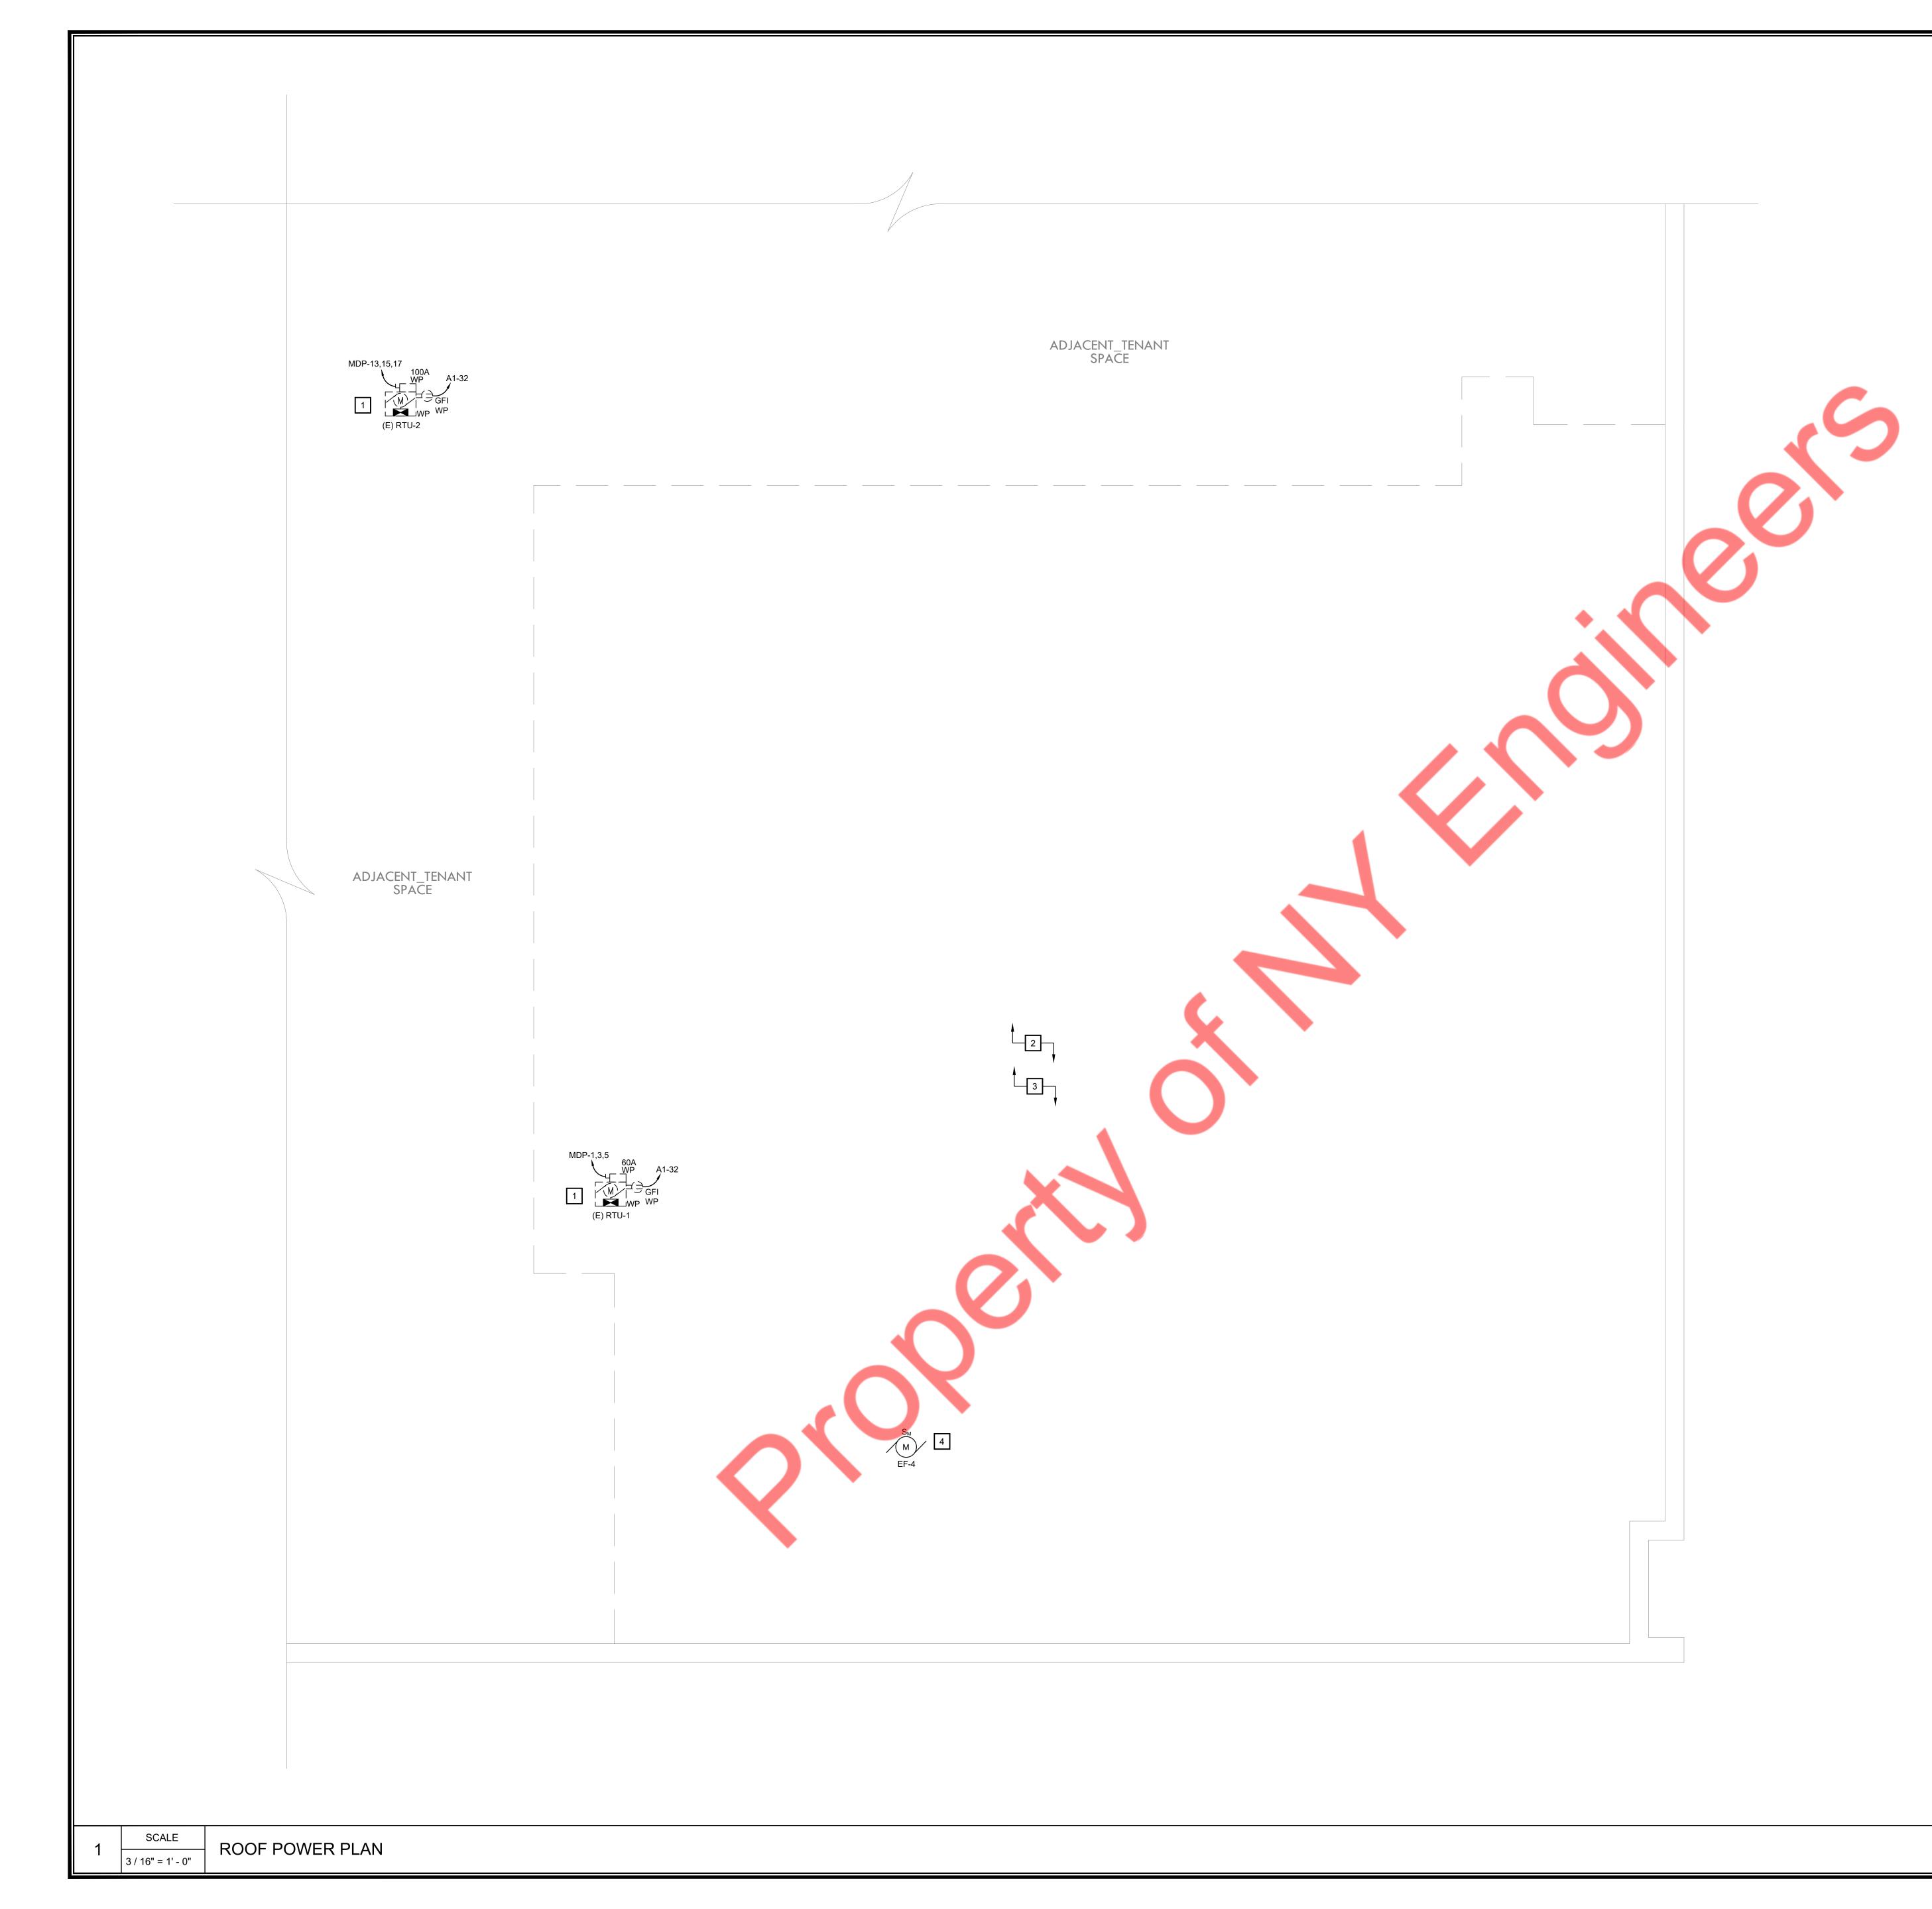

- 1. REFER TO DWG. E001 FOR ELECTRICAL GENERAL NOTES, SYMBOL LIST & ABBREVIATIONS.
- 2. REFER TO DWG. E002 FOR ELECTRICAL SPECIFICATIONS.
- 3. REFER TO DWG. E004 FOR ELECTRICAL RISER DIAGRAM.

5. ALL DEVICES ARE NEW UNLESS NOTED OTHERWISE.

- 4. CONTRACTOR SHALL PROVIDE DETAILED AS-BUILT DRAWINGS. PROVIDE COPY OF AS-BUILT DRAWINGS TO OWNER AND ENGINEER AT PROJECT COMPLETION.
- 6. ALL CONDUIT SHALL BE CONCEALED BEHIND WALLS AND ABOVE CEILINGS. NO EXPOSED CONDUIT PERMITTED.
- 7. COORDINATE FLOOR BOX LOCATIONS WITH FURNITURE PRIOR TO ROUGH-IN AND CUTTING OF
- FLOOR TILES.
- 8. LABEL ALL RECEPTACLES WITH CIRCUIT AND PANEL INFORMATION.
- PROVIDE PLASTIC BUSHINGS ON CONDUIT ENDS FOR ALL CONDUITS STUBBED ABOVE CEILING.
   FINAL CONDUIT/CABLE ROUTING SHALL BE DETERMINED IN-FIELD, AND PRIOR TO THE
- 10. FINAL CONDUIT/CABLE ROUTING SHALL BE DETERMINED IN-FIELD, AND PRIOR TO THE COMMENCEMENT OF WORK, COORDINATED WITH OTHER TRADE CONTRACTORS AND THE
- 11. OUTLETS' LOCATION SHOWN IN THE DRAWING ARE DIAGRAMMATIC, FOR ACTUAL LOCATION AND MOUNTING HEIGHT REFER ARCHITECTURAL PLAN.

12. CONTRACTOR SHALL COORDINATE EXACT RECEPTACLE TYPE FOR EQUIPMENT WITH

EQUIPMENT VENDOR/MANUFACTURER.

13. ALL WIRING TO BE #12AWG WITH #12AWG GND IN 3/4" CONDUIT UNLESS OTHERWISE NOTED OR

# KEYED NOTES: #

REQUIRED.

- 1. EXISTING RTU AND ITS ASSOCIATED CIRCUITS TO REMAIN. UTILIZE EXISTING DISCONNECT IF IT'S IN OPERABLE CONDITION, OTHERWISE PROVIDE NEW. E.C SHALL COORDINATE WITH LANDLORD IN FIELD FOR EXACT POWER DISTRIBUTION. BASE BID ACCORDINGLY.
- 2. ALL OUTDOOR ELECTRICAL EQUIPMENT SHALL BE NEMA 3R RATED.
- 3. CONTRACTOR TO VERIFY IN FIELD ANY RECEPTACLE IS PRESENT WITHIN 25FT OF HVAC UNITS. IF YES, EXISTING RECEPTACLES TO REMAIN. WIRE TO NEW AVAILABLE CIRCUIT IF NEEDED. VERIFY EXACT LOCATION. ELSE PROVIDE NEW WEATHER PROOF, GFI, 120V, 20A RECEPTACLE WITHIN 25FT OF THE HVAC UNITS AS SHOWN. FEED FROM AVAILABLE SPARE CIRCUIT.
- CONNECT TO LOCAL LIGHTING CIRCUIT. FAN TO BE CONTROLLED WITH ROOM LIGHTING CONTROLS. E.C. SHALL COORDINATE THE EXACT LOCATION IN FIELD AND PROVIDE THE ELECTRICAL CONNECTION ACCORDINGLY.

CONSULTANTS (ENGINEER):

NY ENGINEERS

NEARBY ENGINEERS

382 NE 191ST STREET SUITE 49674, MIAMI, FL 33179 PH-914.257.3455 WWW.NY-ENGINEERS.COM

CONTRACTOR'S NOTES:

WRITTEN DIMENSIONS HOLD PREFERENCE OVER SCALED DIMENSIONS. DO NOT SCALE THE DRAWINGS. THE CONTRACTORS MUST VISIT JOB SITE TO VERIFY ALL EXISTING CONDITIONS AND DIMENSIONS BEFORE SUBMITTING BIDS. REPORT ANY DISCREPANCIES OF ANY CONDITIONS WHICH MAY INTERFERE WITH THE PROPER EXECUTION OF, THE CONTRACT TO THE TENANT'S REPRESENTATIVE. REPORT DISCREPANCIES DURING BIDDING PROCESS AND BEFORE START OF CONSTRUCTION. CHANGE ORDERS NEED TO BE APPROVED BY TOWNSQUARE CONSTRUCTION MANAGER FOR ISSUES ARISING FROM THE FIELD CONDITIONS OR CONFLICTS BETWEEN THE PLANS AND THE EXISTING CONDITIONS PRIOR TO THE COMMENCEMENT OF WORK.

DATE ISSUE
10.31.24 LL/CLIENT REVIEW SET
11.15.24 LL/CLIENT REVIEW SET

11.22.24 BD SUBMISSION

11.15.24 CLIENT COMMENTS

DATE REVISION




TITI F:

ELECTRICAL ROOF POWER PLAN

SHEET NUMBER:

E202

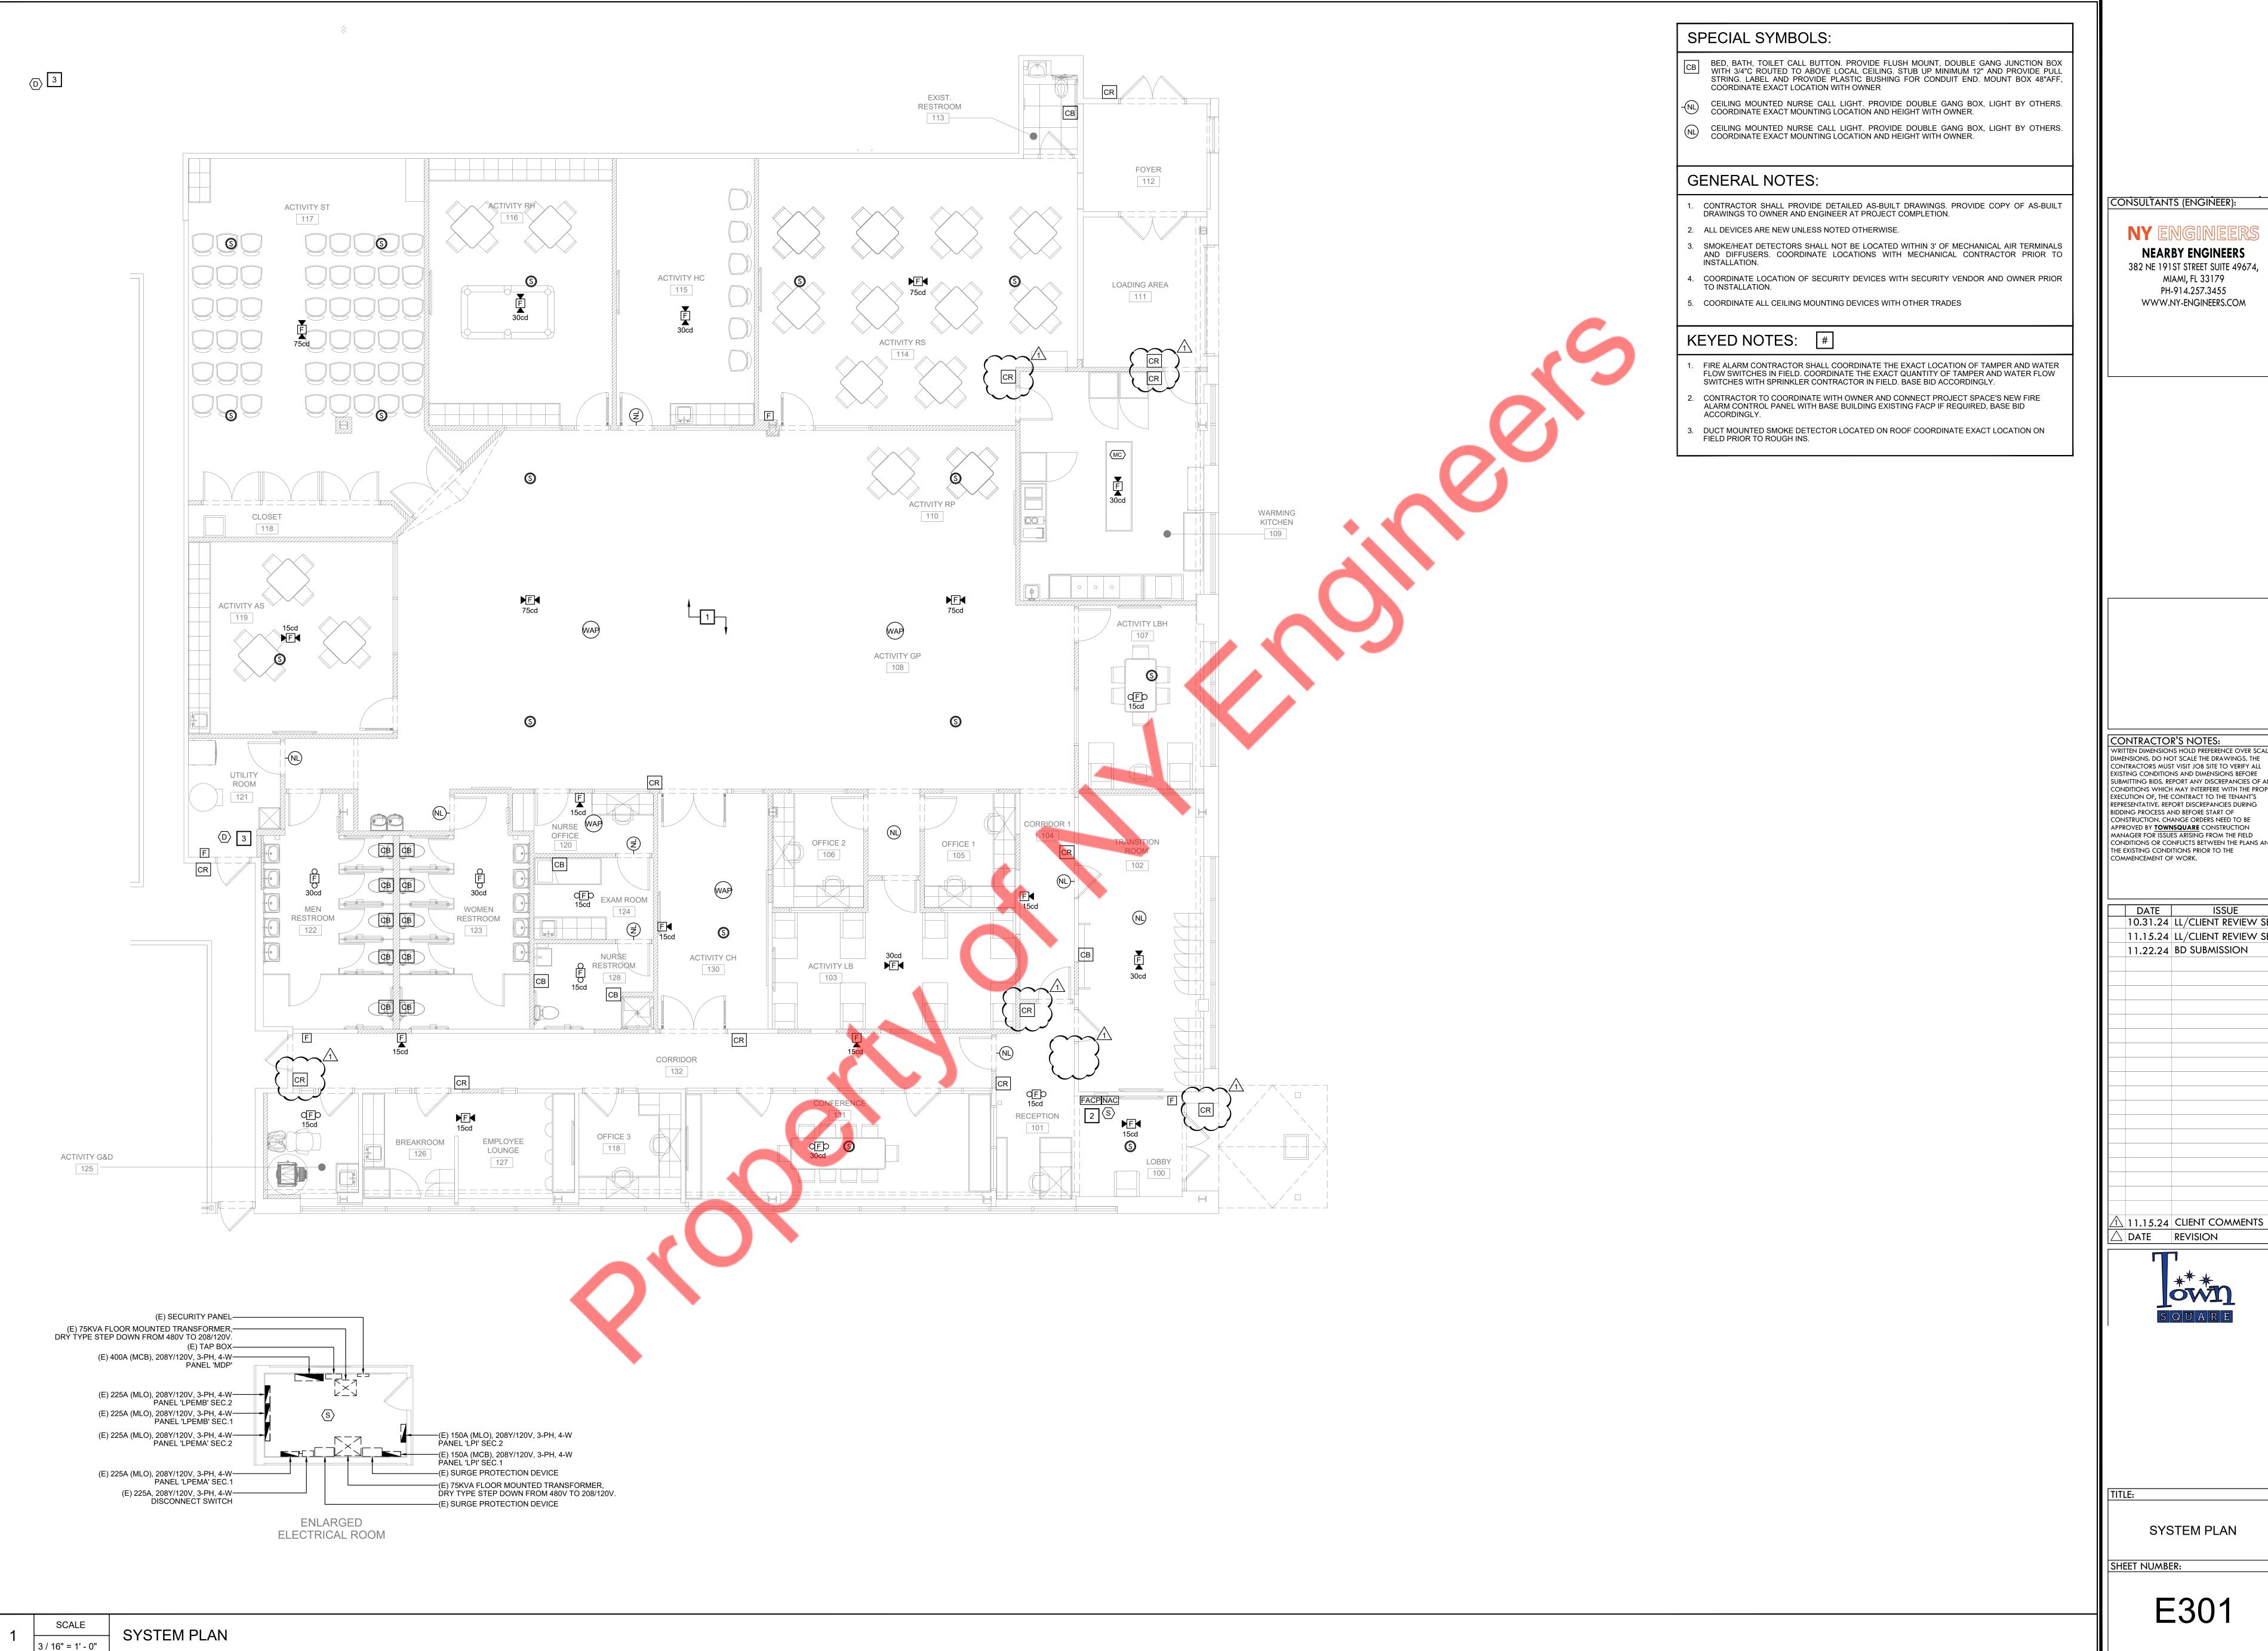

CONSULTANTS (ENGINEER):

**NEARBY ENGINEERS** 

382 NE 191ST STREET SUITE 49674, MIAMI, FL 33179 PH-914.257.3455 WWW.NY-ENGINEERS.COM

SUBMITTING BIDS. REPORT ANY DISCREPANCIES OF ANY CONDITIONS WHICH MAY INTERFERE WITH THE PROPER EXECUTION OF, THE CONTRACT TO THE TENANT'S REPRESENTATIVE. REPORT DISCREPANCIES DURING BIDDING PROCESS AND BEFORE START OF CONSTRUCTION. CHANGE ORDERS NEED TO BE APPROVED BY **TOWNSQUARE** CONSTRUCTION MANAGER FOR ISSUES ARISING FROM THE FIELD CONDITIONS OR CONFLICTS BETWEEN THE PLANS AND THE EXISTING CONDITIONS PRIOR TO THE COMMENCEMENT OF WORK.

10.31.24 LL/CLIENT REVIEW SET 11.15.24 LL/CLIENT REVIEW SET 11.22.24 BD SUBMISSION

11.15.24 CLIENT COMMENTS

SYSTEM PLAN

	VENT PIPING
— SAN — —	WASTE PIPE UNDERGROUND
— GSAN - —	GREASE WASTE UNDERGROUND
	COLD WATER PIPING
	HOT WATER PIPING
	HOT WATER RETURN PIPING
	FILTER WATER PIPING
	EXISTING COLD WATER PIPING
	P-TRAP
o	PIPE UP
	PIPE DROP
	PIPE CAP
——⋈——	CONTROL VALVE
— <del>———</del>	BACKFLOW PREVENTER
•	POINT OF CONNECTION
0	CLEANOUT
Ø	BALANCING VALVE
	FLOOR SINK
	FLOOR DRAIN

PLUMBING ABBREVIATIONS						
FCO	CLEANOUT					
W	WASTE					
V	VENT					
GSAN	GREASE WASTE					
FFD	FUNNEL FLOOR DRAIN					
HD	HUB DRAIN					
EX.	EXISTING					
FD	FLOOR DRAIN					
CW	COLD WATER					
HW	HOT WATER					
HWR	HOT WATER RETURN					
TYP.	TYPICAL					
DN	DOWN					
AFF	ABOVE FINISH FLOOR					
BFP	BACK FLOW PREVENTER					
М	WATER METER					
PRV	PRESSURE REDUCING VALVE					
UNGD	UNDERGROUND					
S	HAND SINK					
3-CS	THREE COMPARTMENT SINK					
1-CS	ONE COMPARTMENT SINK					
FS	FLOOR SINK					
IM	ICE MAKER / MACHINE					
FW	FILTERED WATER					
AAV	AIR ADMITTANCE VALVE					
WCO	WALL CLEANOUT					
EWH-1	ELECTRIC WATER HEATER					
RCP-1	RECIRCULATION PUMP					
ET-1	EXPANSION TANK					
SB	SHAMPOO BOWL					
HT	HAIR TRAP					

#### PLUMBING MATERIALS AND NOTES

#### DOMESTIC WATER PIPING:

- 1. DOMESTIC WATER PIPING AND JOINTS ABOVE GRADE: PROVIDE TYPE 'L' HARD DRAWN SEAMLESS COPPER TUBING (ASTM B 88) AND COPPER ALLOY FITTINGS (ASME B16.18). JOINTS 2" AND SMALLER SHALL BE LEAD FREE 95-5 TIN/SILVER SOLDER JOINTS (ASTM B 32).
- 2. DOMESTIC WATER SERVICE BELOW GRADE: PROVIDE TYPE 'K' OR 'L' WATER PIPE. AS PER ASTM B88 OR CPVC ASTM D2846
- 3. STERILIZE THE DOMESTIC WATER SYSTEM IN ACCORDANCE WITH THE AMERICAN WATER WORKS ASSOCIATION'S SPECIFICATIONS AND LOCAL HEALTH DEPARTMENT REGULATIONS.
- 4. INSULATE DOMESTIC WATER PIPING ABOVE GRADE (EXCEPT EXPOSED CONNECTIONS TO PLUMBING FIXTURES) WITH GLASS FIBER INSULATION HAVING A VAPOR BARRIER AND JACKET. PIPE INSULATION SHALL HAVE A CONDUCTIVITY NOT EXCEEDING 0.27 BTUH x SQ. FT. FOLLOW SCHEDULE BELOW DOMESTIC HOT WATER & CIRCULATION DOMESTIC HOT 1-1/2" - 4" 1-1/2" WATER & CIRCULATION DOMESTIC 1/2" - 1-1/4" 1/2" COLD WATER DOMESTIC COLD 1-1/2" - 4"
- 5. DOMESTIC WATER PIPING INSULATION, JACKETS, COVERINGS, SEALERS, MASTICS AND ADHESIVES ARE REQUIRED TO MEET A FLAME-SPREAD RATING OF 25 OR LESS AND A SMOKE-DEVELOPED RATING OF 50 OR LESS, AS TESTED BY ASTM E84 (NFPA 255) METHOD AND SHALL BE PLENUM RATED. PROVIDE PVC JACKET FOR EXPOSED PIPING IN MECHANICAL ROOMS. INSULATION SHALL BE CONTINUOUS AT ALL HANGERS. PROVIDE GALVANIZED STEEL SHIELD BETWEEN PIPE HANGER AND INSULATION. ALL PIPE INSULATION ABOVE ACT CEILINGS ARE TO HAVE A 1HR FIRE RATED COVERING.
- 6. PROVIDE TWO-PIECE, BRONZE OR BRASS BODY, FULL PORT, 600 PSI WOG, BALL TYPE SHUT-OFF VALVES WITH BLOW-OUT PROOF STEMS AND ADJUSTABLE PACKING GLANDS. VALVES SHALL BE LEAD FREE PER NSF 61. ANNEX G REQUIREMENTS. INSTALL VALVES IN A LOCATION THAT PERMITS ACCESS FOR SERVICE WITHOUT DAMAGE TO THE BUILDING OR FINISHED MATERIALS.
- 7. PROTECT COPPER PIPING AGAINST CONTACT WITH DISSIMILAR METALS. ALL HANGERS, SUPPORTS, ANCHORS AND CLIPS SHALL BE COPPER OR COPPER PLATED. WHERE COPPER PIPING IS CARRIED ON TRAPEZE HANGERS WITH OTHER PIPING, PROVIDE A PERMANENT ELECTROLYTIC ISOLATION MATERIAL TO PREVENT CONTACT WITH DISSIMILAR OTHER METALS.
- 8. PROTECT COPPER PIPING AGAINST CONTACT WITH ALL MASONRY, WHERE COPPER IS SLEEVED THROUGH MASONRY, PROVIDE COPPER OR RED BRASS SLEEVES. WHERE COPPER MUST BE CONCEALED IN OR AGAINST MASONRY PARTITIONS, PROVIDE A HEAVY COATING OF ASPHALTIC ENAMEL ON THE COPPER PIPING AND 15# ASPHALT SATURATED FELT BETWEEN THE PIPING AND THE MASONRY PARTITION.
- 9. DOMESTIC WATER SUPPLY PIPING SHALL BE TESTED AND PROVED WATERTIGHT UNDER A WATER PRESSURE OF NO LESS THAN THE WORKING PRESSURE OF THE SYSTEM, OR AN AIR TEST OF NO LESS THAN ONE-HUNDRED (100) PSI. THIS PRESSURE SHALL BE HELD FOR AT LEAST FIFTEEN (15) MINUTES. WATER USED IN TESTING SHALL BE OBTAINED FROM A POTABLE SOURCE OF SUPPLY.

SANITARY WASTE / VENT AND STORM DRAINAGE PIPING:

- 1. SANITARY WASTE/VENT AND STORM DRAINAGE: PROVIDE SERVICE WEIGHT CAST IRON NO-HUB PIPE AND FITTINGS (CISPI 301) WITH NEOPRENE GASKET AND STAINLESS STEEL CLAMP JOINTS (CISPI 310).
- 2. SLOPE WASTE PIPING AT 1/4" PER FOOT MINIMUM FOR PIPING 2-1/2" AND SMALLER AND 1/8" PER FOOT MINIMUM FOR PIPING 3" AND LARGER UNLESS NOTED OTHERWISE.
- 3. SLOPE GREASE WASTE PIPING AT 1/4" PER LINEAR FOOT MINIMUM FOR ALL PIPE
- 4. WHERE WASTE PIPING IS EXPOSED IN REST ROOM AREAS, PROVIDE CHROME

PLATED BRASS PIPING, REMOVABLE P-TRAPS, MATCHING STOPS AND

- ESCUTCHEONS FOR ALL LAVATORIES. 5. SANITARY WASTE AND VENT SYSTEMS SHALL BE TESTED AND PROVED WATER TIGHT UNDER A HEAD PRESSURE OF NO LESS THAN 10 FT. THIS PRESSURE
- SHALL BE HELD FOR A PERIOD OF NO LESS THAN 15 MINUTES. 6. INSULATE MECHANICAL ROOM FLOOR DRAIN BODIES. P-TRAP AND HORIZONTAL DRAIN PIPING ABOVE GRADE WITH 1" THICK GLASS FIBER INSULATION WITH
- VAPOR BARRIER AND JACKET. 7. INSULATE ROOF DRAIN BODIES AND HORIZONTAL PRIMARY AND SECONDARY STORM DRAIN PIPING ABOVE GRADE WITH 1" THICK GLASS FIBER INSULATION WITH VAPOR BARRIER AND JACKET.
- 8. PIPING INSULATION, JACKETS, COVERINGS, SEALERS. MASTICS AND ADHESIVES ARE REQUIRED TO MEET A FLAME-SPREAD RATING OF 25 OR LESS AND A SMOKE-DEVELOPED RATING OF 50 OR LESS, AS TESTED BY ASTM E84 (NFPA 255) METHOD. INSULATION SHALL BE CONTINUOUS AT ALL HANGERS. PROVIDE GALVANIZED STEEL SHIELD BETWEEN PIPE HANGER AND INSULATION.

PLUMBING DRAWING LIST					
P001 PLUMBING SYMBOLS, ABBREVIATIONS, NOTES AND SPECIFICATIONS					
P002	PLUMBING SPECIFICATIONS				
P100	PLUMBING SANITARY AND VENT PLAN				
P200	PLUMBING WATER SUPPLY PLAN				
P300	PLUMBING DETAILS				
P400	PLUMBING SCHEDULE				
P500	PLUMBING RISER DIAGRAM				

## CODE COMPLIANCE

ALL WORK AND MATERIAL SHALL BE PERFORMED AND INSTALLED IN COMPLIANCE WITH THE FOLLOWING CODES AS ADOPTED AND AMENDED BY THE INSPECTING AUTHORITY. NOTHING IN THESE DRAWINGS IS TO BE CONSTRUCTED TO PERMIT WORK NOT CONFORMING TO THESE CODES OR OTHERS APPLICABLE TO THESE PROJECT

OTHERS APPL	ICABLE TO THESE PROJECT.					
1	INTERNATIONAL BUILDING CODE 2021 FOR NEW JERSEY.					
2	INTERNATIONAL MECHANICAL CODE 2021.	1				
3	NATIONAL STANDARD PLUMBING CODE 2021 (NSPC) FOR NEW JERSE'	Y.				
4	ENERGY CODE ASHRAE 90.1 (2019)					
5	INTERNATIONAL FUEL GAS CODE 2021.	•				
6	NATIONAL ELECTRICAL CODE 2020 FOR NEW JERSEY.					

#### PLUMBING GENERAL NOTES

### GENERAL REQUIREMENTS:

- PLUMBING WORK SHALL BE INSTALLED IN ACCORDANCE WITH THE NATIONAL STANDARD PLUMBING CODE 2021 (NSPC) FOR NEW JERSEY AND WITH THE REQUIREMENTS OF THE LOCAL AUTHORITY HAVING JURISDICTION.
- SCOPE: PROVIDE ALL LABOR, MATERIAL AND EQUIPMENT REQUIRED FOR THE COMPLETION AND OPERATION OF ALL PLUMBING SYSTEMS IN ACCORDANCE WITH ALL APPLICABLE CODES.
- PERMITS: APPLY AND PAY FOR ALL NECESSARY PERMITS, FEES AND INSPECTIONS REQUIRED BY ANY PUBLIC AUTHORITY HAVING JURISDICTION. ACREAGE CHARGES, FACILITIES CHARGES AND BOND PROPERTY ASSESSMENTS ARE NOT TO BE CONSTRUED TO BE A PART OF THIS CONTRACT.
- WARRANTY: PROVIDE A ONE YEAR WARRANTY, FROM THE DATE OF ACCEPTANCE OF WORK BY THE OWNER, FOR ALL PLUMBING MATERIALS AND EQUIPMENT.
- COORDINATE ALL PLUMBING PIPING LOCATIONS, ROUGH-IN LOCATIONS AND EQUIPMENT.LOCATIONS WITH OTHER TRADES TO AVOID CONFLICTS AND INTERFERENCES. FINAL PIPING AND EQUIPMENT LOCATIONS SHALL BE A CODE COMPLIANT INSTALLATION FOR ALL TRADES.
- 6. FIELD VERIFY PROPER OPERATION OF EXISTING SYSTEMS BEFORE STARTING CONSTRUCTION. NOTIFY THE ARCHITECT / ENGINEER OF RECORD OF ANY PROBLEMS OR DISCREPANCIES BETWEEN THE CONSTRUCTION DOCUMENTS AND EXISTING CONDITIONS AND/OR ANY POTENTIAL PROBLEMS OBSERVED BEFORE CONTINUING WORK IN THE AFFECTED AREAS.
- WHERE DISCREPANCIES ARE FOUND IN THE DRAWINGS AND SPECIFICATIONS THE MORE STRINGENT SHALL APPLY. CONTACT ENGINEER FOR CLARIFICATION.
- ALL PIPING SHALL BE MANUFACTURED IN THE UNITED STATES OF
- 9. ALL VALVES, BACKFLOW PREVENTERS, BOOSTER PUMPS, ETC. SERVING THE DOMESTIC WATER SYSTEM SHALL MEET LEAD FREE STANDARDS PER ANSI/NSF 372 AND NSF 61.
- 10. CUT WALLS, FLOORS AND CEILINGS AS REQUIRED FOR INSTALLATION OF PLUMBING WORK. ALL CUTTING SHALL BE HELD TO A MINIMUM. PATCH AND FINISH SURFACES TO MATCH ADJOINING SURFACES.
- 11. PLUMBING PLANS SHALL NOT BE SCALED. REFERENCE THE ARCHITECTURAL PLANS FOR ALL LOCATIONS OF PLUMBING FIXTURES, WALLS, DOORS, WINDOWS, ETC.
- 12. PLUMBING PIPING AND SPECIALTIES SHALL BE LOCATED CONCEALED IN WALLS, PARTITIONS OR ABOVE CEILINGS UNLESS NOTED OTHERWISE. PLUMBING PIPING IN EXPOSED AREAS SHALL BE RUN TIGHT TO UNDERSIDE OF STRUCTURE. PROVIDE ACCESS DOORS FOR CONCEALED SPECIALTIES.
- 13. DO NOT INSTALL PLUMBING PIPING IN AREAS SUBJECT TO FREEZING TEMPERATURES. INSTALL PLUMBING PIPING SHOWN IN EXTERIOR WALLS ON THE CONDITIONED SIDE OF THE WALL INSULATION.
- 14. PROVIDE NON-CONDUCTING DIELECTRIC UNIONS WHENEVER CONNECTING DISSIMILAR METALS.
- 15. ATTACH HANGERS TO STRUCTURE, HANGERS SHALL NOT ATTACH TO THE DECK.
- 16. PROVIDE ACCESS DOORS FOR VALVES, WATER HAMMER ARRESTORS, TRAP PRIMERS, ETC. CONCEALED IN MASONRY WALLS, GYPBOARD WALLS AND/OR CEILINGS THAT WILL REQUIRE MAINTENANCE ACCESS.
- 17. CORE DRILL THROUGH MASONRY (CMU BLOCK) WALLS FOR ALL PIPE PENETRATIONS. WHEN DRILLING OPENINGS FOR INSULATED PIPES THE OPENING'S DIAMETER SHALL BE LARGE ENOUGH FOR PIPE INSULATION TO REMAIN CONTINUOUS PASSING THROUGH THE OPENING. SEAL WATER TIGHT. PROVIDE ESCUTCHEONS IN AREAS. EXPOSED FINISHED AREAS
- 18. PLUMBING SYSTEMS INCLUDE. BUT ARE NOT LIMITED TO PLUMBING FIXTURES. DOMESTIC WATER SYSTEM, SANITARY WASTE AND VENT SYSTEM, GREASE WASTE SYSTEM.

## PLUMBING FIXTURES AND EQUIPMENT:

TO PRODUCTS SPECIFIED HEREIN.

INSTRUCTIONS.

- PROVIDE COMPLETE PLUMBING FIXTURES AND EQUIPMENT. INCLUDE SUPPLIES, STOPS, VALVES, FAUCETS, DRAINS, TRAPS,
- TAIL PIECES, ESCUTCHEONS, ETC. PLUMBING FIXTURES AND EQUIPMENT SHALL BE INSTALLED PER THE MANUFACTURER'S RECOMMENDATIONS AND INSTALLATION
- NO PRIVATE LABELED MATERIALS WILL BE ACCEPTED AS EQUALS
- 4. REFER TO KITCHEN DRAWINGS AND INSTALL REQUIRED CONDUIT AS SHOWN ON PLANS FOR PIPE RUNS CONNECTING EQUIPMENT.
- THE PLUMBING CONTRACTOR IS RESPONSIBLE FOR ALL COSTS ASSOCIATED WITH SUBSTITUTIONS TO SPECIFIED PLUMBING FIXTURES AND EQUIPMENT INCLUDING BUT NOT LIMITED TO; PROVIDING MAINTENANCE ACCESS CLEARANCE, PIPING, ELECTRICAL. REPLACEMENT OF OTHER SYSTEM COMPONENTS. BUILDING ALTERATIONS, ETC. AND ANY MODIFICATIONS TO ASSOCIATED MECHANICAL, ELECTRICAL OR PLUMBING SYSTEMS REQUIRED BY THE EQUIPMENTS INSTALLATION INSTRUCTIONS. ALL COSTS ASSOCIATED WITH SUBSTITUTIONS SHALL BE INCLUDED IN THE ORIGINAL BASE BID.

## VATER HAMMER ARRESTOR REQUIREMENTS

- PROVIDE WATER HAMMER ARRESTORS CONFORMING TO PDI-WH201 OR ASSE 1010, INSTALLED PER MANUFACTURER'S SPECIFICATIONS.
- 2. INSTALL WHERE QUICK CLOSING VALVES ARE UTILIZED.
- PROVIDE WATER HAMMER ARRESTOR ON ALL SUPPLY PIPES SERVING LAVATORIES WITH SENSOR OPERATED VALVES.
- 4. AT MINIMUM, PROVIDE ONE WATER HAMMER ARRESTOR FOR EACH BRANCH LINE TO EACH TOILET ROOM. LOCATED BETWEEN LAST TWO FIXTURES SERVED.
- 5. INSTALL ADDITIONAL SHOCK ARRESTORS IF BRANCH PIPING SERVING WATER CLOSETS IS 20'-0 IN LENGTH OR LONGER. SEE MANUFACTURER'S INSTRUCTIONS FOR DETAILED INSTALLATION INFORMATION.

## BUILDING DEPARTMENT PLUMBING NOTES

- ALL PLUMBING SYSTEMS (SANITARY, WASTE, VENT, WATER) AND ASSOCIATED EQUIPMENT SHALL BE INSTALLED, OPERATED AND MAINTAINED IN ACCORDANCE WITH THE REQUIREMENTS OF 2021 NATIONAL STANDARD PLUMBING CODE (NSPC) FOR NEW JERSEY AND LOCAL LAWS.
- . PROTECTION OF PIPING AND PLUMBING SYSTEM COMPONENTS AS PER SECTION 2.9.
- 3. TRENCHING, EXCAVATION AND BACKFILL AS PER SECTION 2.6. 4. RODENT PROOFING AS PER 2021 NATIONAL STANDARD
- PLUMBING CODE 2021 (NSPC) FOR NEW JERSEY.
- 3.6 AND 3.7. 6. EQUIPMENT CONNECTIONS AND JOINING OF PIPING SHALL BE

. MATERIALS USED IN PLUMBING SYSTEMS SHALL BE IN

ACCORDANCE WITH THE REQUIREMENTS OF SECTION 3.4, 3.5,

- IN ACCORDANCE WITH THE REQUIREMENTS OF CHAPTERS 7, 10, 11 AND 12.
- . DRAINAGE PIPE CLEAN-OUTS SHALL BE INSTALLED IN ACCORDANCE WITH THE REQUIREMENTS OF SECTION 5.4. 8. VERTICAL AND HORIZONTAL PIPING SHALL BE SUPPORTED IN
- ACCORDANCE WITH THE REQUIREMENTS OF CHAPTER 8. 9. WATER SUPPLY SYSTEMS SHALL BE INSTALLED AND

MAINTAINED IN ACCORDANCE WITH THE REQUIREMENTS OF

- CHAPTER 10 SECTION 10.1, 10.3, 10.4, 10.6, 10.14 AND 10.15. 10. THE SANITARY DRAINAGE SYSTEM SHALL BE SIZED AND INSTALLED IN ACCORDANCE WITH THE REQUIREMENTS OF
- 11. VENT PIPING FOR THE SANITARY DRAINAGE SYSTEM SHALL BE INSTALLED IN ACCORDANCE WITH THE REQUIREMENTS OF CHAPTER 12 SECTIONS 12.1, 12.2, 12.10 AND APPENDIX E
- 12. INSPECTION AND TESTING OF PLUMBING SYSTEMS SHALL BE IN ACCORDANCE WITH SECTION 1.2, 10.5 AND CHAPTER 15.
- 13. INSPECTION AND TESTING OF GAS PIPING SYSTEM SHALL BE IN ACCORDANCE WITH SECTION 406 OF 2021 IFGC.

## PLUMBING SPECIFICATIONS

1. BASIC PLUMBING REQUIREMENTS, MATERIALS AND METHODS

CHAPTER 11.

A. PROVIDE ALL MATERIAL, TOOLS, SUPERVISION AND LABOR INCLUDING ALL MISCELLANEOUS AND INCIDENTAL ITEMS REQUIRED FOR COMPLETE AND OPERABLE PLUMBING INSTALLATIONS AS SHOWN OR DESCRIBED ON THE DRAWINGS AND IN THESE SPECIFICATIONS.

- B. THE CONTRACTOR SHALL BE RESPONSIBLE FOR THE PROTECTION OF ALL NEW CONDITIONS AND MATERIALS WITHIN THE CONSTRUCTION AREA. ANY DAMAGE CAUSED BY THE CONTRACTOR SHALL BE REPAIRED TO THE OWNER'S SATISFACTION.
- C. OBTAIN ALL PERMITS, PAY ALL PERMIT FEES AND SCHEDULE ALL REQUIRED INSPECTIONS. COPIES OF ALL PERMITS AND INSPECTION CERTIFICATES SHALL BE FORWARDED TO THE
- THE GENERAL CONDITIONS OF THE CONTRACT AND ALL DIVISION 1 REQUIREMENTS APPLY TO THE WORK OF THIS SECTION.
- THE CONTRACTOR SHALL VISIT THE SITE PRIOR TO SUBMITTING BID TO DETERMINE CONDITIONS AND THE EXTENT OF THE WORK. BY COMMENCING WORK. THE CONTRACTOR ACKNOWLEDGES HIS CONFIRMATION OF ALL CONDITIONS AS ACCEPTABLE WITH REFERENCE TO HIS CONTRACT, SCOPE OF WORK AND BID PRICE SUCH THAT NO ADDITIONAL COMPENSATION SHALL BE FORTHCOMING FOR UNFORESEEN EXISTING CONDITIONS.
- F. IN ALL AREAS SUBJECT TO FREEZING CONDITIONS, THE CONTRACTOR SHALL PROVIDE FREEZE PROTECTION FOR ALL DOMESTIC WATER PIPING INSTALLED UNDER HIS CONTRACT.
- E. VERIFY ALL INDICATED CONDITIONS BEFORE STARTING WORK AND G. ALL ELECTRICAL REQUIREMENTS SHALL BE COORDINATED WITH THE CONTRACTOR FOR ELECTRICAL WORK. THIS CONTRACTOR IS RESPONSIBLE FOR ALL LOW VOLTAGE WIRING FOR EQUIPMENT FURNISHED BY THE OWNER. INSTALLED UNDER HIS CONTRACT. THE CONTRACTOR FOR ELECTRICAL WORK IS RESPONSIBLE FOR LINE VOLTAGE POWER
- H. COLOR AND FINISH SELECTIONS FOR ALL MATERIALS, INCLUDING PAINTING OF PIPING, SHALL BE AS DIRECTED AND/OR APPROVED BY THE ARCHITECT.
- MINOR DETAILS NOT SHOWN OR SPECIFIED, BUT NECESSARY FOR THE PROPER AND ACCEPTABLE CONSTRUCTION, INSTALLATION OR OPERATION OF ANY PART OF THE WORK AS DETERMINED BY THE ENGINEER SHALL BE INCLUDED AS IF SPECIFIED OR INDICATED ON THE DRAWINGS.
- J. THIS CONTRACTOR SHALL BE RESPONSIBLE FOR COORDINATING ALL REQUIREMENTS FOR THE INSTALLATION, CONNECTION, EXTENSION OR MODIFICATION TO ALL UTILITY SERVICES WITH RESPECTIVE PROVIDERS INCLUDING PAYMENT OF ALL ASSOCIATED FEES.
- K. THE CONTRACTOR IS RESPONSIBLE FOR ALL PAINTING ASSOCIATED WITH CUTTING AND PATCHING. ALL PAINTING IN AREAS WITH COMPLETE FINISH RENOVATIONS SHALL BE PROVIDED BY THE GENERAL CONTRACTOR.

## 1.02 SUBMITTALS

WIRING ONLY.

A. SUBMITTAL REQUIREMENTS SHALL BE COORDINATED WITH THE ARCHITECT AND AUTHORITIES HAVING JURISDICTION. UNLESS OTHERWISE DIRECTED, CONTRACTOR SHALL PROVIDE SUBMITTALS AS LISTED BELOW.

- PIPE AND FITTINGS VALVES
- 3. HANGERS AND SUPPORTS 4. PLUMBING PIPING LAYOUT
- TESTS 6. PLUMBING FIXTURES
- 7. FLOOR DRAINS 8. MIXING VALVES
- BACKFLOW PREVENTER 10. ALL SCHEDULED PLUMBING EQUIPMENT
- 11. WATER HEATER 12. GREASE TRAP

B. SUBMITTALS FROM SUPPLIERS OR MANUFACTURERS WHICH DO NOT BEAR THE STAMP OF THE SUBMITTING CONTRACTOR INDICATING THAT THE CONTRACTOR HAS REVIEWED THE SUBMITTAL FOR CONFORMANCE WITH

THE PROJECT REQUIREMENTS WILL BE RETURNED REJECTED.

- C. THE ENGINEER'S REVIEW OF SUBMITTALS IS A COURTESY WHICH DOES NOT RELIEVE THE CONTRACTOR FROM CONFORMING WITH THE CONSTRUCTION DOCUMENTS, REGARDLESS OF THE ACTION INDICATED BY THE SHOP DRAWINGS STAMP.
- D. REVIEW OF SHOP DRAWINGS BY THE ENGINEER SHALL BE LIMITED TO THE INITIAL REVIEW, AND A SECOND REVIEW OF ANY REQUIRED RESUBMITTED DATA. IF THE ENGINEER IS REQUIRED TO REVIEW SHOP DRAWINGS FOR A THIRD (OR MORE) SUBMISSION OF THE SAME ITEM, THE CONTRACTOR SHALL BE LIABLE FOR COMPENSATING THE ENGINEER FOR THESE SUBSEQUENT REVIEWS AS PER THE ENGINEER'S CURRENT HOURLY RATE SCHEDULE.
- E. SUBMIT PROOF OF APPROVAL AND/OR CONFIRMATION OF SATISFACTORY TEST RESULTS TO THE OWNER AND THE ARCHITECT.
- F. SUBMIT TO THE OWNER'S MAINTENANCE PERSONNEL OPERATION AND MAINTENANCE DATA FOR ALL SYSTEM COMPONENTS, SERVICING REQUIREMENTS, INSPECTION DATA, REPLACEMENT PART NUMBERS AND AVAILABILITY AND CONTACT INFORMATION FOR SERVICE/SUPPLY COMPANY.
- G. FOR ALL BELOW GRADE PIPING WHERE ACTUAL INSTALLATION DEVIATES FROM CONSTRUCTION DRAWINGS, THE CONTRACTOR SHALL PROVIDE AS-BUILT DRAWINGS INDICATING BELOW GRADE PIPE LOCATIONS DIMENSIONED TO NEAREST COLUMN LINES.
- H. RECORD AS-BUILT DRAWINGS SHALL BE SUPPLIED TO THE OWNER/TENANT AFTER COMPLETION OF THE WORK SHOWING ANY ALTERATIONS. ADDITIONS AND/OR DELETIONS TO THE SYSTEM(S) INSTALLED.
- 1.03 SUBSTITUTIONS
- A. ALL EQUIPMENT SHALL BE PRODUCTS OF THE SPECIFIED MANUFACTURER OR MANUFACTURERS. ALL BIDS SHALL BE BASED ON THE SPECIFIED MANUFACTURER OR MANUFACTURER'S EQUIPMENT. FOR SUBSTITUTIONS OF OTHER MANUFACTURER'S EQUIPMENT TO BE CONSIDERED, THE SUBSTITUTION MUST BE INDICATED PRIOR TO BIDDING WITH THE REASON FOR THE PROPOSED SUBSTITUTION IDENTIFIED, AND THE PROPOSED CREDIT TO THE OWNER INDICATED. THE ENGINEER SHALL DETERMINE THE
- B. THE CONTRACTOR ASSUMES ALL RESPONSIBILITY FOR COORDINATING THE WORK OF OTHER TRADES WHICH MAY BE AFFECTED BY SUBSTITUTIONS, INCLUDING ALL RELATED COSTS.

ACCEPTABILITY OF ANY PROPOSED SUBSTITUTIONS.

### 1.04 DEFINITIONS

- A. FURNISH: TO PURCHASE, PROCURE, ACQUIRE AND DELIVER, COMPLETE WITH RELATED ACCESSORIES.
- B. INSTALL: TO ERECT, MOUNT AND CONNECT, COMPLETE WITH RELATED ACCESSORIES
- B. PROVIDE: TO FURNISH AND INSTALL.
- C. PLUMBING CONTRACTOR, THE CONTRACTOR, THIS CONTRACTOR: THE CONTRACTOR FOR PLUMBING WORK WHICH IS SPECIFIED HEREIN AND SHOWN ON THESE DRAWINGS.
- D. REFER TO THE NATIONAL STANDARD PLUMBING CODE FOR ADDITIONAL DEFINITIONS.

# 1.05 DRAWINGS

- A. THE DRAWINGS ARE DIAGRAMMATIC AND ARE INTENDED TO ILLUSTRATE THE GENERAL ARRANGEMENT AND ROUTING OF PIPING AND GENERAL LOCATIONS OF EQUIPMENT. PRECISE LOCATIONS OF EQUIPMENT, RISERS AND STACKS, AND ROUTING AND ELEVATION OF ALL PIPING SYSTEMS SHALL BE COORDINATED IN THE FIELD WITH THE ARCHITECT. ARCHITECTURAL DRAWINGS. THE WORK OF OTHER TRADES, EXISTING AND NEW BUILDING CONDITIONS AND/OR THE PREFERENCES OF THE OWNER/TENANT AS CONSTRUCTION PROCEEDS. ALL PIPING SHALL BE INSTALLED CONCEALED IN FINISHED
- SPACES, UNLESS NOTED OTHERWISE. B. PROVIDE ALL NECESSARY INCIDENTAL MATERIALS AND ACCESSORIES REQUIRED TO MAKE THE WORK COMPLETE IN ALL RESPECTS. EVEN IF NOT PARTICULARLY SHOWN OR SPECIFIED.
- C. REFER TO PLUMBING EQUIPMENT/FIXTURE SCHEDULE ON THE DRAWINGS FOR ALL FIXTURE AND EQUIPMENT SPECIFICATIONS.
- D. REFER TO FIXTURE CONNECTION SIZE SCHEDULE FOR ALL FIXTURE ROUGHING SIZE REQUIREMENTS.
- REPORT ANY DISCREPANCIES. THE DRAWINGS REFLECT CONDITIONS WHICH CAN BE REASONABLY INTERPRETED FROM THE EXISTING VISIBLE CONDITIONS OR FROM DRAWINGS AND INFORMATION
- F. LOCATE ALL FIXTURES AND EQUIPMENT AS PER THE FINAL ARCHITECTURAL DRAWINGS

#### 1.06 PRODUCTS A. SANITARY AND VENT PIPING:

- 1. ABOVE GRADE PIPING SHALL BE HUBLESS CAST IRON PIPE WITH STAINLESS STEEL COUPLINGS AND ELASTOMERIC GASKETS WITH A MINIMUM NO. OF BANDS PER COUPLING AS PER CISPI 301.
- 2. SLOPE OF DRAINAGE SYSTEM SHALL BE 1/8" PER FOOT OF RUN FOR PIPE OVER 3" (I.D.) AND 1/4" PER FOOT OF RUN FOR PIPE 3" AND SMALLER (I.D.). VENT PIPING SHALL BE PITCHED TO DRAIN.
- 3. ALL CAST IRON SOIL PIPE AND FITTINGS SHALL BE MARKED WITH THE COLLECTIVE TRADEMARK OF THE CAST IRON SOIL PIPE INSTITUTE (CISPI) AND BE LISTED BY NSF INTERNATIONAL.
- B. DOMESTIC WATER PIPING:

COPPER TUBE.

- 1. ABOVE GRADE WATER PIPING SHALL BE TYPE 'L' HARD-DRAWN
- 2. FITTINGS IN DOMESTIC WATER PIPING SHALL BE WROUGHT COPPER OR CAST BRASS.
- 3. JOINTS SHALL BE MADE WITH LEAD-FREE SOLDER.
- 4. THE ENTIRE DOMESTIC WATER DISTRIBUTION SYSTEM SHALL BE INSULATED INCLUDING ALL VALVES, FITTINGS, ETC.
- 5. COMPLY WITH NSF 61 FOR MATERIALS FOR WATER-SERVICE PIPING AND SPECIALTIES FOR DOMESTIC WATER.

6. ALL DOMESTIC WATER PIPING ABOVE GRADE SHALL BE INSULATED WITH FIRE-RETARDANT, FACTORY-APPLIED JACKET. PROVIDE COLD WATER PIPING WITH FACTORY-APPLIED VAPOR BARRIER. INSULATION REQUIREMENT SHOULD COMPLY WITH ASHRAE 90.1 2019 SECTION

BTU· IN./

(H. FT2. °F)

0.25-0.29

COMPATIBLE WITH THE INTENDED USE.

105-140 0.21-0.28

USAGE (°F)

141-200

40-60

#### MINIMUM PIPE INSULATION THICKNESS NOMINAL PIPE OR TUBE FLUID INSULATION CONDUCTIVITY SIZE (INCHES) OPERATING TEMPERATURE CONDUCTIVITY | MEAN RATING | $\begin{vmatrix} 1 \text{ to} & 1\frac{1}{2} \text{ to} & 4 \text{ to} \\ < 1\frac{1}{2} & < 4 & 8 \end{vmatrix} \ge 8$

TEMPERATURE, <1

125

100

75

1.5 | 1.5 | 2.0 | 2.0 | 2.0

1.0 | 1.0 | 1.5 | 1.5 | 1.5

ENERGY CONSERVATION CODE SECTION 7.4.3 REFER BELOW TABLE.

0.5 0.5 1.0 1.0 1.0 0.21-0.27 7. AS PER ASHRAE 90.1 2019 SECTION 7.4.4.1. TEMPERATURE CONTROLS SHALL BE PROVIDED THAT ALLOW FOR STORAGE TEMPERATURE ADJUSTMENT FROM 120° OR LOWER TO A MAXIMUM TEMPERATURE

8. AS PER ASHRAE 90.1 2019 SECTION 7.4.4.2, SYSTEM DESIGNED TO MAINTAIN USAGE TEMPERATURE IN HOT WATER PIPES, SUCH AS RECIRCULATING HOT WATER SYSTEMS OR HEAT TRANCE, SHALL BE EQUIPED WITH AUTOMATIC TIME SWITCHES OR OTHER CONTROLS THAT CAN BE USED TO SWITCH THE USAGE TEMPERATURE MAINTAINANCE SYSTEM DURING EXTENDED PERIOD WHEN HOT WATER IS NOT

9. AS PER ASHRAE 90.1 2019 SECTION 7.4.4.3, TEMPERATURE CONTROLLING MEANS SHALL BE PROVIDED TO LIMIT THE MAXIMUM TEMPERATURE OF WATER DELIVERED FROM LAVATORY FAUCETS IN PUBLIC FACILITY RESTROOMS TO 110°F.

- 10. AS PER ASHRAE 90.1 2019 SECTION 7.4.4.4, WHEN USED TO MAINTAIN STORAGE TANK WATER TEMPERATURE, RECIRCULATING PUMPS SHALL BE EQUIPPED WITH CONTROLS LIMITING OPERATION TO A PERIOD FROM THE START OF THE HEATING CYCLE TO A MAXIMUM OF FIVE MINUTES AFTER THE END OF THE HEATING CYCLE.
- 11. SEAL ALL JOINTS BETWEEN SEGMENTS OF INSULATION.
- 12. PROVIDE SHIELDS BETWEEN HANGERS AND INSULATION.

## C. MIXING VALVES

- 1. VALVE BODY SHALL BE MADE OF CAST BRASS. THE INTERNAL COMPONENTS SHALL BE MADE OF BRASS OR STAINLESS STEEL.
- 2. THE TEMPERATURE SETTING IS AS PER THE REQUIREMENT OF THE PLUMBING FIXTURE FOR LOCALIZED MIXING OF WATER.
- D. HANGERS AND SUPPORTS:

CLEVIS HANGERS.

SPECIFIED.

EASE OF SERVICING.

- 1. HANGERS SHALL BE STANDARD STEEL, MALLEABLE OR WROUGHT IRON, AS MANUFACTURED BY GRINNELL OR APPROVED EQUAL, SUITABLE FOR THE TYPE OF CONSTRUCTION. PIPING SHALL NOT BE HUNG FROM OTHER PIPE
- 2. SECTIONS OF INDIVIDUAL PIPE RUNS SHALL BE SUPPORTED BY
- 3. ALL EQUIPMENT SHALL BE PROVIDED WITH APPROVED SUPPORTS.
- APPLICABLE FEDERAL, STATE AND LOCAL CODES AND STANDARDS AND THE REQUIREMENTS OF AUTHORITIES HAVING JURISDICTION. 5. UNLESS OTHERWISE INDICATED OR REQUIRED BY AUTHORITIES HAVING JURISDICTION, THE FOLLOWING SHALL BE PROVIDED WITH SEISMIC RESTRAINTS AS REQUIRED BY THE 2021 INTERNATIONAL

BUILDING CODE FOR NEW JERSEY, SECTION 1610.6.4: ALL

EQUIPMENT AND MACHINERY, ALL NEW PIPING 2-1/2" AND LARGER

(1-1/4" AND LARGER INBOILER / MECHANICAL ROOMS) WITH

4. PROVIDE SEISMIC RESTRAINTS IN ACCORDANCE WITH ALL

- HANGERS GREATER THAN 12" IN LENGTH FROM THE TOP OF PIPE TO THE STRUCTURE.
- 6. SUPPORTS SHALL BE PROVIDED IN STRICT ACCORDANCE WITH THE RECOMMENDATIONS OF THE PIPING MANUFACTURER.
- E. DOMESTIC WATER HEATER 1. ELECTRIC TYPE HOT WATER HEATER BELOW CAPACITY AND SHALL HAVE MAX. 150 PSI WORKING PRESSURE AND BE EQUIPPED WITH GLASS LINING PERMANENTLY BONDED TO TANK INTERIOR SURFACE. 1 NOS WATER HEATER (EWH-1), 110 GPH RECOVERY RATE OVERALL BUILDING @ 90 DEG. F TEMP RISE FOR OVERALL. ANOTHER 1 NOS. INSTANTANEOUS ELECTRIC WATER HEATER (EWH-2) FOR LAVATORY. REFER INDIVIDUAL WATER HEATER SCHEDULE AND GPH
- THE PLAN. 2. INSTALL THE WORK OF THIS SECTION IN ACCORDANCE WITH NFPA 54, NFPA 211, AND THE MANUFACTURER'S PRINTED INSTALLATION INSTRUCTIONS, UNLESS OTHERWISE
- 3. THE DRAIN VALVE SHALL BE LOCATED IN THE FRONT FOR

REQUIREMENT FOR THE SPECIFIC LOCATIONS AS SHOWN IN

CONSULTANTS (ENGINEER):

382 NE 191ST STREET SUITE 49674, MIAMI, FL 33179 PH-914.257.3455 WWW.NY-ENGINEERS.COM

**NEARBY ENGINEERS** 

<u>CONTRACTOR'S NOTES:</u> WRITTEN DIMENSIONS HOLD PREFERENCE OVER SCALED DIMENSIONS. DO NOT SCALE THE DRAWINGS. THE CONTRACTORS MUST VISIT IOB SITE TO VERIEY ALL EXISTING CONDITIONS AND DIMENSIONS BEFORE SUBMITTING BIDS. REPORT ANY DISCREPANCIES OF ANY CONDITIONS WHICH MAY INTERFERE WITH THE PROPER EXECUTION OF, THE CONTRACT TO THE TENANT'S REPRESENTATIVE, REPORT DISCREPANCIES DURING BIDDING PROCESS AND BEFORE START OF CONSTRUCTION. CHANGE ORDERS NEED TO BE

CONDITIONS OR CONFLICTS BETWEEN THE PLANS AND

ISSUE 10.31.24 LL/CLIENT REVIEW SET 11.15.24 LL/CLIENT REVIEW SET 11.22.24 BD SUBMISSION

APPROVED BY TOWNSQUARE CONSTRUCTION

MANAGER FOR ISSUES ARISING FROM THE FIELD

THE EXISTING CONDITIONS PRIOR TO THE

COMMENCEMENT OF WORK.

DATE REVISION

1 11.15.24 CLIENT COMMENTS



SHEET NUMBER:

PLUMBING SYMBOL LIST, ABBREVIATIONS & **GENERAL NOTES** 

- F. HOT WATER RE-CIRCULATING PUMP
- IN-LINE PUMP: SINGLE STAGE VOLUTE TYPE PUMP SHALL BE MADE OF CAST IRON OR FORGED LEAD-FREE BRONZE IMPELLER.
- 2. THE PUMP SHALL HAVE A GROUND AND POLISHED STEEL SHAFT WITH A HARDENED INTEGRAL THRUST COLLAR. THE SHAFT SHALL BE SUPPORTED BY TWO HORIZONTAL SLEEVE BEARINGS DESIGNED TO CIRCULATE OIL. THE PUMPS ARE TO BE EQUIPPED WITH A MECHANICAL SEAL WITH CARBON SEAL FACE ROTATING AGAINST CERAMIC SEAT. THE MOTOR SHALL BE NON-OVERLOADING AT ANY POINT ON PUMP CURVE.
- 3. DIRECT CONNECT PUMP TO ELECTRIC MOTOR WITH FLEXIBLE COUPLING. THE MOTOR SHALL BE OF THE DRIP-PROOF, SLEEVE-BEARING, QUIET OPERATING, RUBBER-MOUNTED CONSTRUCTION. EQUIPMENT MOTOR WITH BUILT-IN THERMAL OVERLOAD PROTECTION.
- 4. INSTALL IN-LINE CIRCULATING PUMPS BETWEEN PIPE FLANGES IN PIPING SYSTEMS. INSTALL OVERHEAD PIPE SUPPORTS, BOTH SIDES OF IN-LINE PUMPS, INSTALLED IN HORIZONTAL PIPING RUNS.
- G. VALVES:
- 1. PROVIDE GATE VALVES, BUTTERFLY OR BALL VALVES FOR SHUT-OFF DUTY ON MAIN AND BRANCH SUPPLY LINES. FOR ALL PIPE RUNS 2" AND SMALLER, PROVIDE BALL FOR ALL PIPE RUNS LARGER THAN 2" AND SMALLER THAN 4", PROVIDE GATE VALVES. PIPING 4" AND LARGER, PROVIDE BUTTERFLY VALVES FOR SHUT-OFF DUTY.
- 2. ALL FIXTURES WITH THE EXCEPTION O FLUSHOMETER-EQUIPPED WATER CLOSETS AND URINALS SHALL HAVE STOP VALVES TO CONTROL SUPPLY TO THE FIXTURE. WHERE SUPPLIES ARE EXPOSED PROVIDE CHROME-PLATED STOPS WITH CHROME-PLATED ESCUTCHEONS ON PIPING PENETRATIONS.
- 3. ALL PLUMBING FIXTURES AND EQUIPMENT TO HAVE SHUT-OFF VALVES ON SUPPLY LINES.
- 4. ALL BRANCH LINES TO HAVE SHUT-OFF VALVES.
- 5. ALL VALVES SHALL BE ACCESSIBLE. PROVIDE ACCESS DOORS WHERE REQUIRED FOR VALVE ACCESS.
- 6. PROVIDE GLOBE VALVES FOR THROTTLING/BALANCING OF THE HOT WATER CIRCULATING SYSTEM.
- H. SLEEVES AND ESCUTCHEONS:
- 1. SLEEVES THROUGH STRUCTURAL CONCRETE MEMBERS AND SLEEVES FOR WALLS BELOW GRADE AND FLOORS ON GRADE SHALL BE STANDARD WEIGHT GALVANIZED SCHEDULE 40 STEEL PIPE. SLEEVES THROUGH OTHER THAN STRUCTURAL COMPONENTS OF THE BUILDING SHALL BE 20 GAGE GALVANIZED SHEET METAL WITH LOCK SEAM JOINTS. USG THERMAFIBER SAFING INSULATION SHALL BE INSTALLED BETWEEN PIPE AND SLEEVE.
- 2. PIPE ESCUTCHEON PLATES SHALL BE INSTALLED WHERE EXPOSED PIPING PASSES THROUGH WALLS, CEILINGS, AND FLOORS AND SHALL BE MINIMUM 20 GAGE STEEL. PROVIDE CHROME PLATED ESCUTCHEON PLATES IN FINISHED AREAS.
- I. DRAINAGE ACCESSORIES
- 1. GENERAL:
- a. INSTALL THE WORK OF THIS SECTION IN ACCORDANCE WITH THE MANUFACTURER'S PRINTED INSTALLATION INSTRUCTIONS, UNLESS OTHERWISE SPECIFIED.
- b. SECURE EXTERNAL COMPONENTS IN PLACE WITH VANDAL RESISTANT FASTENERS OR DEVICES WHICH CANNOT BE REMOVED WITHOUT SPECIAL TOOLS.
- J. DEVICES:
  - a. CLEANOUT & CLEANOUT PLUG
- THREADED PIPE FITTING OR CAST IRON FERRULE WITH GAS TIGHT CLEANOUT PLUG
- PLUG SHOULD BE CAST BRASS OR BRONZE, WITH THREADED END, AND RAISED OR COUNTERSUNK HEAD.
- LUBRICATE THREADS OF CLEANOUT PLUG WITH ANTI-SEIZE LUBRICANT BEFORE FINAL INSTALLATION.
- b. CLEANOUT WALL PLATE
- IT SHOULD BE ROUND, STAINLESS STEEL OR POLISHED CHROME PLATED BRONZE COVER PLATE WITH STAINLESS STEEL VANDAL RESISTANT FASTENER TO SECURE TO CLEANOUT PLUG.

  c. CLEANOUT DECK PLATE
- IT SHOULD BE STANDARD DUTY FLOOR CLEANOUT FITTING WITH COATED CAST IRON BODY; ROUND, POLISHED NICKEL BRONZE SCORIATED TOP SECURED TO CLEANOUT PLUG WITH STAINLESS STEEL VANDAL RESISTANT FASTENER; THREADED HEIGHT ADJUSTMENT, CAST IRON HEAD, GAS TIGHT CLEANOUT PLUG, AND CONNECTION TO MATCH PIPING OPTION SELECTED.
- GRILLE FREE AREA SHOULD BE AT LEAST EQUAL TO CROSS-SECTION AREA OF PIPE TO WHICH CONNECTION MADE AND MADE OF POLISHED NICKEL BRONZE, WITH REMOVABLE GRATE, EITHER PERFORATED OR BAR TYPE. GRATE ATTACHED TO GRILLE BODY WITH VANDAL RESISTANT FASTENER.
- K. INSTALL PIPING TO CONSERVE BUILDING SPACE. DO NOT INTERFERE WITH USE OF BUILDING SPACE AND THE WORK OF OTHER TRADES. ALL PIPING RUN IN CEILING SHALL BE INSTALLED TIGHT TO THE STRUCTURE ABOVE.
- L. INSTALL PIPING TO ALLOW FOR EXPANSION AND CONTRACTION WITHOUT STRESSING PIPE, JOINTS OR CONNECTED EQUIPMENT. PROVIDE PIPE ANCHORS, GUIDES AND EXPANSION JOINTS OR LOOPS IN ALL HOT WATER AND HOT WATER CIRCULATING MAIN SUPPLY PIPING AND SEGMENTS OF SUCH PIPE THAT EXCEED 30'-0" IN LENGTH.
- M. IN ALL AREAS WITH FINISHED SURFACES, SYSTEM PIPING AND COMPONENTS SHALL BE CONCEALED ABOVE OR WITHIN FINISHED SURFACES.
- N. REDUCTIONS IN PIPE SIZES SHALL BE MADE WITH ONE-PIECE REDUCING FITTINGS. BUSHINGS ARE NOT ACCEPTABLE. USE FLANGED FITTINGS AT THE BASE OF RISERS.
- O. VENT PENETRATIONS THROUGH THE ROOF SHALL BE FLASHED.
- P. IF WATER PRESSURE EXCEEDS 80 PSI, A WATER PRESSURE REDUCING VALVE SHALL BE INSTALLED IN WATER PIPING AT CONNECTION TO MAIN.
- Q. PROVIDE DIELECTRIC FITTINGS BETWEEN DISSIMILAR METALS.
- R. PIPE BACKFLOW PREVENTER DRAINS TO FLOOR DRAIN OR OTHER APPROVED INDIRECT WASTE SOURCE.
- S. PROVIDE ACCESS DOORS/PANELS FOR SERVICE AND ACCESS TO ALL VALVES AND OTHER SYSTEM COMPONENTS ENCLOSED IN WALLS AND CEILINGS. ACCESS DOORS SHALL BE FURNISHED BY THIS CONTRACTOR, INSTALLED BY THE GENERAL CONTRACTOR.
- T. ALL FIXTURES REQUIRING VACUUM BREAKERS SHALL BE EQUIPPED WITH INTEGRAL VACUUM BREAKERS.

- W. ANY PENETRATIONS THROUGH FIRE RATED PARTITIONS, FLOORS, OR CEILINGS SHALL BE STEEL SLEEVED AND SEALED WITH 3M BRAND UL RATED FIRE BARRIER CAULK OR APPROVED EQUAL.
- X. WHEN THE WATER PIPING SYSTEM IS COMPLETE, THOROUGHLY FLUSH ALL DIRT, SEDIMENT, SOLDER, ETC., OUT OF THE SYSTEM, REMOVING ALL STRAINERS, VALVE STEM SEATS, ETC., REQUIRED TO ACCOMPLISH THE
- Y. AT ALL INDIRECT WASTE DRAINS, MAINTAIN AIR GAP AS REQUIRED BY CODE.
- Z. INSTALL SLEEVES FOR ALL PIPES WHICH PASS THROUGH WALLS, FLOORS, AND CEILINGS. WHERE PIPES ARE TO BE INSULATED, THE SLEEVE SHALL BE LARGE ENOUGH TO ACCOMMODATE INSULATION. SLEEVES SHALL BE FLUSH WITH FINISHED SURFACES AT BOTH ENDS. ON FINISHED SURFACES IN EXPOSED AREAS PROVIDE ESCUTCHEONS COMPATIBLE WITH FINISH.
- AA. PROVIDE WATER HAMMER ARRESTERS ON SUPPLY PIPING TO ALL

FLUSHOMETER VALVES AND QUICK-CLOSING VALVES.

- AB. UNLESS OTHERWISE INDICATED, TRAPS SEALS AT ALL FLOOR DRAINS SHALL BE MAINTAINED BY AN APPROVED TRAP PRIMING DEVICE.
- AC. MAINTAIN ALL REQUIRED AND RECOMMENDED CLEARANCES FOR ALL PLUMBING SYSTEM COMPONENTS AND EQUIPMENT.
- AD. MAINTAIN MINIMUM 10'-0" CLEARANCE BETWEEN ALL PLUMBING V.T.R.S AND ALL OUTDOOR AIR INTAKES. OFFSET VENT STACKS AND STACK VENTS IF AND AS REQUIRED BELOW ROOF TO MAINTAIN SUCH CLEARANCE WHETHER OR NOT SUCH OFFSET IS INDICATED ON THE DRAWINGS. PROVIDE ALL REQUIRED SEISMIC SUPPORTS.
- 2. INSTALLATION

#### 2.01 GENERAL

- A. ALL WORK WHICH REQUIRES DISRUPTION OF THE ROOFING SHALL BE DONE BY A CONTRACTOR CERTIFIED BY THE ROOFING MANUFACTURER AS REQUIRED TO MAINTAIN ANY EXISTING ROOF WARRANTIES.
- B. EXTERIOR INSTALLATIONS TO BE WEATHER PROOF IN ALL RESPECTS.
- C. EXTERIOR MATERIALS AND EQUIPMENT SHALL BE PAINTED TO PREVENT CORROSION, COLOR PER ARCHITECT.
- D. COORDINATE THE PLUMBING WORK WITH ALL OTHER AFFECTED WORK AND THE CONSTRUCTION SCHEDULE.
- E. REAM PIPE AND TUBE ENDS. REMOVE BURRS. BEVEL PLAIN AND FERROUS END PIPE.
- F. REMOVE SCALE AND FOREIGN MATERIAL, FROM INSIDE AND OUTSIDE, BEFORE ASSEMBLY.
- G. PREPARE PIPING CONNECTIONS TO EQUIPMENT WITH FLANGES AND UNIONS.
- H. COORDINATION WITH THE WORK OF OTHER TRADES IS REQUIRED. PROVIDE OFFSETS IN PIPING SYSTEMS OR MINOR DEVIATIONS TO THE INDICATED PIPE ROUTING IN ORDER TO COORDINATE THE PLUMBING WORK WITH THE WORK OF ALL OTHER TRADES AND THE GENERAL BUILDING CONDITIONS.
- I. NO DOMESTIC WATER PIPING SHALL BE INSTALLED IN UNHEATED SPACES.
- J. PRIOR TO DISCONNECTING AND CONNECTING NEW WORK TO EXISTING SYSTEMS, THE PLUMBING CONTRACTOR SHALL NOTIFY THE PROPERTY MANAGER AND OFFER A PROPOSED SCHEDULE OF WORK. ESB WILL AUTHORIZE CONNECTIONS AND COORDINATE NECESSARY SHUT DOWNS AND DRAIN DOWNS AS REQUIRED. SHUT DOWNS AND DRAIN DOWNS MAY BE PERFORMED BY THE PLUMBING CONTRACTOR ONLY AFTER RECEIVING ESB AUTHORIZATION, AND SHOULD BE PERFORMED UNDER SUPERVISION OF ESB PERSONNEL. THREE (3) DAYS ADVANCE NOTICE TO THE PROPERTY MANAGER IS REQUIRED.
- K. THE PLUMBING CONTRACTOR IS ADVISED THAT DUE TO THE NATURE OF THE OPERATIONS AND TENANT REQUIREMENTS, CONNECTIONS TO EXISTING SYSTEMS MAY HAVE TO BE MADE AFTER REGULAR WORKING HOURS. THE PROPERTY MANAGER WILL ADVISE THE PLUMBING CONTRACTOR OF THE TIME CONSTRAINTS UPON RECEIPT AND APPROVAL OF THE PLUMBING CONTRACTOR'S REQUEST FOR SHUT DOWN AND CONNECTION TO EXISTING
- L. WHEN CONNECTING TO EXISTING STACKS AND RISERS, PROVISION IS TO BE MADE FOR FUTURE CONNECTIONS BY PROVIDING CAPPED AND VALVED OUTLETS ON DOMESTIC WATER RISERS AND PLUGGED OUTLETS ON THE SANITARY AND VENT STACKS.

## 2.02 ABOVE GRADE

- A. INSTALL PLUMBING PIPING IN ACCORDANCE WITH RECOGNIZED INDUSTRY PRACTICES TO ENSURE THAT PIPING COMPLIES WITH REQUIREMENTS AND SERVES INTENDED PURPOSES.
- B. ROUTE PIPING IN AN ORDERLY MANNER, PLUMB AND PARALLEL TO BUILDING STRUCTURE. MAINTAIN GRADIENT. SLOPE PIPING AND ARRANGE SYSTEMS TO DRAIN. IN DOMESTIC WATER SYSTEMS, PROVIDE DRAIN VALVES AT MAIN SHUT-OFF VALVES AND ALL LOW POINTS IN PIPING.
- C. USE EXISTING CONNECTIONS AT MAINS WHERE AVAILABLE FOR NEW BRANCH PIPING. LOCATE ALL RISERS AND PIPING BEFORE CONSTRUCTION COMMENCES AND TAKE CARE NOT TO DAMAGE SAME. ANY DAMAGE OCCURRING TO THE EXISTING PIPING WILL BE THE SOLE RESPONSIBILITY OF THE CONTRACTOR.

#### 2.03 INSULATION (PIPE AND FITTINGS)

#### A. PIPING

COVER ALL HOT WATER PIPE WITH 1" THICK FOR PIPE SIZE UP TO 1½" AND 1½" THICK FOR PIPE SIZE 1½" AND GREATER WITH MANVILLE MICRO-LOK AP-T PLUS FIBERGLASS INSULATION. COVER ALL COLD WATER PIPE WITH ½" THICK FOR PIPE SIZE UP TO 1¼" AND 1" THICK FOR PIPE SIZE 1½" AND GREATER WITH 1" MANVILLE MICRO-LOK AP-T PLUS FIBERGLASS INSULATION. FITTINGS AND VALVES SHALL BE INSULATED. INSTALL ALL INSULATION AS PER MANUFACTURERS RECOMMENDATIONS. ALL INSULATION MATERIAL SHALL COMPLY WITH THE 2021 INTERNATIONAL BUILDING CODE, NEW JERSEY REQUIREMENT OF A FLAME SPREAD RATING NOT TO EXCEED 25 AND A SMOKE DEVELOPED RATING NOT TO EXCEED 50. ALL PIPE INSULATION SHALL COMPLY WITH ASHRAE 90.1 2019 ENERGY CONSERVATION CODE.

#### 3. TESTING

- A. AT THE COMPLETION OF THE PLUMBING WORK, COMPLETELY TEST THE ENTIRE INSTALLATION OF ALL SYSTEMS FOR PROPER OPERATION AND COMPLIANCE WITH APPLICABLE CODES AND LOCAL REQUIREMENTS. CORRECT ALL DEFICIENCIES FOUND.
- B. TESTING OF THE INSTALLED SYSTEMS SHALL BE MADE BY THE CONTRACTOR IN THE PRESENCE OF A REPRESENTATIVE OF THE OWNER.
- C. THE CONTRACTOR SHALL NOT COVER UP OR PERMANENTLY CONCEAL PIPING, DEVICES OR ANY PORTION OF NEWLY CONSTRUCTED PLUMBING SYSTEM(S) UNTIL SUCH SYSTEM, OR PORTION OF THE SYSTEM, HAS BEEN TESTED IN THE PRESENCE OF A REPRESENTATIVE OF THE OWNER AND INSPECTED BY THE LOCAL INSPECTOR AND APPROVED IN WRITING, EXCEPT PIPING PASSING THROUGH FLOORS, WALLS, PARTITIONS, OR BEAMS, FOR DISTANCES EQUAL TO THE THICKNESS OF SUCH FLOOR, WALL, PARTITION OR BEAM.
- D. THIS CONTRACTOR SHALL NOTIFY THE VARIOUS DEPARTMENTS, BUREAUS AND INDIVIDUALS AT LEAST TWO WEEKS IN ADVANCE OF THE TIME THAT THE TESTS ARE TO BE CONDUCTED.
- E. ALL DEFECTIVE PARTS SHALL BE REPLACED OR CORRECTED BY THIS CONTRACTOR AND AN EXTRA TEST OR TESTS SHALL BE MADE UNTIL THE OPERATION IS SATISFACTORY. ALL ARRANGEMENTS AND EXPENSES NECESSARY TO CONDUCT ALL TESTS REQUIRED BY THESE SPECIFICATIONS AND THE VARIOUS AGENCIES HAVING JURISDICTION OVER THE WORK INSTALLED UNDER THIS CONTRACT SHALL BE MADE BY THIS CONTRACTOR. NO EXTRA COMPENSATION WILL BE ALLOWED FOR THESE TESTS, THE COST THEREOF BEING INCLUDED IN THE LUMP SUM BID FOR THIS CONTRACT.
- F. WHERE ANY EVIDENCE OF STOPPAGE IS FOUND IN PIPING OR EQUIPMENT, THIS CONTRACTOR SHALL DISCONNECT, CLEAN, REPAIR AND RECONNECT ALL OBSTRUCTED PIPING OR EQUIPMENT AND SHALL ALSO PAY FOR ALL NECESSARY CUTTING AND REPAIRS TO ADJOINING WORK.
- / \//ADDANTV
- G. ALL PIPING AND EQUIPMENT SHALL BE THOROUGHLY CLEANED INSIDE AND OUT, OF DIRT, CUTTINGS, OILS AND OTHER FOREIGN SUBSTANCES AND SHALL BE LEFT CLEAN.
- L. TESTING REQUIREMENTS

TO FINAL ACCEPTANCE.

- H. ALL REQUIRED TESTS SHALL BE WITNESSED BY LOCAL AUTHORITIES AND THE
- OWNER'S REPRESENTATIVE.

  I. ALL EQUIPMENT WILL BE FACTORY TESTED.
- J. CONTRACTOR SHALL IDENTIFY TO THE OWNER'S REPRESENTATIVE ANY LEAKS OR DAMAGE THAT OCCURS AS A RESULT OF SYSTEM TESTING. CONTRACTOR SHALL TAKE NECESSARY PRECAUTIONS TO LIMIT ANY POTENTIAL DAMAGE. CORRECTIVE ACTION REQUIRED AS A RESULT OF TESTING SHALL BE PERFORMED IMMEDIATELY AND AT THE CONTRACTOR'S EXPENSE.
- K. REPORT IN WRITING TO AUTHORITIES HAVING JURISDICTION, THE ARCHITECT
- AND THE OWNER THE RESULTS OF ALL TESTING.
- a. TEST ALL DOMESTIC WATER PIPING HYDROSTATICALLY TO 125 PSIG.b. HYDROSTATIC TEST PRESSURES SHALL REMAIN CONSTANT WITH NO
- c. TESTS SHALL BE WITNESSED BY THE BUILDING ENGINEER.
   d. THE PLUMBING CONTRACTOR WILL BE HELD RESPONSIBLE FOR ALL DAMAGE DUE TO TEST FAILURES AND LEAKAGE IN THE TEST AREA AND ADJACENT TENANT OR ESB SPACES.
- M. REFILL ENTIRE POTABLE HOT AND COLD WATER SUPPLY SYSTEM WITH CHLORINE SOLUTION (HTH OLIN CHEMICAL CORP.) AT A STRENGTH TO MEET STANDARDS OF THE DEPARTMENT OF HEALTH, AND FOR A PERIOD OF
- RETENTION AS STIPULATED.

  N. THOROUGHLY FLUSH PIPING SYSTEM WITH FRESH WATER IMMEDIATELY PRIOR
- O. INSPECTION & TESTING SHALL BE AS PER INTERNATIONAL BUILDING CODE 2021, NEW JERSEY, NATIONAL PLUMBING CODE 2021 (NSPC) FOR NEW

PERIOD SHALL ALSO BE PROMPTLY REPAIRED.

A. EQUIPMENT, MATERIALS AND WORKMANSHIP FURNISHED UNDER THIS CONTRACT SHALL BE GUARANTEED BY THE CONTRACTOR FOR A PERIOD OF ONE YEAR FROM THE DATE OF FINAL ACCEPTANCE OF THE WORK BY THE OWNER. THE CONTRACTOR SHALL KEEP THE WORK IN GOOD REPAIR FOR ONE YEAR AFTER THE DATE OF FINAL APPROVAL. THE CONTRACTOR SHALL, AT HIS OWN EXPENSE, PROMPTLY CORRECT AND REPAIR ANY AND ALL BREAKS, FAILURES OR WEAR DUE TO FAULTY MATERIALS, WORKMANSHIP OR EQUIPMENT. ALL SETTLEMENTS OF SURFACES THAT MAY OCCUR WITHIN THAT

CONSULTANTS (ENGINEER):

## NY ENGINEERS

NEARBY ENGINEERS
382 NE 191ST STREET SUITE 49674,
MIAMI, FL 33179
PH-914.257.3455

WWW.NY-ENGINEERS.COM

CONTRACTOR'S NOTES:

WRITTEN DIMENSIONS HOLD PREFERENCE OVER SCALED DIMENSIONS. DO NOT SCALE THE DRAWINGS. THE CONTRACTORS MUST VISIT JOB SITE TO VERIFY ALL EXISTING CONDITIONS AND DIMENSIONS BEFORE SUBMITTING BIDS. REPORT ANY DISCREPANCIES OF ANY CONDITIONS WHICH MAY INTERFERE WITH THE PROPER EXECUTION OF, THE CONTRACT TO THE TENANT'S REPRESENTATIVE. REPORT DISCREPANCIES DURING BIDDING PROCESS AND BEFORE START OF CONSTRUCTION. CHANGE ORDERS NEED TO BE APPROVED BY TOWNSQUARE CONSTRUCTION MANAGER FOR ISSUES ARISING FROM THE FIELD CONDITIONS OR CONFLICTS BETWEEN THE PLANS AND THE EXISTING CONDITIONS PRIOR TO THE

COMMENCEMENT OF WORK.

10.31.24 LL/CLIENT REVIEW SET
11.15.24 LL/CLIENT REVIEW SET
11.22.24 BD SUBMISSION


11.15.24 CLIENT COMMENTS

DATE REVISION



PLUMBING SPECIFICATIONS

SHEET NUMBER:

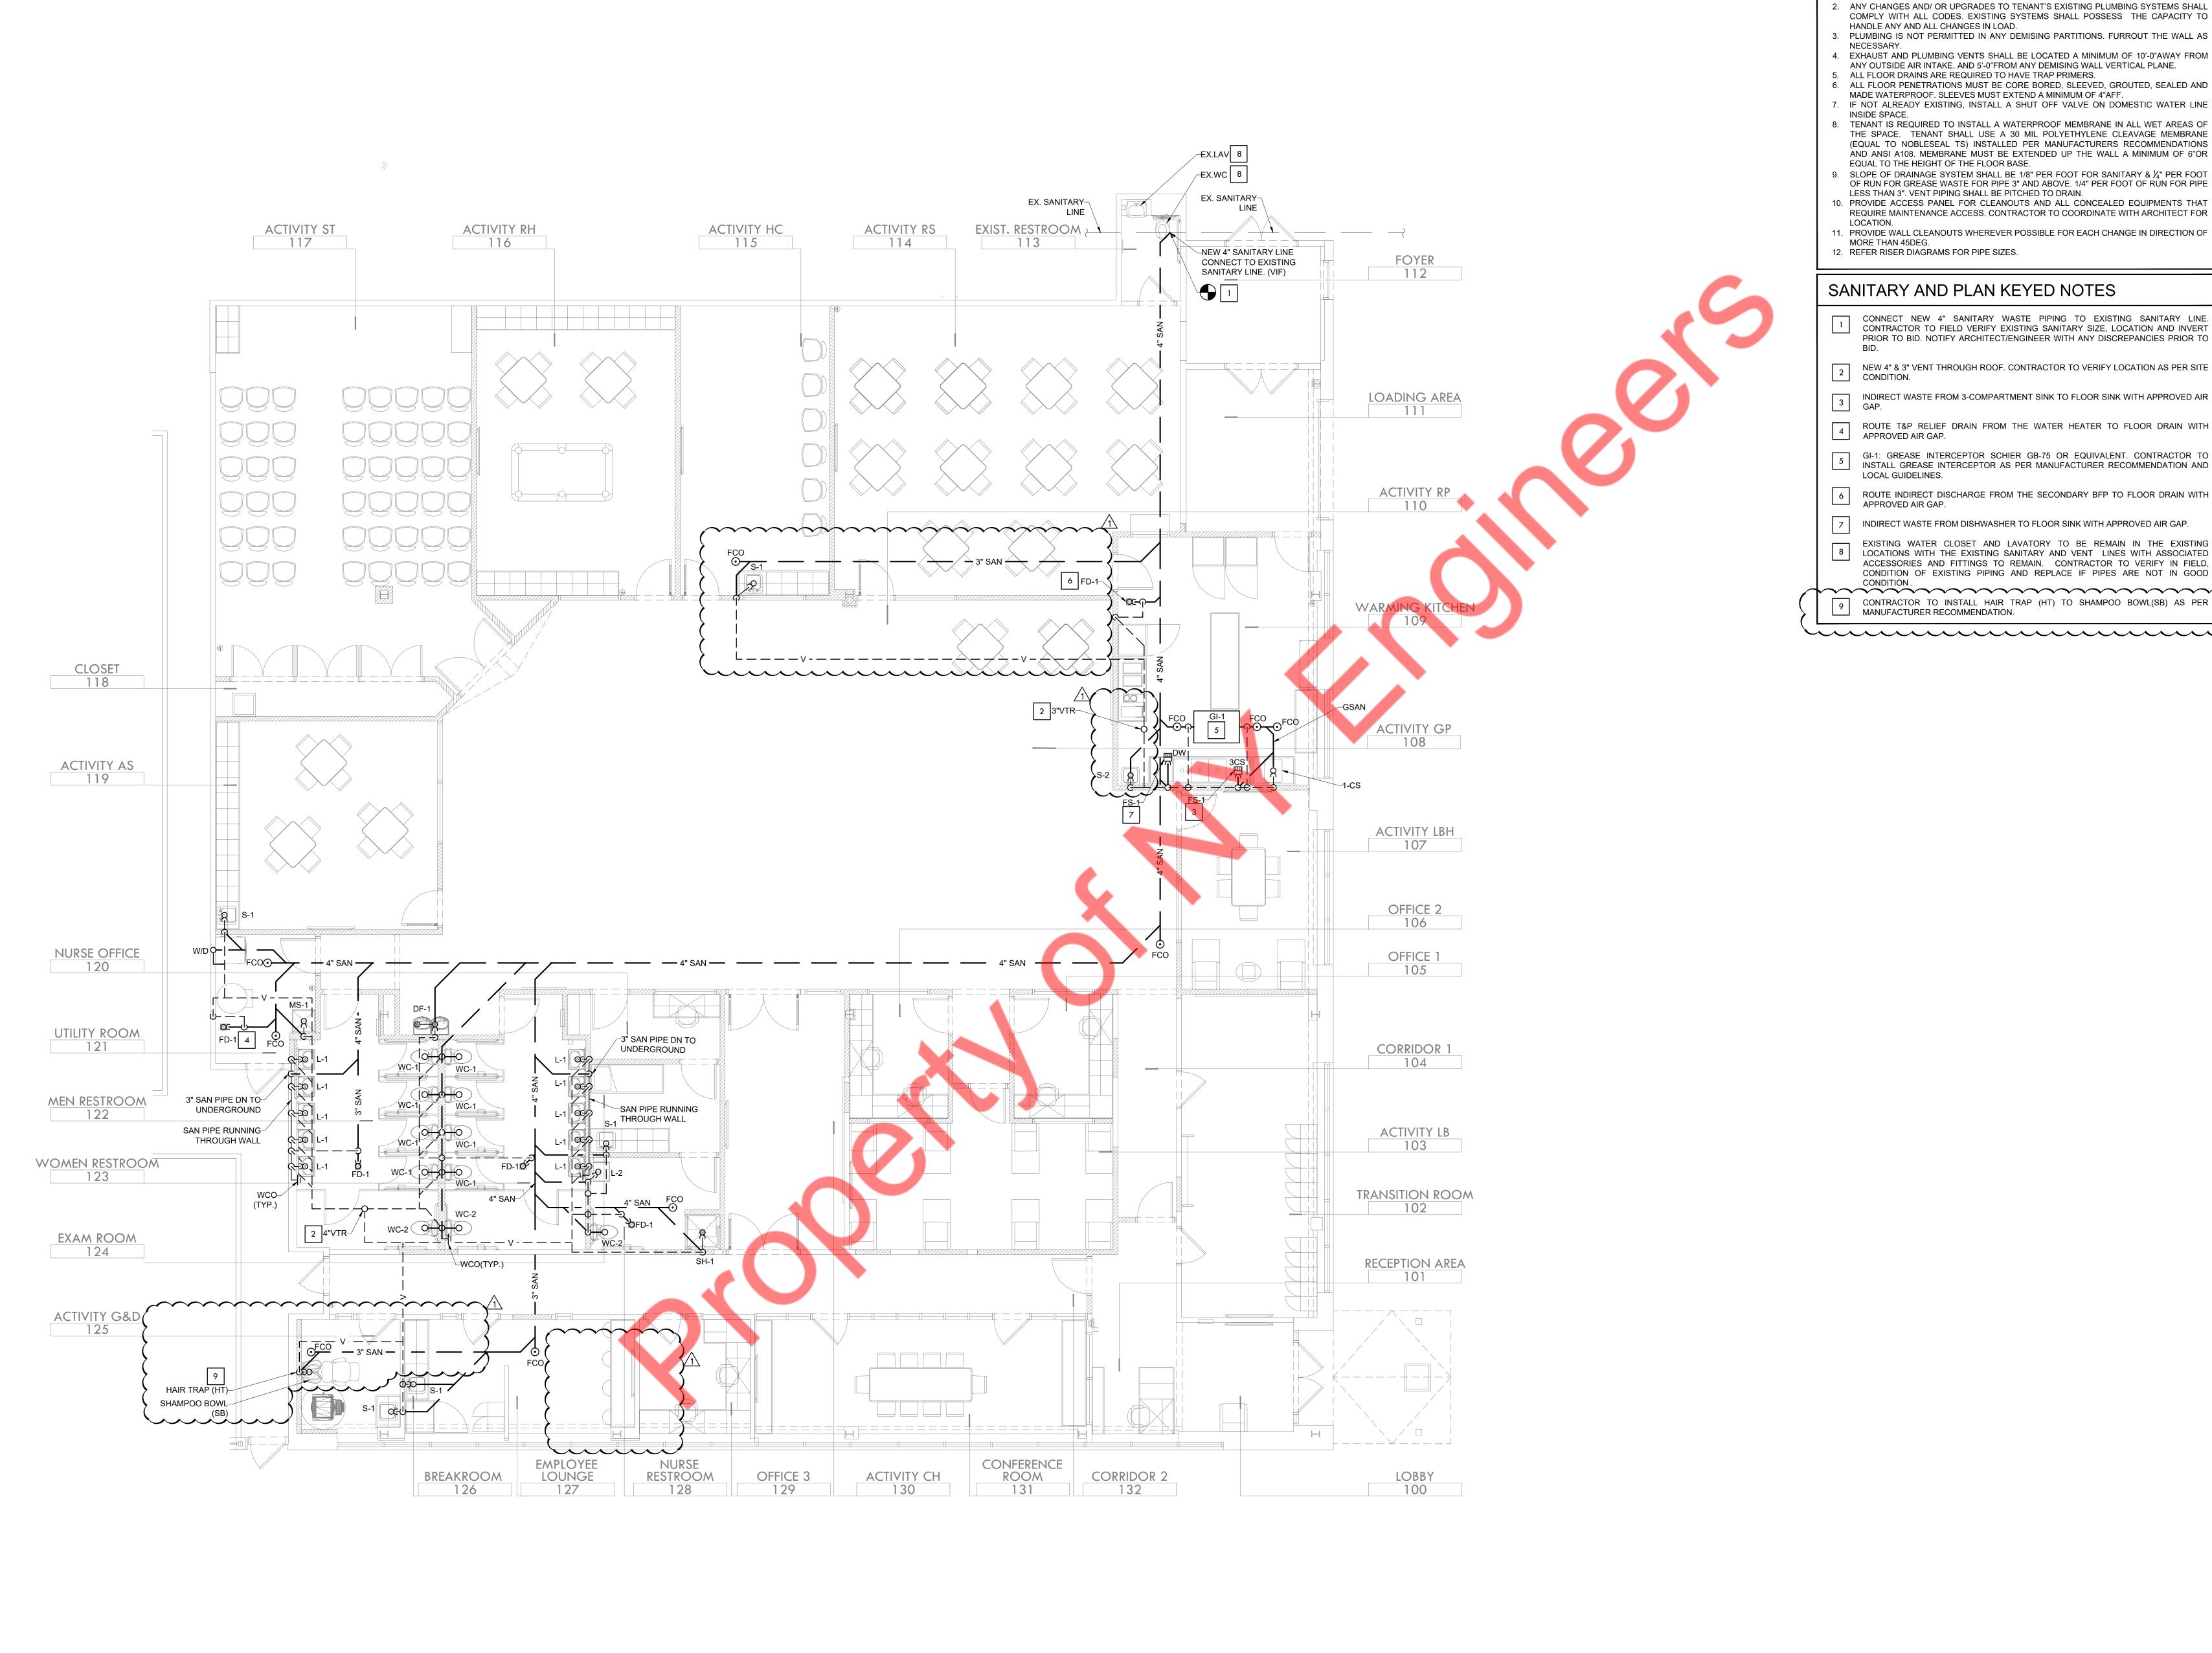

- 1. ALL PIPING SHALL BE SNAKE CLEAN PRIOR TO CONNECTION. 2. ANY CHANGES AND/ OR UPGRADES TO TENANT'S EXISTING PLUMBING SYSTEMS SHALL COMPLY WITH ALL CODES. EXISTING SYSTEMS SHALL POSSESS THE CAPACITY TO
- 3. PLUMBING IS NOT PERMITTED IN ANY DEMISING PARTITIONS. FURROUT THE WALL AS
- 4. EXHAUST AND PLUMBING VENTS SHALL BE LOCATED A MINIMUM OF 10'-0"AWAY FROM ANY OUTSIDE AIR INTAKE, AND 5'-0"FROM ANY DEMISING WALL VERTICAL PLANE.
- 5. ALL FLOOR DRAINS ARE REQUIRED TO HAVE TRAP PRIMERS. 6. ALL FLOOR PENETRATIONS MUST BE CORE BORED, SLEEVED, GROUTED, SEALED AND MADE WATERPROOF. SLEEVES MUST EXTEND A MINIMUM OF 4"AFF. 7. IF NOT ALREADY EXISTING, INSTALL A SHUT OFF VALVE ON DOMESTIC WATER LINE
- 8. TENANT IS REQUIRED TO INSTALL A WATERPROOF MEMBRANE IN ALL WET AREAS OF THE SPACE. TENANT SHALL USE A 30 MIL POLYETHYLENE CLEAVAGE MEMBRANE (EQUAL TO NOBLESEAL TS) INSTALLED PER MANUFACTURERS RECOMMENDATIONS
- EQUAL TO THE HEIGHT OF THE FLOOR BASE. 9. SLOPE OF DRAINAGE SYSTEM SHALL BE 1/8" PER FOOT FOR SANITARY & 1/4" PER FOOT OF RUN FOR GREASE WASTE FOR PIPE 3" AND ABOVE. 1/4" PER FOOT OF RUN FOR PIPE
- LESS THAN 3". VENT PIPING SHALL BE PITCHED TO DRAIN. 10. PROVIDE ACCESS PANEL FOR CLEANOUTS AND ALL CONCEALED EQUIPMENTS THAT REQUIRE MAINTENANCE ACCESS. CONTRACTOR TO COORDINATE WITH ARCHITECT FOR
- 11. PROVIDE WALL CLEANOUTS WHEREVER POSSIBLE FOR EACH CHANGE IN DIRECTION OF
- 12. REFER RISER DIAGRAMS FOR PIPE SIZES.

## SANITARY AND PLAN KEYED NOTES

- CONNECT NEW 4" SANITARY WASTE PIPING TO EXISTING SANITARY LINE. CONTRACTOR TO FIELD VERIFY EXISTING SANITARY SIZE, LOCATION AND INVERT PRIOR TO BID. NOTIFY ARCHITECT/ENGINEER WITH ANY DISCREPANCIES PRIOR TO
- NEW 4" & 3" VENT THROUGH ROOF. CONTRACTOR TO VERIFY LOCATION AS PER SITE CONDITION.
- INDIRECT WASTE FROM 3-COMPARTMENT SINK TO FLOOR SINK WITH APPROVED AIR
- ROUTE T&P RELIEF DRAIN FROM THE WATER HEATER TO FLOOR DRAIN WITH 4 APPROVED AIR GAP.
- GI-1: GREASE INTERCEPTOR SCHIER GB-75 OR EQUIVALENT. CONTRACTOR TO INSTALL GREASE INTERCEPTOR AS PER MANUFACTURER RECOMMENDATION AND LOCAL GUIDELINES.
- 6 ROUTE INDIRECT DISCHARGE FROM THE SECONDARY BFP TO FLOOR DRAIN WITH APPROVED AIR GAP.
- INDIRECT WASTE FROM DISHWASHER TO FLOOR SINK WITH APPROVED AIR GAP.
- 8 LOCATIONS WITH THE EXISTING SANITARY AND VENT LINES WITH ASSOCIATED ACCESSORIES AND FITTINGS TO REMAIN. CONTRACTOR TO VERIFY IN FIELD, CONDITION OF EXISTING PIPING AND REPLACE IF PIPES ARE NOT IN GOOD
- CONTRACTOR TO INSTALL HAIR TRAP (HT) TO SHAMPOO BOWL(SB) AS PER

CONSULTANTS (ENGINEER):

**NEARBY ENGINEERS** 382 NE 191ST STREET SUITE 49674, MIAMI, FL 33179

PH-914.257.3455

WWW.NY-ENGINEERS.COM

CONTRACTOR'S NOTES: WRITTEN DIMENSIONS HOLD PREFERENCE OVER SCALED DIMENSIONS, DO NOT SCALE THE DRAWINGS. THE CONTRACTORS MUST VISIT JOB SITE TO VERIFY ALL EXISTING CONDITIONS AND DIMENSIONS BEFORE SUBMITTING BIDS. REPORT ANY DISCREPANCIES OF ANY CONDITIONS WHICH MAY INTERFERE WITH THE PROPER EXECUTION OF, THE CONTRACT TO THE TENANT'S REPRESENTATIVE. REPORT DISCREPANCIES DURING BIDDING PROCESS AND BEFORE START OF CONSTRUCTION. CHANGE ORDERS NEED TO BE APPROVED BY TOWNSQUARE CONSTRUCTION

MANAGER FOR ISSUES ARISING FROM THE FIELD CONDITIONS OR CONFLICTS BETWEEN THE PLANS AND

THE EXISTING CONDITIONS PRIOR TO THE

COMMENCEMENT OF WORK.

10.31.24 LL/CLIENT REVIEW SET 11.15.24 LL/CLIENT REVIEW SET 11.22.24 BD SUBMISSION

DATE REVISION


11.15.24 CLIENT COMMENTS

PLUMBING SANITARY AND VENT PLAN

SHEET NUMBER:

P100

3 / 16" = 1' - 0"

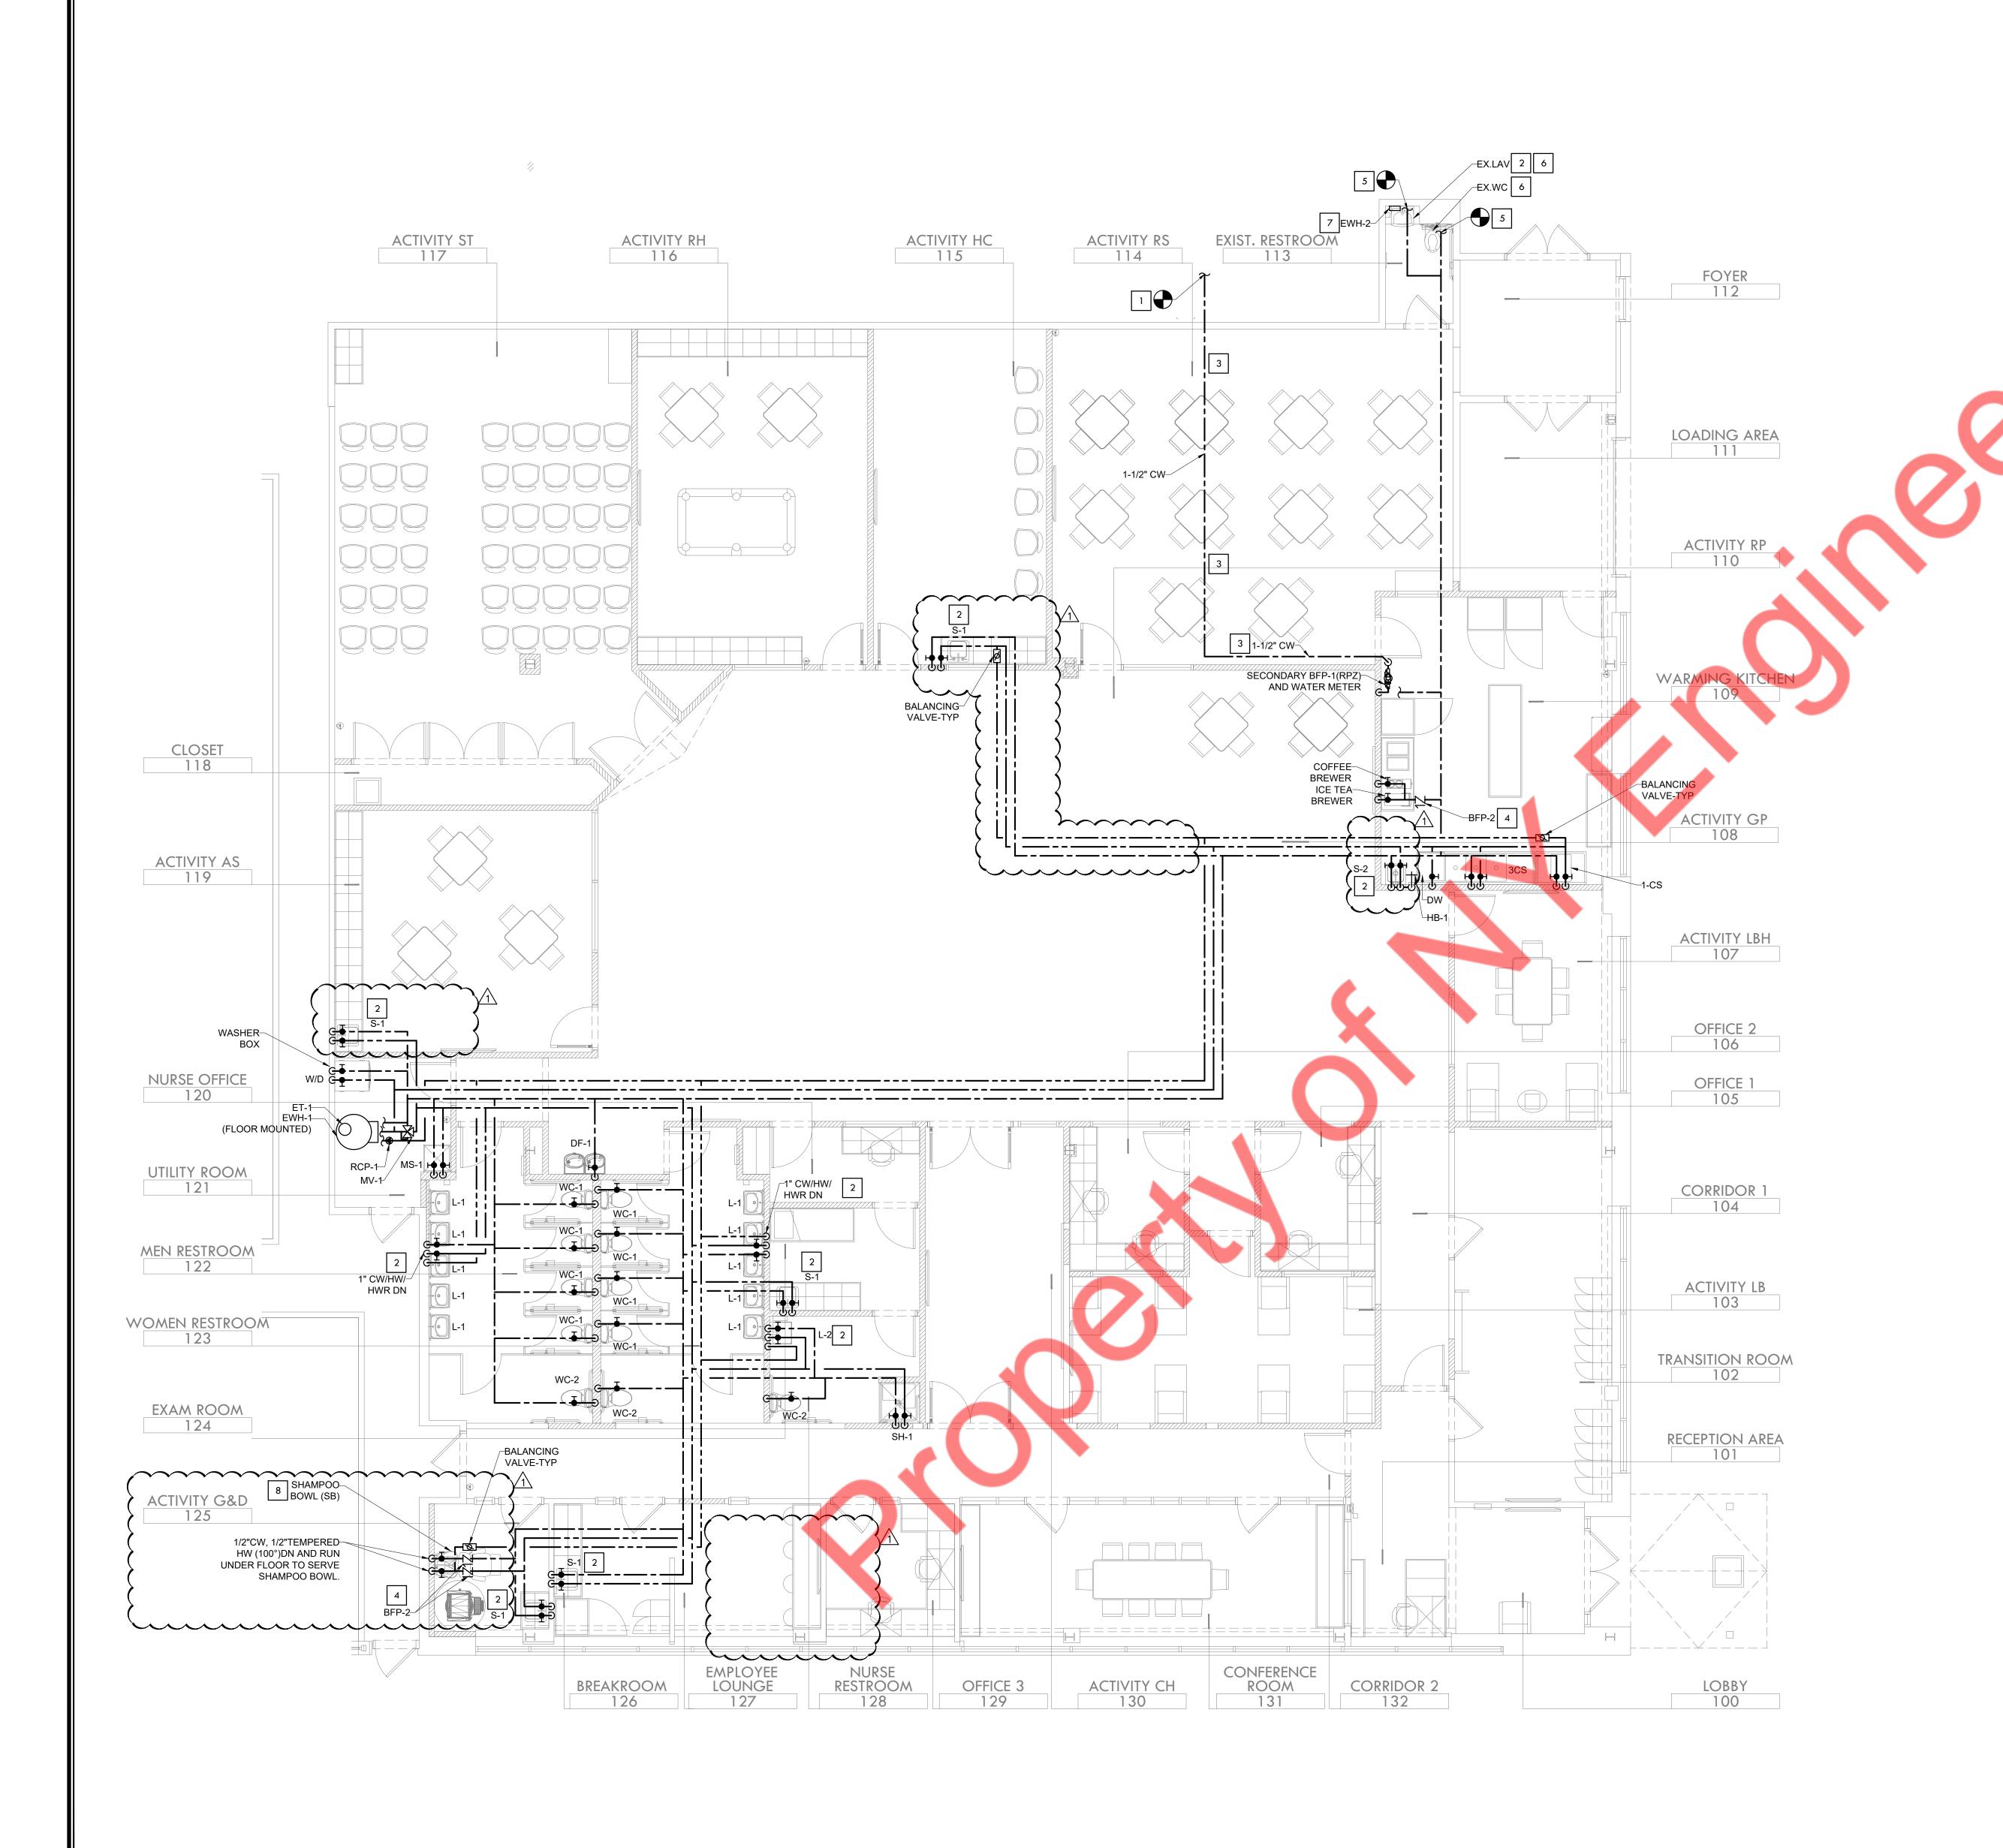

REQUIRED.

- ANY WORK SHOWN ON THE DRAWINGS AND NOT PARTICULARLY DESCRIBED IN THE SPECIFICATIONS OR DETAILS, OR ANY WORK WHICH MAY BE DEEMED NECESSARY TO COMPLETE THE CONTRACT SHALL BE PROVIDED BY THE CONTRACTOR AS PART OF THIS CONTRACT.
- 2. CW/ HW PIPING TO BE PROVIDED WITH INSULATION AS PER ENERGY CODE ASHRAE 90.1 (2021), TABLE 7.4.3.
- (2021), TABLE 7.4.3.

  3. CONTRACTOR TO FIELD VERIFY FEASIBILITY OF FLOOR SLAB PENETRATION AS PER
- STRUCTURAL REQUIREMENT.
  4. REFER RISER DIAGRAMS FOR ALL PIPE SIZES.
- 5. PROVIDE ACCESS PANELS FOR WATER HAMMER ARRESTOR, CLEANOUTS & SHUT-OFF VALVES AS REQUIRED.6. FOR SINK PROVIDE HOT WATER AT 110°F. PROVIDE POINT OF USE MIXING VALVE IF
- PROVIDE BRANCH PRV IF PRESSURE INCREASES 80 PSI.
   PROVIDE HOT WATER RETURN AS PER MAXIMUM PIPE LENGTH TABLE FROM ENERGY CODE ASHRAE 90.1 (2021).

## WATER SUPPLY KEYED NOTES

- EXTEND AND CONNECT NEW 1-1/2" CW LINE TO EXISTING CW LINE WITH EXISTING WATER METER AND BFP. CONTRACTOR SHALL VERIFY EXACT LOCATION AND SIZE. UPDATE EXISTING WATER SERVICE LINE IF NOT SUFFICIENT. BASE BID ACCORDINGLY.
- PROVIDE APPROVED ASSE 1070 TEMPERING VALVE FOR HAND SINK AND LAVATORIES.
- SET TEMPERATURE MAXIMUM AT 110°F.
- NO TAP OFF TO BE TAKEN BEFORE BFP.

TEMPERATURE MAXIMUM AT 100°F.

- PROVIDE APPROVED ASSE 1022 WATTS SD-3 OR EQUIVALENT BACKFLOW PREVENTER FOR ICE TEA, COFFEE BREWER AND SHAMPOO BOWL.
- EXTEND AND CONNECT NEW CW LINE TO THE EXISTING WATER SUPPLY LINE.

  CONTRACTOR TO FIELD VERIFY THE SIZE, LOCATION AND CONDITION OF EXISTING PIPING AND UPGRADE/REPLACE IF REQUIRED.
- EXISTING WATER CLOSET AND LAVATORY TO REMAIN WITH EXISTING CW/HW PIPING CONNECTIONS, ASSOCIATED ACCESSORIES AND FITTINGS. CONTRACTOR TO FIELD VERIFY THE CONDITION OF EXISTING PIPING AND UPGRADE/REPLACE IF REQUIRED. CW LINE EXTEND AND CONNECT TO THE NEAREST WATER SUPPLY LINE.
- 7 NEW INSTANTANEOUS WATER HEATER (EWH-1) WITH ASSOCIATED ACCESSORIES AND FITTINGS. CONTRACTOR TO EXTEND AND CONNECT WATER SUPPLY CONNECTION TO
- NEAREST WATER SUPPLY LINE.

  PROVIDE APPROVED ASSE 1070 TEMPERING VALVE FOR SHAMPOO BOWL (SB). SET

CONSULTANTS (ENGINEER):

NY ENGINEERS

NEARBY ENGINEERS

382 NE 191ST STREET SUITE 49674, MIAMI, FL 33179 PH-914.257.3455 WWW.NY-ENGINEERS.COM

CONTRACTOR'S NOTES:

WRITTEN DIMENSIONS HOLD PREFERENCE OVER SCALED DIMENSIONS. DO NOT SCALE THE DRAWINGS. THE CONTRACTORS MUST VISIT JOB SITE TO VERIFY ALL EXISTING CONDITIONS AND DIMENSIONS BEFORE SUBMITTING BIDS. REPORT ANY DISCREPANCIES OF ANY CONDITIONS WHICH MAY INTERFERE WITH THE PROPER EXECUTION OF, THE CONTRACT TO THE TENANT'S REPRESENTATIVE. REPORT DISCREPANCIES DURING BIDDING PROCESS AND BEFORE START OF CONSTRUCTION. CHANGE ORDERS NEED TO BE APPROVED BY TOWNSQUARE CONSTRUCTION MANAGER FOR ISSUES ARISING FROM THE FIELD

CONDITIONS OR CONFLICTS BETWEEN THE PLANS AND

THE EXISTING CONDITIONS PRIOR TO THE

COMMENCEMENT OF WORK.

DATE ISSUE
10.31.24 LL/CLIENT REVIEW SET
11.15.24 LL/CLIENT REVIEW SET
11.22.24 BD SUBMISSION

11.15.24 CLIENT COMMENTS


DATE REVISION



TITLE:

PLUMBING WATER SUPPLY PLAN

SHEET NUMBER:

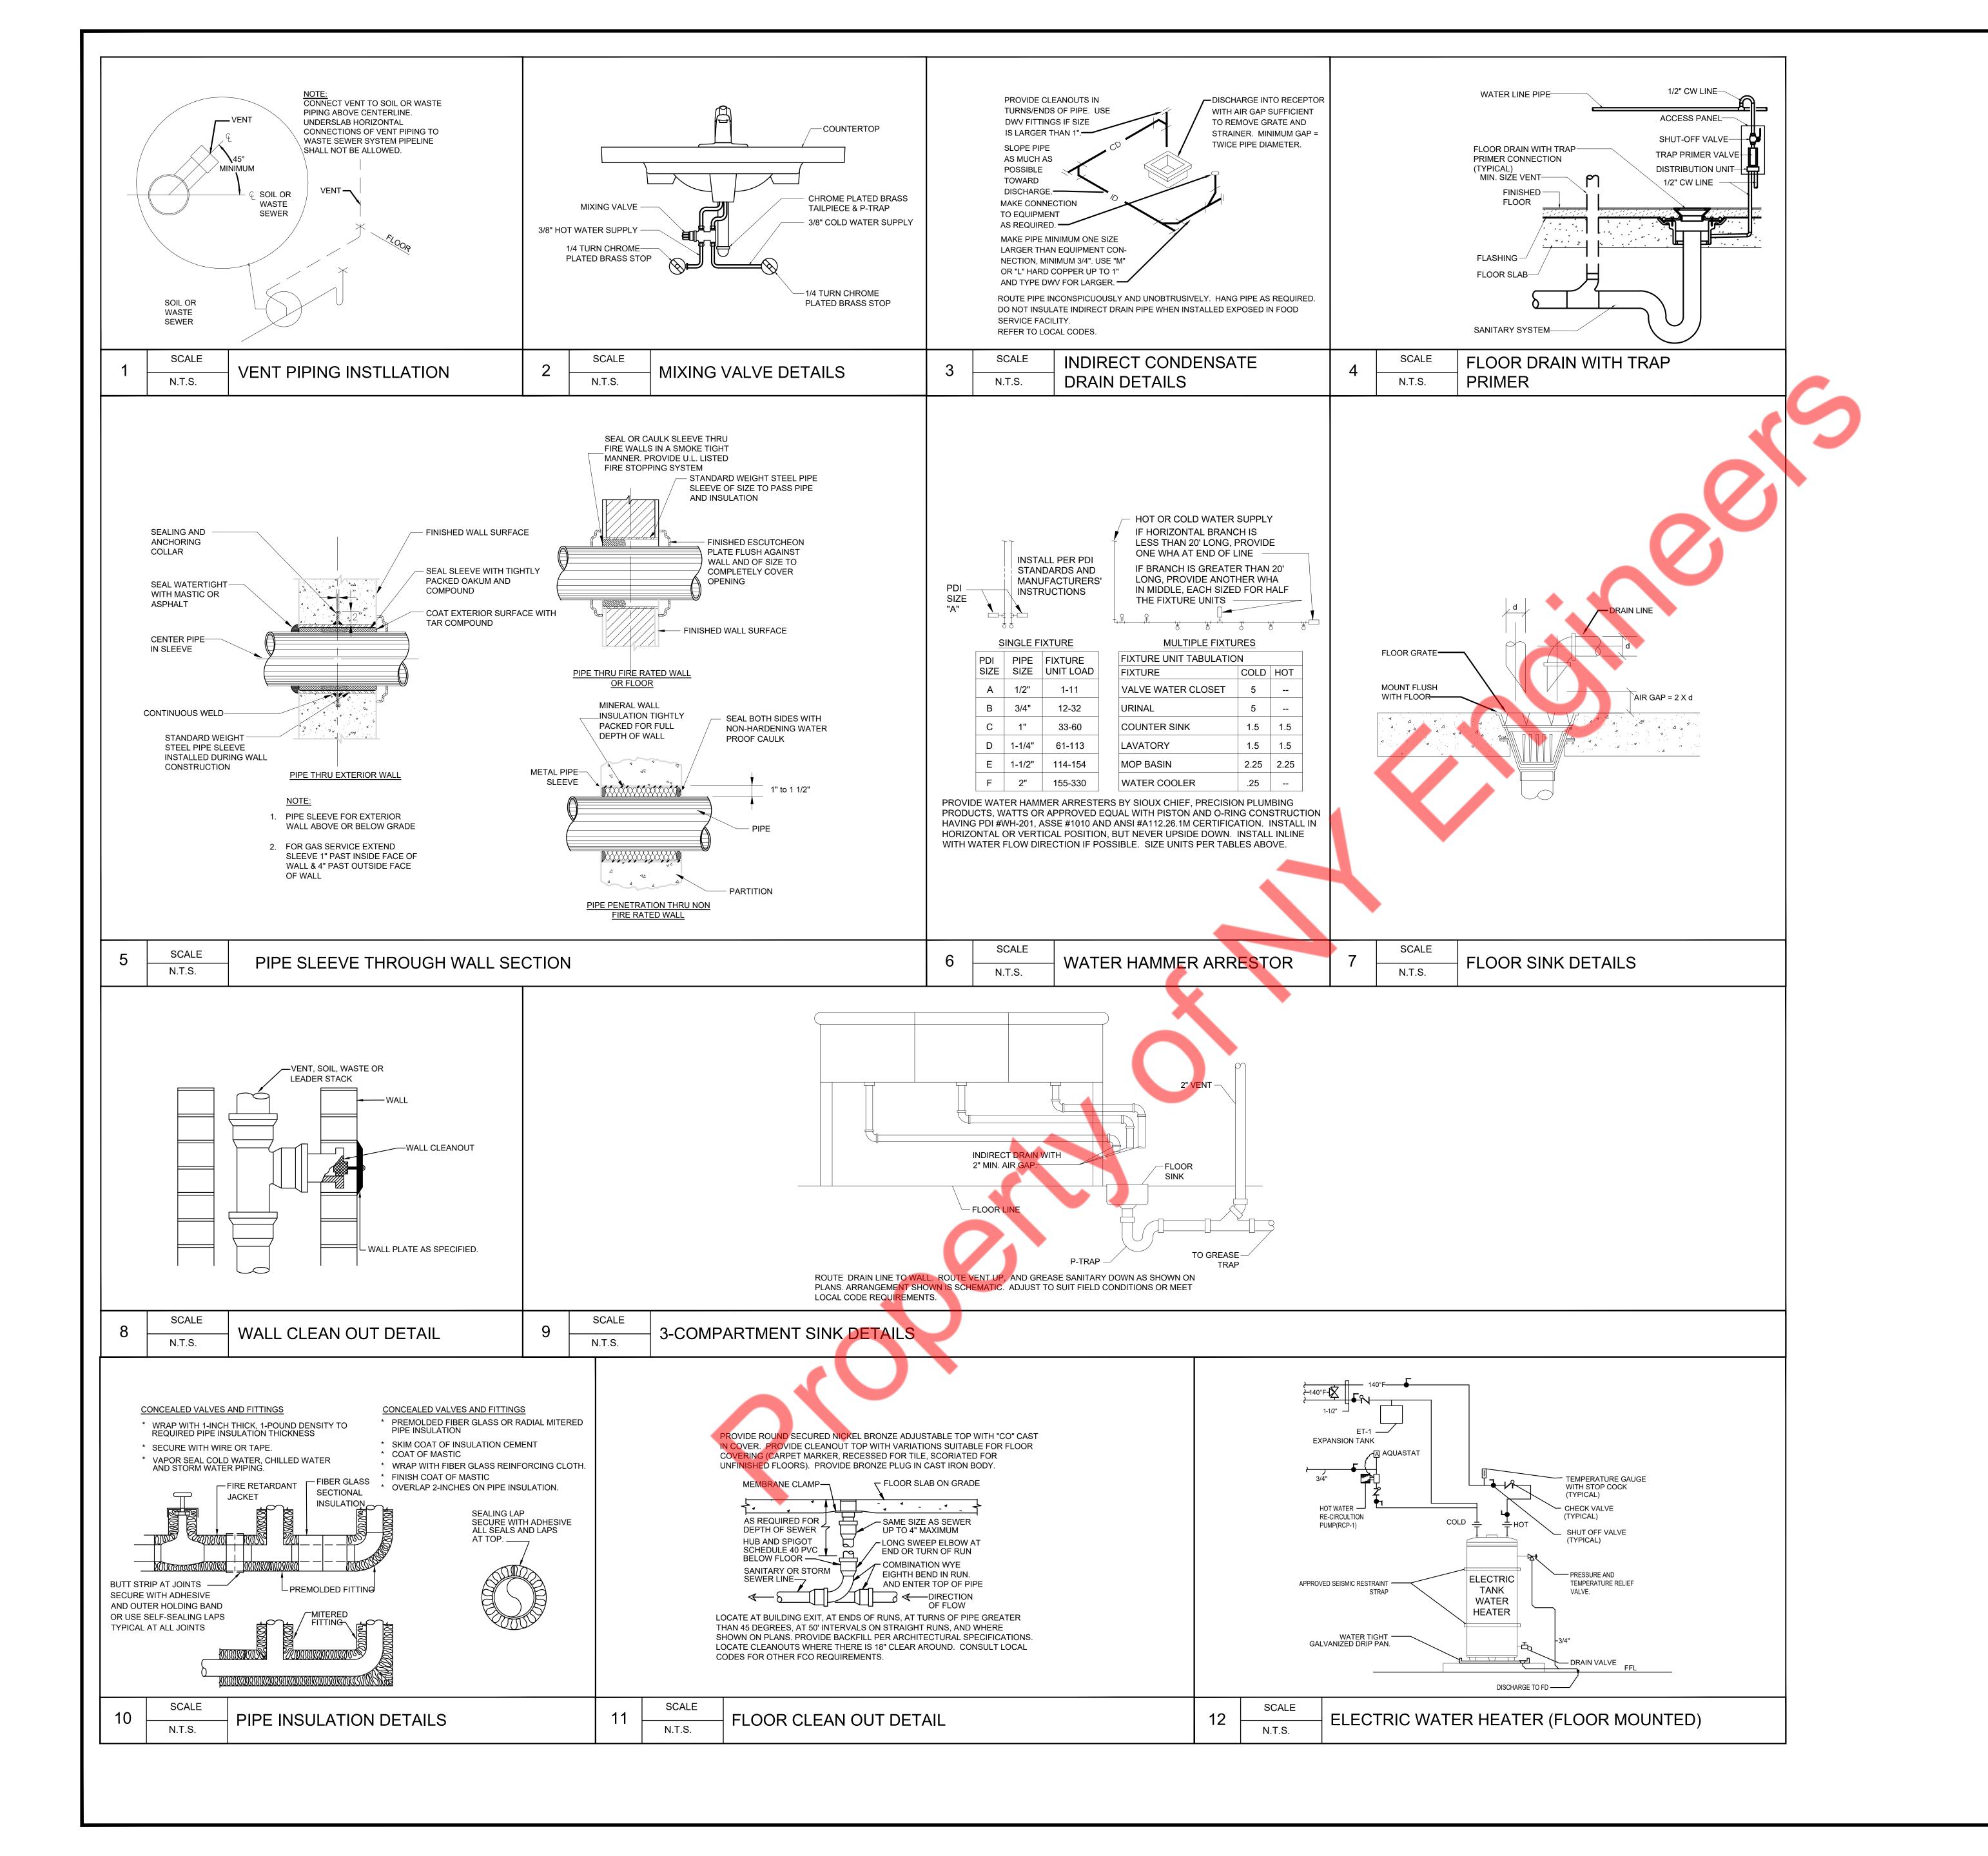

CONSULTANTS (ENGINEER):

NY ENGINEERS

NEARBY ENGINEERS
382 NE 191ST STREET SUITE 49674,
MIAMI, FL 33179
PH-914.257.3455

WWW.NY-ENGINEERS.COM

CONTRACTOR'S NOTES:

WRITTEN DIMENSIONS HOLD PREFERENCE OVER SCALED DIMENSIONS. DO NOT SCALE THE DRAWINGS. THE CONTRACTORS MUST VISIT JOB SITE TO VERIFY ALL EXISTING CONDITIONS AND DIMENSIONS BEFORE SUBMITTING BIDS. REPORT ANY DISCREPANCIES OF ANY CONDITIONS WHICH MAY INTERFERE WITH THE PROPER EXECUTION OF, THE CONTRACT TO THE TENANT'S REPRESENTATIVE. REPORT DISCREPANCIES DURING BIDDING PROCESS AND BEFORE START OF CONSTRUCTION. CHANGE ORDERS NEED TO BE APPROVED BY TOWNSQUARE CONSTRUCTION MANAGER FOR ISSUES ARISING FROM THE FIELD CONDITIONS OR CONFLICTS BETWEEN THE PLANS AND THE EXISTING CONDITIONS PRIOR TO THE

DATE ISSUE

10.31.24 LL/CLIENT REVIEW SET

11.15.24 LL/CLIENT REVIEW SET

COMMENCEMENT OF WORK.

11.15.24 LL/CLIENT REVIEW S
11.22.24 BD SUBMISSION

DATE REVISION

11.15.24 CLIENT COMMENTS



TI F:

PLUMBING DETAILS

SHEET NUMBER:

	EQUIPMENT SCHEDULE					
TAG	NAME	LOCATION	DESCRIPTION			
EWH-1	WATER HEATER (FLOOR MOUNTED)	UTILITY ROOM (121)	RHEEM ES120-24G, 24KW/208/60HZ, RECOVERY RATE 110 GPH @90°F, TYPE-STORAGE ELECTRIC, DIMENSION 30-1/4" X 58-3/4"			
EWH-2	INSTANTANEOUS WATER HEATER	EXISTING RESTROOM (113)	EEMAX SPEX 2412 , 2.4KW/120/60HZ, RECOVERY RATE 0.3 GPH @90°F, INSTANTANEOUS TYPE-ELECTRIC, DIMENSION 5-1/4" X 10-3/4"			
RCP-1	RECIRCULATING PUMP	UTILITY ROOM (121)	GRUNDFOS UPS 15-42 FC, 2GPM, HEAD 10 FEET, 87W,115V /1PH /60HZ			
ET-1	EXPANSION TANK	UTILITY ROOM (121)	AMTROL THERM-X-TROL ST-8, CAPACITY 3.2 GALLON, DIMENSION 9"D X 15"H			
GI-1	GREASE INTERCEPTOR	WARMING KITCHEN (109) (UNDERGROUND)	SCHIER GB-75, GREASE CAPACITY 861 @75GPM, LIQUID 125 GALLONS. PROVIDE FCR2 FILED CUT RISER IF REQUIRED.			

	KITCHEN EQUIPMENT SCHEDULE								
					SUPPL	_Y	W	/ASTE	
SR.	NO.	QTY.	DESCRIPTION	CW SIZE	HW (140°	) HW (110°) SIZE	DIRECT WASTE SIZE	INDIRECT WASTE SIZI	PLUMBING REMARKS
	1	1	TEA BREWER	3/8"					CONNECT FILTERED C.W. SUPPLY LINE TO UNIT. PROVIDE BFP-2 AND SOV UPSTREAM OF FILTER. FILTER BY OWNER. SPILL DRAINS INDIRECTLY INTO FLOOR DRAIN.
	2	1	COFFEE BREWER	3/8"					CONNECT FILTERED C.W. SUPPLY LINE TO UNIT. PROVIDE BFP-2 AND SOV UPSTREAM OF FILTER. FILTER BY OWNER. SPILL DRAINS INDIRECTLY INTO FLOOR DRAIN.
	3	1	HAND SINK, WALL MOUNT	1/2"		1/2"	1-1/2"		CONNECT C.W. AND H.W. SUPPLY LINES AND CONNECT TO FAUCET. P.C. TO CONNECT DIRECT DRAIN.
	4	1	3-COMPARTMENT SINK	3/4"	3/4"			2"	CONNECT C.W. AND H.W. SUPPLY LINES AND CONNECT TO FAUCET. SPILL 2" DRAIN FROM EACH BOWL INDIRECTLY INTO FLOOR SINK. DO NOT MANIFOLD, SPILL EACH DRAIN SEPARATELY
	5	1	UNDERCOUNTER DISHWASHER	-	3/4"			3/4"	CONNECT H.W. SUPPLY TO UNIT. PROVIDE PRESSURE REGULATOR, SHOCK ARRESTOR AND SOV. INSTALL DRAIN TEMPERING KIT (OWNER PROVIDED KIT) SPILL TEMPERED DRAIN INDIRECTLY INTO FLOOR SINK. (MODEL EURODIB USA F99 EKDPS)
	6	1	1 -COMPARTMENT SINK	1/2"		1/2"	2"	3/4"	CONNECT C.W. AND H.W. SUPPLY LINES AND CONNECT TO FAUCET. P.C. TO CONNECT DIRECT DRAIN.

WATER PIPE SIZING AS PER NATIONAL STANDARD PLUMBING CODE 2021 (NSPC) FOR NEW JERSEY.

THE LISTED FIXTURE UNIT VALUES REPRESENT THEIR TOTAL LOAD ON THE COLD WATER BUILDING SUPPLY.
 THE SEPARATE COLD WATER AND HOT WATER FIXTURE UNIT VALUE FOR FIXTURES HAVING BOTH COLD AND HOT WATER CONNECTION SHALL BE PERMITTED TO THREE QUARTER OF THE TOTAL VALUE OF THE FIXTURE.

SIZE OF THE COLD BRANCH PIPE OR BOTH THE HOT AND COLD BRANCH PIPE.

INSTALL RECIRCULATION PUMP AND WATER HEATER AS PER MANUFACTURER RECOMMENDATION.

AQUA-STAT & NIGHT TIMER.

BALANCING VALVE & CHECK VALVE.

MAINTENANCE BALL VALVE ON BOTH SIDE OF PUMP.

SET AQUA -STAT WITH SET 10 DEGREE BELOW SYSTEM SUPPLY TEMP.

#### NOTES

- PROVIDE REQUIRED AIR GAP FOR INDIRECT DRAINS SPILLING INTO FLOOR DRAIN RECEPTACLES.
   ALL EQUIPMENT BRAND NAMES, SPECIFIC HARDWARE AND CONNECTION DETAILS SHALL BE VERIFIED WITH THE EQUIPMENT DEALER AND OWNER PRIOR TO BIDDING,
- PURCHASE OR INSTALLATION. GENERAL CONTRACTOR SHALL FIELD VERIFY ALL DIMENSIONS PRIOR TO EQUIPMENT ROUGH-IN.

  3. CONTRACTOR SHALL PROVIDE AND INSTALL TRAPS, SUPPLIES AND ALL REQUIRED FITTINGS, VALVES AND SPECIALTY EQUIPMENT NEEDED FOR COMPLETE AND
- OPERATIONAL INSTALLATION. FINAL CONNECTIONS TO EQUIPMENT BY PLUMBING CONTRACTOR

  4. ALL REQUIRED BACKFLOW PREVENTER DEVICES SHALL BE INSTALLED UPSTREAM OF ANY FILTRATION UNITS. FILTRATION UNITS PROVIDED BY OWNER OR KITCHEN

					LOAD SUI			
TAG	QTY.	FIXTURE	COLD AND HOT WATER FIXTURE UNIT PER FIXTURE	TOTAL COLD AND HOT WATER FIXTURE UNIT	HOT WATER GPH PER UNIT	TOTAL HOT WATER GPH	DRAINAGE FIXTURE UNIT PER FIXTURE	TOTAL DRAINAGE FIXTURE UNITS
WC-1	8	WATER CLOSET	2.5	20	-	-	4	32
WC-2	3	WATER CLOSET (ADA)	2.5	7.5	-	-	4	12
EX.WC	1	EXISTING WATER CLOSET	8.0	8.0	-	-	4	4
LAV-1,2	11	LAVATORY	1	11	6	66	1	11
EX. LAV.	1	EXISTING LAVATORY	1	1	6	6	1	1
HB-1	1	HOSE BIB	2.5	2.5	-	-	-	_
S-1 & 2	6	HAND SINK	1	6	2	12	1	6
SH-1	1	SHOWER	2	2	60	60	3	3
DF-1	1	DRINKING FOUNTAIN	0.5	0.5			0.5	0.5
3-CS	1	3-COMPARTMENT SINK	3.0	3.0	45	45		
W/D	1	WASHER/DRYER	1.5	1.5	30	30	2	2
MS-1	1	MOP SINK	3	3	20	20	3	3
DW	1	DISHWASHER	1.5	1.5	50	50		
-	2	COFFEE AND TEA BREWER	0.5	1	-	-		
1-CS	1	1 COMP. SINK	3	3	6	6	3	3
SB	1	SHAMPOO BOWL	1	1	6	6	1	1
FS-1	2	FLOOD CINIC		<del>~</del>				10
FD-1		FLOOR SINK	-	_	-		5	10
ו ט-ו	5	FLOOR DRAIN	-	$\sim$	-	-	5	25
			TOTAL CW & HW FIXTURE UNITS	72.5	TOTAL HW GPH	301	TOTAL DRAINAGE FIXTURE UNIT	113.5
			FLUSH TANK GPM	36				

GREASE INTERCEPTOR CALCULATIONS

		Pr	oject N	Name: T	own Square		
Step 1: Flow rate to gre	-	· ,					
Fixture flow rate: $(cu in / 231) = gal \times 0.5 / 2 min = 2 min flow rate$							
NAME	TYPE	DIMENSIONS	QTY	CU IN F	LOW RATE		
3-Comp Sink Mop Sink Floor Drain	3 Compartment Sink Mop Sink Floor Drain	25" x 18" x 14" (3) 22" x 22" x 10" N/A	1 1 0	18,144 4,840 N/A	29.45 GPM 7.86 GPM 0.0 GPM		
Total							

Step 2: Grease Production
Servings per day x Grease production value x Days between pump-outs = Grease output

Number of meals served per day: 200

Grease production value: 0.035 lbs per serving (Cafeteria - Full Serve: High / No flatware)
Days between pump-outs: 90 days

200 x 0.035 x 90 = 630 lbs of FOG

SCHIER MODEL

GB-75

Description: Polyethylene Grease Interceptor Dimensions: Length: 47", Width: 33", Height: 39.75" Flow Rates/Grease Capacities: 75 GPM / 861 lbs Liquid Capacity: 125 gal

#### CONNECTION SIZES DESCRIPTION SYMBOL FIXTURE C.W. | H.W. | W. | V. AMERICAN STANDARD 16-1/2" HIGH "CADET" MODEL# 2467.016 VITREOUS CHINA, TANK TYPE, PRESSURE ASSIST (1.6 GPF) FLUSH. ELONGATED BOWL. PROVIDE COMMERCIAL OPEN FRONT WATER CLOSET WC-1 SEAT AND MCGUIRE 2166CC ANGLE SUPPLY. AMERICAN STANDARD 16-1/2" HIGH "CADET" MODEL# 2467.016 VITREOUS CHINA, TANK TYPE, WC-2 WATER CLOSET PRESSURE ASSIST (1.6 GPF) FLUSH. ELONGATED BOWL. PROVIDE COMMERCIAL OPEN FRONT SEAT AND MCGUIRE 2166CC ANGLE SUPPLY. AMERICAN STANDARD "LUCERNE" 0356.421.020 (20"X18") WALL HUNG LAVATORY, VITREOUS CHINA, SINGLE HOLE. AMERICAN STANDARD "SELECTRONIC" MODEL 7025.305.295 FAUCET (0.5 GPM), ABOVE LAVATORY DECK MIXING, INTEGRAL TEMPERATURE LIMITER THAT MEETS ASSE 1070. PROVIDE MCGUIRE 2165CC L-1 1/2" | 1/2" | 2" | 1-1/2" | SUPPLIES AND "PROWRAP" KIT PW-2150WC, INCLUDES PREWRAPPED OFFSET DRAIN, PREWRAPPED (ADA) CAST BRASS "P" TRAP, TAILPIECE COVER, SUPPLY COVERS, AND CHROME PLATED FLANGE. INSTALL IN ACCORDANCE WITH ANSI 117.1 AND NC PLUMBING CODE. AMERICAN STANDARD "LUCERNE" 0356.421.020 (20"X18") WALL HUNG LAVATORY, VITREOUS CHINA, SINGLE HOLE. AMERICAN STANDARD "SELECTRONIC" MODEL 7025.305.295 FAUCET (0.5 GPM), ABOVE DECK MIXING, INTEGRAL TEMPERATURE LIMITER THAT MEETS ASSE 1070. PROVIDE MCGUIRE 2165CC LAVATORY L-2 SUPPLIES AND "PROWRAP" KIT PW-2150WC, INCLUDES PREWRAPPED OFFSET DRAIN, PREWRAPPED (ADA) CAST BRASS "P" TRAP, TAILPIECE COVER, SUPPLY COVERS, AND CHROME PLATED FLANGE. INSTALL IN ACCORDANCE WITH ANSI 117.1 AND NC PLUMBING CODE. ELECTRIC WATER COOLER, DUAL LEVEL. ELKAY EZSTL8C, BARRIER FREE. (8 GPH, WATER COOLER DF-1 4.5F.L.A., 120-1-60) PROVIDE APRON. McGUIRE 165 ANGLE SUPPLY AND 8872 CAST BRASS ELKAY ELUHAD211555 18 GAUGE 304 STAINLESS STEEL SINGLE COMPARTMENT UNDERMOUNT ADA SINK BREAK SINK (23-1/2X18-1/4"X5-3/8") WITH KOHLER "SIMPLICE" MODEL K-596 (1.5 GPM) GOOSENECK FAUCET WITH S-1 PULL-DOWN SPRAY. FINISH: VIBRANT STAINLESS. LK-99 BASKET STRAINER. MCGUIRE 2165CC SUPPLIES, 8912 CAST BRASS "P" TRAP, PROVIDE MV2 UNDER SINK ON HOT WATER SUPPLY LINE. INSULATE EXPOSED PIPING TRAP AND PIPING BELOW SINK PER ANSI 117.1 ELKAY ELUHAD211555 18 GAUGE 304 STAINLESS STEEL SINGLE COMPARTMENT UNDERMOUNT ADA SINK (23-1/2X18-1/4"X5-3/8") WITH KOHLER "SIMPLICE" MODEL K-596 (1.5 GPM) GOOSENECK FAUCET WITH S-2 PULL-DOWN SPRAY. FINISH: VIBRANT STAINLESS. LK-99 BASKET STRAINER. MCGUIRE 2165CC SUPPLIES,

SHOWER DRAIN SD

<u>The summer of the summer of t</u>

1/2" | 1/2" | 2" | 1-1/2" | HOT WATER SUPPLY. PROVIDE HAIR TRAP HT IN DRAIN LINE.

8912 CAST BRASS "P" TRAP, PROVIDE MV2 UNDER SINK ON HOT WATER SUPPLY LINE. INSULATE EXPOSED

STRAINER, PROVIDE T&S BRASS B-0665-BSTP SERVICE SINK FAUCET WITH INTEGRAL STOPS, VACUUM

LIBERTY LINE MODEL 11383834 (36"X36"). GEL COAT, BARRIER FREE TRANSFER TYPE WITH L-SHAPED

VALVE WITH STOP SCREW TO LIMIT HANDLE TURN, SEPARATE DUAL OUTLET LEVER DIVERTER VALVE,

SHAMPOO BOWL BY TENANT. INSTALL PER MANUFACTURER'S INSTRUCTIONS. PROVIDE BACKFLOW PREVENTER BFP-2 AND SOV AND SHOCK ARRESTOR IN SUPPLY LINES. PROVIDE MIXING VALVE MV2 ON

WALL/HAND SHOWER WITH FLEXIBLE METAL HOSE, IN-LINE VACUUM BREAKER, WALL CONNECTION AND MOUNTING CRADLE, FIXED SHOWER HEAD WITH BRACKET, 1.5 GPM FLOW RESTRICTOR. PROVIDE

FOLD-UP SEAT, L-SHAPED GRAB BAR, SOAP DISH, STAINLESS STEEL CURTAIN ROD AND DRAIN. PROVIDE

BREAKER, HOSE THREAD OUTLET & PAIL HOOK. PROVIDE MOP HANGER & HOSE & BRACKET, WALL

1-1/2" SYMMONS ALLURA MODEL 4705 SHOWER SYSTEM WITH HAND SHOWER, PRESSURE BALANCING MIXING

MOLDED MOP RECEPTOR, FIAT MODEL MSB-2424 (24"x24") WITH INTERGRAL DRAIN & CHROME

PIPING TRAP AND PIPING BELOW SINK PER ANSI 117.1

WASHING MACHINE BOX. 1/4 TURN BRASS BALL HAMMER VALVES, 2"

PLUMBING FIXTURES SCHEDULE

NOTES:

MS-1

1. ALL FIXTURE MAY BE SUBSTITUTED WITH APPROVED EQUAL. CONTACT OWNER FOR APPROVAL.

MOP SINK

SHOWER

WASHING MACHINE BOX

SHAMPOO BOWL

2. SEE ARCHITECTURAL PLANS FOR EXACT MANUFACTURER AND MODEL, LOCATION AND MOUNTING HEIGHTS OF ALL FIXTURES.
3. FLUSH VALVE HANDLES SHALL BE LOCATED OPPOSITE OF HAND RAIL AS PER ADA REQUIREMENT.
4. PROVIDE CARRIERS FOR ALL WALL MOUNTED FIXTURES.

		PLUMBING SPECIALITIES SCHEDULE				
SYMBOL	NAME	DESCRIPTION  ASSE 1013 APPROVED WATTS LF009-QT-S. LEAD FREE, REDUCED PRESSURE PRINCIPLE BACKFLOW PREVENTER WITH QUARTER TURN.FULL PORT, RESILIENT SEATED, BRONZE BALL VALVE SHUTOFFS AND AIR GAP FITTING  BACKFLOW PREVENTER EQUAL: ASSE 1022 WATTS SD-3, LEAD FREE, DUAL CHECK VALVE WITH ATMOSPHERIC PORT AND STRAINER FOR COFFEE, TEA BREWER AND SHAMPOO BOWL.				
BFP-1	BACKFLOW PREVENTER					
BFP-2	BACKFLOW PREVENTER					
BALANCING VALVE	BALANCING VALVE	WATTS LFCSM 61-S OR EQUIVALENT. LEAD FREE, NSF-61 ANNEX G CERTIFIED. BI-DIRECTIONAL, BALL DESIGN, POSITION INDICATOR, MEMORY DEVICE, CHECKED METERING PORTS WITH DRIP CAPS AND INTEGRAL DRAIN PORTS.				
FD-1	FLOOR DRAIN (GENERAL/TOILETS)	J.R. SMITH FIG#2005-B-NB. CAST IRON, ADJUSTABLE, WITH NICKEL BRONZE TOP. PROVIDE TRAP GUARD ON ALL FLOOR DRAINS				
FS-1	FLOOR SINK (KITCHEN)	J.R. SMITH / ZURN OR EQUAL				
FCO	FLOOR CLEANOUT	J.R.SMITH MODEL 4429. PROVIDE NICKEL-BRONZE ADJUSTABLE TOP.				
wco	WALL CLEANOUT	J.R. SMITH / ZURN OR EQUAL				
GI-1	GREASE INTERCEPTOR	SCHIER GB-75 OR EQUIVALENT, CAPACITY: LIQUID 125 GAL. & GREASE 861LBS @ 75GPM. PROVIDE FCR2 FILED CUT RISER IF REQUIRED.				
HB-1	HOSE BIBB	WOODFORD MODEL 24 P3/4 WITH VACUUM BREAKER AND THREADED SPOUT. LOOSE KEY.				
HT	HAIR TRAP	ZURN Z1175. CAST IRON HAIR INTERCEPTOR. WITH STAINLESS STEEL STRAINER SCREEN AND CAST IRON, COUNTER-SUNK, FLANGED CLEANOUT COVER, GAS TIGHT, REMOVABLE FOR SCHEDULED PERIODIC CLEANING.				
MV-1	MIXING VALVE (WATER HEATER)	WATTS LFN170 LEAD FREE MASTER TEMPERING VALVE. LEAD FREE BRASS BODY, THERMOSTAT ASSEMBLY, LOCKABLE TEMPERATURE ADJUSTMENT, SINGLE SEAT DESIGN FOR TIGHT SHUT-OFF IN EVENT OF COLD WATER SUPPLY LOSS. ASSE 1017 LISTED.				
MV-2	MIXING VALVE (FIXTURE)	ZURN ZW1070XL LEAD FREE THERMOSTATIC MIXING VALVE. LEAD FREE BRASS BODY, INTEGRAL CHECK VALVES, ADJUSTMENT CAP WITH LOCKING FEATURE, ASSE 1070. MINIMUM FLOW RATE 0.25 GPM				
LD	LEAK DETECTOR	"WATERCOP" LEAK DETECTION SYSTEM TO INCLUDE SOLENOID VALVE: (LEAD FREE) ANSI NSF 372, WITH VISUAL AND AUDIBLE ALARM PANEL AND HARD-WIRED SENSOR.				
SA	SHOCK ABSORBER	SIOUX CHIEF, A=652-A, B=653-B, C=654-C, D=655-D				

CONSULTANTS (ENGINEER):

NY ENGINEERS

NEARBY ENGINEERS
382 NE 191ST STREET SUITE 49674,
MIAMI, FL 33179
PH-914.257.3455
WWW.NY-ENGINEERS.COM

CONTRACTOR'S NOTES:

WRITTEN DIMENSIONS HOLD PREFERENCE OVER SCALED DIMENSIONS. DO NOT SCALE THE DRAWINGS. THE CONTRACTORS MUST VISIT JOB SITE TO VERIFY ALL EXISTING CONDITIONS AND DIMENSIONS BEFORE SUBMITTING BIDS. REPORT ANY DISCREPANCIES OF ANY CONDITIONS WHICH MAY INTERFERE WITH THE PROPER EXECUTION OF, THE CONTRACT TO THE TENANT'S REPRESENTATIVE. REPORT DISCREPANCIES DURING BIDDING PROCESS AND BEFORE START OF CONSTRUCTION. CHANGE ORDERS NEED TO BE APPROVED BY TOWNSQUARE CONSTRUCTION MANAGER FOR ISSUES ARISING FROM THE FIELD CONDITIONS OR CONFLICTS BETWEEN THE PLANS AND

DATE ISSUE
10.31.24 LL/CLIENT REVIEW SET
11.15.24 LL/CLIENT REVIEW SET
11.22.24 BD SUBMISSION

THE EXISTING CONDITIONS PRIOR TO THE

COMMENCEMENT OF WORK.

11.15.24 CLIENT COMMENTS


△ DATE REVISION



TITI F:

PLUMBING SCHEDULES

SHEET NUMBER:

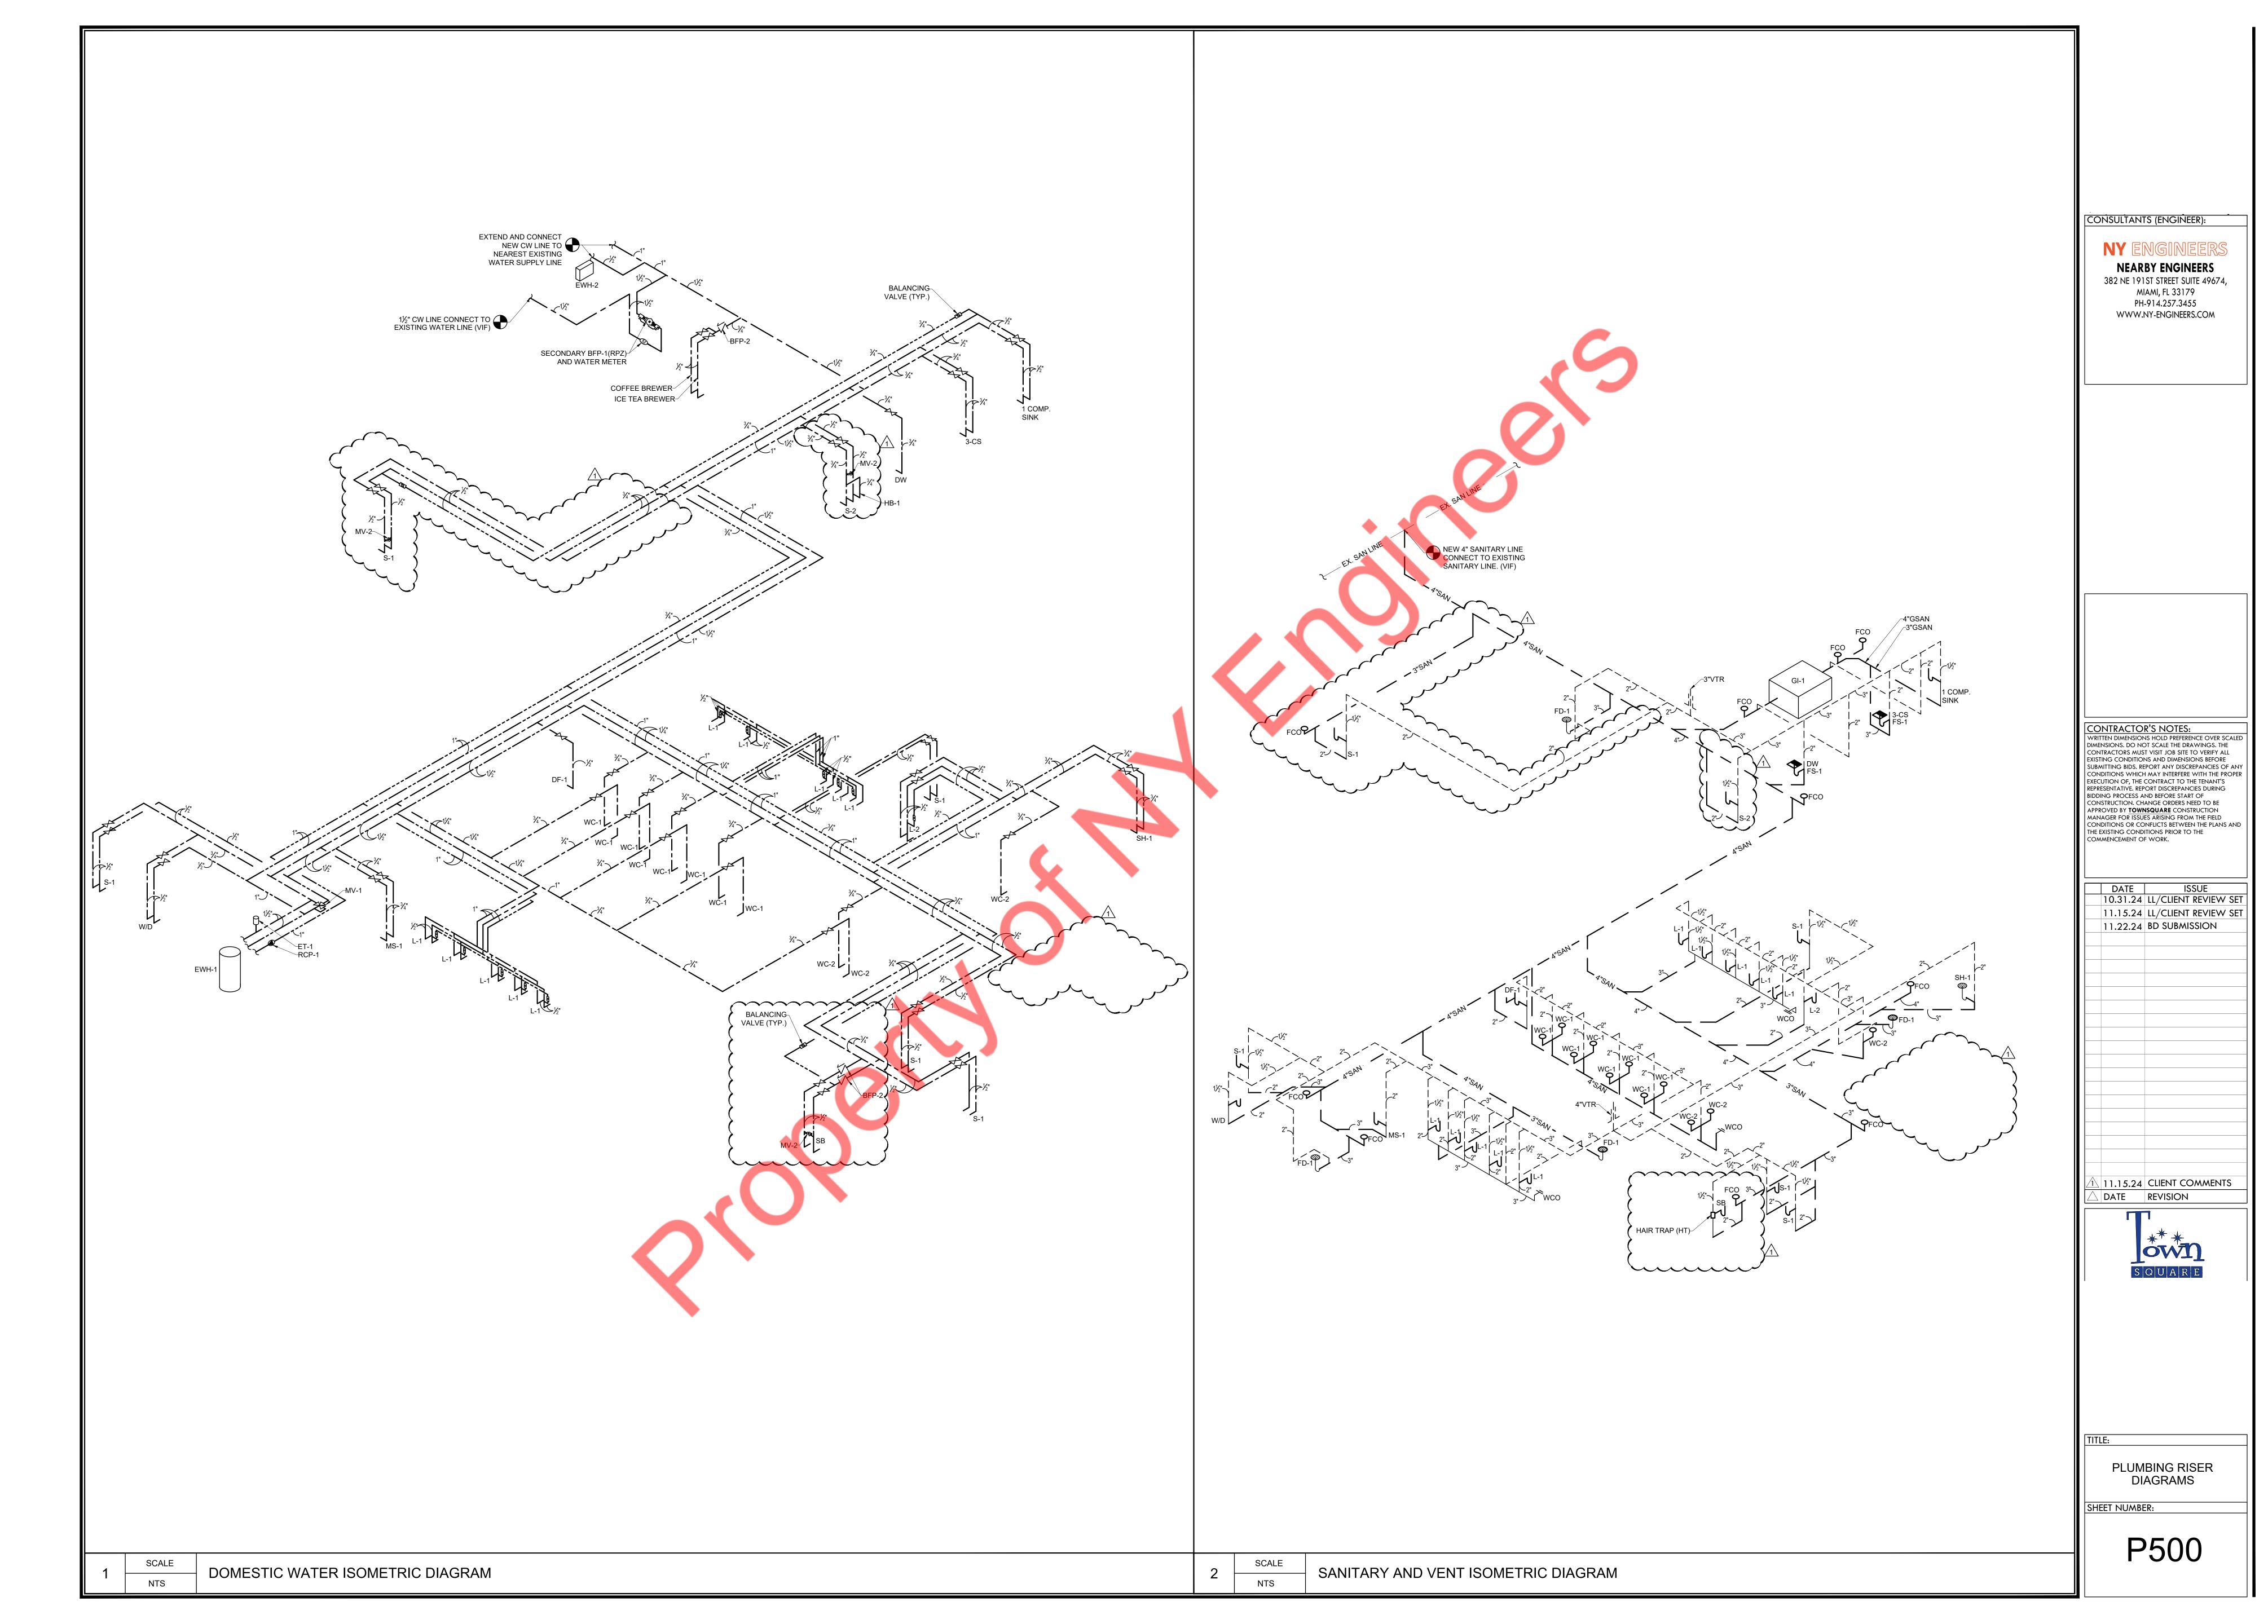

#### SPRINKLER GENERAL NOTES

- 1. ALL SPRINKLER WORK SHALL BE IN ACCORDANCE WITH THE REQUIREMENTS OF NFPA-13 2019. INTERNATIONAL FIRE CODE 2021 AND ALL LOCAL LAWS AND AUTHORITIES.
- CONTRACTOR SHALL COORDINATE WITH OTHER TRADES AND SHALL INSTALL NEW WORK TO CLEAR DUCTWORK AND LIGHTING FIXTURES.
- 3. ALL SPRINKLER WORK SHALL COMPLY WITH BUILDING STANDARDS AND
- 4. ALL SPRINKLER HEADS SHALL BE INSTALLED AT CENTER OF TILE WHEREVER APPLICABLE.
- 5. GENERAL CONTRACTOR SHALL COORDINATE FINAL FURNITURE / EQUIPMENT HEIGHT ELEVATIONS AND LOCATIONS WITH SPRINKLER INSTALLATION. ENGINEER SHALL BE NOTIFIED WHEN FURNITURE / EQUIPMENT IS LESS THAN 18" TO UNDERSIDE OF CEILING.
- PIPES SIZES SHOWN ARE BASED ON DESIGN PIPING LAYOUTS ONLY. ACTUAL PIPE SIZES SHALL BE DETERMINED BY CONTRACTORS HYDRAULIC CALCULATIONS BASED ON HIS INSTALLATION DRAWINGS. CONTRACTOR SHALL ALLOW FOR THIS AND INCLUDE THIS IN HIS
- DRAWING INDICATES SPRINKLER SYSTEM DESIGN ONLY. CONTRACTOR RESPONSIBLE FOR OFFSETS, DROPS AND RISES FOR COORDINATION WITH OTHER TRADES.

CONTRACT PRICE.

DETECTION DEVICES.

- 8. G.C. SHALL BE RESPONSIBLE FOR ALL FINAL TESTS AND INSPECTIONS OF COMPLETED WORK REQUIRED BY THE BUILDING MANAGEMENT PRIOR TO OCCUPANCY OF SPACE.
- 9. ALL SPRINKLER WORK SHALL BE TESTED AND MADE OPERATIONAL PRIOR TO CARPET AND FURNITURE INSTALLATION. G.C. SHALL REPAIR AND/OR REPLACE ALL FINISHES DAMAGED BY DEFECTIVE SPRINKLER WORK AT HIS EXPENSE.
- 10. ALL BURNING, CUTTING, SOLDERING AND WELDING SHALL BE COORDINATED WITH BUILDING FIRE SYSTEMS WITH BUILDING
- MANAGEMENT. AS REQUIRED. 11. REFER TO ENGINEERING DRAWINGS FOR SPRINKLER HEADS AND FIRE
- 12. ALL WORK TO BE DONE DURING THE HOURS DESIGNATED BY OWNER.
- 13. UPON COMPLETION OF ALL SPRINKLER WORK, CONTRACTOR SHALL TEST AND INSPECT ENTIRE SPRINKLER SYSTEM. ENTIRE SYSTEM SHALL BE FULLY OPERATIONAL AND APPROVED IN COMPLIANCE WITH ALL AHJ.
- 14. UPON SUCCESSFUL COMPLETION OF ALL TESTING, CONTRACTOR SHALL PRIME AND PAINT ALL EXPOSED SPRINKLER PIPING. COLOR AND FINISH SHALL BE AS PER ARCHITECT.
- 15. CONTRACTOR SHALL INCLUDE IN HIS BID THE COST TO PROVIDE (10) TEN ADDITIONAL SPRINKLERS INSTALLED. EXACT LOCATIONS OF THESE SPRINKLER HEADS SHALL BE DETERMINED IN FIELD.
- 16. THE SPRINKLER SYSTEMS ARE TO BE HYDROSTATIC TESTED FOR A (2) HOUR MINIMUM AT 200 LBS. PRESSURE AND ARE TO BE WITNESSED BY AUTHORIZED BUILDING PERSONNEL. COORDINATE ALL TESTING WITH BUILDING MANAGER.
- 17. ALL SERVICE SHUTDOWNS SHALL BE BY BASE BUILDING ENGINEERS. MINIMUM OF 48 HOURS NOTICE IS REQUIRED TO THE BUILDING OFFICE PRIOR TO SHUT DOWN.
- 18. ALL SPRINKLER WORK SHALL COMPLY WITH BUILDING STANDARDS AND REQUIREMENTS.
- 19. PIPES SIZES SHOWN ARE BASED ON SCHEDULE OF PIPE SIZE PIPING LAYOUTS ONLY. ACTUAL PIPE SIZES SHALL BE DETERMINED BY CONTRACTORS HYDRAULIC CALCULATIONS BASED ON HIS INSTALLATION DRAWINGS. CONTRACTOR SHALL ALLOW FOR THIS AND INCLUDE THIS IN HIS CONTRACT PRICE.
- 20. PROVIDE AUXILIARY DRAINS AT TRAPPED SECTIONS OF PIPING AS REQUIRED BY NFPA-13-2019.
- 21. COMPOSITE DRAWINGS

CONTRACTOR SHALL BE GIVEN A SEPIA TRANSPARENCIES TO IMPOSE THEIR WORK FOR A COORDINATED ALLOCATION OF SPACE. PROCEDURE SHALL INCLUDE HVAC CONTRACTOR TO INDICATE DUCT WORK, PIPING, STRUCTURAL AND ARCHITECTURAL DETAILS. SEPIAS SHALL BE GIVEN TO PLUMBING, SPRINKLER AND ELECTRICAL TRADES WHO WILL DRAW HIS WORK ON DRAWINGS. HVAC CONTRACTORS SHALL HOLD A COORDINATION MEETING WITH ALL CONTRACTORS TO ELIMINATE INTERFERENCE OR CONFLICTS IN INSTALLING WORK. IF UNABLE TO EACH AGREEMENT ISSUE, ARCHITECT SHALL MAKE BINDING DECISION

## SPRINKLER DRAWING LIST

SP001 SPRINKLER NOTES, SYMBOLS & SPECIFICATIONS

SP100 SPRINKLER PLAN

SP200 SPRINKLER DETAILS

## SPACING BETWEEN SPRINKLER HEADS

LIGHT HAZARD: 15' MAX. ORDNIARY HAZARD: 15' MAX

NOTE: MAXIMUM DISTANCE BETWEEN SPRINKLER HEADS & WALLS IS % THE DISTANCE BETWEEN HEADS.

PROTECTION AREA OF SPRINKLER HEADS

LIGHT HAZARD : 225 SQ. FT. ORDINARY HAZARD: 130 SQ. FT.

NAME

**GENERAL NOTES** 

SYMBOL

. FOR SPRINKLER WORK ONLY. 2. ALL SPRINKLER HEADS MEET DESIGN CRITERIA PER COVERAGE

#### BUILDING DEPARTMENT SPRINKLER NOTES


- 1. THE INSTALLATION, COMPONENTS, SIZING, SPACING, CLEARANCES, POSITION AND TYPE OF SYSTEMS SHALL CONFORM TO THE 2021 INTERNATIONAL BUILDING CODE, AND 2021 INTERNATIONAL FIRE CODE OF NEW JERSEY.
- 2. DIRECT CONNECTION OF SPRINKLERS TO THE PUBLIC WATER SYSTEM SHALL CONFORM TO SECTION 903.3.5 OF 2021 INTERNATIONAL BUILDING CODE FOR NEW JERSEY.
- 3. AUTOMATIC SPRINKLER SYSTEMS SHALL COMPLY WITH SECTION 903 OF 2021 INTERNATIONAL BUILDING CODE OF NEW JERSEY.
- 4. INSPECTION AND TESTS OF SPRINKLERS SHALL BE CONDUCTED AS SEC. 903.5 OF 2021 INTERNATIONAL BUILDING CODE OF NEW JERSEY & 2021 INTERNATIONAL FIRE CODE.
- 5. THE OCCUPANCY OF THE AREAS TO BE SPRINKLER IN ACCORDANCE WITH 903.2 OF 2021 INTERNATIONAL BUILDING CODE OF NEW JERSEY.
- 6. FIRE HOSE THREADS AND FITTINGS USED IN CONNECTION WITH AUTOMATIC SPRINKLER SYSTEMS SHALL BE IN ACCORDANCE WITH 903.3.6 OF 2021 INTERNATIONAL BUILDING CODE OF NEW JERSEY.
- 7. STOCK OF EXTRA SPRINKLERS WILL BE FURNISHED AS REQUIRED BY 2021 INTERNATIONAL FIRE CODE OF NEW JERSEY (REQUIRED FOR EACH TEMPERATURE RATING).
- 8. SPRINKLER ALARM SHALL BE IN ACCORDANCE WITH CHAPTER 9 OF 2021 INTERNATIONAL FIRE CODE OF NEW JERSEY.
- 9. ALL BLIND SPACES EXCEEDING 6" IN WIDTH OR DEPTH WHICH CONTAIN COMBUSTIBLE MATERIAL WILL BE SPRINKLERED.
- 10. ALL PIPE PASSING THROUGH WALLS WILL COMPLY WITH SECTION SEC. 714 2021 INTERNATIONAL FIRE CODE OF NEW JERSEY. 11. PROVIDE DEPARTMENT OF WATER SUPPLY LETTER WITH FLOW TEST
- SUPPLY

DATE IF THERE IS A DIRECT CONNECTION TO THE STREET WATER

- 12. ALL VALVES ON CONNECTIONS TO WATER SUPPLIES TO SPRINKLER SHALL BE APPROVED O.S. & Y. OR APPROVED INDICATOR TYPE.
- 13. HANGERS SHOULD BE SUPPORTED BY WROUGHT IRON U TYPE OR APPROVED ADJUSTABLE HANGERS. HANGERS SHALL BE OF THE TYPE APPROVED FOR USE WITH THE PIPE OR TUBE INVOLVED, AS PER 2021 INTERNATIONAL FIRE CODE OF NEW JERSEY.
- 14. MINIMUM BRANCH PIPE SIZE TO BE ONE INCH (1").

JERSEY.

- 15. THIS APPLICATION IS MADE ONLY FOR WORK INDICATED ON THE SPECIFICATION SHEET. ALL OTHER MATTERS SHOWN ARE NOT TO BE RELIED UPON OR TO BE CONSIDERED AS EITHER BEING APPROVED OR
- IN ACCORDANCE WITH APPLICABLE CODES. 16. FIRE PROTECTION SYSTEM SHALL BE MAINTAINED IN ACCORDANCE WITH SECTION 901.2 OF 2021 INTERNATIONAL FIRE CODE OF NEW
- 17. FIRE PROTECTION SYSTEMS SHALL BE INSPECTED, TESTED AND MAINTAINED IN ACCORDANCE WITH THE REFERENCED STANDARDS LISTED IN TABLE 901.6.2 OF 2021 INTERNATIONAL FIRE CODE OF NEW JERSEY.
- 18. AUTOMATIC SPRINKLER SYSTEMS SHALL BE DESIGNED AND INSTALLED IN ACCORDANCE WITH SECTIONS 903.3.1 THROUGH 903.3.5 OF 2021 INTERNATIONAL FIRE CODE OF NEW JERSEY...
- 19. SHOP DRAWINGS FOR THE FIRE PROTECTION SYSTEM SHALL BE A. THE CONTRACTOR SHALL SUBMIT, FOR APPROVAL, FULLY MITTED TO INDICATE CONFORMANCE TO CHAPTER 9, ANY OTHER APPLICABLE PROVISION OF THE UNIFORM CODE, AND THE CONSTRUCTION DOCUMENTS PER WSBC SECTION 106.2.2 & CHAPTER 23. NFPA 13-2019. SUCH SHOP DRAWINGS SHALL BE APPROVED PRIOR TO THE START OF SYSTEM INSTALLATION. SHOP DRAWINGS SHALL CONTAIN ALL INFORMATION AS REQUIRED BY THE REFERENCED INSTALLATION STANDARDS IN CHAPTER 9 OR IN ANY OTHER APPLICABLE PROVISION OF THE UNIFORM CODE.
- 20. PROVIDE FLUSHING TO SPRINKLER SYSTEM AS PER NFPA 13-2019 SECTION 8.16.3 AND TESTING PER NFPA 13-2019 SECTION 10.10.2.2 WITNESSED BY THE AHJ. FLUSHING & TESTING SHALL BE DOCUMENTED ON THE REQUIRED NFPA FORMS AND A COPY PROVIDED TO THE AHJ. CO-ORDINATE FLUSHING DRAIN REQUIREMENT WITH PLUMBING CONTRACTOR.

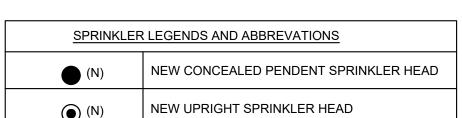

HAZARD CLASSIFICATION AND DESIGN DENSITY OCCUPANCY: LIGHT HAZARD

MINIMUM DESIGN DENSITY: 0.10 GPM/SQ. FT.

OCCUPANCY: ORDINARY HAZARD MINIMUM DESIGN DENSITY: 0.15 GPM/SQ. FT.

#### D. THE SCHEDULING OF THE SPRINKLER WORK SHALL BE COORDINATED WITH BUILDING MANAGEMENT, WITH OTHER CONTRACTORS AND WITH THE ENGINEER.

MUST BE COORDINATED WITH BUILDING MANAGEMENT. SHUT-DOWNS OF BASE BUILDING SYSTEMS SHALL TAKE PLACE AFTER OR BEFORE NORMAL BUSINESS HOURS AND SHALL BE CONSIDERED OVERTIME WORK. THE CONTRACTOR MUST GIVE BUILDING MANAGEMENT AND CITY FIRE DEPARTMENT 48 HOURS NOTICE PRIOR TO SHUT-DOWN OF SPRINKLER, OR OTHER SYSTEMS.

. NECESSARY SHUT-DOWNS OF BASE BUILDING SPRINKLER SYSTEM

A. THE SPRINKLER CONTRACTOR SHALL BE A LICENSED, AUTHORIZED

B. BEFORE SUBMITTING HIS BID, THE SPRINKLER CONTRACTOR SHALL

INSTALLER OF SPRINKLER SYSTEMS AND SHALL HAVE HAD A MINIMUM

OF FIVE YEARS EXPERIENCE IN THE INSTALLATION OF SPRINKLER

VISIT THE SITE AND SHALL FULLY FAMILIARIZE HIMSELF WITH, AND

BECOME FAMILIAR WITH THE DIFFICULTIES THAT WILL ATTEND THE

CONSTRUED AS EVIDENCE THAT SUCH AN EXAMINATION HAS BEEN

LABOR, EQUIPMENT OR MATERIALS REQUIRED BECAUSE OF

DIFFICULTIES ENCOUNTERED WHICH COULD HAVE BEEN FORESEEN

SUBMITTING HIS PROPOSAL, THE SPRINKLER CONTRACTOR SHALL

REQUEST CLARIFICATION IN WRITING, IF NECESSARY, CONCERNING

THE INTENT OF THE PLANS AND SPECIFICATIONS TO PROVIDE A

COMPLETE SPRINKLER SYSTEM INSTALLATION. LATER CLAIMS WILL

NOT BE RECOGNIZED FOR EXTRA LABOR, EQUIPMENT OF MATERIALS

C. UPON REVIEW OF THE DRAWINGS AND SPECIFICATIONS, PRIOR TO

MADE, AND LATER CLAIMS WILL NOT BE RECOGNIZED FOR EXTRA

#### 1.02 WORK INCLUDED

1.01 REQUIREMENTS

SYSTEMS IN THE CITY CODE.

HAD SUCH AN EXAMINATION BEEN MADE.

SHOULD SUCH PROCEDURE NOT BE FOLLOWED.

- A. WORK SHALL INCLUDE ALL SPRINKLER WORK FURNISHED AND INSTALLED AS INDICATED ON THE PLANS AND AS SPECIFIED HEREIN.
- 1. ALL WORK SHALL COMPLY WITH REQUIREMENTS OF THE . CITY BUILDING CODE, N.F.P.A. STANDARD 13-2019, INTERNATIONAL FIRE CODE 2021. FIRE DEPARTMENT AND OWNERS INSURANCE RATING ORGANIZATION.
- PROVIDE COMPLETE NEW SPRINKLER SYSTEM CONNECTING TO EXISTING SPRINKLER SYSTEM ALARM CHECK VALVE ASSEMBLY.
- 3. THESE DRAWINGS ARE DIAGRAMMATIC AND INDICATE THE GENERAL LOCATION OF WORK. SCALED DIMENSIONS SHALL NOT BE USED. ANY DIMENSIONS NOT SHOWN SHALL BE OBTAINED FROM FIELD MEASUREMENTS.
- 4. PROVIDE COMPUTER GENERATED HYDRAULIC CALCULATIONS IN ACCORDANCE WITH 2021 INTERNATIONAL BUILDING CODE OF NEW JERSEY OR LOCAL AHJ. BUILDING DEPARTMENT AND NFPA STANDARDS.

#### 1.03 SHOP DRAWINGS AND SUBMITTALS

- COORDINATED SHOP DRAWINGS, CAPACITY, DATA, AND CATALOG CUT OF THE FOLLOWING:
- 1. PIPE AND FITTINGS
- VALVES 3. HANGERS AND SUPPORTS
- SPRINKLER PIPING LAYOUT TESTS
- 6. SPRINKLER HEADS 7. HYDRAULIC CALCULATIONS
- A. THE SPRINKLER SYSTEM SHALL BE HYDRAULICALLY DESIGNED. CONTRACTOR SHALL SUBMIT CALCULATIONS WITH SHOP DRAWINGS. CALCULATIONS SHALL BE PERFORMED IN ACCORDANCE WITH REQUIREMENTS OF NFPA 13-2019, AND 2021 INTERNATIONAL FIRE CODE OF NEW JERSEY.
- B. ADD APPROPRIATE HOSE ALLOWANCE.
- C. THE SPRINKLER CONTRACTOR SHALL OBTAIN THE LATEST FIRE PUMP TEST AT THE SITE TO VERIFY THE AVAILABLE WATER SUPPLY.

## 1.04 BUILDING DEPARTMENT FILING, PERMITS AND CERTIFICATES

- A. THE SPRINKLER CONTRACTOR SHALL FILE ALL REQUIRED DRAWINGS AND HYDRAULIC CALCULATIONS WITH THE BUILDING DEPARTMENT AND BE RESPONSIBLE FOR OBTAINING FINAL APPROVAL.
- B. ARRANGE FOR INSPECTION AND TESTS OF ANY AND ALL PARTS OF THE WORK AS REQUIRED BY AUTHORITIES HAVING JURISDICTION AND PAY ALL CHARGES FOR SAME.

## 1.05 INSPECTION AND TESTING

- A. THE SPRINKLER SYSTEM SHALL BE INSPECTED AND TESTED IN ACCORDANCE WITH THE REQUIREMENTS OF THE . CITY BUILDING CODE FIRE DEPARTMENT INSPECTOR.
- B. THE SPRINKLER SYSTEM SHALL BE SUBJECTED TO A HYDROSTATION PRESSURE TEST FOR A PERIOD OF TWO HOURS AT A PRESSURE OF AT LEAST 200 PSIG OR 50 PSI IN EXCESS OF THE MAXIMUM PRESSURE TO BE MAINTAINED WHEN THE MAXIMUM PRESSURE IN THE SYSTEM IS IN EXCESS OF 150 PSI AS PER NFPA.
- C. THE BUILDING DEPARTMENT SHALL BE NOTIFIED THAT THE SYSTEM IS READY FOR REINSPECTION AND TESTING. THE BUILDING DEPARTMENT INSPECTOR SHALL WITNESS THE TEST. FINAL APPROVAL OF THE SPRINKLER SYSTEM SHALL BE OBTAINED FROM BUILDING DEPARTMENT, AND FIRE DEPARTMENT.

# PART 2 - MATERIALS

2.01 GENERAL

A. THE SPRINKLER SYSTEM SHALL BE COMPLETE WITH ALL PIPE, FITTINGS, VALVES, DRAINAGE SYSTEM AND VALVES, HANGERS AND SUPPORTS. ALSO, MISCELLANEOUS WORK ITEMS, SUCH AS, SIGNS AS REQUIRED, VALVE TAGS, ETC., AND ALL OTHER RELATED EQUIPMENT, APPARATUS AND MATERIAL ITEMS NECESSARY FOR COMPLETE, APPROVED TYPE

## SPRINKLER SPECIFICATIONS

#### SYSTEM, READY FOR FUTURE EXTENSION.

B. ALL PIPE, FITTINGS, HANGERS, SUPPORTS, SPRINKLER HEADS, ETC., SHALL CONFORM TO THE . CITY BUILDING CODE AND NATIONAL FIRE PROTECTION ASSOCIATION'S REQUIREMENTS AS TO TYPES OF MATERIALS, ARRANGEMENT, SIZES AND INSTALLATION. PIPING PENETRATING FIRE RATED PARTITIONS SHALL HAVE OPENING SEALED WITH U.L. APPROVED FIREPROOF SEALANT

#### 2.02 SPRINKLER PIPING

- EXECUTION OF THIS WORK. CONTRACTOR SHALL PERFORM THIS PRIOR A. ALL SPRINKLER PIPING SHALL BE SCHEDULE 40 IN ACCORDANCE WITH NFPA 13. PIPE SHALL BE UL/FM APPROVED. TO SUBMITTING HIS PROPOSAL. SUBMISSION OF A PROPOSAL WILL BE
  - B. STEEL PIPE SHALL BE BETHLEHEM STEEL CO., ALLIED TUBE, BERGER INDUSTRIES OR APPROVED.
  - C. AS PER NFPA 13, PIPE OR TUBE USED IN SPRINKLER SYSTEMS SHALL BE
- AS PER NFPA 13, FITTINGS USED IN SPRINKLER SYSTEMS SHALL BE OF INFORM ARCHITECT AND/OR ENGINEER OF ANY DISCREPANCIES OR THE MATERIALS LISTED IN TABLE 6.4.1. FITTING SHALL BE UL/FM APPROVED. CONTRACTOR.

OF THE MATERIALS SPECIFIED IN SECTION 16.3.

NONMETALLIC PIPES & FITTINGS USED IN MULTIPURPOSE PIPING SYSTEMS NOT EQUIPPED WITH A FIRE DEPARTMENT CONNECTION SHALL BE DESIGNED TO WITHSTAND A WORKING PRESSURE OF NOT

#### 2.03 CUTTING AND PATCHING

LESS THAN 130PSI AT 120°F.

DO ALL CUTTING AND CORE DRILLING NECESSARY FOR THE INSTALLATION OF SPRINKLER WORK. ACCURATELY LAYOUT WORK FOR WHICH CUTTING IS REQUIRED. PATCH AND RESTORE ANY DAMAGE WORK TO LIKE NEW CONDITION.

### 2.04 CUTTING AND PATCHING

- 1. DO ALL CUTTING AND CORE DRILLING NECESSARY FOR THE INSTALLATION OF SPRINKLER WORK. ACCURATELY LAYOUT WORK FOR WHICH CUTTING IS REQUIRED. PATCH AND RESTORE ANY DAMAGE WORK TO LIKE NEW CONDITION.
- 2. FOR REPLACEMENT OF THE WORK REMOVED, MATCH EXISTING IN NATURE, CONSTRUCTION AND FINISH.
- 3. MAINTAIN THE PREMISES FREE FROM ACCUMULATION OF WASTE MATERIAL OR RUBBISH COVERED BY THE WORK, REMOVE ALL SURPLUS MATERIALS, TOOLS ETC. AND LEAVE PREMISES CLEAN.

## 2.05 FIRE STOPPING

INSTALLATION SHALL BE IN STRICT ACCORDANCE WITH THE MANUFACTURERS PUBLISHED DIRECTIONS AND PER FIRE TESTED DESIGNS THAT HAVE BEEN ACCEPTED BY THE APPROPRIATE CODE AUTHORITY HAVING JURISDICTION.

#### 2.06 PHASING

PHASING SHALL BE COORDINATED BETWEEN THE SPRINKLER CONTRACTOR AND GENERAL CONTRACTOR. SPRINKLER INSTALLATION SHALL BE PHASED IN A MANNER WHICH WILL ALLOW FULL OCCUPANCY OF THE EXISTING FACILITY WHILE THE INSTALLATION IS IN PROGRESS.

### 2.06 ALTERNATES/SUBSTITUTIONS

CONTRACTOR SHALL STATE IN THEIR PROPOSAL ANY CONTRACTOR PROPOSED SUBSTITUTIONS OF THE MATERIALS OR METHODS OF INSTALLATION FROM THAT SPECIFIED. THESE ALTERATIONS SHALL BE LISTED ON THE PROPOSAL AS CONTRACT<mark>OR</mark> ALTERNATIVE.

## 2.07 LEAK DAMAGE

THE SPRINKLER CONTRACTOR SHALL BE RESPONSIBLE DURING THE INSTALLATION AND TESTING PERIODS OF THE SPRINKLER SYSTEM FOR ANY LOSS OR DAMAGE TO THE WORK OF OTHERS, TO THE BUILDING, IT'S CONTENTS ETC. CAUSED BY LEAKS IN THE EQUIPMENT. BY UNPLUGGED OR DISCONNECTED PIPES, FITTINGS ETC. OR BY OVERFLOW, AND SHALL PAY FOR THE NECESSARY REPLACEMENTS OR REPAIRS TO THE WORK OF OTHERS, DAMAGED BY SUCH LEAKAGE.

## 2.08 INSERTS, HANGERS, ETC

- ALL SPRINKLER PIPING SHALL BE SUBSTANTIALLY SUPPORTED AND SHALL COMPLY WITH THE STANDARDS FOR THE NATIONAL FIRE PROTECTION ASSOCIATION FOR THE INSTALLATION OF SPRINKLER SYSTEMS AND AS REQUIRED BY THE . CITY BUILDING CODE.
- HANGERS AND THEIR COMPONENTS SHALL BE FERROUS. HANGERS SHALL BE ADJUSTABLE FLAT IRON TYPE OF CLEVIS TYPE.
- SPRINKLER PIPING OR HANGERS SHALL NOT BE USED TO SUPPORT NON-SYSTEM COMPONENTS.
- SPRINKLER PIPING SHALL BE SUBSTANTIALLY SUPPORTED FROM THE BUILDING STRUCTURE WHICH MUST SUPPORT THE ADDED LOAD OF THE WATER-FILLED PIPE PLUS A MINIMUM OF 250 LBS. APPLIED AT THE POINT OF HANGING. CONTRACTOR SHALL SUBMIT DETAIL OF SUPPORT FOR REVIEW AND APPROVAL.
- SPRINKLER PIPING SHALL BE SUPPORTED INDEPENDENTLY OF THE CEILING SHEATHING.
- WHEN SPRINKLER PIPING IS INSTALLED BELOW DUCTWORK, PIPING SHALL BE SUBSTANTIALLY SUPPORTED FROM THE BUILDING STRUCTURE, NOT FROM THE DUCTWORK.
- MAXIMUM DISTANCE BETWEEN HANGERS SHALL NOT EXCEED 12 FT. FOR 1 AND 1-1/4" SIZES NOR 15' FOR SIZES 1-1/2" AND LARGER.
- H. EXPANSION SHIELDS FOR SUPPORTING PIPES UNDER CONCRETE CONSTRUCTION MAYBE USED IN A HORIZONTAL POSITION IN THE SIDES OF BEAMS. IN CONCRETE HAVING GRAVEL OR CRUSHED STONE AGGREGATE, EXPANSION SHIELDS MAY BE USED IN THE VERTICAL POSITION TO SUPPORT PIPES 4" OR LESS IN DIAMETER.

## 2.09 ESCUTCHEONS

PROVIDE ESCUTCHEONS ON ALL EXPOSED PIPING PASSING THROUGH WALLS, PARTITIONS, FLOORS AND CEILINGS, ESCUTCHEON SHALL BE HELD IN PLACE BY INTERNAL TENSION OR SET SCREW.

## 2.10 AS-BUILT DRAWINGS

PREPARE AND SUBMIT "AS BUILT" DRAWINGS AT THE COMPLETION OF THE PROJECT.

- A. SPRINKLERS SHALL BE RATED FOR ORDINARY TEMPERATURES (155 DEG. F) EXCEPT AS REQUIRED NEAR HEATERS OR LOCATIONS WHERE ELEVATED TEMPERATURES MAY NORMALLY BE EXPECTED OR AS OTHERWISE INDICATED ON THE CONTRACT DRAWINGS.
- B. SPRINKLER HEADS SHALL BE BY TYCO SPRINKLER CO., INC. MANUFACTURE OR APPROVED EQUAL, UL AND FM APPROVED, AS
- SPRINKLER HEADS IN FINISHED CEILINGS WITH CONCEALED PIPING SHALL BE SAME AS EXISTING SPRINKLER MODEL.
- CONCEALED SPRINKLER HEADS SHOULD BE AUTOMATIC TYCO MODEL TY3531.
- 3. PROVIDE SPARE SPRINKLER EMERGENCY CABINETS CONFORMING
- SPRINKLER EMERGENCY CABINETS SHALL BE OF TYCO SPRINKLER CO., INC. OR APPROVED EQUAL, UL AND FM APPROVED.
- 5. CABINET SHALL BE CONSTRUCTED OF 22 GAUGE STEEL WITH PRIME COAT AND MANUFACTURER'S BAKED ENAMEL FINISH IN COLOR SELECTED BY THE ARCHITECT.
- CABINET SHALL CONTAIN A MINIMUM OF 6 SPRINKLER HEADS O EACH TYPE EMPLOYED.

#### 2.12 PRESSURE GAUGE

TO NFPA 13.

ASHCROFT SERIES 1079, OR APPROVED OTHER, 4-1/2" DIAMETER, 0-P.S.I. RANGE, 5 P.S.I. INTERVALS.

#### PART 3 - EXECUTION

#### 3.01 GUARANTEE

A. GUARANTEE FOR A PERIOD OF ONE (1) YEAR FORM THE DATE OF ACCEPTANCE BY THE OWNER, ALL MATERIALS, APPARATUS AND WORKMANSHIP WHETHER FURNISHED BY HIMSELF OR BY HIS SUBCONTRACTORS AND HE SHALL REPLACE OR REPAIR IN A MANNER APPROVED BY THE ARCHITECTS, WITHOUT COST TO THE OWNER, ANY PART OR PARTS OF THE WORK WHICH MAY PROVE DEFECTIVE OR UNSATISFACTORY WITH IN THE PERIOD OF THE GUARANTEE.

#### 3.02 INSTALLATION

BE DRAINED.

- INSTALL PIPING AS SHOWN ON THE CONTRACT DRAWINGS AND STRAIGHT AND DIRECT AS POSSIBLE, FORMING RIGHT ANGLES OR PARALLEL LINES WITH BUILDING WALLS, NEATLY SPACED, WITH RISERS PLUMB AND TRUE.
- SPRINKLER PIPING SHALL BE INSTALLED SO THAT THE SYSTEM CAN
- PIPE SHALL BE REMOVED BY REAMING.
- BEFORE INSTALLING PIPE. THOROUGHLY CLEAN THE INSIDE FREE OF CUTTING AND FOREIGN MATTER. CUT ALL PIPE SQUARE AND SMOOTH AND MAKE UP ALL JOINTS TO REQUIRED LIMITS.

## B. PIPE JOINTS

THREADED JOINTS SHALL BE MADE UP OF TIGHT USING PIPE JOINT TEFLON COMPOUND OR TAPE, APPLIED ON THE MALE THREADS CONSULTANTS (ENGINEER):

**NEARBY ENGINEERS** 382 NE 191ST STREET SUITE 49674, MIAMI, FL 33179 PH-914.257.3455 WWW.NY-ENGINEERS.COM

CONTRACTOR'S NOTES: WRITTEN DIMENSIONS HOLD PREFERENCE OVER SCALED DIMENSIONS. DO NOT SCALE THE DRAWINGS. THE CONTRACTORS MUST VISIT JOB SITE TO VERIEY ALL EXISTING CONDITIONS AND DIMENSIONS BEFORE SUBMITTING BIDS. REPORT ANY DISCREPANCIES OF AN CONDITIONS WHICH MAY INTERFERE WITH THE PROPER EXECUTION OF, THE CONTRACT TO THE TENANT'S REPRESENTATIVE, REPORT DISCREPANCIES DURING BIDDING PROCESS AND BEFORE START OF CONSTRUCTION. CHANGE ORDERS NEED TO BE APPROVED BY **TOWNSQUARE** CONSTRUCTION MANAGER FOR ISSUES ARISING FROM THE FIELD CONDITIONS OR CONFLICTS BETWEEN THE PLANS AND

THE EXISTING CONDITIONS PRIOR TO THE

COMMENCEMENT OF WORK.

10.31.24 LL/CLIENT REVIEW SET 11.15.24 LL/CLIENT REVIEW SET 11.22.24 BD SUBMISSION

DATE REVISION


11.15.24 CLIENT COMMENTS



SHEET NUMBER:

SPRINKLER NOTES. SYMBOLS AND **SPECIFICATIONS** 

SP001

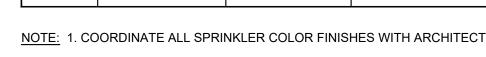


COVERAGE

CONCEALED STANDARD LH/OH OPEN AREAS BRASS 155 PENDENT STANDARD LH OPEN AREAS BRASS 155 **UPRIGHT** 

SPRINKLER SCHEDULE RESPONSE K-FACTOR NP AREA METAL (°F) QUICK TYCO QUICK 5.6

**APPROVALS** SERIES RF-II FM APPROVED TY3531 SERIES TY-FRB FM APPROVED TY313

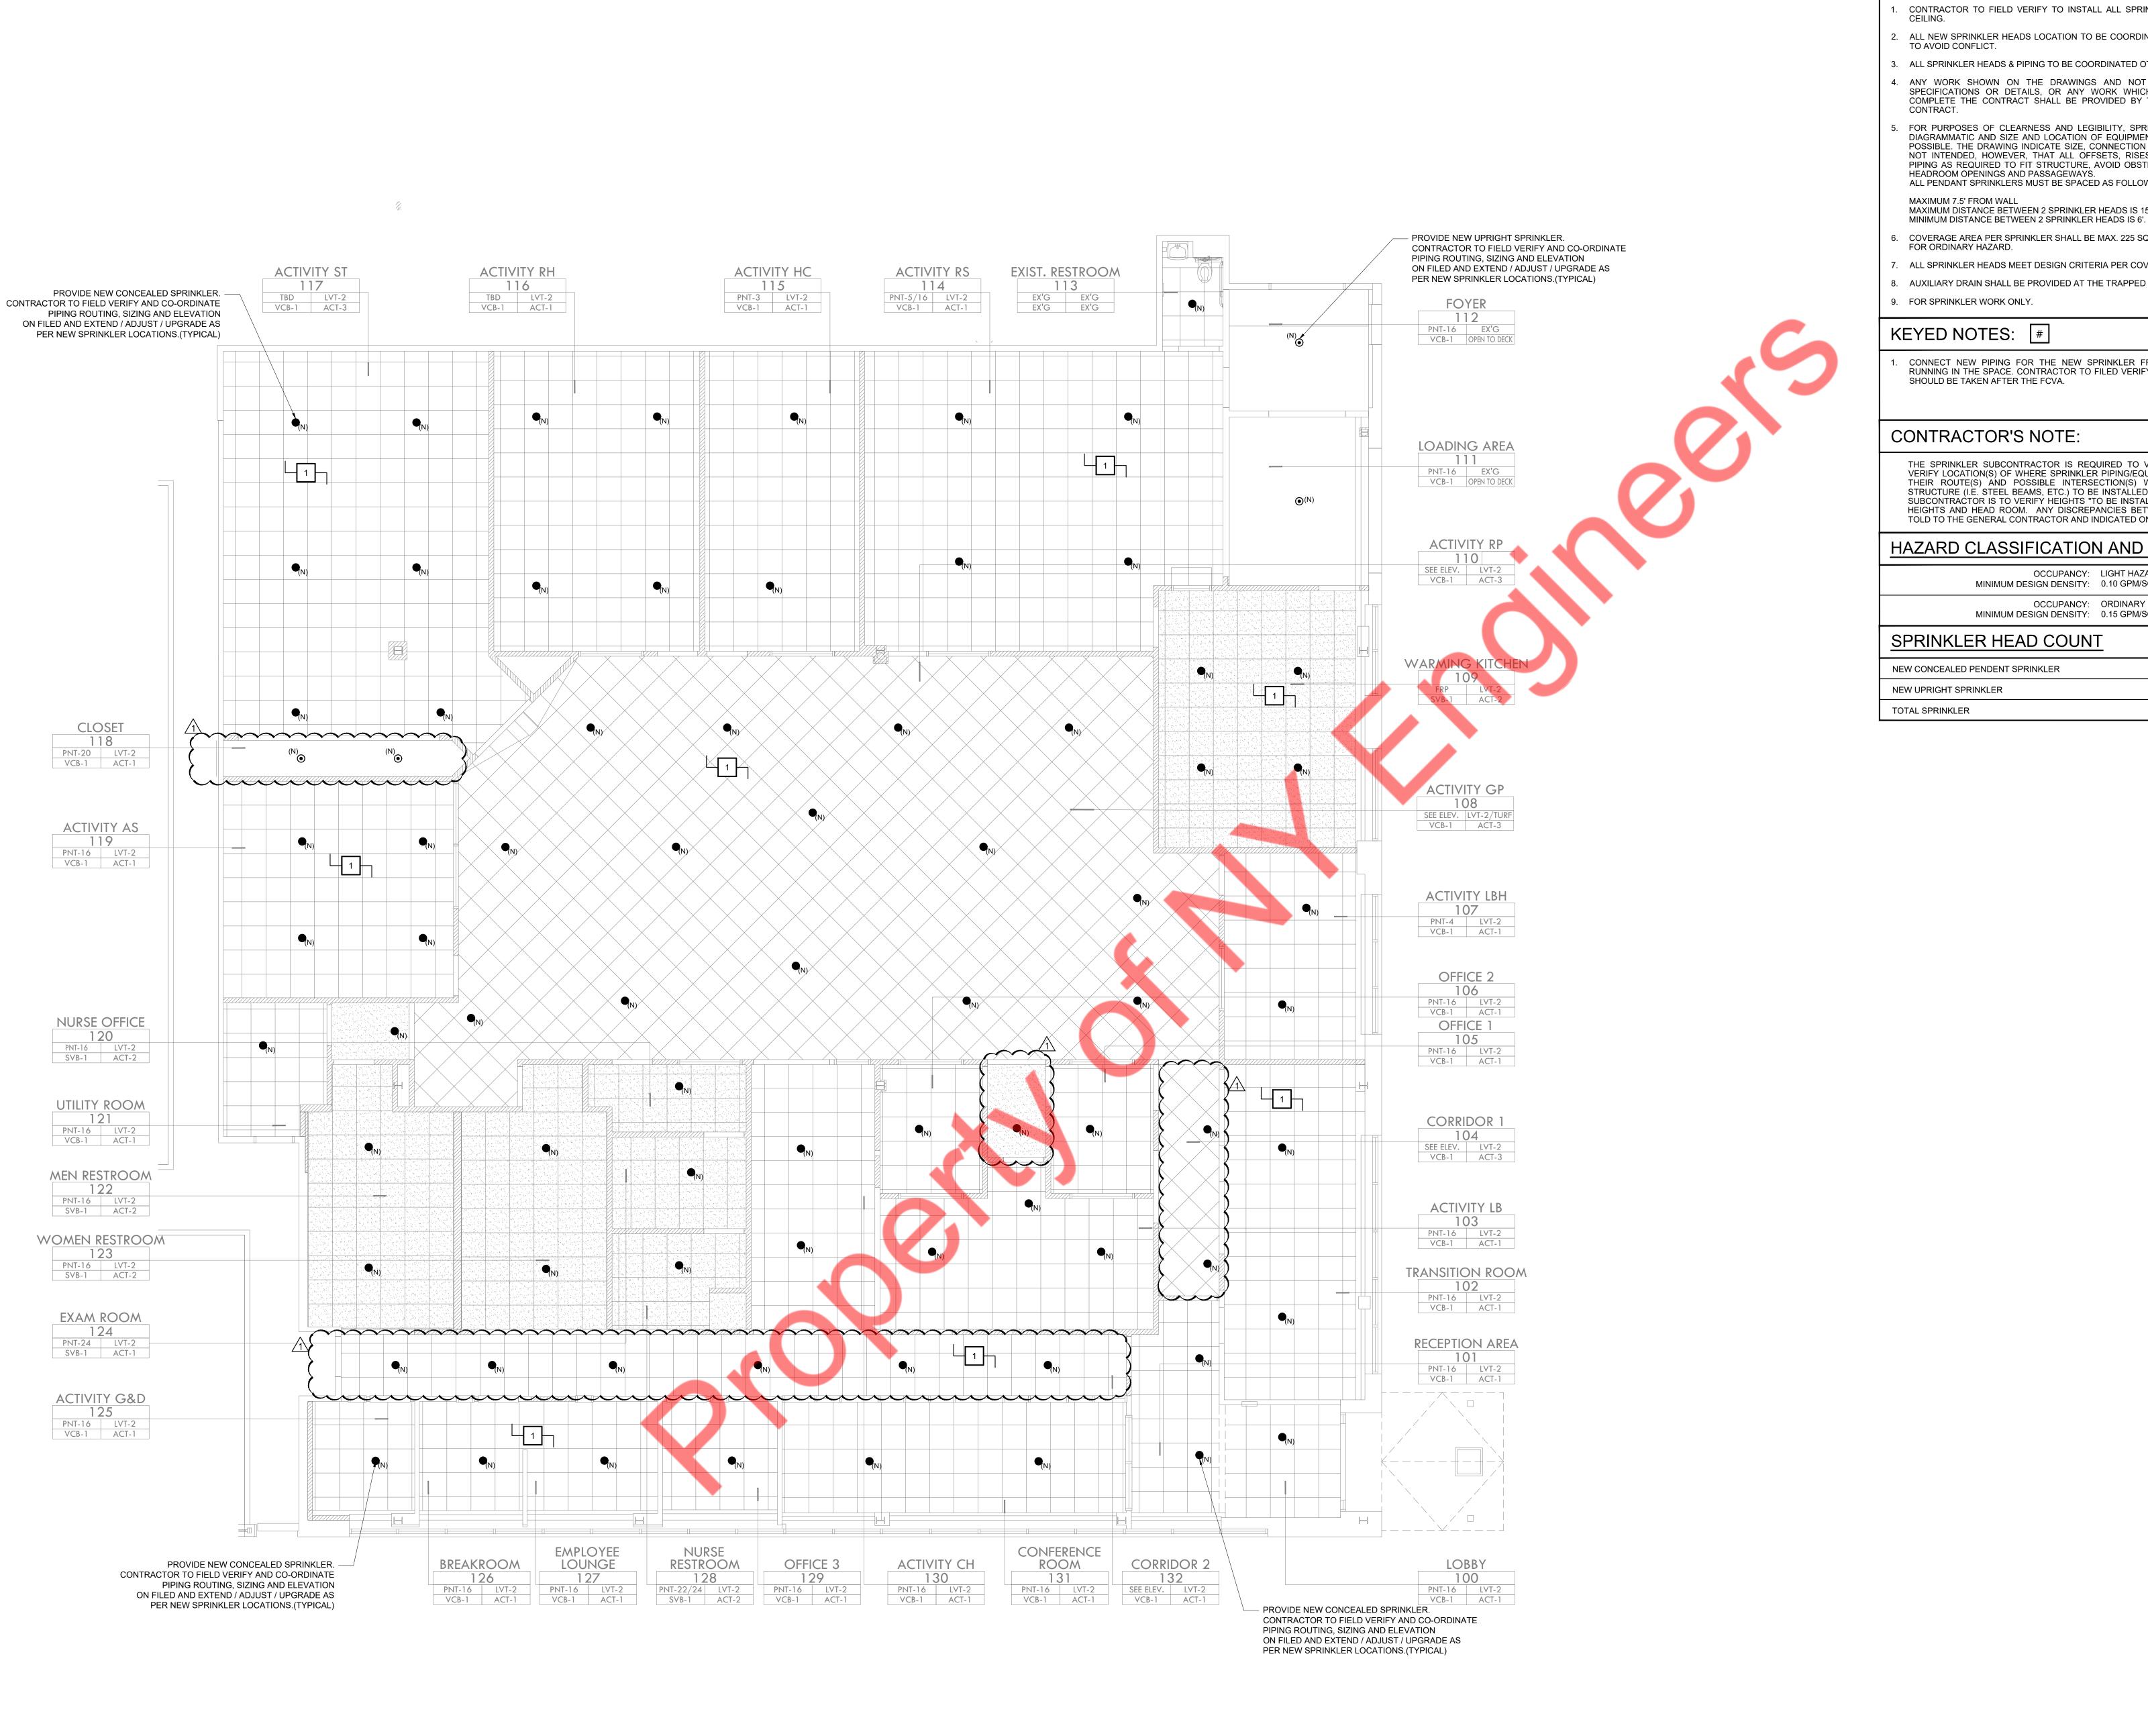

- CONTRACTOR TO FIELD VERIFY TO INSTALL ALL SPRINKLER HEADS TO BE MAX. 12" FROM
  - ALL NEW SPRINKLER HEADS LOCATION TO BE COORDINATED WITH LIGHTING AND DIFFUSERS
- 3. ALL SPRINKLER HEADS & PIPING TO BE COORDINATED OTHER TRADES.
- 4. ANY WORK SHOWN ON THE DRAWINGS AND NOT PARTICULARLY DESCRIBED IN THE SPECIFICATIONS OR DETAILS, OR ANY WORK WHICH MAY BE DEEMED NECESSARY TO COMPLETE THE CONTRACT SHALL BE PROVIDED BY THE CONTRACTOR AS PART OF THIS
- FOR PURPOSES OF CLEARNESS AND LEGIBILITY, SPRINKLER DRAWINGS ARE ESSENTIALLY DIAGRAMMATIC AND SIZE AND LOCATION OF EQUIPMENT ARE DRAWN TO SCALE WHEREVER POSSIBLE. THE DRAWING INDICATE SIZE, CONNECTION POINTS, AND ROUTED OF PIPES. IT IS NOT INTENDED, HOWEVER, THAT ALL OFFSETS, RISES AND DROPS ARE SHOWN. PROVIDE PIPING AS REQUIRED TO FIT STRUCTURE, AVOID OBSTRUCTIONS, AND RETAIN CLEARANCES, HEADROOM OPENINGS AND PASSAGEWAYS. ALL PENDANT SPRINKLERS MUST BE SPACED AS FOLLOWS -

## MAXIMUM DISTANCE BETWEEN 2 SPRINKLER HEADS IS 15'.

- . COVERAGE AREA PER SPRINKLER SHALL BE MAX. 225 SQ.FT FOR LIGHT HAZARD AND 130 SQ.FT.
- 7. ALL SPRINKLER HEADS MEET DESIGN CRITERIA PER COVERAGE.
- 8. AUXILIARY DRAIN SHALL BE PROVIDED AT THE TRAPPED SECTIONS.

CONNECT NEW PIPING FOR THE NEW SPRINKLER FROM THE EXISTING SPRINKLER MAIN RUNNING IN THE SPACE. CONTRACTOR TO FILED VERIFY AND ENSURE THE PIPE CONNECTION SHOULD BE TAKEN AFTER THE FCVA.

### **CONTRACTOR'S NOTE:**

THE SPRINKLER SUBCONTRACTOR IS REQUIRED TO VISIT THE SITE DURING BIDDING AND VERIFY LOCATION(S) OF WHERE SPRINKLER PIPING/EQUIPMENT IS INDICATED TO BE PLACED, THEIR ROUTE(S) AND POSSIBLE INTERSECTION(S) WITH OTHER EQUIPMENT / WORK / STRUCTURE (I.E. STEEL BEAMS, ETC.) TO BE INSTALLED AND/OR "EXISTING TO REMAIN". THIS SUBCONTRACTOR IS TO VERIFY HEIGHTS "TO BE INSTALLED" TO MAINTAIN DESIGNED CEILING HEIGHTS AND HEAD ROOM. ANY DISCREPANCIES BETWEEN DESIGNED AND ACTUAL TO BE TOLD TO THE GENERAL CONTRACTOR AND INDICATED ON THE BID FORM.

## HAZARD CLASSIFICATION AND DESIGN DENSITY

OCCUPANCY: LIGHT HAZARD MINIMUM DESIGN DENSITY: 0.10 GPM/SQ. FT.

OCCUPANCY: ORDINARY HAZARD MINIMUM DESIGN DENSITY: 0.15 GPM/SQ. FT.

SPRINKLER HEAD COUNT	
NEW CONCEALED PENDENT SPRINKLER	77
NEW UPRIGHT SPRINKLER	04
TOTAL SPRINKLER	81

CONSULTANTS (ENGINEER):

**NEARBY ENGINEERS** 382 NE 191ST STREET SUITE 49674, MIAMI, FL 33179 PH-914.257.3455

WWW.NY-ENGINEERS.COM

CONTRACTOR'S NOTES: WRITTEN DIMENSIONS HOLD PREFERENCE OVER SCALED DIMENSIONS. DO NOT SCALE THE DRAWINGS. THE CONTRACTORS MUST VISIT JOB SITE TO VERIFY ALL EXISTING CONDITIONS AND DIMENSIONS BEFORE SUBMITTING BIDS. REPORT ANY DISCREPANCIES OF ANY CONDITIONS WHICH MAY INTERFERE WITH THE PROPER EXECUTION OF, THE CONTRACT TO THE TENANT'S REPRESENTATIVE. REPORT DISCREPANCIES DURING BIDDING PROCESS AND BEFORE START OF CONSTRUCTION. CHANGE ORDERS NEED TO BE APPROVED BY TOWNSQUARE CONSTRUCTION MANAGER FOR ISSUES ARISING FROM THE FIELD CONDITIONS OR CONFLICTS BETWEEN THE PLANS AND THE EXISTING CONDITIONS PRIOR TO THE

COMMENCEMENT OF WORK.

10.31.24 LL/CLIENT REVIEW SET 11.15.24 LL/CLIENT REVIEW SET 11.22.24 BD SUBMISSION

 $\setminus |11.15.24|$  CLIENT COMMENTS


DATE REVISION



SPRINKLER PLAN

SHEET NUMBER:

**SP100** 

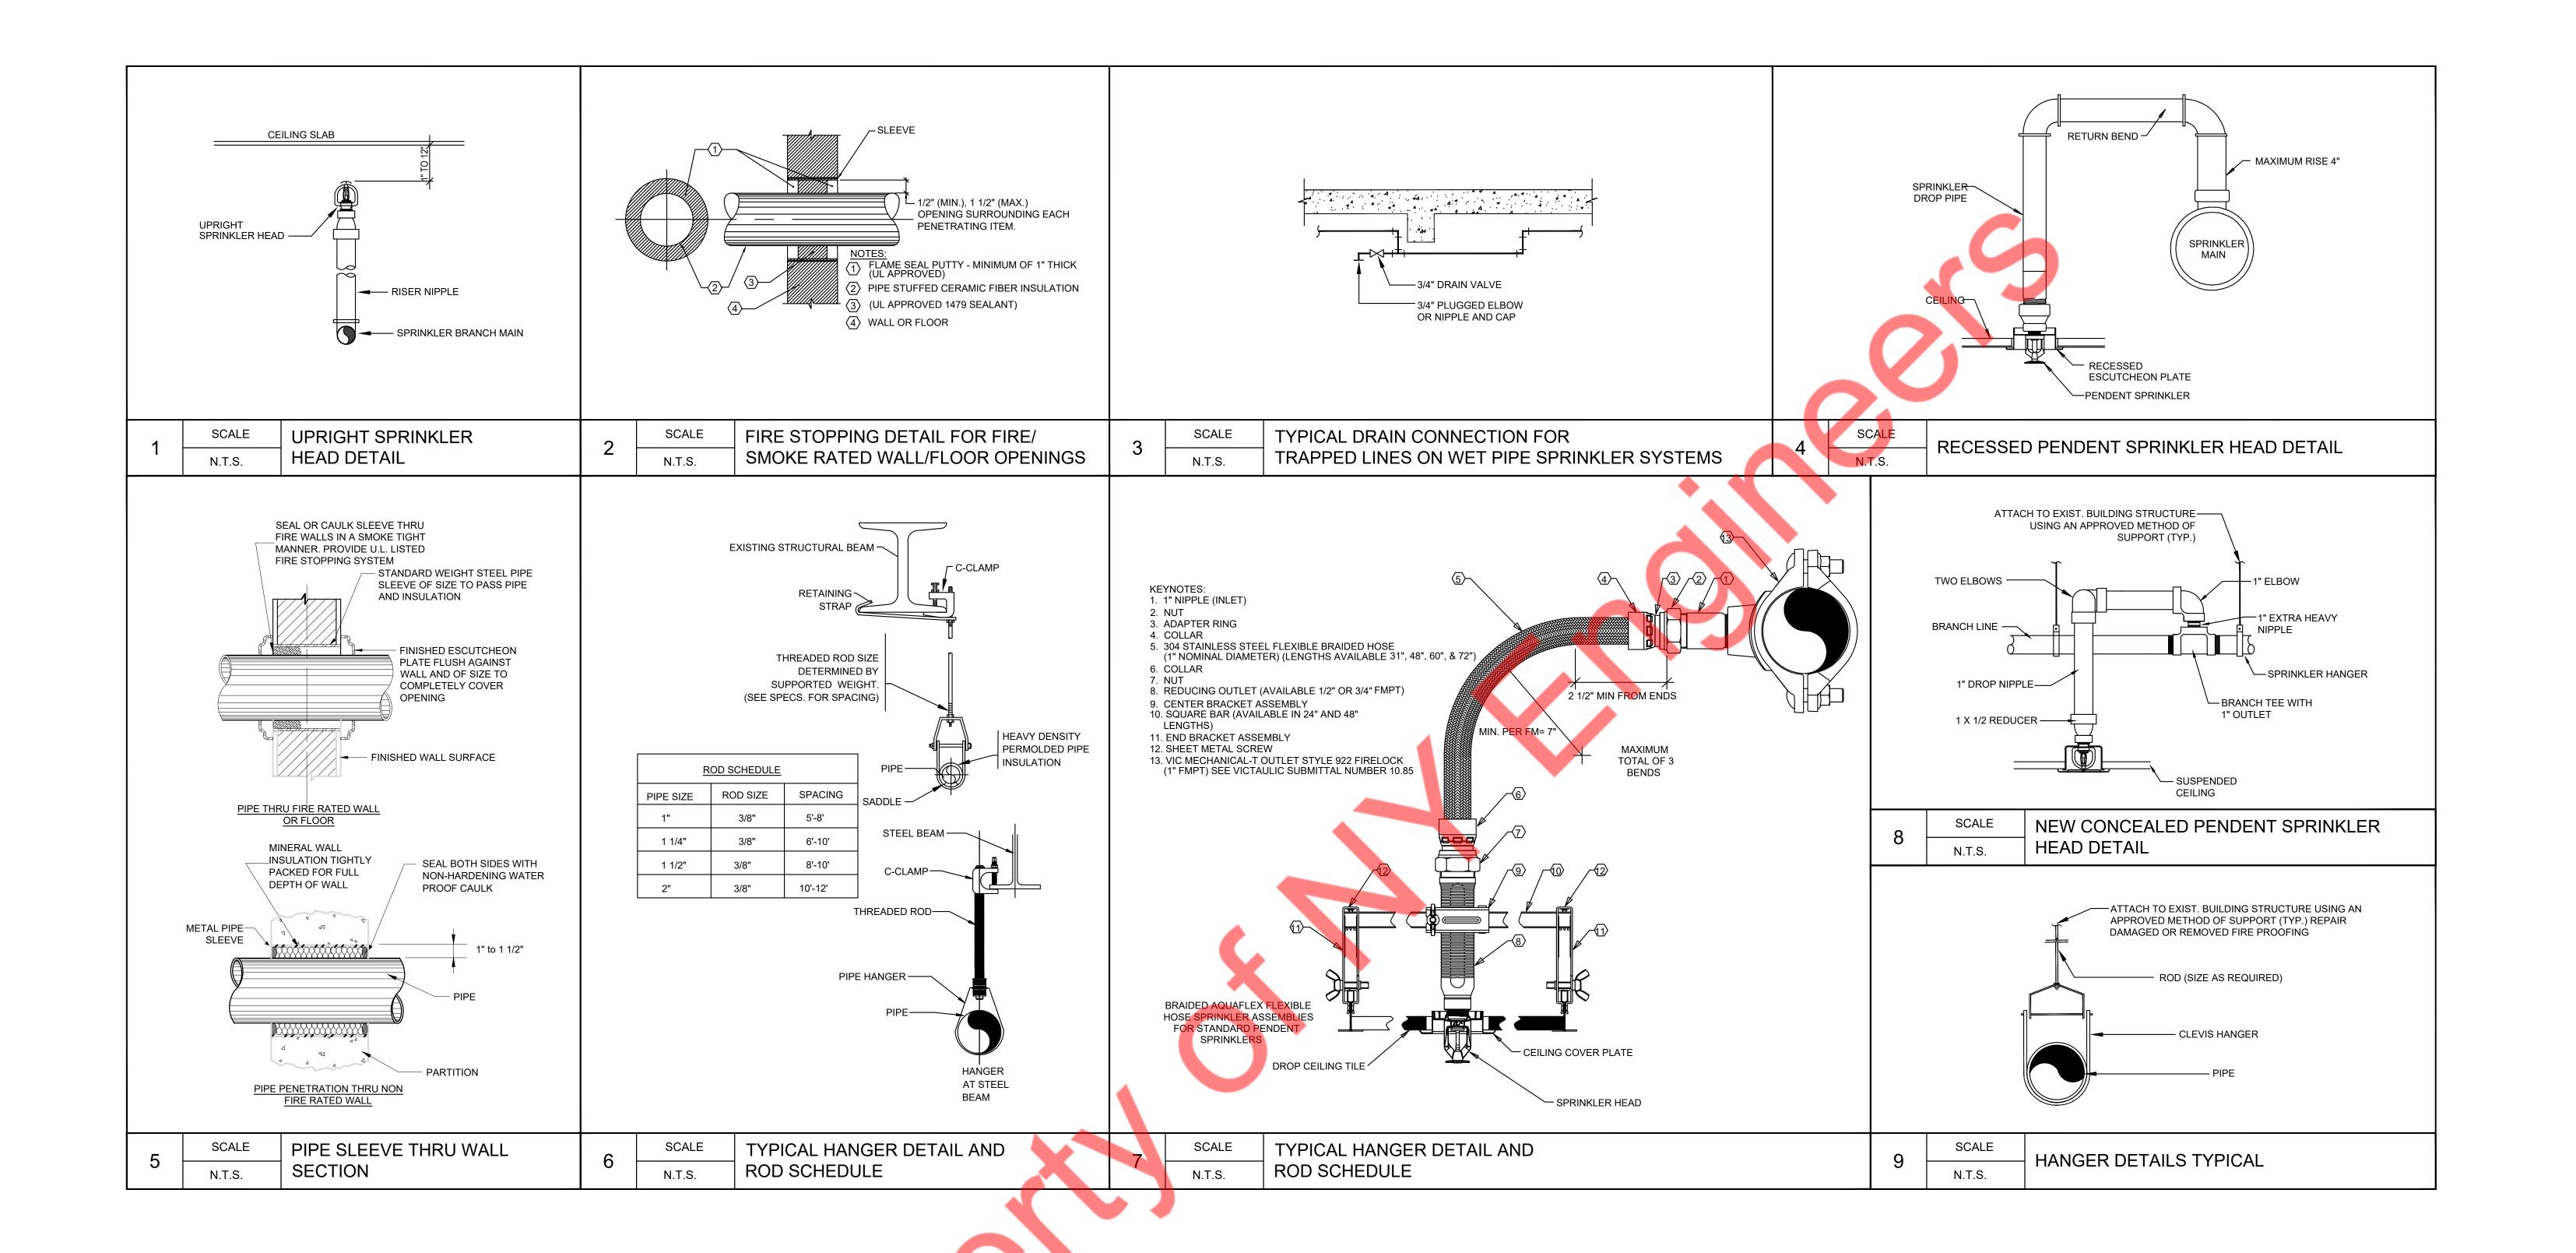

CONSULTANTS (ENGINEER):

# NY ENGINEERS

NEARBY ENGINEERS
382 NE 191ST STREET SUITE 49674,
MIAMI, FL 33179
PH-914.257.3455
WWW.NY-ENGINEERS.COM

CONTRACTOR'S NOTES:

WRITTEN DIMENSIONS HOLD PREFERENCE OVER SCALED DIMENSIONS. DO NOT SCALE THE DRAWINGS. THE CONTRACTORS MUST VISIT JOB SITE TO VERIFY ALL EXISTING CONDITIONS AND DIMENSIONS BEFORE SUBMITTING BIDS. REPORT ANY DISCREPANCIES OF ANY CONDITIONS WHICH MAY INTERFERE WITH THE PROPER EXECUTION OF, THE CONTRACT TO THE TENANT'S REPRESENTATIVE. REPORT DISCREPANCIES DURING BIDDING PROCESS AND BEFORE START OF CONSTRUCTION. CHANGE ORDERS NEED TO BE APPROVED BY TOWNSQUARE CONSTRUCTION MANAGER FOR ISSUES ARISING FROM THE FIELD CONDITIONS OR CONFLICTS BETWEEN THE PLANS AND THE EXISTING CONDITIONS PRIOR TO THE COMMENCEMENT OF WORK.

DATE ISSUE
10.31.24 LL/CLIENT REVIEW SET
11.15.24 LL/CLIENT REVIEW SET
11.22.24 BD SUBMISSION

1 11.15.24 CLIENT COMMENTS

DATE REVISION



TITLE:

SPRINKLER DETAILS

SHEET NUMBER:

SP200